

SYSTEM FIRST

# PERMIT

P 25756

A 22263

SEWAGE DISPOSAL SYSTEM

MARYLAND STATE DEPARTMENT OF HEALTH

HOWARD COUNTY

ELLICOTT CITY

DISTRICT 4th

DATE 5/3/77

3/1/78 final

## INDEXED

Alan Mitchell

IS PERMITTED TO INSTALL X ALTER

ADDRESS

PHONE 875-3396

A SEWAGE DISPOSAL SYSTEM LOCATED AT

SUBDIVISION Marion Frost property ROAD Daisy Road LOT 1

PROPERTY OWNER George A. Brubaker - owner

ADDRESS 9217 May Day Ct. Columbia, Md. 21045

SPECIFICATIONS 3 bedrooms

DRAIN FIELD \_\_\_\_\_ DEPTH \_\_\_\_\_ FEET, BOTTOM AREA \_\_\_\_\_ SQ. FT.

SEEPAGE PITS \_\_\_\_\_ ABSORBENT SIDE-WALL AREA \_\_\_\_\_ SQ. FT.

SEPTIC TANK CAPACITY 1000 GALLONS

FOR GARBAGE GRINDER, INCREASE DISPOSAL AREA 22% & TANK CAPACITY 50%.

OTHER 1.304/B.R. sidewall area; max depth 9'

PLANS APPROVED BY R. Moorefield DATE 4/4/77


FILL SEPTIC TANK AND DISTRIBUTION BOX WITH WATER BEFORE CALLING FOR AN INSPECTION. COVER NO WORK UNTIL INSPECTED AND APPROVED.

NEITHER THE HOWARD COUNTY COMMISSIONERS NOR THE HEALTH DEPARTMENT IS RESPONSIBLE FOR THE SUCCESSFUL OPERATION OF ANY SYSTEM.

BLDG. PERMIT SIGNED  
AND RETURNED 6/23/77

serial no 31913

22263

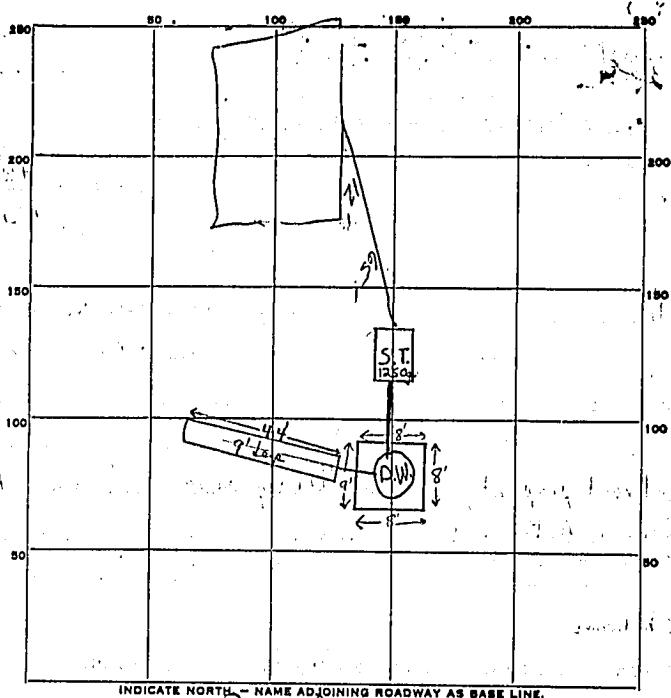

INDICATE NORTH - NAME ADJOINING ROADWAY AS BASE LINE.

Daisy Road

PERMIT CARD ✓ verbal not in permit S.S. S.T. | D.W.

SEPTIC TANK, LEVEL ✓ 1250 gal CLEANOUTS ✓ | ✓

DISTRIBUTION BOX, LEVEL n.a.

TILE FIELD, DEPTH 9 FT. TRENCH WIDTH 2 FT.

GRAVEL DEPTH 6 FT. TOTAL LENGTH 4.4 FT.

NUMBER OF TRENCHES 1  $\frac{1}{2}$  S10 WALL TOTAL BOTTOM AREA 242  $\phi$

SEEPAGE PITS, INSIDE DIAMETER 33 FT. DEPTH BELOW INLET 5 1/2 FT. D.W. area 181.5  $\phi$

ABSORBENT AREA +42.3 SQ. FT.

REMARKS 5/25/77 O.K. to add gravel in trench S.S.  
5/25/77 Call for final inspection when house is built and connect to septic tank O.K. to cover septic system except for caution line from house to tank S.S.

DATE SYSTEM APPROVED 3/78 INSPECTOR RR

