

APPLICATION

SEWAGE DISPOSAL TESTING

MARYLAND STATE DEPARTMENT OF HEALTH

HOWARD COUNTY

ELLICOTT CITY

DISTRICT 4

DATE 3/23/71

A 15791

P _____

TO: THE COUNTY HEALTH OFFICER
ELLICOTT CITY, MARYLAND

I, HEREBY, APPLY FOR THE NECESSARY TESTS IN ORDER TO CONSTRUCT (OR RECONSTRUCT) A SEWAGE DISPOSAL SYSTEM.

PROPERTY OWNER Norma Chase

ADDRESS Daisy Road, Woodbine, Maryland PHONE _____

PROPERTY LOCATION:

SUBDIVISION _____ LOT NO. _____

ROAD AND DESCRIPTION Daisy Road

OCCUPANT _____ PHONE _____

PERSON TO CONSTRUCT SYSTEM _____

ADDRESS _____ PHONE _____

SIZE OF LOT 2.037 acres TYPE BLDG. Bedrooms ? Existing house

NUMBER OF BEDROOMS

IF NOT SINGLE RESIDENCE DESCRIBE _____

SIGNATURE OF APPLICANT /s/ James H. Dutton

APPROVED BY _____ FOR _____ DATE _____

(KIND OF SYSTEM)


REJECTED BY _____ FOR _____ DATE _____

(KIND OF SYSTEM)

HOLD PENDING FURTHER TESTS _____ DATE _____

REASONS FOR REJECTION OR HOLDING _____

THIS IS NOT A PERMIT

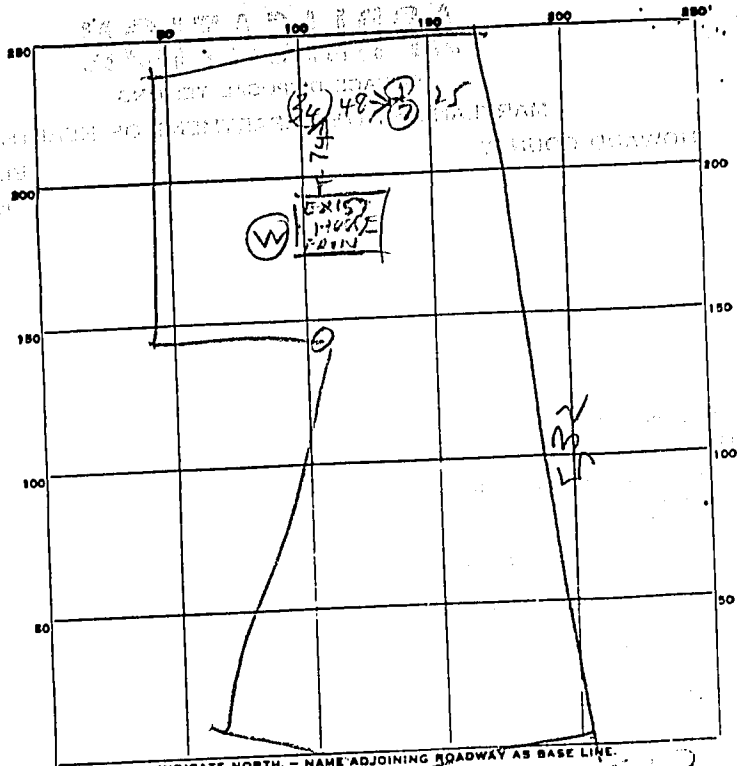


INDICATE NORTH - NAME ADJOINING ROADWAY AS BASE LINE.

PAISY 312

DATE	TEST NO.	DEPTH	PRE-WET		TEST - 1" DROP		TIME
			START	STOP	START	STOP	
<i>3/12/71</i>	<i>1</i>	<i>11</i>	<i>1217</i>	<i>1219</i>	<i>1219</i>	<i>1224</i>	<i>5</i>
<i>3/12/71</i>	<i>2</i>	<i>4 1/2</i>	<i>1227</i>	<i>100</i>	<i>1227</i>	<i>1231</i>	<i>3</i>
	<i>3</i>	<i>4</i>	<i>1229</i>	<i>1231</i>	<i>1231</i>	<i>1232</i>	<i>1</i>
	<i>4</i>	<i>11</i>	<i>1230</i>	<i>1231</i>	<i>1231</i>	<i>1232</i>	<i>1</i>

SOIL AUGER FINDING²
 TESTED BY *Howard Hodges*
 REMARKS _____

Daisy Road

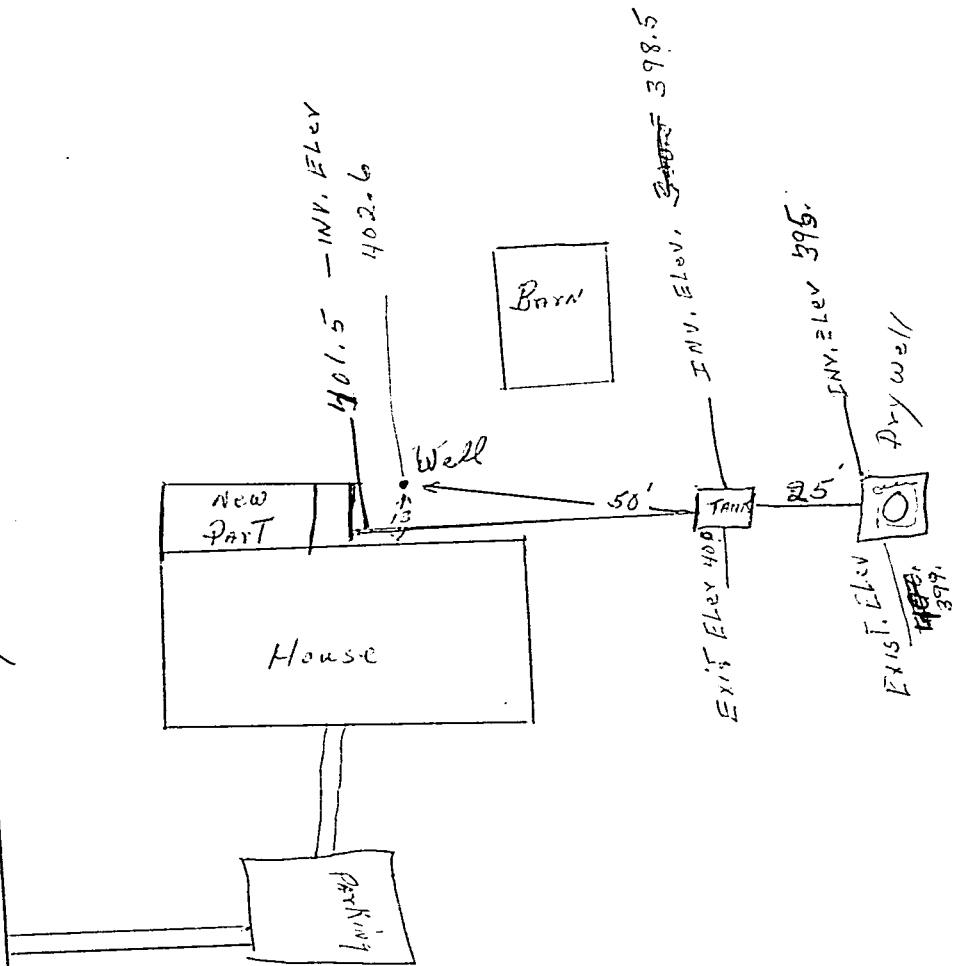

I Certify the above measurements and elev. are actual
and correct for this property Norma Chase
Signed