

PERMIT

SEWAGE DISPOSAL SYSTEM

DEPARTMENT OF HEALTH AND MENTAL HYGIENE

P _____

A 513203-R

DISTRICT _____

DATE _____

DATE SYSTEM APPROVED _____

INSPECTOR _____

HOWARD COUNTY HEALTH DEPARTMENT
BUREAU OF ENVIRONMENTAL HEALTH
~~XXXXXXX~~ 410-313-2640

INDEXED

RPS# 296520

_____ IS PERMITTED TO INSTALL _____ ALTER _____

ADDRESS _____ PHONE _____

SUBDIVISION Parton Property LOT 1 ROAD 1645 Henryton Road

PROPERTY OWNER Thomas & Joanne Parton

ADDRESS _____

PLANS APPROVED BY _____ DATE _____

COVER NO WORK UNTIL INSPECTED AND APPROVED

NEITHER THE HOWARD COUNTY COUNCIL NOR THE HEALTH DEPARTMENT IS RESPONSIBLE FOR THE SUCCESSFUL OPERATION OF ANY SYSTEM

NOTE: CLEANOUT REQUIRED EVERY 70 FEET OF SEWER LINE AND/OR AT 90° SWEEPS IN LINES FROM HOUSE TO DRAIN FIELDS, 90° ELBOWS NOT ACCEPTABLE.

NOTE: ALL PARTS OF SEPTIC SYSTEMS (I.E. TANK, DISTRIBUTION BOX TRENCHES) TO BE 100 FEET FROM WELL (UNLESS OTHERWISE SPECIFICALLY AUTHORIZED)

NOTE: IF DEEP TRENCH(ES) ARE USED CALL FOR INSPECTION BEFORE AND AFTER PLACING GRAVEL IN TRENCH(ES)

NOTE: NO DRY WELL SHALL EXCEED 15 FOOT IN DIAMETER NO ABSORPTION TRENCH TO EXCEED 100 FEET IN LENGTH

NOTE: ALL PIPE FROM HOUSE TO SEPTIC TANK MUST BE CAST IRON OR SCHEDULE 35/40 PVC OR ABS

PERMIT VOID AFTER TWO YEARS

NOTE: INSTALL STAND PIPE ON SEPTIC TANK AND DRY WELL STAND PIPES MUST BE 6 INCHES IN DIAMETER CAST IRON. CONCRETE OR TERRA COTTA OR PVA OR ABS ACCEPTED. IF TOP OF SEPTIC TANK IS DEEPER THAN 3 FEET, MANHOLE TO GRADE REQUIRED.

NOTE: DISTRIBUTION BOXES MUST HAVE BAFFLES


***INSTALLER IS RESPONSIBLE FOR OBTAINING FINAL APPROVAL ON THIS PERMIT**

***CALL 461-9933 FOR INSPECTION OF SEPTIC SYSTEM.**

HD-260(6-90)

REG. PERMIT SIGNATURE
AND RETURNED 13/1/90
MASTER BEDROOM

A 513203 R

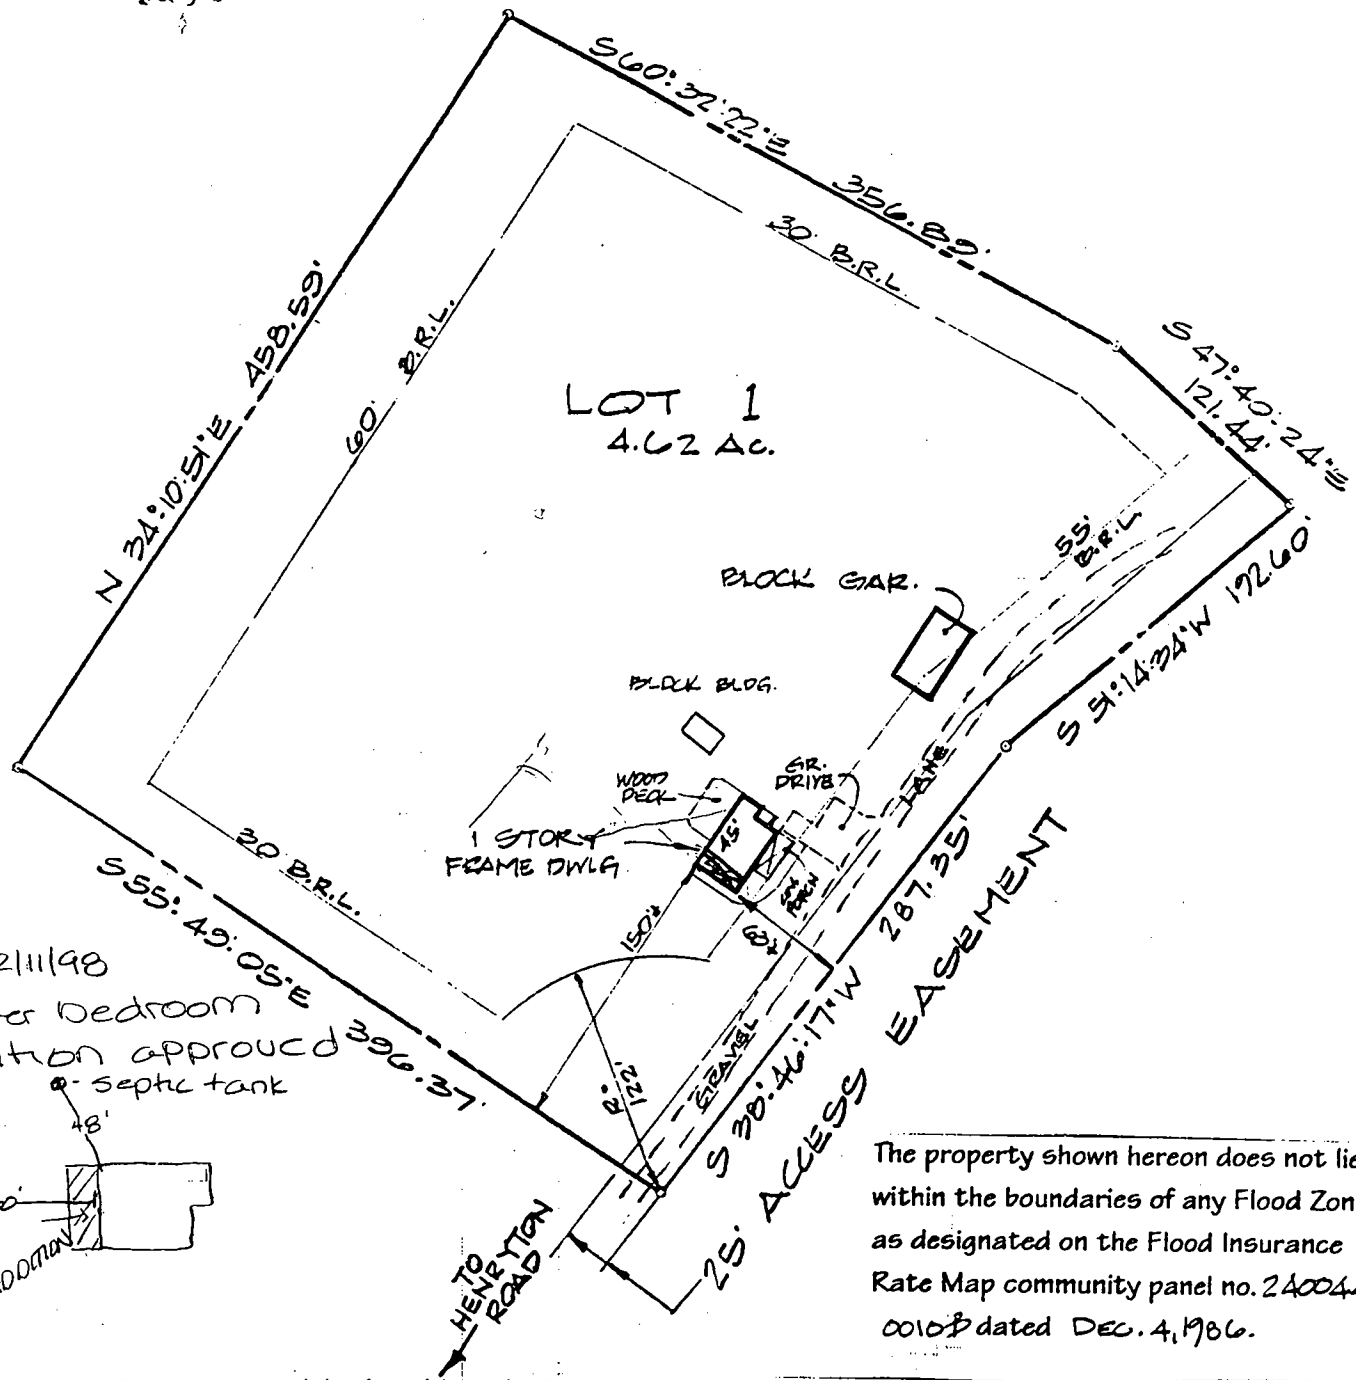

1211198
 Master bedroom
 addition approuched
 • septic tank
 48'
 WELL
 ADDITION

The property shown hereon does not lie within the boundaries of any Flood Zone as designated on the Flood Insurance Rate Map community panel no. 240044 0010 dated DEC. 4, 1986.


- NOTE:**
- i) the plat is of benefit to a consumer only insofar as it is required by a lender or a title insurance company or its agent in connection with contemplated transfer, financing or re-financing;
 - ii) the plat is not to be relied upon for the establishment or location of fences, garages, buildings, or other existing or future improvements; and
 - iii) the plat does not provide for the accurate identification of property boundary lines, but such identification may not be required for the transfer of title or securing financing or refinancing.

Being known and designated as Lot 1, on a Plat of PARTON SUBDIVISION, which Plat is recorded in Plat Book CMP No. 5910

Accuracy of setbacks and improvements shown hereon to the APPARENT property lines are plus or minus 1 feet.

**W. T. SADLER
 SURVEYORS**

152 WESTMINSTER PIKE
 REISTERSTOWN, MD
 21136
 Phone - (410) 526-5618
 Fax - (410) 526-7199

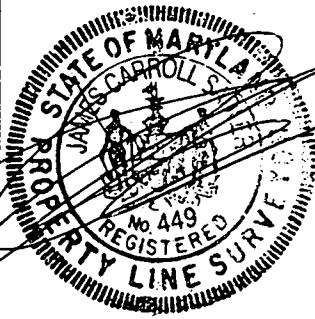

LOCATION DRAWING

1645 HENRYTON ROAD
 HOWARD COUNTY, MD.

SCALE 1"=100'	DATE 10.14.1998	JOB NO. J. 11269
-------------------------	---------------------------	----------------------------