

7-9-71
DL

7/7/71
excav.

PERMIT

SEWAGE DISPOSAL SYSTEM

P 16005

A 13329

MARYLAND STATE DEPARTMENT OF HEALTH

HOWARD COUNTY

INDEXED

ELLICOTT CITY

DISTRICT 4

DATE 6-8-71

Jack Fyock IS PERMITTED TO INSTALL X ALTER

ADDRESS Glenelg, Md. PHONE 286-2939

A SEWAGE DISPOSAL SYSTEM LOCATED AT _____

SUBDIVISION Jennings Chapel Woods ROAD Daisy Rd. LOT 1

PROPERTY OWNER Robert G. Johnson

ADDRESS Ashton, Md.

SPECIFICATIONS 3 - Bedrooms

DRAIN FIELD _____ DEPTH _____ FEET, BOTTOM AREA _____ SQ. FT.

SEEPAGE PITS _____ ADSORBENT SIDE-WALL AREA _____ SQ. FT.

SEPTIC TANK CAPACITY 1000 GALLONS

FOR GARBAGE GRINDER, INCREASE DISPOSAL AREA 22% & TANK CAPACITY 50%.

OTHER Dry Well - 100 sq. ft. absorbent sidewall area to begin below inlet pipe per bedroom.

Inlet pipe at least 4 ft. below original grade. Maximum depth permitted for Dry Well below original grade is 13 ft.

Place Dry Well either 125 ft. or 165 ft. from front lot line and about 25 ft. from right sideline as seen when facing lot from Daisy Road. NOTE: ALL PIPE FROM HOUSE TO TANK MUST BE CAST IRON.


PERMIT VOID AFTER THREE YEARS.

PLANS APPROVED BY Donald W. Monaghan DATE 6-8-71

FILL SEPTIC TANK AND DISTRIBUTION BOX WITH WATER BEFORE CALLING FOR AN INSPECTION. COVER NO WORK UNTIL INSPECTED AND APPROVED.

NEITHER THE HOWARD COUNTY COMMISSIONERS NOR THE HEALTH DEPARTMENT IS RESPONSIBLE FOR THE SUCCESSFUL OPERATION OF ANY SYSTEM.

A 13329

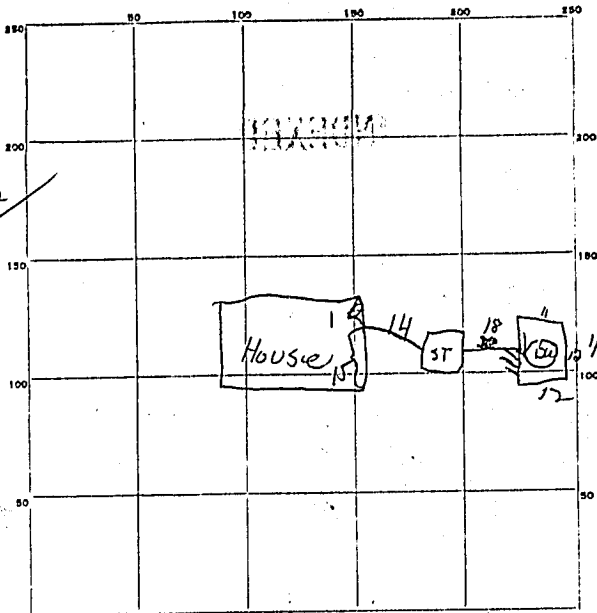

INDICATE NORTH - NAME ADJOINING ROADWAY AS BASE LINE.

Daisy Rd

PERMIT CARD OK

SEPTIC TANK, LEVEL OK

CLEANOUTS OK

DISTRIBUTION BOX, LEVEL _____

TILE FIELD, DEPTH _____ FT. TRENCH WIDTH _____ FT.

GRAVEL DEPTH _____ IN. TOTAL LENGTH _____ FT.

NUMBER OF TRENCHES _____ TOTAL BOTTOM AREA _____

SEEPAGE PITS, W/PIPE DIAMETER Perimeter 48 FT. DEPTH BELOW INLET 6 1/2 FT.

ABSORBENT AREA 312 SQ. FT.

REMARKS reconnect inlet to tank


DATE SYSTEM APPROVED 7-9-71 INSPECTOR [Signature]

7-9-71

[Signature]
DeWaney

NORTH

A13329

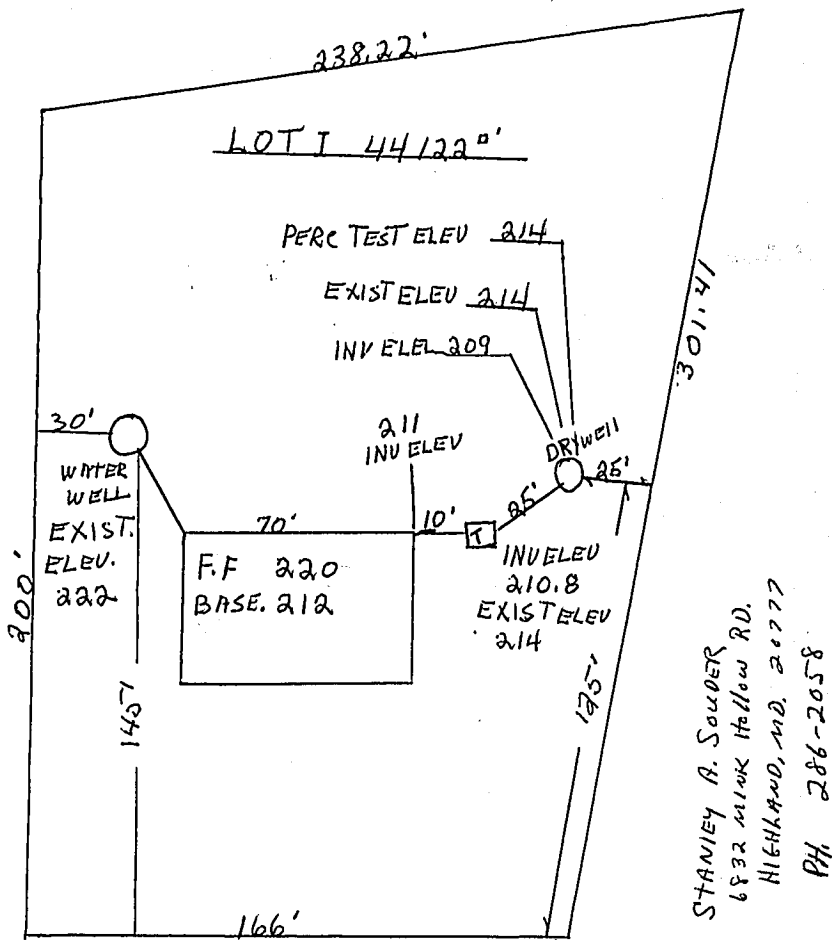

DAISY ROAD

PLOT PLAN FOR THEO. SNYDER

JENNINGS Chapel Woods, 4th Elec. Dist.

Howard County, Maryland

J. 30-71.
O.K. SW.