

REPAIR

6/29/67
10 a.m.

PERMIT

SEWAGE DISPOSAL SYSTEM

P-12785

A-

MARYLAND STATE DEPARTMENT OF HEALTH

HOWARD COUNTY

INDEXED

ELLCOTT CITY

DISTRICT 2

DATE 6/28/67

James Triplett IS PERMITTED TO INSTALL ALTER

ADDRESS Hardy Road, Mt. Airy, Md. PHONE HU 9-4535

A SEWAGE DISPOSAL SYSTEM LOCATED AT Daniels Road, off Old Frederick Road
left hand side with large pond in front by driveway.

SUBDIVISION ROAD LOT

PROPERTY OWNER Edsel Lanford

ADDRESS Daniels Road

SPECIFICATIONS

DRAIN FIELD DEPTH FEET, BOTTOM AREA SQ. FT.

SEEPAGE PITS ABSORBENT SIDE-WALL AREA SQ. FT.

SEPTIC TANK CAPACITY GALLONS

FOR GARBAGE GRINDER, INCREASE DISPOSAL AREA 22% & TANK CAPACITY 50%.

OTHER REPAIR - 200 sq. ft. drain field


PLANS APPROVED BY DATE 6/28/67

FILL SEPTIC TANK AND DISTRIBUTION BOX WITH WATER BEFORE CALLING FOR AN INSPECTION. COVER NO WORK UNTIL INSPECTED AND APPROVED.

NEITHER THE HOWARD COUNTY COMMISSIONERS NOR THE HEALTH DEPARTMENT IS RESPONSIBLE FOR THE SUCCESSFUL OPERATION OF ANY SYSTEM.

NOTIFY THE HEALTH DEPARTMENT 48 HOURS BEFORE EXCAVATIONS ARE TO BE BACK FILLED.

12785

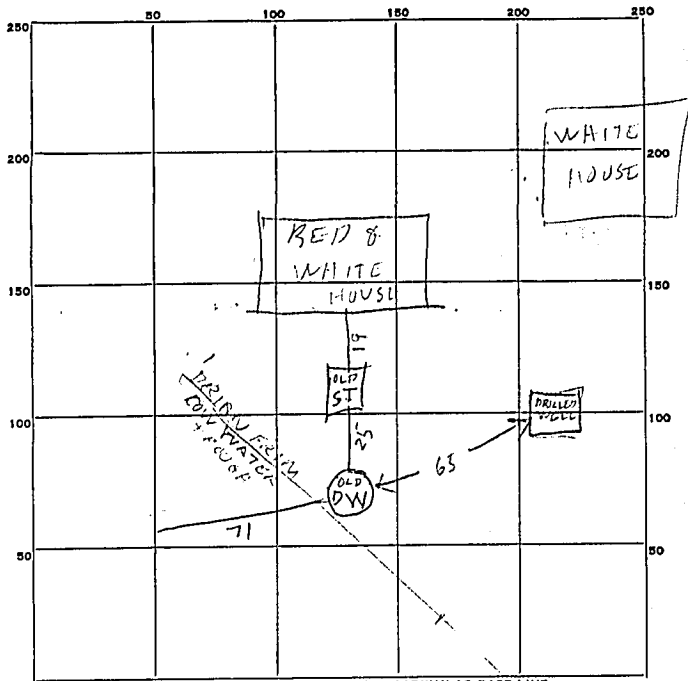

INDICATE NORTH. - NAME ADJOINING ROADWAY AS BASE LINE.

PERMIT CARD _____

SEPTIC TANK, LEVEL _____ CLEANOUTS _____

DISTRIBUTION BOX, LEVEL _____

TILE FIELD, DEPTH 13 FT. TRENCH WIDTH 3 FT.

GRAVEL DEPTH 16 1/2" IN. TOTAL LENGTH 71 FT.

NUMBER OF TRENCHES 1 TOTAL BOTTOM AREA 213

SEEPAGE PITS, INSIDE DIAMETER _____ FT. DEPTH BELOW INLET _____ FT.

ABSORBENT AREA _____ SQ. FT.

REMARKS _____

DATE SYSTEM APPROVED BY JONE 67 INSPECTOR Raymond Hodges

