

6/28/67
10 AM

AP. 6-28-67. 77.

PERMIT

P 12781

SEWAGE DISPOSAL SYSTEM

A _____

MARYLAND STATE DEPARTMENT OF HEALTH

HOWARD COUNTY

ELLCOTT CITY

INDEXED

DISTRICT 2

DATE 6/26/67

James Triplatt IS PERMITTED TO INSTALL ALTER

ADDRESS Hardy Rd., Mt. Airy, Md. PHONE HU 9-4535

A SEWAGE DISPOSAL SYSTEM LOCATED AT _____

SUBDIVISION _____ ROAD Daniels off Old _____ LOT _____

PROPERTY OWNER James Cobb Frederick Rd. 2nd house on right - big white

ADDRESS _____

SPECIFICATIONS - REPAIR

DRAIN FIELD _____ DEPTH _____ FEET, BOTTOM AREA _____ SQ. FT.

SEEPAGE PITS _____ ABSORBENT SIDE-WALL AREA _____ SQ. FT.

SEPTIC TANK CAPACITY 1,000 GALLONS

FOR GARBAGE GRINDER, INCREASE DISPOSAL AREA 22% & TANK CAPACITY 50%.

OTHER REPAIR - dry wall 300 sq. ft. min.


PLANS APPROVED BY _____ DATE 6/26/67

FILL SEPTIC TANK AND DISTRIBUTION BOX WITH WATER BEFORE CALLING FOR AN INSPECTION. COVER NO WORK UNTIL INSPECTED AND APPROVED.

NEITHER THE HOWARD COUNTY COMMISSIONERS NOR THE HEALTH DEPARTMENT IS RESPONSIBLE FOR THE SUCCESSFUL OPERATION OF ANY SYSTEM.

NOTIFY THE HEALTH DEPARTMENT 48 HOURS BEFORE EXCAVATIONS ARE TO BE BACK FILLED.

12781

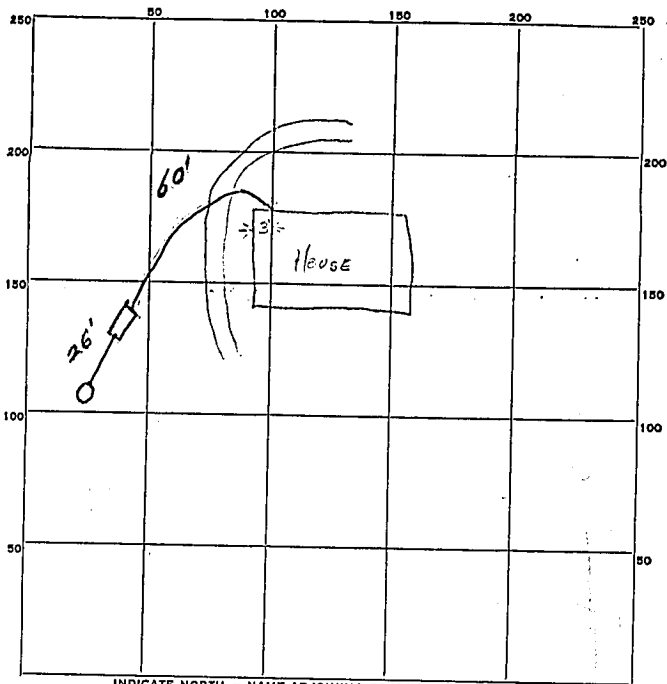

INDICATE NORTH. - NAME ADJOINING ROADWAY AS BASE LINE.

DANIELS RR.

PERMIT CARD

SEPTIC TANK, LEVEL ok 1000 cu. ft. CLEANOUTS ok

DISTRIBUTION BOX, LEVEL _____

TILE FIELD, DEPTH _____ FT. TRENCH WIDTH _____ FT.

GRAVEL DEPTH _____ IN. TOTAL LENGTH _____ FT.

NUMBER OF TRENCHES _____ TOTAL BOTTOM AREA _____

SEEPAGE PITS, INSIDE DIAMETER 12" dia. FT. DEPTH BELOW INLET 9 FT.

ABSORBENT AREA 432 SQ. FT.

REMARKS _____

DATE SYSTEM APPROVED

6-28-67

INSPECTOR

F. J. Loomis