

Retest

*3/30/79
9:30 A.M.*

APPLICATION

SEWAGE DISPOSAL TESTING

A 29585

STATE OF MARYLAND - DEPARTMENT OF HEALTH AND MENTAL HYGIENE

P _____

HOWARD COUNTY HEALTH DEPARTMENT
ENVIRONMENTAL HEALTH SERVICES
P.O. BOX 476 ELLICOTT, MARYLAND 21043
TELEPHONE: 992-2330

DISTRICT 4th

DATE 3/20/79

TO THE COUNTY HEALTH OFFICER
ELLCOTT CITY, MARYLAND

I HEREBY APPLY FOR THE NECESSARY TEST IN ORDER TO CONSTRUCT (OR RECONSTRUCT) A SEWAGE DISPOSAL SYSTEM

PROPERTY OWNER John & Evelyn Keenan (Contract Purchaser - Donald G. Franklin)

ADDRESS 11060 Berrypick Lane, Columbia, Md. 21044 PHONE 997-5582

PROPERTY LOCATION

SUBDIVISION Rover Mill Estates LOT NO 11

ROAD AND DESCRIPTION Danmark Drive

SIZE OF LOT 3 acre m/l TYPE BLDG 3 or 4 bedrooms

THE SYSTEM INSTALLED UNDER THIS APPLICATION IS ACCEPTABLE ONLY UNTIL PUBLIC FACILITIES BECOME AVAILABLE.

I FULLY UNDERSTAND THE FEE CONNECTED WITH THE FILING OF THIS PERC TEST APPLICATION IS NON-REFUNDABLE UNDER ANY CIRCUMSTANCES.

SIGNATURE OF APPLICANT *Louise M. Jensen*

APPROVED BY _____ FOR _____ DATE _____

REJECTED BY _____ FOR _____ DATE _____



HOLD PENDING FURTHER TESTS _____ DATE _____

REASONS FOR REJECTION OR HOLDING *3/30/79 - RETEST PERC O.K.*
HOLD FOR PLAT SHOWING SEPTIC SYSTEM
CERTIFIED HALES ECT RIT


THIS IS NOT A PERMIT

lot # 11

SEE ORIGINAL SITE PLAN

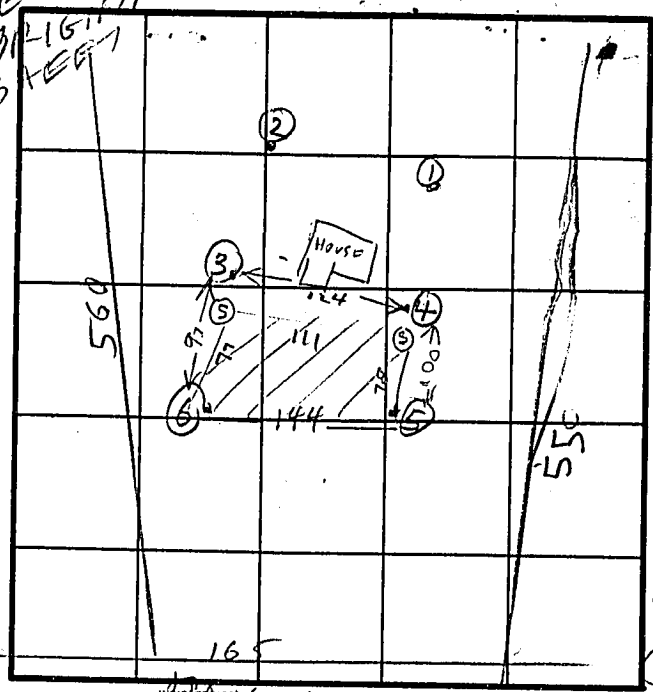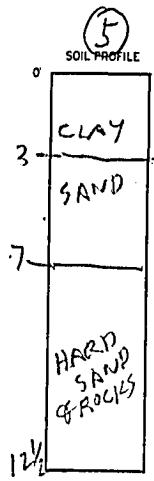

- HOLE ELEVATION
- ① = VERMION
 - ② = VERMION
 - ③ = HIGH
 - ④ = HIGH
 - ⑤ = LOW
 - ⑥ = LOW, LOW
 - ⑦ = STAKE FOR SEWAGE AREA

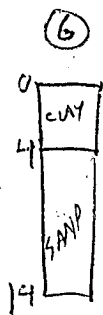

DATE	TEST NO.	DEPTH	PRE-WET		TEST - 1" DROP		TIME
			START	STOP	START	STOP	
3/30/79	5D	12 1/2	1004	1011	1011	1020	9
3/30/79	5S	4	1005	1007	1007	1010	3
	6D	12 1/2	1022	1026	1026	1033	7
	6S	4 1/2	1027	1030	1030	1033	3
3/30/79	6V	14	DRY	SEE	SOIL	PROFILE	

VIII = PROPOSED NEW SEWAGE DISPOSAL AREA

REMARKS _____

TYPE OF SOIL _____

TESTED BY R. HODGES

ALSO PRESENT DON FRANTALIN
BARB PARKER
J. F. YOCK CO