

PRELIMINARY

(C.B.D. write spec)

6/26/98 Hold for sewage Hold 1/4/98 New #26 area recheck

APPLICATION

26585
~~26587~~

permitted 40 911 A P

SEWAGE DISPOSAL TESTING

STATE OF MARYLAND - DEPARTMENT OF HEALTH AND MENTAL HYGIENE

HOWARD COUNTY HEALTH DEPARTMENT
ENVIRONMENTAL HEALTH SERVICES
P. O. BOX 476, ELLICOTT CITY, MARYLAND 21043
TELEPHONE: 465-5000, EXT. 356

Septic Tank { 1-3 Bedrooms 1000 gallons
4 Bedrooms 1250 gallons
DISTRICT 4th
DATE 8/15/77

⊕ Dry well to have 125 sqft. effective absorbant sidewall area per bedroom below inlet Inlet to be 3 1/2' below original grade and maximum depth 12'. Location per plat: 190' off right property line and 135' from Hewitt Hwy Drive other high perc hole per house plans of 8/2/79

⊖ Man hole cleanout on cover & Manhole septic tank to grade at tank stop TO THE COUNTY HEALTH OFFICER over 3' below original grade ELLICOTT CITY, MARYLAND

I HEREBY APPLY FOR THE NECESSARY TEST IN ORDER TO CONSTRUCT (OR RECONSTRUCT) A SEWAGE DISPOSAL SYSTEM.

PROPERTY OWNER J & B Partnership Gordon C. Jenkins
125' off right property line & 205' from Hewitt Drive when facing lot from Hewitt Drive
(1) 5' earth buffer

ADDRESS 5632 Stevens Forest Rd., Apt. 254, Columbia 21045
PHONE Any questions call Ron Carter - 837-0194

PROPERTY LOCATION 504 Morelock School Road Westminister, Md 21157
SUBDIVISION Westcliffe Manor old LOT NO. 25 New 26

ROAD AND DESCRIPTION off Underwood Road
(2) 2 inspections of trench before & after stone in.

SIZE OF LOT 13763 Barberray Way 45,000 sq. ft. TYPE BLDG. 3 or 4 bedrooms
NUMBER OF BEDROOMS

IF NOT SINGLE RESIDENCE DESCRIBE

THE SYSTEM INSTALLED UNDER THIS APPLICATION IS ACCEPTABLE ONLY UNTIL PUBLIC FACILITIES BECOME AVAILABLE.

SIGNATURE OF APPLICANT /s/ Ron Carter
BLDG. PERMIT SIGNED AND RETURNED 40648 Serial No. 8/21/79


APPROVED BY C.B. Strescher FOR Dry well + 100 " " + trench DATE 6/29/98
(KIND OF SYSTEM)

REJECTED BY FOR
(KIND OF SYSTEM) DATE

HOLD PENDING FURTHER TESTS DATE

REASONS FOR REJECTION OR HOLDING

THIS IS NOT A PERMIT

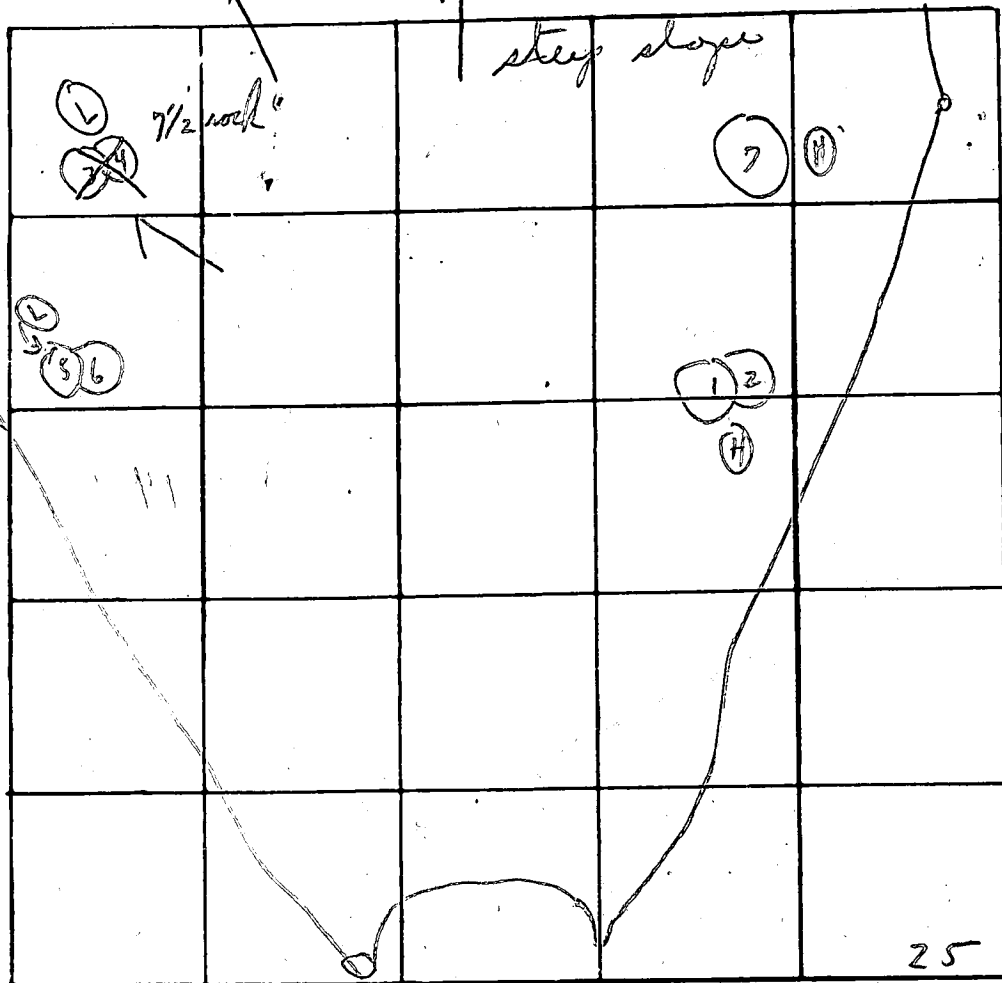

INDICATE NORTH. - NAME ADJOINING ROADWAY AS BASE LINE

Soil Profile

(Hold for
releasing
possible)

DATE	TEST NO.	DEPTH	PRE-WET		TEST - 1" DROP		TIME	
			START	STOP	START	STOP		
7/2/77	1	4 1/2'	:	:	:	:		
	2	12 1/2'	:	:	:	:		
	3		:	:	:	:		
	4		:	:	:	:		
	5		:	:	:	:		
	6		:	:	:	:		
	7	11 1/2'	Visual without probe holes					

REMARKS _____

TYPE OF SOIL _____

TESTED BY C. B. S. ALSO PRESENT: Frostman

PRELIMINARY

APPLICATION

26586
A ~~26588~~

SEWAGE DISPOSAL TESTING

STATE OF MARYLAND - DEPARTMENT OF HEALTH AND MENTAL HYGIENE

HOWARD COUNTY HEALTH DEPARTMENT
ENVIRONMENTAL HEALTH SERVICES
P. O. BOX 476, ELLICOTT CITY, MARYLAND 21043
TELEPHONE: 465-5000, EXT. 356

DISTRICT 4th
DATE 8/15/77

TO: THE COUNTY HEALTH OFFICER
ELLICOTT CITY, MARYLAND

I, HEREBY, APPLY FOR THE NECESSARY TEST IN ORDER TO CONSTRUCT (OR RECONSTRUCT) A SEWAGE DISPOSAL SYSTEM.

PROPERTY OWNER J. & B Partnership

ADDRESS 5632 Stevens Forest Road, Apt. 254, Columbia 21045 PHONE Any questions call Ron Carter - 837-0194

PROPERTY LOCATION:

SUBDIVISION Westcliffe Manor LOT NO. 26

ROAD AND DESCRIPTION off Underwood Road

SIZE OF LOT 42,000 sq. ft. TYPE BLDG. 3 or 4 bedrooms
NUMBER OF BEDROOMS

IF NOT SINGLE RESIDENCE DESCRIBE _____

THE SYSTEM INSTALLED UNDER THIS APPLICATION IS ACCEPTABLE ONLY UNTIL PUBLIC FACILITIES BECOME AVAILABLE.

SIGNATURE OF APPLICANT /s/ Ron Carter


APPROVED BY _____ FOR _____ DATE _____
(KIND OF SYSTEM)

REJECTED BY _____ FOR _____ DATE _____
(KIND OF SYSTEM)

HOLD PENDING FURTHER TESTS _____ DATE _____

REASONS FOR REJECTION OR HOLDING _____

THIS IS NOT A PERMIT

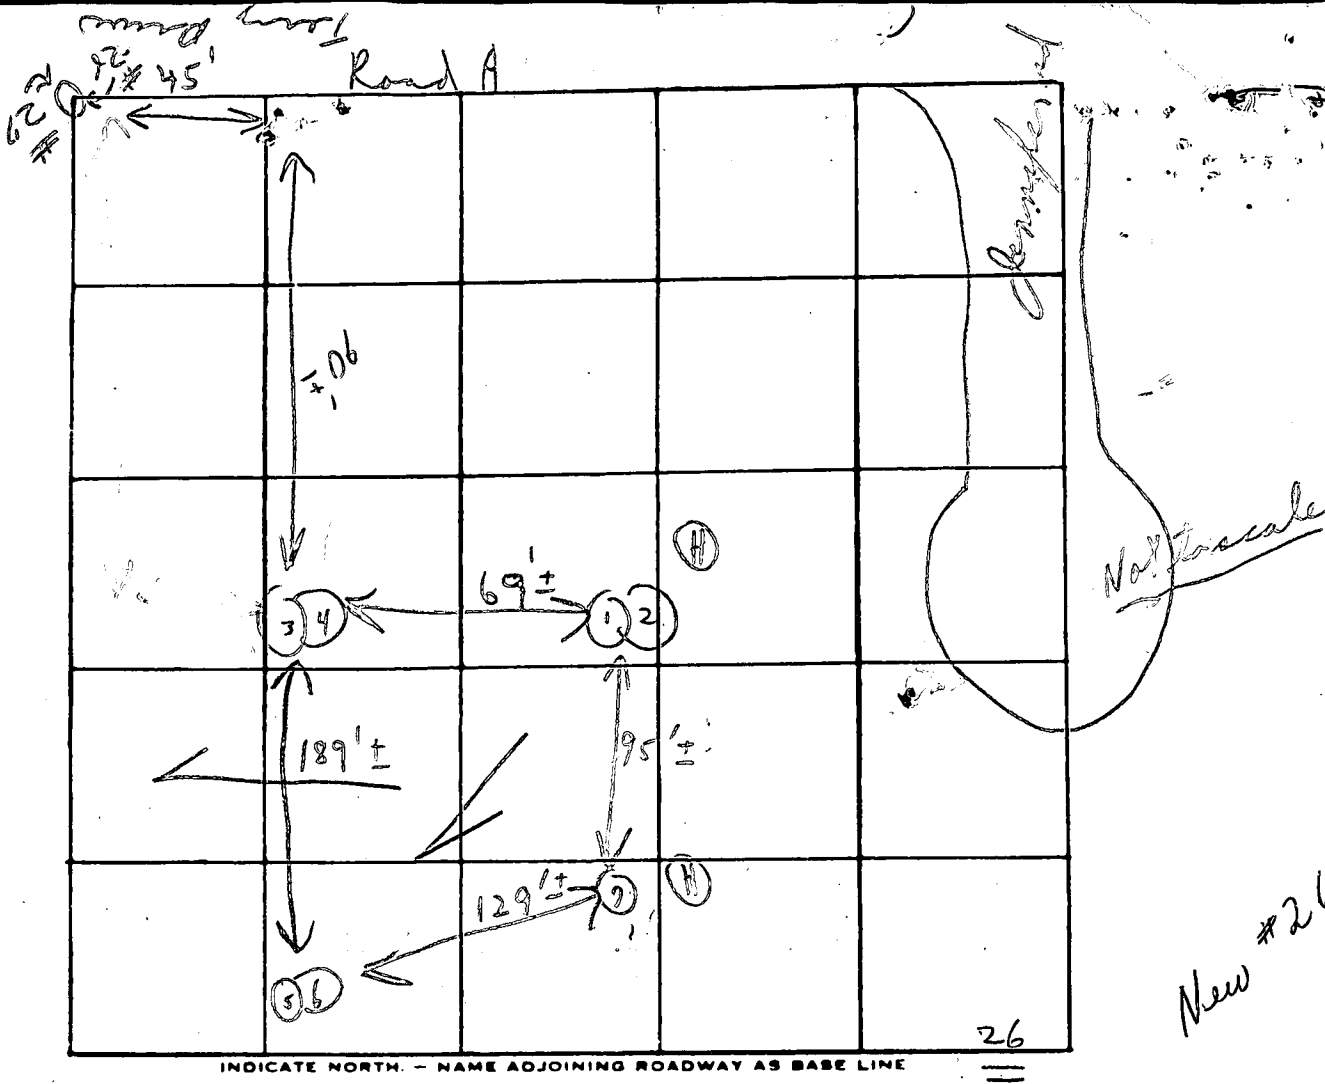

New #26

Soil Profile

DATE	TEST NO.	DEPTH	PRE-WET		TEST - 1" DROP		TIME
			START	STOP	START	STOP	
9/2/77	1	3 1/2'	9:46	9:47	9:47	9:49	2m
	1 2	12'	9:46	9:50	9:50	9:53	4m
	3	2 1/2'	9:48	9:50	9:50	9:54	4m
	4	13' 1/2'	9:48	9:52	9:52	9:57	5m
	5	4'	9:59	10:00	10:00	10:02	2m
	6	13'	9:59	10:02	10:02	10:05	3m
	7	(12'±)	Visual				6:20

Zoom below clay

Highway Note

Use (F07 #7) 3 1/2" 11' main 3m 125 sq ft effective per B.R.

REMARKS Open field

TYPE OF SOIL _____

TESTED BY C.B.S.

ALSO PRESENT: Forks men

M. Steaker,
Kearns Jenkins
permit jr - 8/15/79

(8/15/79

See 8/15/79)
Holding for revisions
Carter engineer in 8/14/79 C.B.

8/16/79 Per V.W.M. need seal
+ certifying statement
and everything in ink. C.B.

Call in P.M. F.C.C.

461-2855

8/16/79 Called spoke to Mrs. Carter.

8/21 { Need revisions in
(1) sink
(2) seal
(3) certifying statement