

PUB. SEWER STATUS VERIFIED BY _____

ISSUE DATE: 08/22/07

P 527314

APPROVAL DATE: 9/12/07

A REPAIR

PERMIT

Logged Into Permit Manager
Tax ID # 04-337905

ON-SITE SEWAGE DISPOSAL SYSTEM HOWARD COUNTY HEALTH DEPARTMENT BUREAU OF ENVIRONMENTAL HEALTH

Fogles Septic Clean, Inc. IS PERMITTED TO INSTALL ALTER

ADDRESS: 580 Obrecht Road PHONE NUMBER: 410-795-5670

SUBDIVISION: Rover Mill Estates LOT NUMBER: 11

ADDRESS: 3187 Danmark Drive PROPERTY OWNER: Donald Franklin

SEPTIC TANK CAPACITY (GALLONS): _____ *Trenches 2' Wide*

PUMP CHAMBER CAPACITY (GALLONS): _____ *Inlet 4'*

NUMBER OF BEDROOMS: _____ *Bottom 8'*

SQUARE FEET PER BEDROOM: _____ *4' of Stone Below Pipe*

LINEAR FEET OF TRENCH REQUIRED: 112' *2-56' Trenches*


TRENCHES:	Trench to be _____ feet wide. Inlet _____ feet below original grade. Bottom maximum depth _____ feet below original grade. Effective area begins at _____ feet below original grade. _____ feet of stone below distribution pipe.
LOCATION:	<i>Pump Out and Fill in Drywell, Place Dist. Box Below Tank and Install Trenches On Contour Across Swale</i>
PURPOSE:	Existing septic system has failed. Call for inspection when ground is opened so sanitarian can recommend repair.

PLANS APPROVED: B. Baker DATE: 8/28/07

- NOTE: PERMIT VOID AFTER 2 YEARS
- NOTE: CONTRACTOR RESPONSIBLE FOR SCHEDULING A PRE-CONSTRUCTION INSPECTION FOR ALL INSTALLATIONS
- NOTE: WATERTIGHT SEPTIC TANKS REQUIRED
- NOTE: ALL PARTS OF SEPTIC SYSTEM SHALL BE 100 FEET FROM ANY WATER WELL
- NOTE: MANHOLE RISERS REQUIRED ON ALL SEPTIC TANKS AND PUMP CHAMBERS

NEITHER THE HOWARD COUNTY COUNCIL OR THE HEALTH DEPARTMENT IS RESPONSIBLE FOR THE SUCCESSFUL OPERATION OF ANY SYSTEM PERMITTEE RESPONSIBLE FOR OBTAINING FINAL APPROVAL ON THIS PERMIT CALL 410-313-2640 FOR INSPECTION OF SEPTIC SYSTEM

NOT TO SCALE

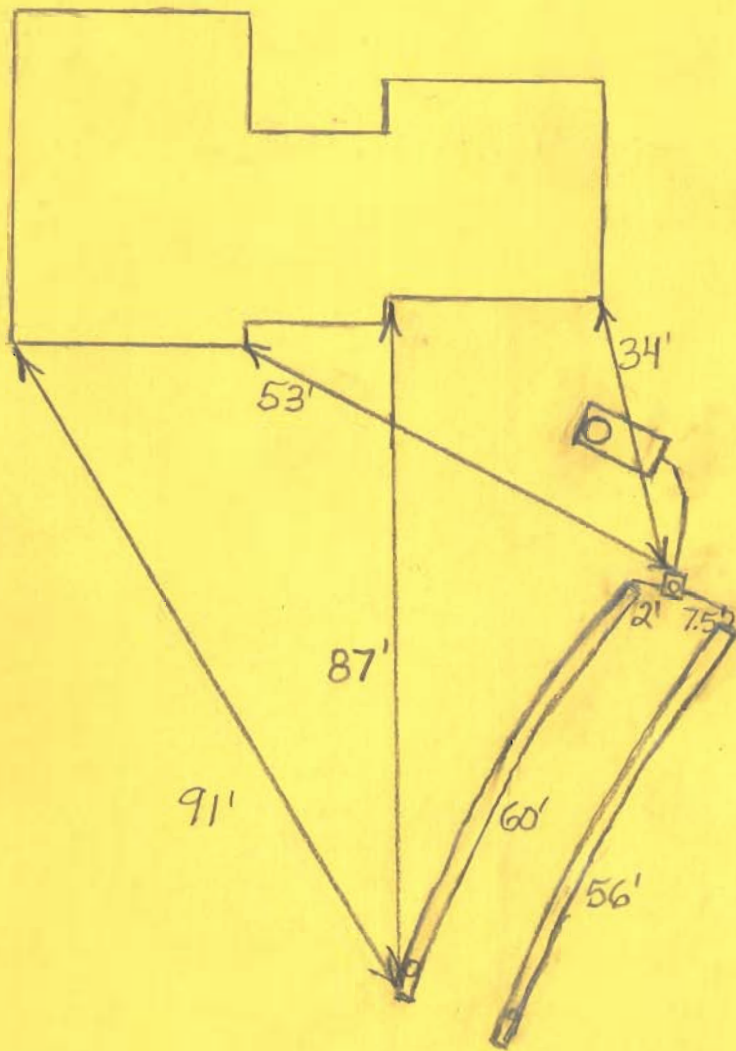

TRENCH/DRAINFIELD DATA		
WIDTH	INLET	BOTTOM
2'	3.5'-4'	8'
NUMBER OF TRENCHES		2
TOTAL LENGTH		116'
ABSORPTION AREA		464+
DISTRIBUTION BOX LEVEL		Levelers
DISTRIBUTION BOX BAFFLE		Yes
DISTRIBUTION BOX PORT		Yes

SEPTIC TANK DATA	
SEPTIC TANK 1 LEVEL	Yes
CAPACITY	Existing GAL
SEAM LOC	Midseam
TANK LID DEPTH	2'-4'
BAFFLES	Yes
BAFFLE FILTER	No
MANHOLE LOC	Front
6" PORT LOC	None
WATERTIGHT TEST	No
SEPTIC TANK 2 LEVEL	N/A
CAPACITY	GAL
SEAM LOC	
TANK LID DEPTH	
BAFFLES	
BAFFLE FILTER	
MANHOLE LOC	
6" PORT LOC	
WATERTIGHT TEST	

PRE-CONSTRUCTION 9/10/07 Met with installer and established where system components are to go. (BB)

INSTALLATION 9/11/07 Started on trenches. (BB)

9/12/07 System finished except for connection to dist. box and drywell abandonment. O.K. to cover when done. (BB)

FINAL INSPECTOR B. Baker DATE OF APPROVAL 9/12/07