

1/3/00
10:00
1/19/00 10am

PERMIT

SEWAGE DISPOSAL SYSTEM

DEPARTMENT OF HEALTH AND MENTAL HYGIENE

P 513208

A REPAIR

DISTRICT _____

DATE 1/3/2000

HOWARD COUNTY HEALTH DEPARTMENT

BUREAU OF ENVIRONMENTAL HEALTH

~~XXXXXXXX~~ 410-313-2640

RPS#?

DATE SYSTEM APPROVED 1/2/2000

INSPECTOR [Signature]

INDEXED

Arnold's Backhoe & Septic Service, Inc. IS PERMITTED TO INSTALL _____ ALTER X

ADDRESS P. O. Box 15 Woodbine, Maryland 21797 PHONE 410-795-3869

SUBDIVISION Everlea LOT 2 ROAD 1538 1545 Henryton Road

PROPERTY OWNER Dorothy & Dennis Turner

ADDRESS 1545 Henryton Road
Marriottsville, Maryland 21104

SEPTIC TANK CAPACITY existing 1000 GALLONS

NUMBER OF BEDROOMS 3

_____ SQUARE FEET PER BEDROOM

LINEAR FEET OF TRENCH REQUIRED _____

REPAIR - PURPOSE - SEPTIC SYSTEM HAS FAILED.

Call for inspection when ground is opened so sanitarian can recommend repair.

Install one 70 ft long trench connects to existing dry well. 12/30/99

Trench to be 2ft wide, 8ft deep, inlet @ 3 1/2 or 4', 4ft stone fill. Replace baffle in
of septic tank

PLANS APPROVED BY _____ DATE _____

COVER NO WORK UNTIL INSPECTED AND APPROVED

NEITHER THE HOWARD COUNTY COUNCIL NOR THE HEALTH DEPARTMENT IS RESPONSIBLE FOR THE SUCCESSFUL OPERATION OF ANY SYSTEM

NOTE: CLEANOUT REQUIRED EVERY 70 FEET OF SEWER LINE AND/OR AT 90° SWEEPS IN LINES FROM HOUSE TO DRAIN FIELDS. 90° ELBOWS NOT ACCEPTABLE.

NOTE: ALL PARTS OF SEPTIC SYSTEMS (I.E. TANK, DISTRIBUTION BOX TRENCHES) TO BE 100 FEET FROM WELL (UNLESS OTHERWISE SPECIFICALLY AUTHORIZED)

NOTE: IF DEEP TRENCH(ES) ARE USED CALL FOR INSPECTION BEFORE AND AFTER PLACING GRAVEL IN TRENCH(ES)

NOTE: NO DRY WELL SHALL EXCEED 15 FOOT IN DIAMETER NO ABSORPTION TRENCH TO EXCEED 100 FEET IN LENGTH

NOTE: ALL PIPE FROM HOUSE TO SEPTIC TANK MUST BE CAST IRON OR SCHEDULE 35/40 PVC OR ABS

PERMIT VOID AFTER TWO YEARS

NOTE: INSTALL STAND PIPE ON SEPTIC TANK AND DRY WELL STAND PIPES MUST BE 6 INCHES IN DIAMETER CAST IRON. CONCRETE OR TERRA COTTA OR PVA OR ASS ACCEPTED. IF TOP OF SEPTIC TANK IS DEEPER THAN 3 FEET. MANHOLE TO GRADE REQUIRED.


NOTE: DISTRIBUTION BOXES MUST HAVE BAFFLES

***INSTALLER IS RESPONSIBLE FOR OBTAINING FINAL APPROVAL ON THIS PERMIT**

*CALL 461-9933 FOR INSPECTION OF SEPTIC SYSTEM.

P513208

Test Hole
 A
 1' micaceous fill
 2' dark brown
 Topsoil
 Reddish
 4' mid red brown
 Mica
 (No stones
 seen)
 15'

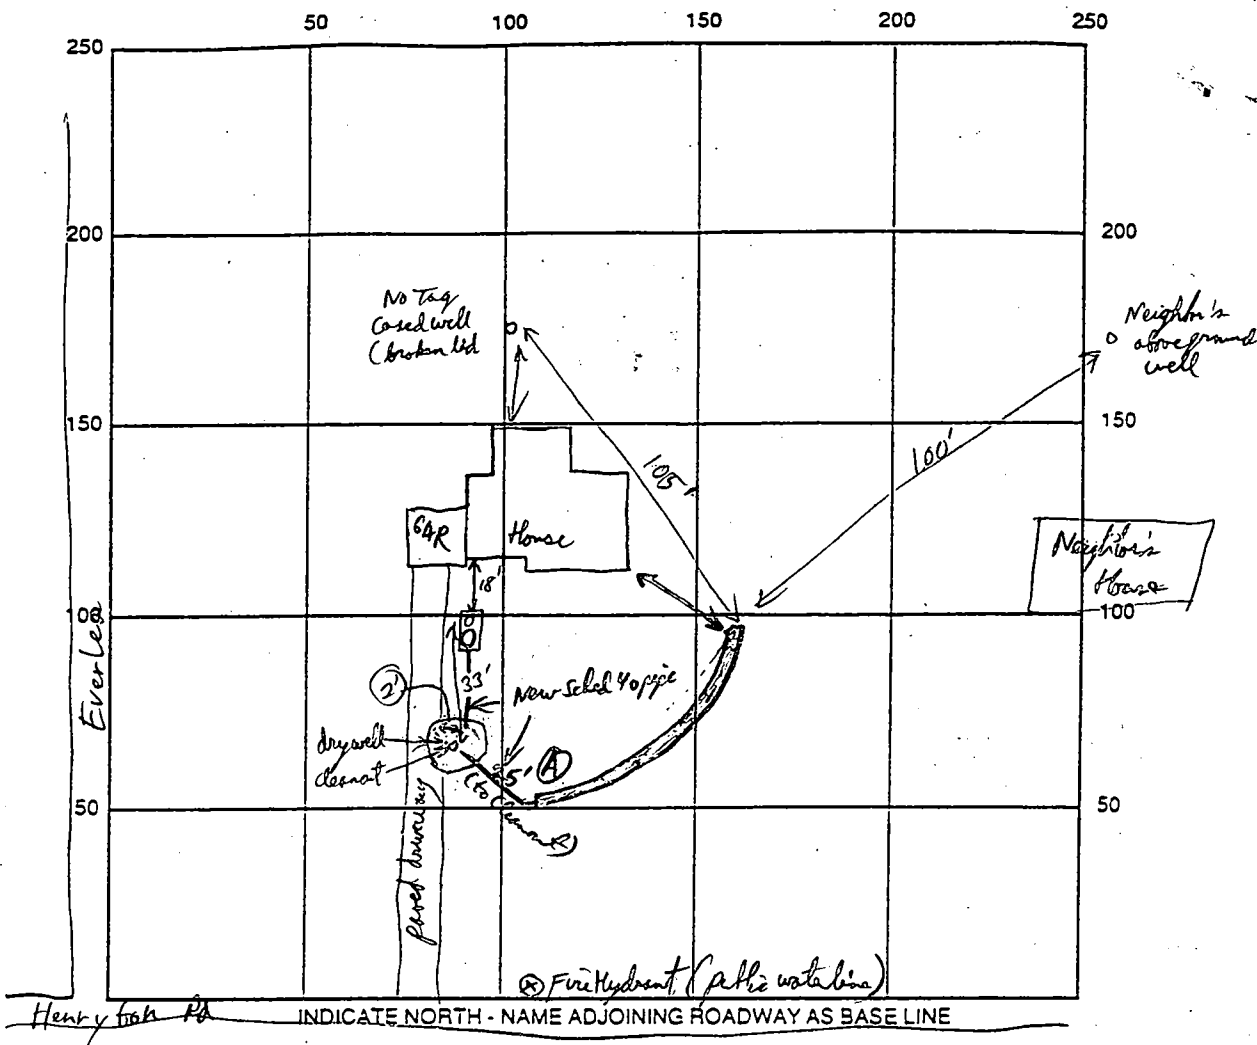

SEPTIC TANK LEVEL existing 1000 gal. septic tank CLEANOUTS New Manhole riser above outfall side of S.T.

DISTRIBUTION BOX LEVEL NA

DRAIN FIELD/TITLE DEPTH 8 FT. TRENCH WIDTH 2 FT. INLET DEPTH 4' FT.

EFFECTIVE GRAVEL DEPTH 4 FT. TOTAL LENGTH 7.2 FT.

NUMBER OF TRENCHES one ONE SIDEWALL/BOTTOM AREA 288 SQ. FT.

DRYWALL INSIDE DIAMETER existing FT. EFFECTIVE DEPTH BELOW INLET _____ FT.

ABSORBENT AREA _____ SQ. FT. 1/2" T" Baffle - used as second "settling" tank.

REMARKS: Septic Tank, connecting pipes, Manhole riser over S.T. all OK to cover. P/P 1/3/00
Baffle in S.T. OK + No odor OK ("T" = sch 40) P/P 1/4/2000

DATE SYSTEM APPROVED 1/3/2000 INSPECTOR Donald Stanley

8/16/72

File

INDEXED

9/16/72
Final OK
RT.

PERMIT

P 16792

SEWAGE DISPOSAL SYSTEM

A 16687

MARYLAND STATE DEPARTMENT OF HEALTH

HOWARD COUNTY

ELLICOTT CITY

DISTRICT 2

DATE 2/29/72

Everett Ramsey & wife IS PERMITTED TO INSTALL R ALTER

ADDRESS 1450 Henryton Road, Marriottsville, Md. PHONE 328-2696

A SEWAGE DISPOSAL SYSTEM LOCATED AT _____

SUBDIVISION Everlea ROAD Henryton LOT 2, Blk. B, Sec. 2

PROPERTY OWNER same as above

ADDRESS _____

SPECIFICATIONS - 3 bedrooms

DRAIN FIELD _____ DEPTH _____ FEET. BOTTOM AREA _____ SQ. FT.

SEEPAGE PITS _____ ABSORBENT SIDE-WALL AREA _____ SQ. FT.

SEPTIC TANK CAPACITY 1,000 GALLONS

FOR GARBAGE GRINDER, INCREASE DISPOSAL AREA 22% & TANK CAPACITY 50%.

OTHER Dry wall - 300 sq. ft. absorbent sidewall area below inlet pipe. Inlet pipe to be 6 ft. below original grade. Location 70 ft. from right side line and 60 ft. from edge of road as seen from Henryton Road.
*Maximum depth 17 1/2' below original grade
4/1/72 To bring coded in at 3'-5' depths as discussed with Mr. [unclear] area not counted in absorption area*

NOTE: ALL PIPE FROM HOUSE TO SEPTIC TANK MUST BE CAST IRON.

PERMIT VOID AFTER THREE YEARS.

NOTE: INSTALL STAND PIPE ON SEPTIC TANK AND DRY WELL.


PLANS APPROVED BY C. Streater DATE 1/27/72

FILL SEPTIC TANK AND DISTRIBUTION BOX WITH WATER BEFORE CALLING FOR AN INSPECTION. COVER NO WORK UNTIL INSPECTED AND APPROVED.

NEITHER THE HOWARD COUNTY COMMISSIONERS NOR THE HEALTH DEPARTMENT IS RESPONSIBLE FOR THE SUCCESSFUL OPERATION OF ANY SYSTEM

16687

REVERSE

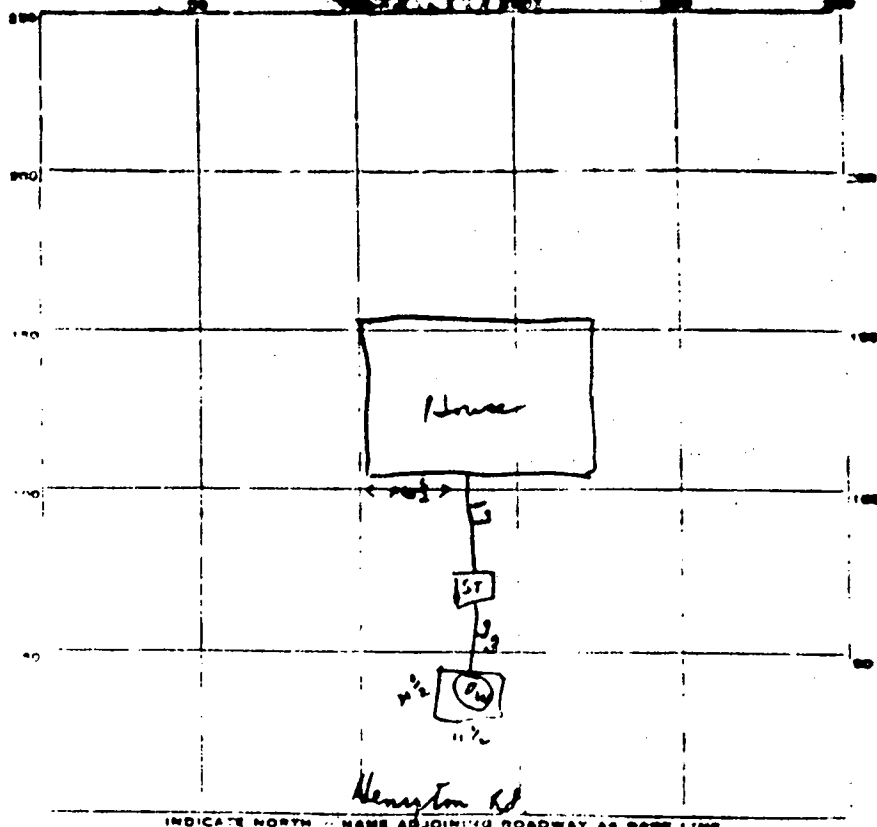


INDICATE NORTH NAME ADJOINING ROADWAY AS BASE LINE

TERM: Signed
 DATE: 10/09/01 CLEANOUTS: OK
 LOCATION ON BOX, LEVEL: _____
 TRENCH DEPTH _____ FT. TRENCH WIDTH _____ FT.
 GRAVEL DEPTH _____ IN. TOTAL LENGTH _____ FT.
 NUMBER OF TRENCHES _____ TOTAL BOTTOM AREA _____
 SEPARATE PITS: outside perimeter INSIDE DIAMETER 11 1/2 x 11 1/2 FT. DEPTH BELOW INLET 11 (10ft effective) FT.
 ABSORBENT AREA 460 SQ. FT.

9/6/02 materials made up cement blocks constructed on S Tank.

APPROVED 9/6/02 INSPECTOR R. Tene

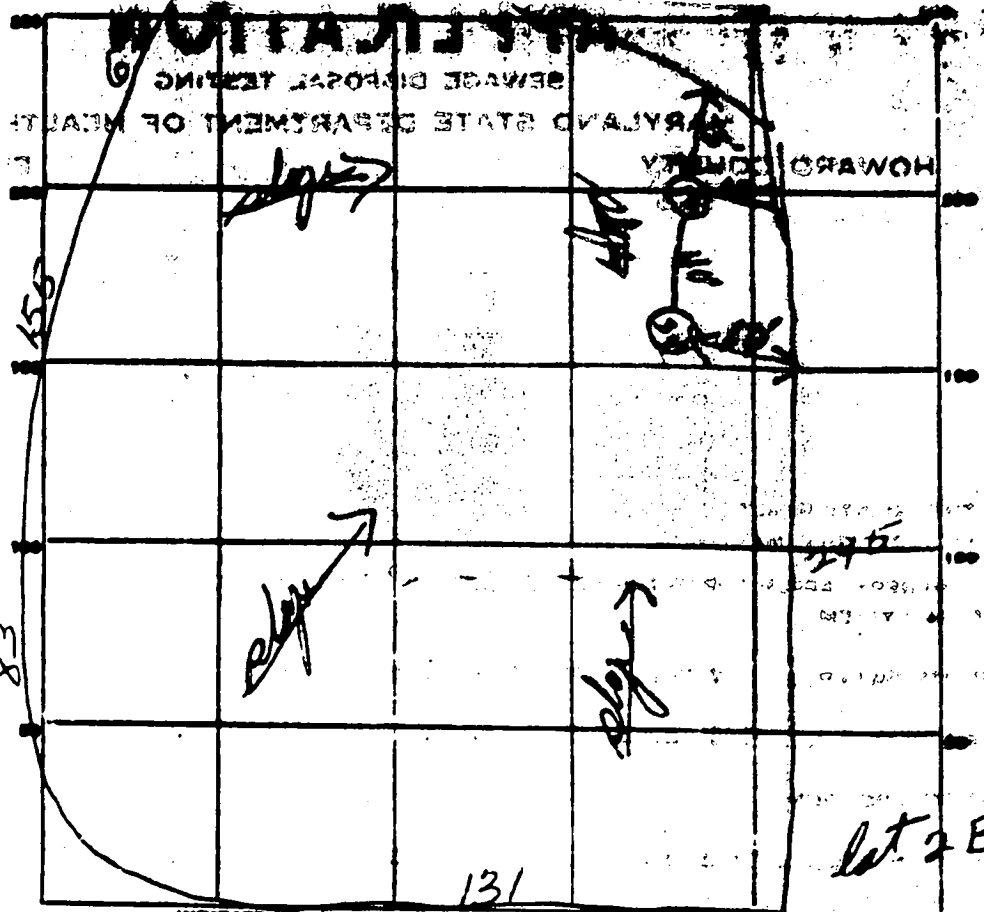


INDICATE NORTH - NAME ADJOINING PROPERTY AS ONE LINE
Henrietta Rd

DATE	TEST NO.	DEPTH	PRE-WET		TEST - 1" DROP		TIME
			START	STOP	START	STOP	
	1	11'	11 ²⁸	11 ²⁹	11 ²⁹	11 ²⁶	3 min
	2	4'	11 ³⁰	11 ³²	11 ²²	11 ³⁴	2 min
	3	12'	11 ²⁸	11 ²⁹	11 ²⁹	11 ³⁴	5 min
	4	4'	11 ²⁹	11 ³⁰	11 ³⁰	11 ³³	3 min

4 min

SOIL AUGER FINDING _____
 TESTED BY *[Signature]* _____
 REMARKS *inlet 3 1/2 ft use hole 132* _____

HOWARD COUNTY MARYLAND STATE DEPARTMENT OF HEALTH SEWAGE DISPOSAL TESTING

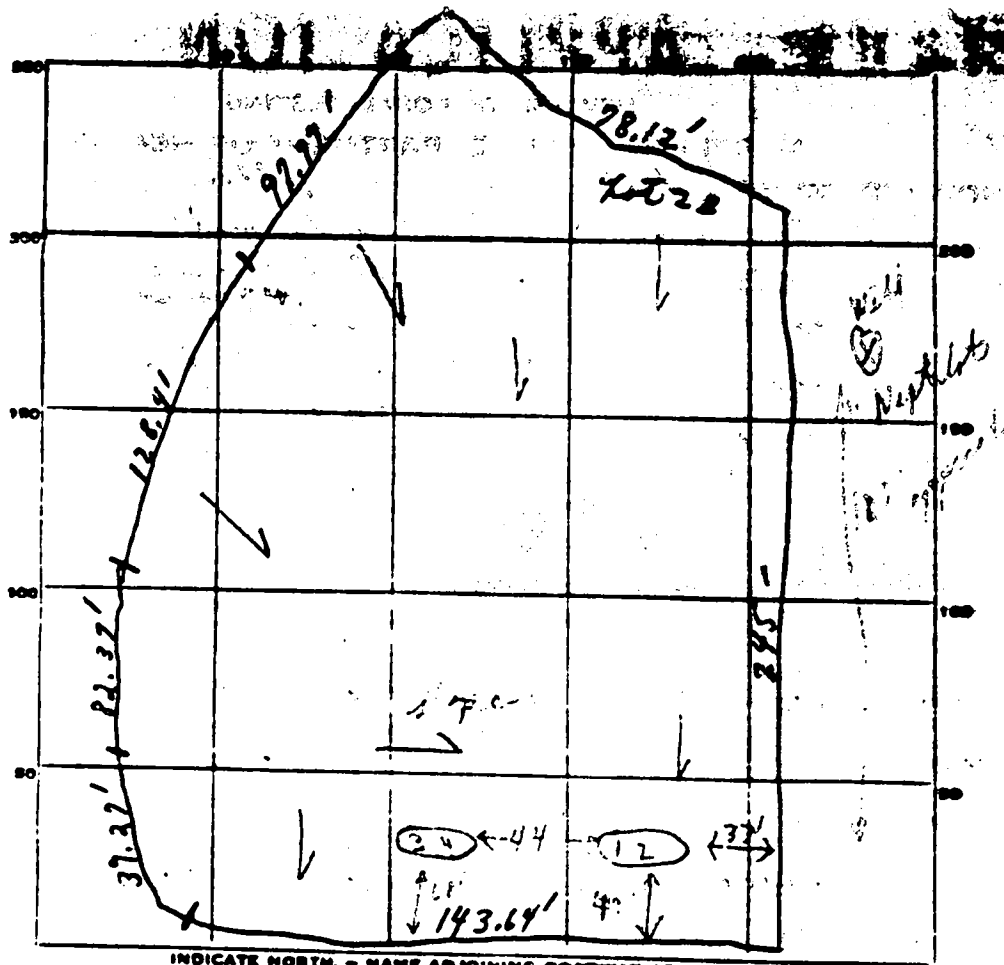

Heaton Road

DATE	TEST NO.	DEPTH	PRE-WET		TEST - 1" DROP		TIME
			START	STOP	START	STOP	
1/25/72	1						} Max did not show today holes!
	2						
	3						
	4						
1/27	1	6'	9:44	9:52	9:52	10:01	} 19 min } 6 min
	2	12'	9:38	9:47	9:48	9:42	
	4	6'	10:24	10:29	10:29	10:40	
	5	12 1/2'	10:14	10:16	10:16	10:18	


SOIL AUGER FINDING _____

TESTED BY B.S. 1/27/72

REMARKS slaked in at 6' Use hole 3+4



EVERLEA

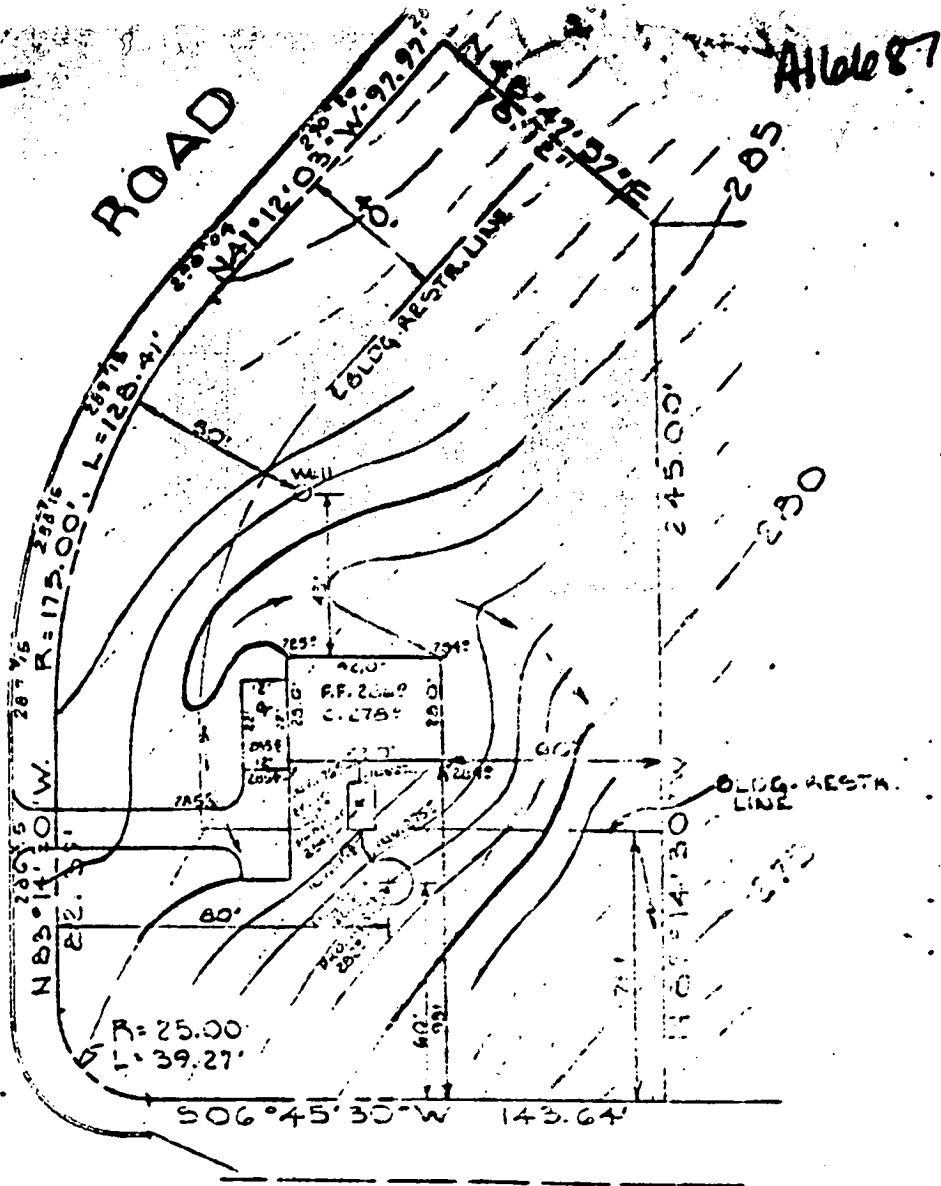

Alld 87

HENRYTON ROAD

OK'd
CBS
2/7/92

PLOT PLAN
LOT 2, BLOCK B
SECTION - 2
EVERLEA

BLANK