

PERMIT

SEWAGE DISPOSAL SYSTEM

DEPARTMENT OF HEALTH AND MENTAL HYGIENE

P 513211-D

A REPAIR

DISTRICT _____

RPS# 297810

DATE 1/5/2000

HOWARD COUNTY HEALTH DEPARTMENT

BUREAU OF ENVIRONMENTAL HEALTH

HEH-9933 313-2640

DATE SYSTEM APPROVED 5/9/97

INDEXED

INSPECTOR *[Signature]*

Jack Fyock Septic Service IS PERMITTED TO INSTALL ALTER X

ADDRESS 13775 Triadelphia Road, Glenelg, MD 21737 PHONE 988-9270

SUBDIVISION Evergreen Valley Estates LOT 33, Sect. 6 ROAD 3135 Evergreen Way

PROPERTY OWNER Linda Twardowicz

ADDRESS _____

SEPTIC TANK CAPACITY 1000 pump chamber existing GALLONS

NUMBER OF BEDROOMS 4.5

180 SQUARE FEET PER BEDROOM

LINEAR FEET OF TRENCH REQUIRED 120

180
x4
61720
120

150ft trench needed for 5 chambers

Top Seamed Pump Chamber Required 1/10/23/95

REPAIR - PURPOSE - SEPTIC SYSTEM HAS FAILED.

Call for inspection when ground is opened so sanitarian can recommend repair.
OK to dis connect old Dry well. Need a pump & pump chamber to pump to trench on high side
Install two 60ft long trenches, 2ft wide, 6ft deep. of lot.
- Inlet depth 2 feet. OK
- Maximum bottom depth 8 feet. OK

RPS 8/23/95

owner says addition (already built) give 5 Bedrooms House

PLANS APPROVED BY *[Signature]* DATE 8/23/95

COVER NO WORK UNTIL INSPECTED AND APPROVED

NEITHER THE HOWARD COUNTY COUNCIL NOR THE HEALTH DEPARTMENT IS RESPONSIBLE FOR THE SUCCESSFUL OPERATION OF ANY SYSTEM

NOTE: CLEANOUT REQUIRED EVERY 70 FEET OF SEWER LINE AND/OR AT 90° SWEEPS IN LINES FROM HOUSE TO DRAIN FIELDS, 90° ELBOWS NOT ACCEPTABLE.

NOTE: ALL PARTS OF SEPTIC SYSTEMS (I.E. TANK, DISTRIBUTION BOX TRENCHES) TO BE 100 FEET FROM WELL (UNLESS OTHERWISE SPECIFICALLY AUTHORIZED)

NOTE: IF DEEP TRENCH(ES) ARE USED CALL FOR INSPECTION BEFORE AND AFTER PLACING GRAVEL IN TRENCH(ES)

NOTE: NO DRY WELL SHALL EXCEED 15 FOOT IN DIAMETER NO ABSORPTION TRENCH TO EXCEED 100 FEET IN LENGTH

NOTE: ALL PIPE FROM HOUSE TO SEPTIC TANK MUST BE CAST IRON OR SCHEDULE 35/40 PVC OR ABS

PERMIT VOID AFTER TWO YEARS

NOTE: INSTALL STAND PIPE ON SEPTIC TANK AND DRY WELL STAND PIPES MUST BE 6 INCHES IN DIAMETER CAST IRON. CONCRETE OR TERRA COTTA OR PVA OR ABS ACCEPTED. IF TOP OF SEPTIC TANK IS DEEPER THAN 3 FEET. MANHOLE TO GRADE REQUIRED.

NOTE: DISTRIBUTION BOXES MUST HAVE BAFFLES


Addition - Pool
BLDG. PERMIT SIGNED
AND RETURNED 8-30-95
Serial # 61538

*INSTALLER IS RESPONSIBLE FOR OBTAINING FINAL APPROVAL ON THIS PERMIT

R519211-D

Hole A
Thin horizon
Mix Brown, Tan
and Cream
colored
Hica SL

Hole B
Thin horizon
dark brown
Light colored
Tan, tan, cream
Hica SL
v. dark brown
co SL
10% Hazy
slight
water seepage

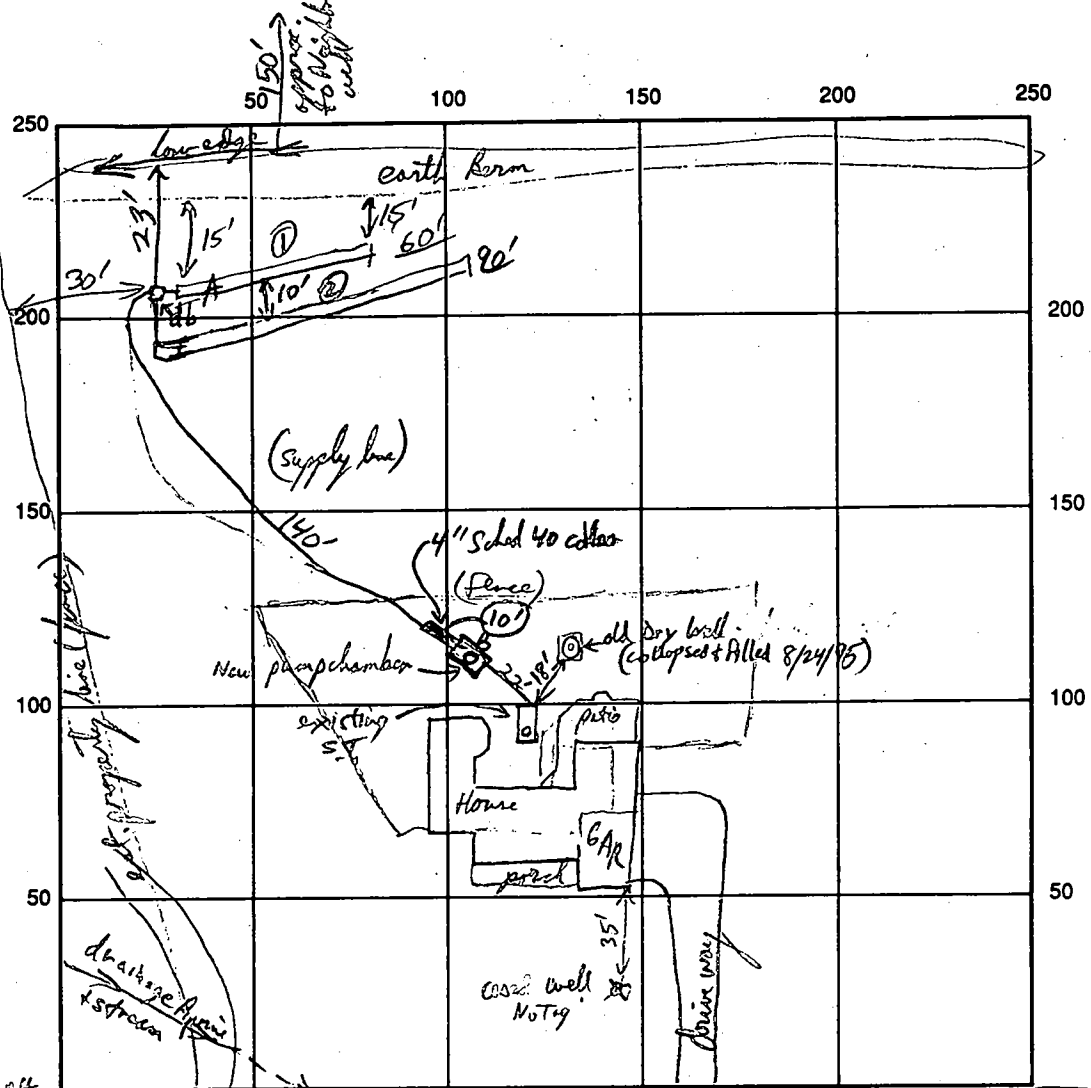

INDICATE NORTH - NAME ADJOINING ROADWAY AS BASE LINE Evergreen way

Pump chamber 1000gal Top Seamed

SEPTIC TANK LEVEL 1200 gal existing CLEANOUTS existing S.T.

DISTRIBUTION BOX LEVEL

DRAIN FIELD/TITLE DEPTH 8 FT. TRENCH WIDTH 2 FT. INLET DEPTH 2 FT.

EFFECTIVE GRAVEL DEPTH 6 FT. TOTAL LENGTH 60/90 FT. = 150 Ft total

NUMBER OF TRENCHES 2 ONE SIDEWALL/BOTTOM AREA _____ SQ. FT.

DRYWALL INSIDE DIAMETER _____ FT. EFFECTIVE DEPTH BELOW INLET _____ FT.

ABSORBENT AREA _____ SQ. FT.

REMARKS: Excavation for pump chamber has very dark brown coarse sand, brown and water seepage at 9-10 ft.
Use a Top Seamed pump chamber, OK to cover trenches when finish gravel filling. Need to
call for pump test and supply line check out. 8/23/95 RPP 2" flexible supply line OK to cover,
Dry well being collapsed & filled, OK RPP 8/24/95 5/9/97 PUMP + CONTROL OPERATION (ALARM)
CHECK - OK. RPP FINAL WHEN PAID (epoch NOT IN USE 5-9-97)

DATE SYSTEM APPROVED 5/9/97 INSPECTOR [Signature]

12/12/72

PERMIT

SEWAGE DISPOSAL SYSTEM

MARYLAND STATE DEPARTMENT OF HEALTH

HOWARD COUNTY

INDEXED

ELLICOTT CITY

DISTRICT 3

DATE 7/14/72

P 17219

A 14226

Hudson Construction Co., Inc. IS PERMITTED TO INSTALL ALTER

ADDRESS 363 Chapel Avenue, Ellicott City, Md. PHONE Ho 5-2205

A SEWAGE DISPOSAL SYSTEM LOCATED AT _____

SUBDIVISION Evergreen Valley Estates ROAD Evergreen Way LOT 33, Sect. 6

PROPERTY OWNER Hudson Construction Co., Inc. Linda Twardowicz

ADDRESS same as above

SPECIFICATIONS 4 bedrooms

DRAIN FIELD _____ DEPTH _____ FEET, BOTTOM AREA _____ SQ. FT.

SEEPAGE PITS _____ ABSORBENT SIDE-WALL AREA _____ SQ. FT.

SEPTIC TANK CAPACITY 1200 GALLONS

FOR GARBAGE GRINDER, INCREASE DISPOSAL AREA 22% & TANK CAPACITY 50%.

OTHER DRY WELL * To be 100 sq. ft. absorbent sidewall are below the inlet pipe per bedroom. Maximum depth of dry well to be 19 ft. below original grade. Locate dry well 192 ft. from rear lot line and 84 ft. from right side line as lot is seen from standing on Evergreen Way facing lot.

NOTE: ALL PIPE FROM HOUSE TO SEPTIC TANK MUST BE CAST IRON.

PERMIT VOID AFTER THREE YEARS.

NOTE: INSTALL STAND PIPE ON SEPTIC TANK AND DRY WELL.


PLANS APPROVED BY James T. Wright DATE 6/16/70

FILL SEPTIC TANK AND DISTRIBUTION BOX WITH WATER BEFORE CALLING FOR AN INSPECTION. COVER NO WORK UNTIL INSPECTED AND APPROVED.

NEITHER THE HOWARD COUNTY COMMISSIONERS NOR THE HEALTH DEPARTMENT IS RESPONSIBLE FOR THE SUCCESSFUL OPERATION OF ANY SYSTEM.

BLDG. PERMIT SIGNED
AND RETURNED 10/22/93
Serial # 57857-
1 Story Addition

A 14226

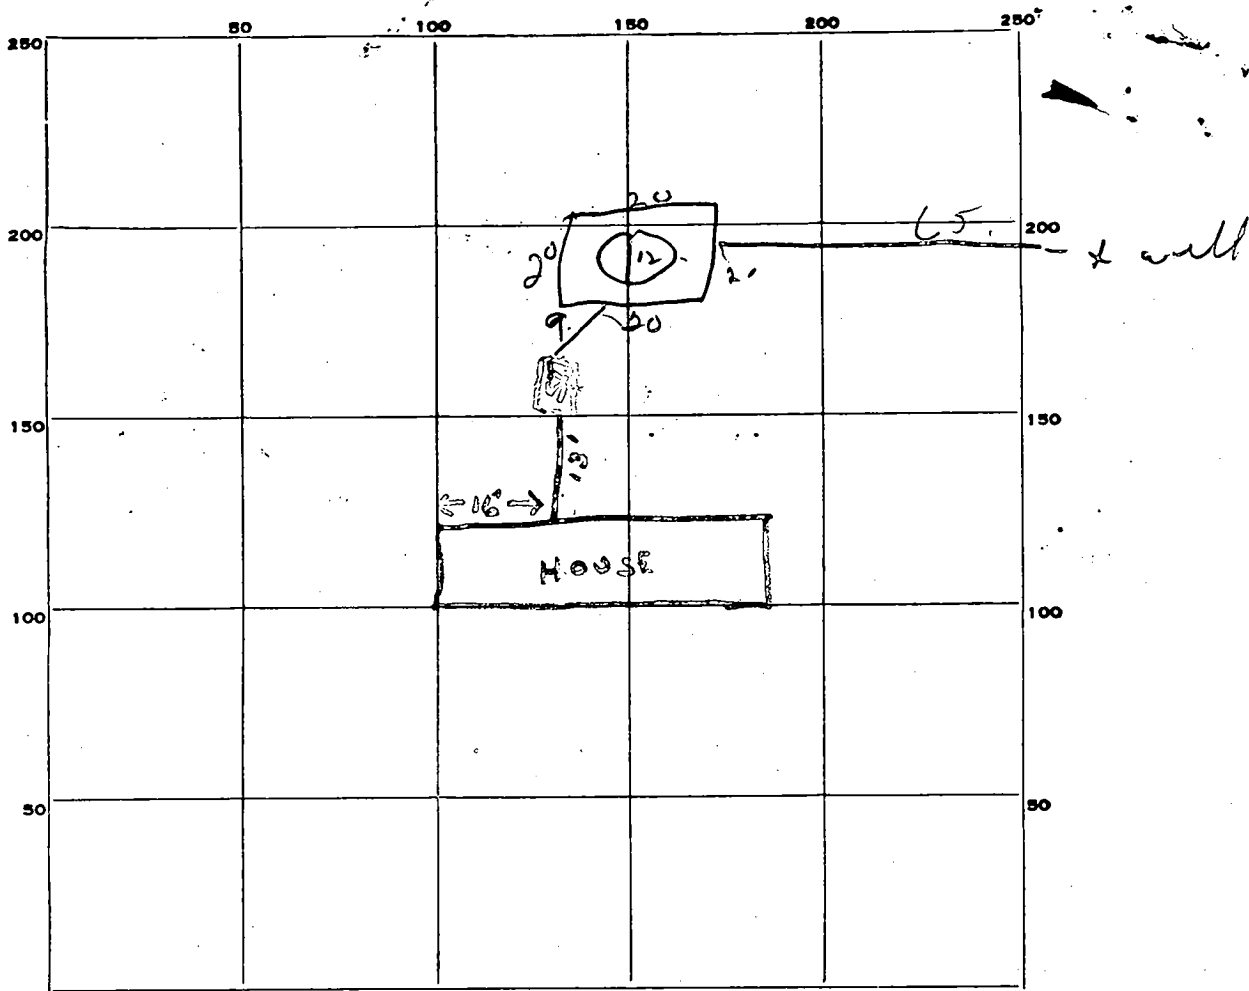

PERMIT CARD OK

SEPTIC TANK, LEVEL OK CLEANOUTS OK

DISTRIBUTION BOX, LEVEL _____

TILE FIELD, DEPTH _____ FT. TRENCH WIDTH _____ FT.

GRAVEL DEPTH _____ IN. TOTAL LENGTH _____ FT.

NUMBER OF TRENCHES _____ TOTAL BOTTOM AREA _____

SEEPAGE PITS, INSIDE DIAMETER 80 FT. DEPTH BELOW INLET 6 FT.

ABSORBENT AREA 480 SQ. FT.

REMARKS 10/27/72 - Septic tank not level - to be structural to level.

R.T.

DATE SYSTEM APPROVED 12/14/72 INSPECTOR [Signature]

APPLICATION

A 14226

P _____

SEWAGE DISPOSAL TESTING

MARYLAND STATE DEPARTMENT OF HEALTH

HOWARD COUNTY *Light Tower for 3 February 1900* ELLICOTT CITY

DISTRICT 3

DATE 1/17/69

*Very Well to be 100 sq ft at Apartment Building
 10 ft below the inlet pipe per. Feb room (maximum)
 Depth of Dry Well to be 10 ft below original grade
 facade Dry well 19' ft from rear lot line and 24 ft from right
 side line. as lot is seen from standing on Evergreen way
 facing lot - Max Depth of Dry Well is 9 ft below org grade*

TO: THE COUNTY HEALTH OFFICER
ELLICOTT CITY, MARYLAND

I, HEREBY, APPLY FOR THE NECESSARY TESTS IN ORDER TO CONSTRUCT (OR RECONSTRUCT) A SEWAGE DISPOSAL SYSTEM.

PROPERTY OWNER Hudson Construction Co., Inc.

ADDRESS 363 Chapel Avenue, Ellicott City, Md. PHONE HO 5-2205

PROPERTY LOCATION:

SUBDIVISION Evergreen Valley Estates LOT NO. 33, Sec. 6

ROAD AND DESCRIPTION Evergreen Way

OCCUPANT _____ PHONE _____

PERSON TO CONSTRUCT SYSTEM _____

ADDRESS _____ PHONE _____

SIZE OF LOT 140' x 340' x 120' x 325' TYPE BLDG. 3 or 4
NUMBER OF BEDROOMS

IF NOT SINGLE RESIDENCE DESCRIBE _____

SIGNATURE OF APPLICANT /s/ Madeline Leonardi

APPROVED BY James T. Wagner FOR Dry Well (KIND OF SYSTEM) DATE 6/26/70


REJECTED BY _____ FOR _____ (KIND OF SYSTEM) DATE _____

HOLD PENDING FURTHER TESTS _____ DATE _____

REASONS FOR REJECTION OR HOLDING _____

THIS IS NOT A PERMIT

64
197

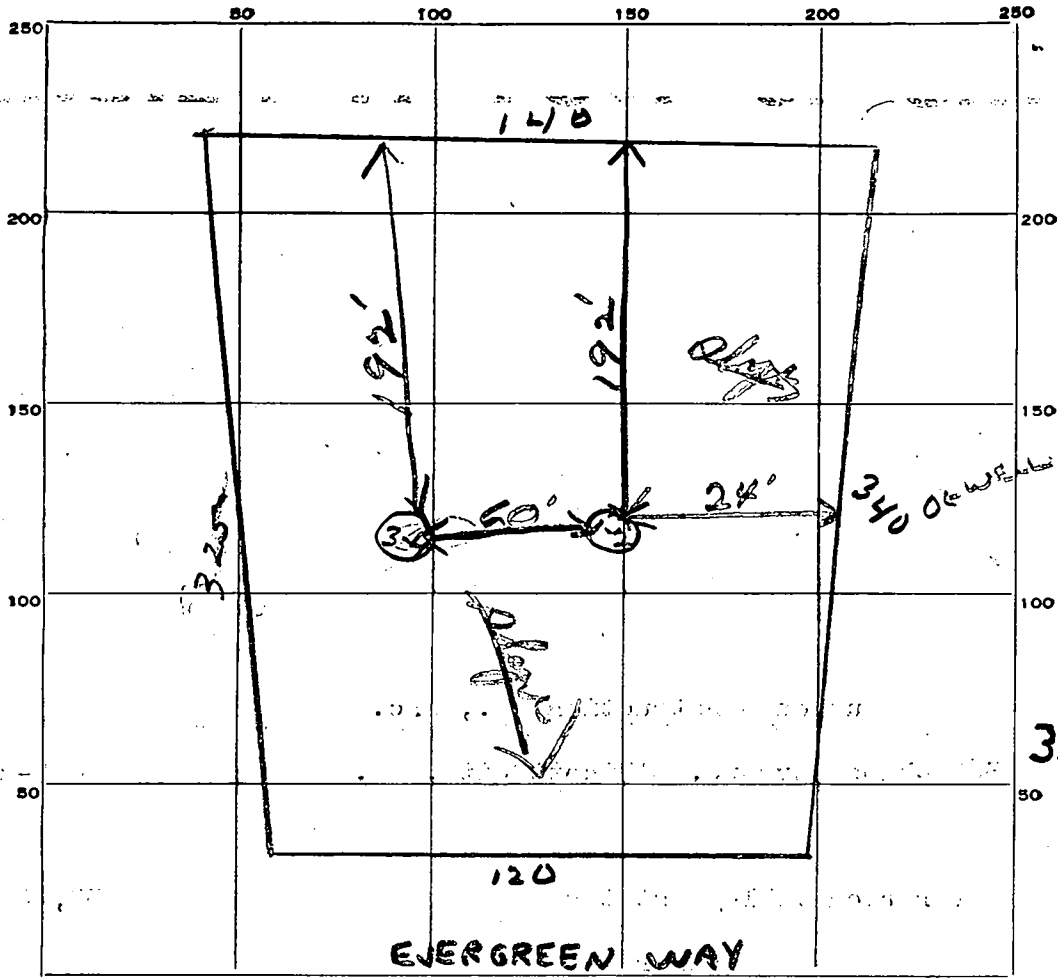

33-6

DATE	TEST NO.	DEPTH	PRE-WET		TEST - 1" DROP		TIME
			START	STOP	START	STOP	
11/26/69	1	9'	11:12	11:13	11:13	11:15	2 min
	2	4'	11:12	11:14	11:14	11:16	2 min
	3	9'	11:19	11:20	11:20	12:24	4 min
	4	4'	11:12	11:19	11:19	11:21	2 min

4510
8000 AC

SOIL AUGER FINDING _____
 TESTED BY *[Signature]* _____
 REMARKS _____

514°-07'-54"E - 144.12' - 445

LOT 33
SECTION SIX
EVERGREEN VALLEY
ESTATES

110'

40'

WATER WELL
ELEV. 455.0

N67°-12'-29"E - 330.94'

S71°-39'-34"W - 338.11'

ELEV. AT TIME OF PERM. TEST
430.0

EX. ELEV. 430.0
INV. ELEV. 426.0
INV. 426.5

INV. 427.0
25'

F.F. 431.0

50' DRAINAGE EASEMENT
75' BUILDING SETBACK LINE

65' OR F.F.

Well

OK
1-28-72

N02°-17'-56"W
15.00' / L=105.00' R=375.00'

EVERGREEN WAY

I CERTIFY THAT THE MEASUREMENTS
AND ELEVATIONS SHOWN ON THIS
PLAT ARE ACTUAL AND CORRECT
FOR THIS PROPERTY.

Oliver F. Ratych 1/10/72



APR
Associated Land Surveyors
A. P. RATYCH
205 N. MAIN ST.
ELICOTT CITY, MD 21221
PHONE: 800-7765

PLAT TO ACCOMPANY
APPLICATION FOR
BUILDING PERMIT
FOR
HUDSON CONSTRUCTION CO.
8957 CHAPEL AVENUE
ELICOTT CITY, MARYLAND

SCALE: 1"=50' JANUARY 11, 1972

514°-07'-54"E - 144.12' - 445

LOT 33
SECTION SIX
EVERGREEN VALLEY
ESTATES

WATER WELL
ELEV. 455.0

ELEV. AT TIME OF PERM. TEST
430.0

EX. ELEV. 430.0
INV. ELEV. 426.0

INV. 426.5

F.F. 431.0

15' BUILDING SETBACK LINE

50' DRAINAGE EASEMENT

N02°-17'-56"W
15.00' L=105.00' R=375.00'

EVERGREEN WAY

I CERTIFY THAT THE MEASUREMENTS
AND ELEVATIONS SHOWN ON THIS
PLAT ARE ACTUAL AND CORRECT
FOR THIS PROPERTY.

Overland J. Ratych 1/11/72



ap
Associates  land surveyors

A. P. RATYCH, E. S.

205 N. MAIN ST.
BALTIMORE, MD. 21201
PHONE: 800-7766

3720 GREENBAY AVE.
BALTIMORE, MD. 21206
PHONE: 496-0771

PLAT TO ACCOMPANY
APPLICATION FOR
BUILDING PERMIT
FOR
HUDSON CONSTRUCTION CO.
8957 CHAPEL AVENUE
ELLCOTT CITY, MARYLAND

SCALE: 1"=50'

JANUARY 11, 1972

B 1 104778
 1 2 3 (SEQ. NO.) 6
 (THIS NUMBER IS TO BE PUNCHED IN COLS. 3-6 ON A&L CARDS)

STATE OF MARYLAND
 DEPARTMENT OF WATER RESOURCES
 STATE OFFICE BLDG., ANNAPOLIS, MARYLAND 21401
 APPLICATION FOR PERMIT TO DRILL WELL

DWR PERMIT NUMBER
 HA-93-5050
 FILL IN THIS FORM COMPLETELY

DATE RECEIVED (DWR USE ONLY)
 10/27/72
 9:30 A.M.

OWNER Nudson Const. Co.
 COL 15 LAST NAME COL. 34 FIRST NAME
 STREET OR RFD 8957 Chapline
 COL 36 COL. 55
 POST OFFICE Ellicott City Md.
 COL 57 COL. 76

B 1 CONTINUED DRILLER INFORMATION
 1 2 3 (SEQ. NO.) 6
 DATE 7-27-72 LICENSE NUMBER 479
 77 78 79 80
A. J. Costello
 FIRST NAME DRIVER LAST NAME
 SIGNATURE A. J. Costello

B 3 LOCATION OF WELL
 1 2 3 (SEQ. NO.) 6
 COUNTY Howard
 (DO NOT ABBREVIATE COUNTY NAME) 21
 SUBDIVISION Paragarden
 23 42
 SECTION 46 LOT 33
 44 48 50
 NEAREST TOWN Marfield
 52 71
 MILES FROM TOWN (ENTER 0 IF IN TOWN) 1 M I
 73 76 77 78


B 2 WELL INFORMATION
 1 2 3 (SEQ. NO.) 6
 MAXIMUM PUMPING RATE (GALLONS PER MINUTE) 6
 8 12
 AVERAGE DAILY QUANTITY NEEDED (GALLONS PER DAY) 500
 14 20
 USE FOR WATER (CIRCLE APPROPRIATE BOX)
 DOMESTIC, HOME (SINGLE OR DOUBLE HOUSEHOLD UNIT ONLY)
 FARMING, AGRICULTURE, IRRIGATION
 INDUSTRIAL, COMMERCIAL, STATE AND FEDERAL GOVERNMENT.
 MUNICIPAL WATER SUPPLY
 PRIVATE WATER COMPANY } MUST HAVE STATE HEALTH DEPT. APPROVAL
 TEST

B 4 DIRECTION FROM TOWN
 (CIRCLE APPROPRIATE BOX)
 1 2 3 (SEQ. NO.) 6
 NORTH EAST NE NORTHEAST SE SOUTHEAST
 SOUTH WEST NW NORTHWEST SW SOUTHWEST
 8 8 8 9 8 9
 NEAR WHAT ROAD Chapline Rd.
 ON WHICH SIDE OF ROAD (CIRCLE APPROPRIATE BOX) NORTH SOUTH EAST WEST
 11 30
 N S E W
 32 32 32
 DISTANCE FROM ROAD (ENTER DISTANCE AND CIRCLE APPROPRIATE BOX) 4000
 34 37 38 39

APPROXIMATE DEPTH OF WELL 100 FEET
 24 28
 APPROXIMATE DIAMETER OF WELL 6 (NEAREST INCH)
 METHOD OF DRILLING USED (CIRCLE APPROPRIATE METHOD)
 BORED (OR AUGERED) JETTED DRIVEN
 30-37 AIR-ROTARY AIR-PERCUSSION ROTARY (HYDRAULIC ROTARY)
 CABLE REVERSE-ROTARY DRIVE-POINT
 OTHER (DESCRIBE)

DRAW A SKETCH BELOW SHOWING LOCATION OF WELL IN RELATION TO NEARBY TOWNS, ROADS AND STREAMS WITH NORTH IN THE DIRECTION OF THE ARROW, AND GIVE DISTANCE FROM WELL TO NEAREST ROAD JUNCTION OR STREAM CROSSING SHOWN ON THE SKETCH. ALSO SHOW, BY MEANS OF AN "X", THE WELL LOCATION IN THE BOX BELOW, AND THE BOX NUMBER FROM THE WELL LOCATION MAP.

REPLACEMENT OR DEEPEMED WELLS (CIRCLE APPROPRIATE BOX)
 THIS WELL WILL NOT REPLACE AN EXISTING WELL
 THIS WELL WILL REPLACE A WELL THAT WILL BE ABANDONED AND SEALED
 THIS WELL WILL REPLACE A WELL THAT WILL BE USED AS A STANDBY
 THIS WELL WILL DEEPEM AN EXISTING WELL PERMIT NUMBER OF WELL TO BE REPLACED OR DEEPEMED (IF AVAILABLE)
 41 52

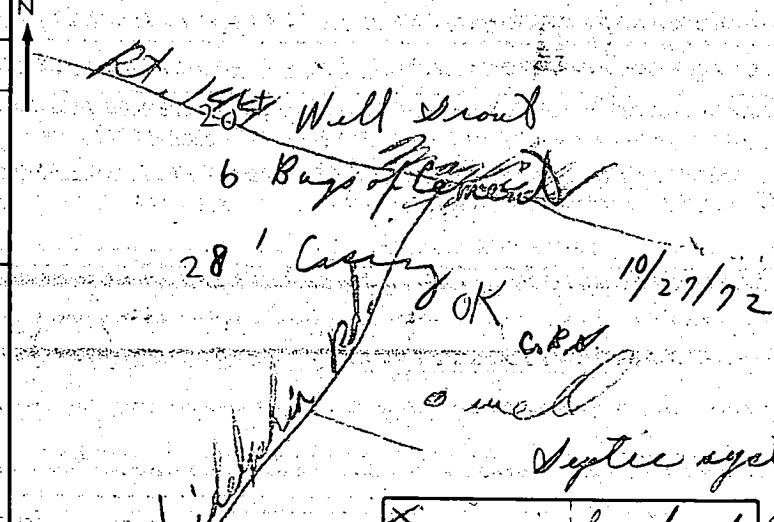

NOT TO BE FILLED IN BY DRILLER (DWR USE ONLY)
 APPROPRIATION PERMIT NUMBER [] ENGINEER REVIEW DISTRICT NO. []
 54 63 65
 FORCE [] WRITE INITIALS IN BOX CONDITIONS []
 67 68 70 71 72 73 74 75 76 77 78 79

BOX NUMBER
 E 520
 N 520
 NORTH COORDINATE 505000
 50 51 52 53 54 55
 EAST COORDINATE 050000
 57 58 59 60 61 62 63
 ELEVATION AT WELL HEAD (FEET) []
 65 66 67 68 0/0 5/0

B 4 CONTINUED HEALTH DEPARTMENT APPROVAL
 1 2 3 (SEQ. NO.) 6
 41 STATE HEALTH (CIRCLE BOX)
 COUNTY NAME Howard COUNTY NO. 2060
 MO. DAY YR. 10 27 72
 DATE 43 48
 APPROVED BY Palmer F. Wine, Director

B 5 SPECIAL CONDITIONS 8-63 (DWR USE ONLY)
 1 2 3 (SEQ. NO.) 6

STATE OF MARYLAND DEPARTMENT OF WATER RESOURCES STATE OFFICE BLDG., ANNAPOLIS, MARYLAND 21401 WELL COMPLETION REPORT

THIS REPORT MUST BE SUBMITTED WITHIN 30 DAYS AFTER WELL COMPLETION.

FILL IN THIS FORM COMPLETELY

C 00272 SEQUENCE NO. (DWR USE ONLY) 23 (SEQ. NO.) 6 (THIS NUMBER IS TO BE PUNCHED IN COLUMNS 3-6 ON ALL CARDS)

COUNTY NUMBER 3960

DATE RECEIVED (DWR USE ONLY) 8-13

DATE WELL COMPLETED 10-27-72 DEPTH OF WELL 309 (TO NEAREST FOOT) 26

PERMIT NO. FROM PERMIT TO DRILL WELL 40413-0030 DRILLERS IDENTIFICATION NO. 42

OWNER LAST NAME FIRST NAME STREET OR RFD POST OFFICE

WELL LOG

Table with columns: DESCRIPTION (USE ADDITIONAL SHEETS IF NECESSARY), FEET (FROM, TO), CHECK IF WATER BEARING. Includes handwritten entries: Top soil, Sandy, Gravel.

GROUTING RECORD

WELL HAS BEEN GROUTED (YES/NO) TYPE OF GROUTING MATERIAL (CEMENT/BENTONITE-CLAY) NO. OF BAGS 6 NO. OF POUNDS 600 GALLONS OF WATER 30 DEPTH OF GROUT SEAL (TO NEAREST FOOT) FROM 0 FT. TO 25 FT.

CASING RECORD

INSERT APPROPRIATE CODE BELOW MAIN CASING TYPE (S, T, C, O, P, L, O, T) NOMINAL DIAMETER TOP (MAIN) CASING (NEAREST INCH) 60 DEPTH OF MAIN CASING (NEAREST FOOT) 26

OTHER CASING (IF USED)

DIAMETER (INCH) DEPTH (FEET) FROM TO

SCREEN RECORD

INSERT APPROPRIATE CODE BELOW SCREEN TYPE OR OPEN HOLE (S, T, B, R, H, O, P, L, O, T) STEEL BRASS OR BRONZE OPEN HOLE PLASTIC OTHER

DEPTH (NEAREST WHOLE FOOT)

Table for screen depth with columns for screen number (1-3) and depth intervals (8-9, 11-15, 17-21, 23-24, 26-30, 32-36, 38-39, 41-45, 47-51).

DIAMETER OF SCREEN 56 (NEAREST INCH) FROM TO

GRAVEL PACK IF WELL FLOWED WAS A FLOWING WELL CIRCLE BOX 68 F

DWR USE ONLY (NOT TO BE FILLED IN BY DRILLER) TELESCOPE CASING LOG INDICATOR OTHER DATA AVAILABLE

PUMPING TEST

HOURS PUMPED (TO NEAREST HOUR) 2 PUMPING RATE (GALLONS PER MINUTE TO NEAREST GALLON) 7 METHOD USED TO MEASURE PUMPING RATE WATER LEVEL: (DISTANCE FROM LAND SURFACE) BEFORE PUMPING 20 (NEAREST FOOT) WHEN PUMPING 22 (NEAREST FOOT) TYPE OF PUMPED USED (CIRCLE APPROPRIATE BOX) (A) AIR (P) PISTON (T) TURBINE (C) CENTRIFUGAL (R) ROTARY (O) OTHER (DESCRIBE BELOW) (J) JET (S) SUBMERSIBLE

PUMP INSTALLED

TYPE OF PUMP (WRITE APPROPRIATE LETTER IN BOX - SEE ABOVE: A, C, J, P, R, S, T, O) DRILLER WILL INSTALL PUMP (CIRCLE APPROPRIATE BOX) YES/NO CAPACITY: GALLONS PER MINUTE (TO NEAREST GALLON) 31-35 PUMP HORSE POWER 37-41 PUMP COLUMN LENGTH (NEAREST FOOT) 43-47

CASING HEIGHT (CIRCLE APPROPRIATE BOX AND ENTER CASING HEIGHT)

ABOVE/BELAND SURFACE (NEAREST FOOT) 49-51

LOCATION OF WELL ON LOT

SHOW PERMANENT STRUCTURE SUCH AS BUILDINGS, SEPTIC TANKS, AND/OR OTHER LAND MARKS AND INDICATE NOT LESS THAN TWO DISTANCES (MEASUREMENTS TO WELL).

- CIRCLE APPROPRIATE BOXES: A A WELL WAS ABANDONED AND SEALED WHEN THIS WELL WAS COMPLETED; E ELECTRIC LOG OBTAINED; P TEST WELL CONVERTED TO PRODUCTION WELL

I HEREBY CERTIFY THAT I HAVE COMPLIED WITH ALL CONDITIONS STATED ON THE ABOVE-CAPTIONED PERMIT TO DRILL WELL, AND THAT INFORMATION CONTAINED IN THIS REPORT IS TRUE, ACCURATE, AND COMPLETE TO THE BEST OF MY KNOWLEDGE, INFORMATION AND BELIEF.

DRILLERS NAME: L F Eastender (PRINT), P H Pauley (SIGNATURE)

Handwritten notes: "Please see 3960 well" and "Red."

no failure seen @ septic location,
 proposed addition presents
 no space conflicts w/septic
 system, but system is 20
 yrs old, and implies increase
 in flow; recommend repair, set
 requirement for BP approval.
 MR 10/7/93

BRADLEY ADDITION

du Taylor Assoc, architects
 9/93

D/W STATUS 10 SP:

D/W 8.5-9' DEEP 5' OF

WATER IN D/W
 (4' FROM GRADE)

MR
 10/8/93

INLET 3" FROM GRADE

REC. BP APPROVAL

I hereby certify that I have made a survey of
 this property for the purpose of locating the
 improvements thereon, and that they are
 located as shown.

Alexander J. Ratych
 7/7/1972

S 14° 07' 54" E - 144.12'

LOT 33
 SECTION SIX
 EVERGREEN VALLEY
 ESTATES



N 02° 17' 56" W L=105.00' R=375.00'
 15.00'
 EVERGREEN WAY



ap
 associates land surveyors
 A. P. RATYCH, L. S.
 208 E. MAIN ST. ELKTON, MD. 21821 PHONE: 388-7768
 3320 ROSALIE AVE. BALTIMORE, MD. 21234 PHONE: 444-4323

LOCATION SURVEY
 LOT 33 SEC. 6
 EVERGREEN VALLEY ESTATES
 THIRD ELECTION DISTRICT
 HOWARD COUNTY, MARYLAND
 SCALE 1"=50' JULY 6, 1972

S 14° 07' 54" E - 144.12'

Richard Bradley

Pool 18' x 36' Rect.
3' to 8' Deep

Pool to Home 17'

Pool to Right Side 9'

Pool to Rear 150'

Pool to Well 100'



Pool to Left Side 75'

Pool to New Septic
39'

LOT 33
SECTION SIX
EVERGREEN VALLEY
ESTATES

8/30/75

POOL
OK TO
SIGN
MR

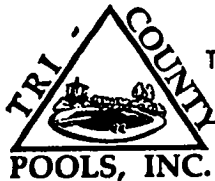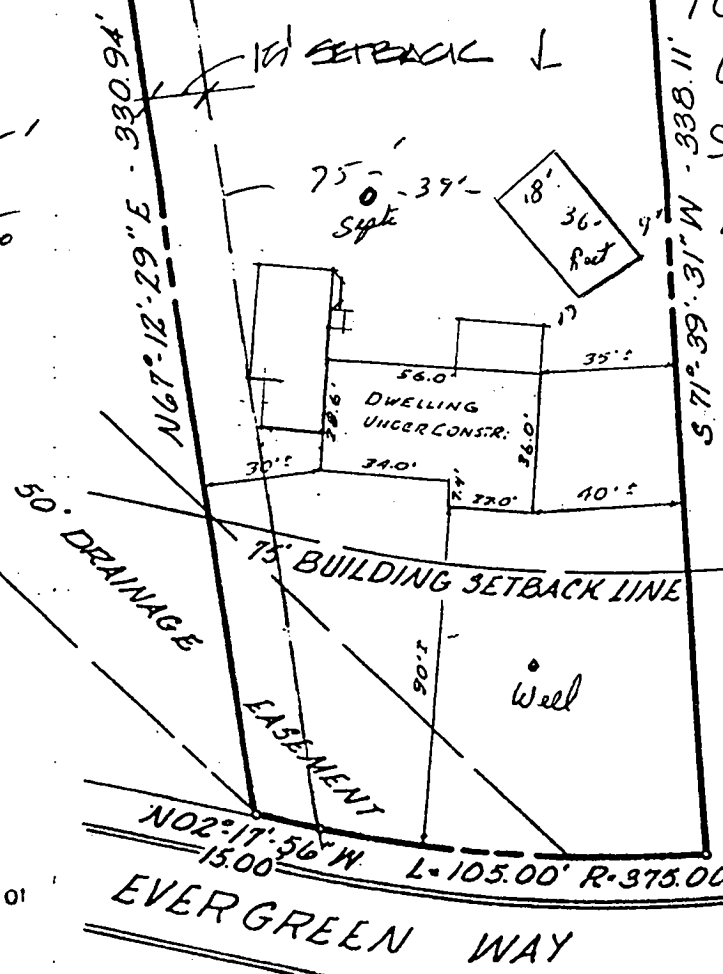

MHC # 34414-01
TRI-COUNTY POOLS, INC.
 13410 Moser Rd.
 Thurmont, MD 21788
 301-898-3030

I hereby certify that I have made a survey of this property for the purpose of locating the improvements thereon, and that they are located as shown.

Alexander J. Ratych
 7/7/1972



apri
 associates land surveyors
 A. P. RATYCH, L. S.
 206 E. MAIN ST. ELKTON, MD. 21821 PHONE: 388-7768
 3320 ROSALIE AVE BALTIMORE, MD. 21224 PHONE: 444-4323

LOCATION SURVEY
 LOT 33 SEC. 6
 EVERGREEN VALLEY ESTATES
 THIRD ELECTION DISTRICT
 HOWARD COUNTY, MARYLAND
 SCALE 1"=50' JULY 6, 1972

APPLICATION

HOWARD COUNTY

SERIAL NUMBER

PERMIT APPLICATION

DEPARTMENT OF INSPECTIONS, LICENSES & PERMIT
3430 COURT HOUSE DRIVE, ELLICOTT CITY, MARYLAND 21043

615-38

BUILDING ADDRESS (HOUSE NO., STREET, TOWN OR AREA)

3135 Evergreen Way
Ellicott City, MD 21042

GRADING/SEDIMENT CONTROL YES NO SDP #

DESCRIPTION OF WORK AUTHORIZED

18x36 Inground Swimming Pool, rectangle in steel, 3'-8" depth, sand filtration system.

LOT NO. 33	PARCEL NO.	SEC. 6	AREA	BLOCK NO.	LIBER	FOLIO
SUB DIVISION Evergreen Valley Est.			ZONE	ZONE MAP	ELEC. DIST. 3	CENSUS TR.

OWNER NAME AND ADDRESS
Richard + Susan Bradley
3135 Evergreen Way

PHONE NO.
410-531-6753

OCCUPANT'S NAME AND ADDRESS
SAME AS ABOVE

PHONE NO.

ARCHITECT OR ENGINEER'S NAME AND ADDRESS

PHONE NO.

SIZE OF BLDG.	FRONT	DEPTH	HEIGHT

TYPE OF BLDG.	AREA	VOLUME	ROOF
B. ROOMS			
ROOMS			
BATHS			
FIREPLACES			

FOOTINGS	FOUNDATION	S. WALLS

CONTRACTOR'S NAME AND ADDRESS
TRICOUNTY POOLS
13410 MOSER RD, THURMONT MD

PHONE NO.
301-898-3030

UTILITIES					
WATERWELL	SEWER/SEPTIC	GAS	ELECTRICITY	TYPE OF HEAT	AC

I have carefully examined and read this application and know the same is true and correct, and that is doing this work, all provisions of Howard County Ordinances and the State Laws of Maryland will be complied with, whether specified or not; and I will notify the Department of Inspections, and Permits twenty-four hours in advance when I am ready for the inspections called for elsewhere in the application; and that no work will be covered up until such inspections have been completed.

Ray J. Starvill
Signature
TITLE
DATE

EXISTING USE
PROPOSED USE

EST. CONSTRUCTION COST
23,000

LICENSE NUMBER
34414-01

PERMIT FEE

W/S CODE FOR OFFICE USE ONLY

DISTRICT IN FEET FROM R/W LINE TO FRONT BUILDING LINE

SIDE YARD (DISTANCE IN FEET FROM SIDE BLDG. LINE TO SIDE PROPERTY LINE)

TO SIDE BUILDING LINE DISTANCE IN FEET, REAR YD. REQUIRING SET

BACK (CORNER LOT ONLY) SDP #

Check payable to: DIRECTOR OF FINANCE OF HOWARD COUNTY

CAUTION
To begin construction before a permit placard has been issued and displayed on the job is a violation of the law.
Use and occupancy permit must be applied for two weeks before it will be issued.

FUNCTION	DATE	SIGNATURE APPROVAL
ZONING/PLANNING		
SHA		
SEDIMENT/GRADING		
BUILDING OFFICIAL		
WATER & SEWER		
HEALTH DEPT.	8/30/95	Mark E. Ripken
FIRE PROTECTION		
STORM WATER MGM.		

IMPORTANT: PLEASE SHOW ZIP CODES AND AREA CODES WHEREVER REQUIRED.

LP-69-591

APPROVED DATE
Distribution of Copies:
White - Building Official
Green - Planning & Zoning
Yellow - Engineering
Pink - Health Dept.
Gold - S.H.A.