

APPLICATION

PERCOLATION TESTING

A 41990

P _____

HOWARD COUNTY HEALTH DEPARTMENT
BUREAU OF ENVIRONMENTAL HEALTH
P.O. BOX 476 ELLICOTT CITY, MARYLAND 21043
TELEPHONE 461-9933

DISTRICT 4TH

DATE March 10, 1988

TO: THE COUNTY HEALTH OFFICER
ELLICOTT CITY, MARYLAND

I HEREBY APPLY FOR THE NECESSARY TEST IN ORDER TO CONSTRUCT (OR RECONSTRUCT) A SEWAGE DISPOSAL SYSTEM.

PROPERTY OWNER Sang Ho Company, Inc. DEAN F. BARBARA SOULY

ADDRESS 8100 Cooper Street, Alexandria, Va. 22309 PHONE (703) 239-7541

PROSPECTIVE BUYER Unknown

ADDRESS _____ PHONE _____

PROPERTY LOCATION:

SUBDIVISION Choi Property LOT NO. 27

ROAD AND DESCRIPTION North side of Burrowswood Rd., 1290' East of Hedges Road.
(3284 DANMARK DRIVE)

TAX MAP 14 PARCEL # 106

AND RETURNED 10-5-98
Serial # 250 114 277

SIZE OF LOT 3.00 Acre Minimum TYPE BLDG S.F.O.
(SINGLE FAMILY DWELLING OR COMMERCIAL)

THE SYSTEM INSTALLED UNDER THIS APPLICATION IS ACCEPTABLE ONLY UNTIL PUBLIC FACILITIES BECOME AVAILABLE. I FULLY UNDERSTAND THE FEE CONNECTED WITH THE FILING OF THIS PERC TEST APPLICATION IS NON-REFUNDABLE UNDER ANY CIRCUMSTANCES. I ALSO AGREE TO COMPLY WITH ALL M.O.S.H.A. REQUIREMENTS IN TESTING THIS LOT.

Dennis M. Bush
(SIGNATURE OF APPLICANT)

APPROVED BY _____ FOR _____ DATE _____

REJECTED BY _____ FOR _____ DATE _____







HOLD PENDING FURTHER TESTS _____ DATE _____

REASONS FOR REJECTION OR HOLDING _____

HD-216

THIS IS NOT A PERMIT

Lot 27
 A41990
 SEP 25
 See Plat

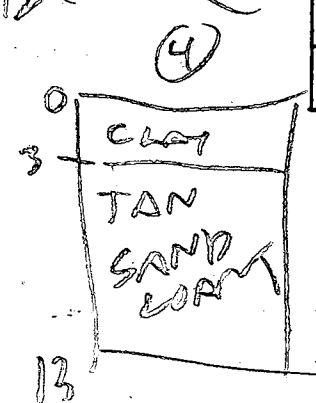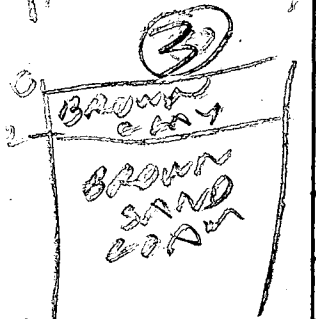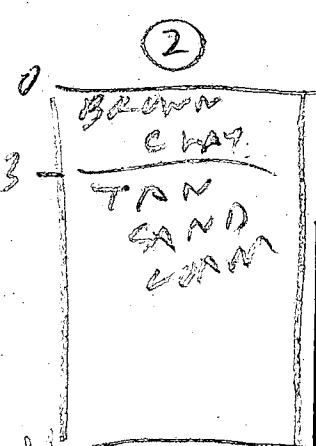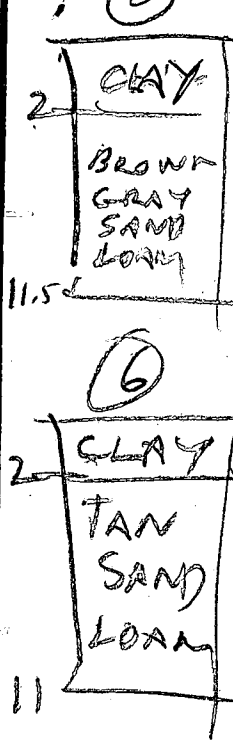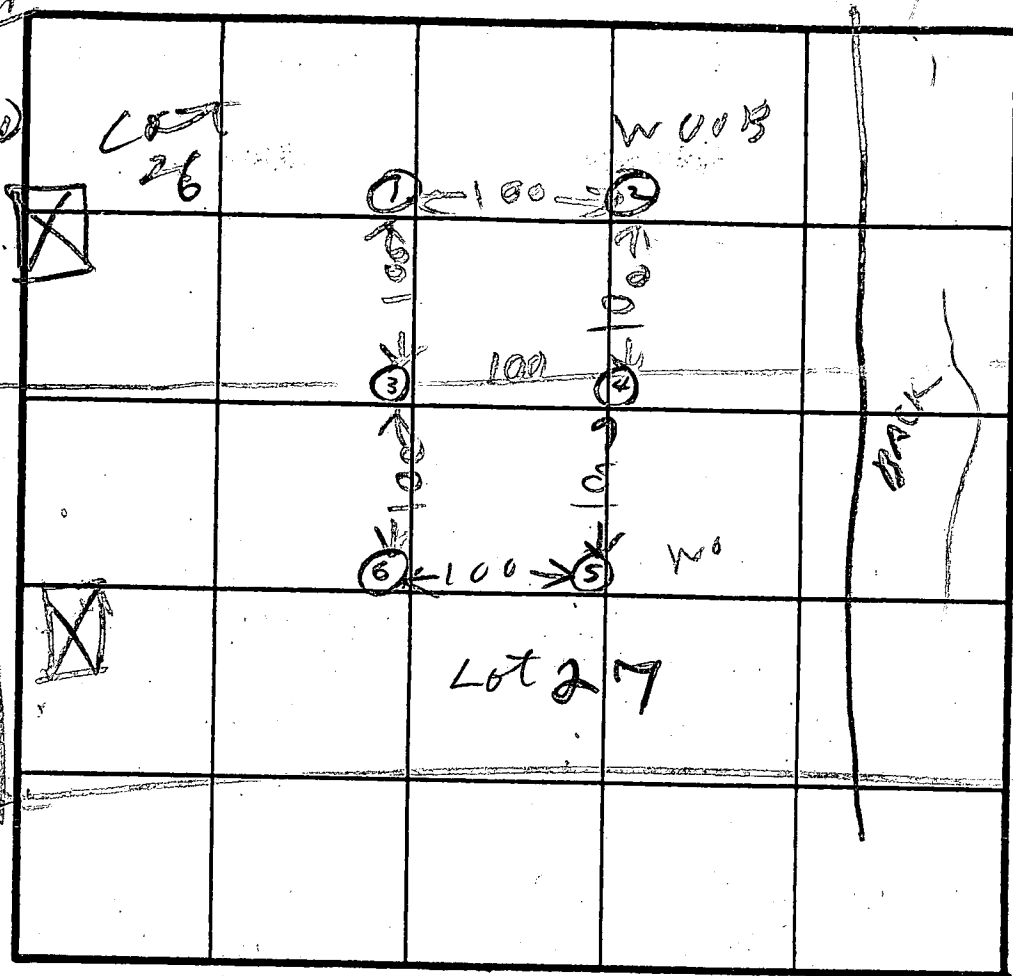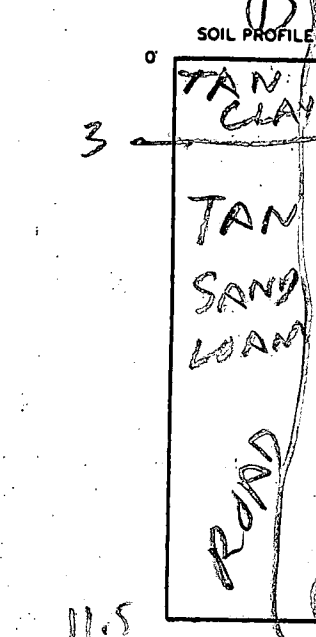

INDICATE NORTH - NAME ADJOINING ROADWAY AS BASE LINE.

DATE	TEST NO.	DEPTH	PRE-WET		TEST - 1' DROP		TIME
			START	STOP	START	STOP	
8/3/88	15 16	4 11.5	320 OK	323	323	334	11
8/1/88	25 26	4 11	328 OK	330	330	334	4
	35 37	3 5.5	338 328	339 339	339 339	341 341	2 2
	45	12	OK				
	55 56	3 10.5	349 OK	350	350	355	
	60 65	7 7	359 403	400 405	400 405	402 407	2 2
	67	11.5	OK				
9/3/88							

X 5 MIN
 180 7/82
 INLET 2'
 BOTTOM 4'
 REV.
 2/19/98
 TOP
 SEAM
 TANK

REMARKS: Holes shifted off stake 30 FT
 TYPE OF SOIL: 8 On Line Hole retractor used
 TESTED BY: R. Hodges
 ALSO PRESENT: WOOD & SKIP OF ROCK

September 28, 1998

MEMORANDUM

TO: Jacobsen Homes LLC
9409 Elizabeth Court
Fulton, Maryland 21738

FROM: Amy Mc Millen, R.S.
Water & Sewerage Program

RE: Building Permit #B00114277
Choi Property - Lot 27
3284 Danmark Drive

COMMENTS

This office has received the above referenced building permit application. We are unable to approve your permit at this time. On February 24, 1998, this office sent you a letter (see attached) requesting a wet season observation test hole prior to building permit application. As of this date, no such observation test has been performed.

In order to resolve this concern, please contact this office in order to schedule a conference at this office.

Thank you for your cooperation in this matter and if you have any question, please call Amy Mc Millen or Glen Savage at (410)313-2640.

am
cc:Dean & Barbara Savoy

10-5-98
Letter not sent - no
evidence found to suggest
problems w/ septic easement (No installation
problems on lots 26 & 28. Septic esmt is 140' x 120',
ie. > 10,000 ft. Building permit released w/ no
test hole or adjustment to SPA.
A McMillen



HOWARD COUNTY HEALTH DEPARTMENT

Joyce M. Boyd, M.D., County Health Officer

February 24, 1998

**Jacobson Homes, LLC
9409 Elizabeth Ct.
Fulton, MD 20759**

RE: Choi Property Lot 27, A-41992

Dear Sir/Madam:

Our records indicate that you are the owner of the above referenced property. Please be advised of the following issue regarding this property:

- When percolation testing was conducted during the summer of 1988, conditions at the time were uncommonly dry.
- A wet season observation is requested for appropriate septic system design for soil conditions. Ideally, this would be conducted prior to application for a building permit.

If you have any questions, feel free to contact me at the address listed above or by calling 410-313-2640.

Sincerely,

**Glen Savage, R.S.
Water and Sewerage Program**

**cc:Gail Jacobs
File**

GS:gschoi27.jet


6820 OLD PIMLICO RD
BALT, MD 21289

POTENTIAL BUYER FOR LOT, WANTED TO VERIFY PERC, SEPTIC INSTALLATION SPECS.
SS

L.246, F.9R

DEED 9-106

44w) *
160°00'00"

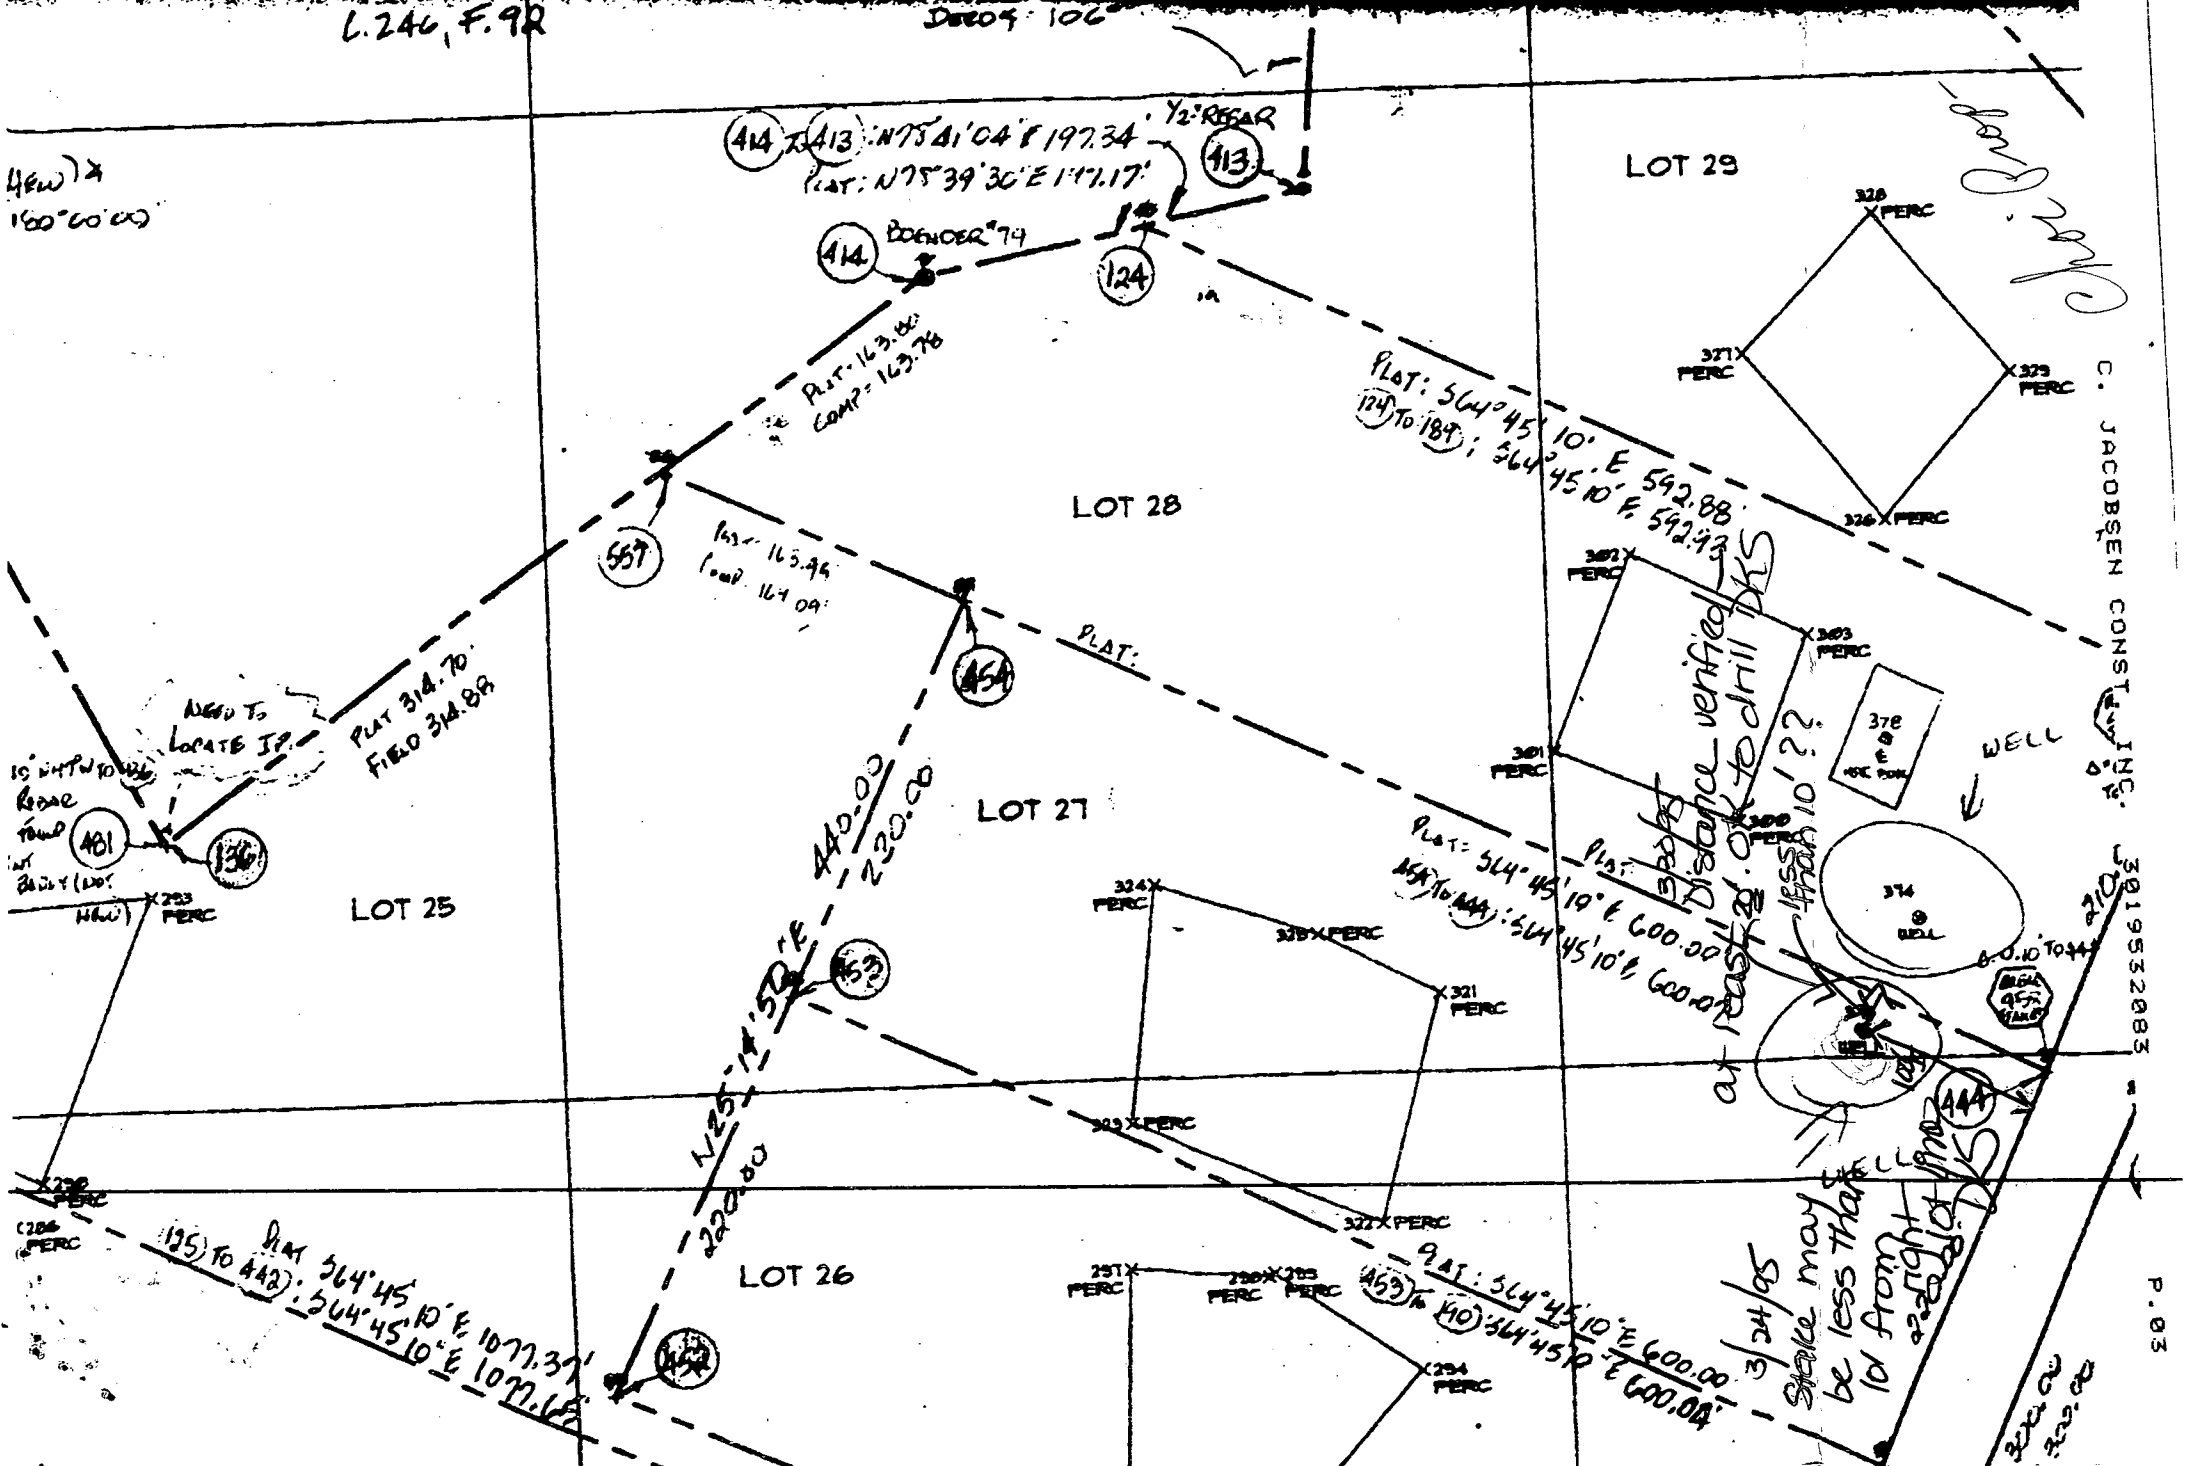

Handwritten signature

C. JACOBSEN CONSULTING INC.

3019532083