

9/14/62

PERMIT

P 05606
A 05053

SEWAGE DISPOSAL SYSTEM

MARYLAND STATE DEPARTMENT OF HEALTH

HOWARD COUNTY

ELLCOTT CITY

INDEXED

INDEXED

DISTRICT 2

DATE 9/10/62

John E. Ruth Co

IS PERMITTED TO INSTALL ALTER

ADDRESS

PHONE

A SEWAGE DISPOSAL-SYSTEM LOCATED AT

130 N. Rogers Ave

SUBDIVISION

ROAD

LOT

PROPERTY OWNER

E. Russell Mofey Jr.

ADDRESS

110 A N. Rogers Ave E.C.

SPECIFICATIONS

DRAIN FIELD _____ DEPTH _____ FEET, BOTTOM AREA _____ SQ. FT.

SEEPAGE PITS 1 ABSORBENT SIDE-WALL AREA 12 ft diameter SQ. FT.

SEPTIC TANK CAPACITY 750 GALLONS

FOR GARBAGE GRINDER, INCREASE DISPOSAL AREA 22% & TANK CAPACITY 50%.

OTHER

Locate the dry well ^{about 115} 20 ft. from the front property line and 24 ft. from the left side property line. Left side property line determined when facing the lot from N. Rogers Ave. Above refers to the original ground.

PLANS APPROVED BY

J. E. Heargan

DATE


4/26/62

FILL SEPTIC TANK AND DISTRIBUTION BOX WITH WATER BEFORE CALLING FOR AN INSPECTION. COVER NO WORK UNTIL INSPECTED AND APPROVED.

NEITHER THE HOWARD COUNTY COMMISSIONERS NOR THE HEALTH DEPARTMENT IS RESPONSIBLE FOR THE SUCCESSFUL OPERATION OF ANY SYSTEM.

Permission given to locate dry well about 115 ft from front line instead of 120 ft because of clearance of original lot to the well on the property to the right side of original lot. a Dry Well 12 ft diameter and 9 ft deep below the inlet pipe is to be installed. 9/14/62

513599-D

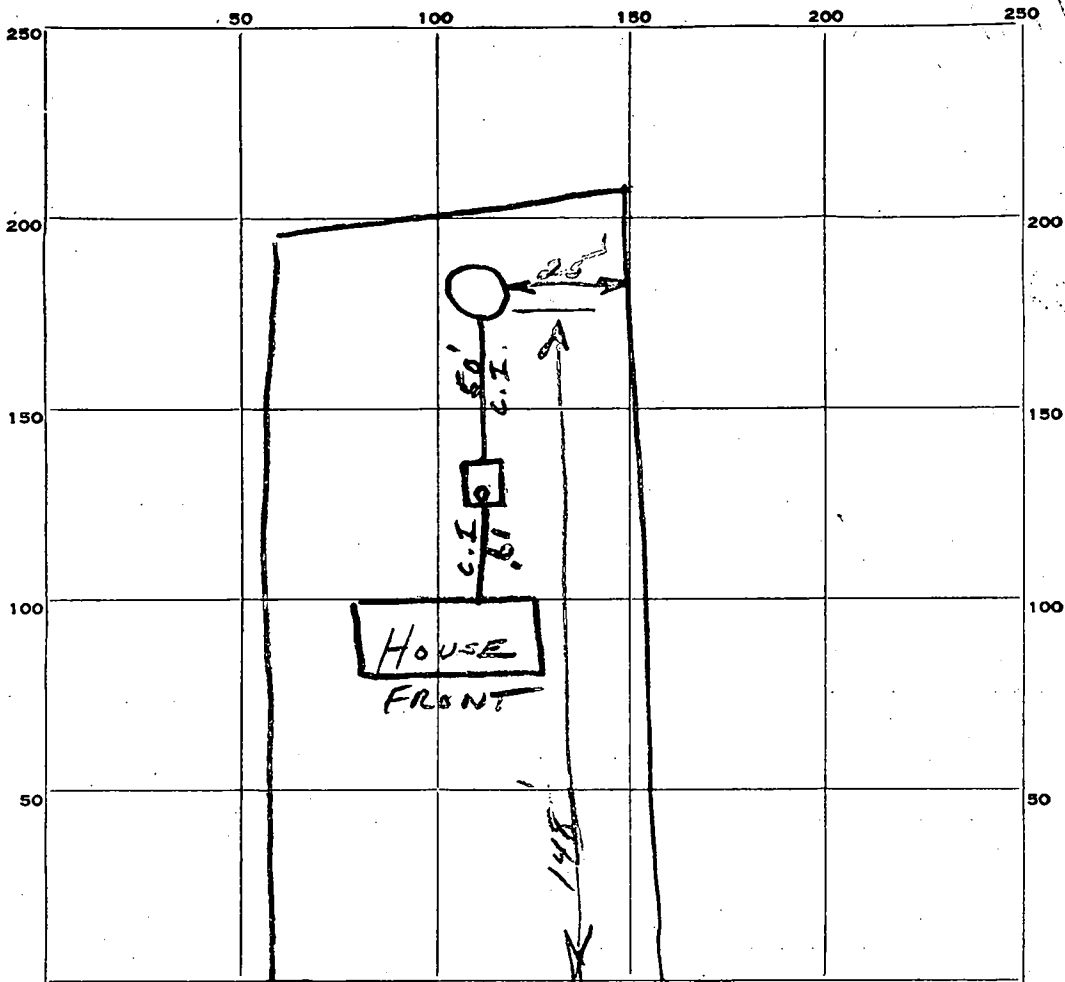

INDICATE NORTH. - NAME ADJOINING ROADWAY AS BASE LINE.

PERMIT CARD yes N. RODGERS AVE.

SEPTIC TANK LEVEL 750 gal - metal CLEANOUTS 6" stand pipe

DISTRIBUTION BOX, LEVEL none

TILE FIELD, DEPTH _____ FT. TRENCH WIDTH _____ FT.

GRAVEL DEPTH _____ IN. TOTAL LENGTH _____ FT.

NUMBER OF TRENCHES _____ TOTAL BOTTOM AREA _____

SEEPAGE PITS, INSIDE DIAMETER 15 FT. DEPTH BELOW INLET 9 FT.

ABSORBENT AREA _____ SQ. FT.

REMARKS _____

DATE SYSTEM APPROVED 9-14-62 INSPECTOR J. Fleming

Fill out in triplicate
Make fee of \$15.00 payable to

APPLICATION

A 05053

P _____

to: HOWARD COUNTY HEALTH DEPT. SANITATION

SEWAGE DISPOSAL TESTING

MARYLAND STATE DEPARTMENT OF HEALTH

HOWARD COUNTY

ELLICOTT CITY

one dry well 10 ft in dia. by 10 ft. below the inlet located 120 ft. from the front property line and 24 ft. from the left side property line. Left side property line determined when facing the lot from N. Rogers ave. above refers to the original ground.

DISTRICT 21 DATE 4/24/62

TO: THE COUNTY HEALTH OFFICER
- ELLICOTT CITY, MARYLAND

75 gal septic tank.

I, HEREBY, APPLY FOR THE NECESSARY TESTS IN ORDER TO CONSTRUCT (OR RECONSTRUCT) A SEWAGE DISPOSAL SYSTEM.

PROPERTY OWNER Mr & Mrs E. Russell Moxley Jr
ADDRESS 110A North Rogers Ave. Ellicott City Md PHONE No 5-0592

PROPERTY LOCATION:

SUBDIVISION 130 N. Rogers ave LOT NO. _____
ROAD AND DESCRIPTION Rogers

OCCUPANT _____ PHONE _____

PERSON TO CONSTRUCT SYSTEM John E. Ruth Co

ADDRESS _____ PHONE _____

SIZE OF LOT 79 front 210 Deep TYPE BLDG. Frame 1 family 3 Bed room
NUMBER OF BEDROOMS

IF NOT SINGLE RESIDENCE DESCRIBE _____

SIGNATURE OF APPLICANT Edgar Russell Moxley Jr


APPROVED BY Jane E. Hennigan FOR Pay Well DATE 4-26-62

REJECTED BY _____ FOR _____ DATE _____

HOLD PENDING FURTHER TESTS _____ DATE _____

REASONS FOR REJECTION OR HOLDING _____

THIS IS NOT A PERMIT

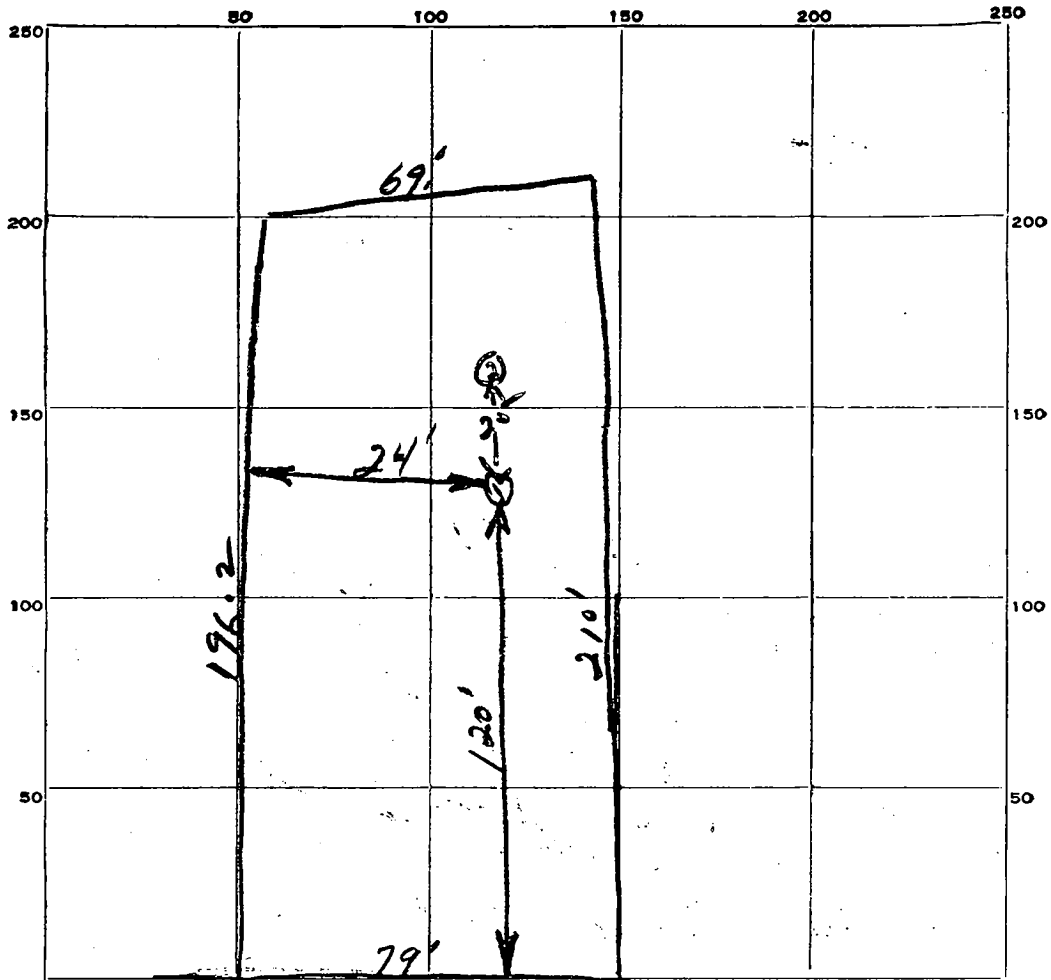

INDICATE NORTH. - NAME ADJOINING ROADWAY AS BASE LINE.

N. RODGERS

DATE	TEST NO.	DEPTH	PRE-WET		TEST - 1" DROP		TIME
			START	STOP	START	STOP	
4-26-62	1	9	9:39	9:44	9:41	9:47	6 min
9/4/62	2	10	10:12	10:15	10:15	10:21	6 min

SOIL AUGER FINDING

TESTED BY

REMARKS

ALSO PRESENT

Jan Hennigan
4-26-62 E. Kimmel Dr 4 leg Jr
 LOT NO. *130 N. RODGERS*