

check out 6/12/61

513625-B

PERMIT

P 03306
A 02711

SEWAGE DISPOSAL SYSTEM

MARYLAND STATE DEPARTMENT OF HEALTH

HOWARD COUNTY

ELLICOTT CITY

DISTRICT 2

DATE 1/12/61

INDEXED

02-195194

The John E. Ruth Co.

IS PERMITTED TO INSTALL ALTER

ADDRESS 400 Overbrook Rd., Catonsville

PHONE Ri. 7-0678

A SEWAGE DISPOSAL SYSTEM LOCATED AT Church Lane

SUBDIVISION _____ ROAD 8418 Church La LOT _____

PROPERTY OWNER ~~Bierman, William E.~~ Bilney

ADDRESS Pine Orchard

SPECIFICATIONS

DRAIN FIELD DEPTH 3 FEET, BOTTOM AREA 300 SQ. FT.

SEEPAGE PITS _____ ABSORBENT SIDE-WALL AREA _____ SQ. FT.

SEPTIC TANK CAPACITY 750 GALLONS

FOR GARBAGE GRINDER, INCREASE DISPOSAL AREA 22% & TANK CAPACITY 50%.

OTHER Place the tile field about 75 ft. to 150 ft. from the edge of the dirt lane. Septic tank cannot be installed more than 3 feet below original grade.

away to washing bed

PLANS APPROVED BY Raymond Hodges


DATE 7/21/60

FILL SEPTIC TANK AND DISTRIBUTION BOX WITH WATER BEFORE CALLING FOR AN INSPECTION. COVER NO WORK UNTIL INSPECTED AND APPROVED.

NEITHER THE HOWARD COUNTY COMMISSIONERS NOR THE HEALTH DEPARTMENT IS RESPONSIBLE FOR THE SUCCESSFUL OPERATION OF ANY SYSTEM.

BLDG. PERMIT SIGNED
AND RETURNED 7/5/64
Serial # 59910
Pool.

513625-B

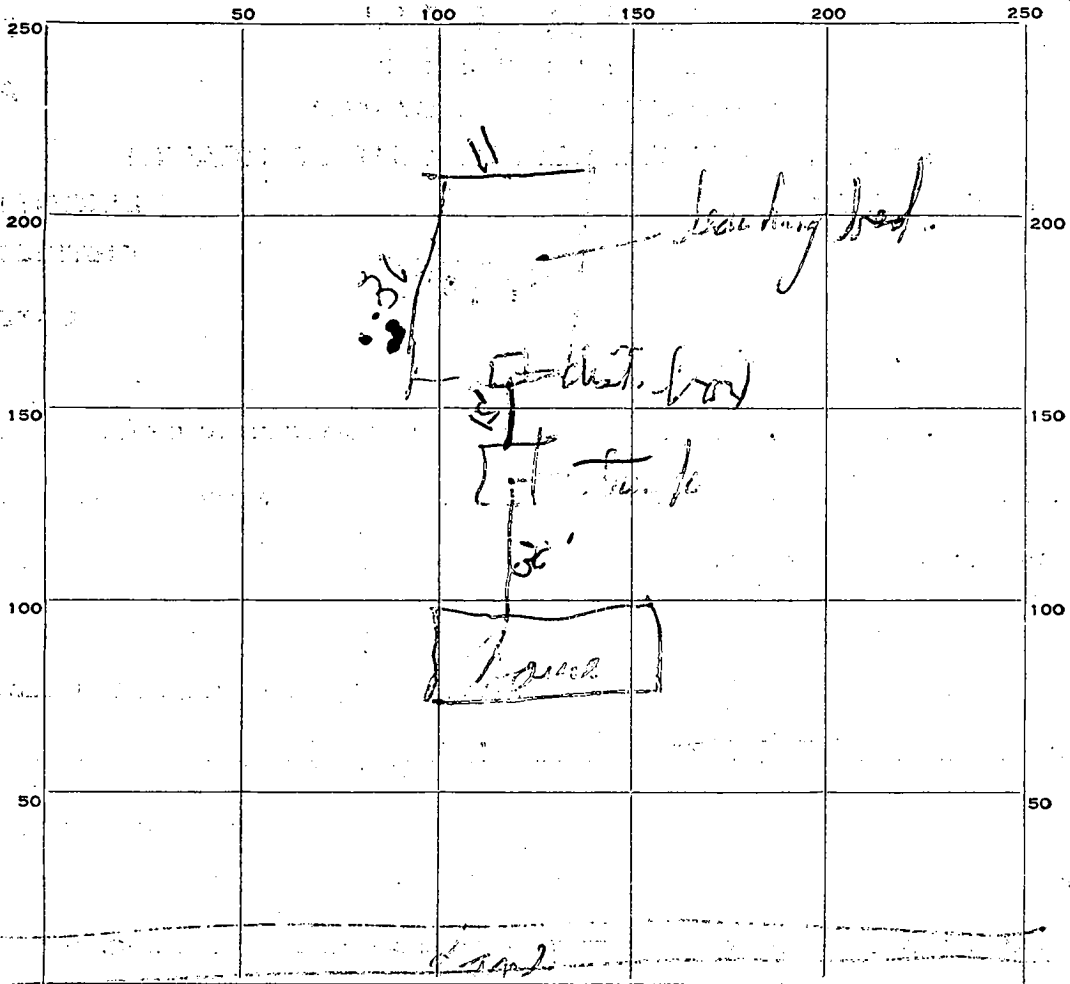

So
11
30
356

INDICATE NORTH - NAME ADJOINING ROADWAY AS BASE LINE.

PERMIT CARD

SEPTIC TANK, LEVEL CLEANOUTS

DISTRIBUTION BOX, LEVEL _____

TILE FIELD, DEPTH _____ FT. TRENCH WIDTH _____ FT.

GRAVEL DEPTH _____ IN. TOTAL LENGTH _____ FT.

NUMBER OF TRENCHES _____ TOTAL BOTTOM AREA _____

SEEPAGE PITS, INSIDE DIAMETER _____ FT. DEPTH BELOW INLET _____ FT.

ABSORBENT AREA 330 *Leaching be* SQ. FT.

REMARKS 4/12/61 - Leaching bed installed instead of tile field

DATE SYSTEM APPROVED _____ INSPECTOR 1/1/61

STATE OF MARYLAND

HOWARD COUNTY HEALTH DEPARTMENT

ELLICOTT CITY, MARYLAND

Date

19 1962

Name

Telephone No.

DETAILED LOCATION OF SITE, DEVELOPMENT,
SECTION, ROAD, LOT NO. & ELECTION DISTRICT

PRIVATE SEWAGE DISPOSAL SYSTEMS

Testing and Inspection

\$

Installation Permit

\$

Received
Payment

03306
DUPLICATE

THIS RECEIPT IS NOT
A PERMIT AND IT IS
NOT A WARRANTY OF
PERFORMANCE OF
THE SYSTEM THAT
IS INSTALLED

STATE OF MARYLAND

HOWARD COUNTY HEALTH DEPARTMENT

ELLICOTT CITY, MARYLAND

Date

19 51

Name

Telephone No.

DETAILED LOCATION OF SITE, DEVELOPMENT,
SECTION, ROAD, LOT NO. & ELECTION DISTRICT

PRIVATE SEWAGE DISPOSAL SYSTEMS

Testing and Inspection

\$

Installation Permit

\$

Received
Payment

03306
TRIPPLICATE

THIS RECEIPT IS NOT
A PERMIT AND IT IS
NOT A WARRANTY OF
PERFORMANCE OF
THE SYSTEM THAT
IS INSTALLED

STATE OF MARYLAND

HEWLETT COUNTY HEALTH DEPARTMENT
ELLICOTT CITY, MARYLAND

Date July 18 1960

Name William Lippincott

Telephone No. Southfield 6-2711

DETAILED LOCATION OF SITE, DEVELOPMENT,
SECTION, ROAD, LOT NO. & ELECTION DISTRICT

Church Lane

PRIVATE SEWAGE DISPOSAL SYSTEMS

Testing and Inspection \$ 10.00

Installation Permit \$ _____

Received
Payment Mary Carolyn Shoop

02711

DUPLICATE

THIS RECEIPT IS NOT
A PERMIT AND IT IS
NOT A WARRANTY OF
PERFORMANCE OF
THE SYSTEM THAT
IS INSTALLED

STATE OF MARYLAND

HARVARD COUNTY HEALTH DEPARTMENT ELLICOTT CITY, MARYLAND

Date

July 18

1960

Name

William L. Lippert

Telephone No.

Southfield 6-1271

DETAILED LOCATION OF SITE, DEVELOPMENT,
SECTION, ROAD, LOT NO. & ELECTION DISTRICT

Church Lane

PRIVATE SEWAGE DISPOSAL SYSTEMS

Testing and Inspection

\$ 10.00

Installation Permit

\$

Received
Payment

Mary Carolyn Shoop

02711

TRIPPLICATE

THIS RECEIPT IS NOT
A PERMIT AND IT IS
NOT A WARRANTY OF
PERFORMANCE OF
THE SYSTEM THAT
IS INSTALLED

APPLICATION

A 02711

SEWAGE DISPOSAL TESTING

P 3306

MARYLAND STATE DEPARTMENT OF HEALTH

HOWARD COUNTY 750 Gallon Tank

ELLICOTT CITY

Tile Field - 300 sq ft bottom area

DISTRICT 2

DATE July 18, 1960

Place the tile field about 75 ft to 150 ft from the edge of the dirt lane

TO: THE COUNTY HEALTH OFFICER
ELLICOTT CITY, MARYLAND

I, HEREBY, APPLY FOR THE NECESSARY TESTS IN ORDER TO CONSTRUCT (OR RECONSTRUCT) A SEWAGE DISPOSAL SYSTEM.

PROPERTY OWNER William E. Bierman

ADDRESS Pine Orchard

PHONE Globe 1912J

PROPERTY LOCATION:

SUBDIVISION

LOT NO.

ROAD AND DESCRIPTION Church Lane (map shows location)

OCCUPANT

PHONE

PERSON TO CONSTRUCT SYSTEM

ADDRESS

PHONE

SIZE OF LOT 90 by 350

TYPE BLDG: 2

NUMBER OF BEDROOMS

IF NOT SINGLE RESIDENCE DESCRIBE

SIGNATURE OF APPLICANT

William W. Typhings (Agent - Monumental Eng, Inc)

APPROVED

Raymond Hodge

Tile Field
(KIND OF SYSTEM)

DATE

7/21/60

REJECTED BY

FOR

(KIND OF SYSTEM)


DATE

HOLD PENDING FURTHER TESTS

DATE

REASONS FOR REJECTION OR HOLDING

THIS IS NOT A PERMIT

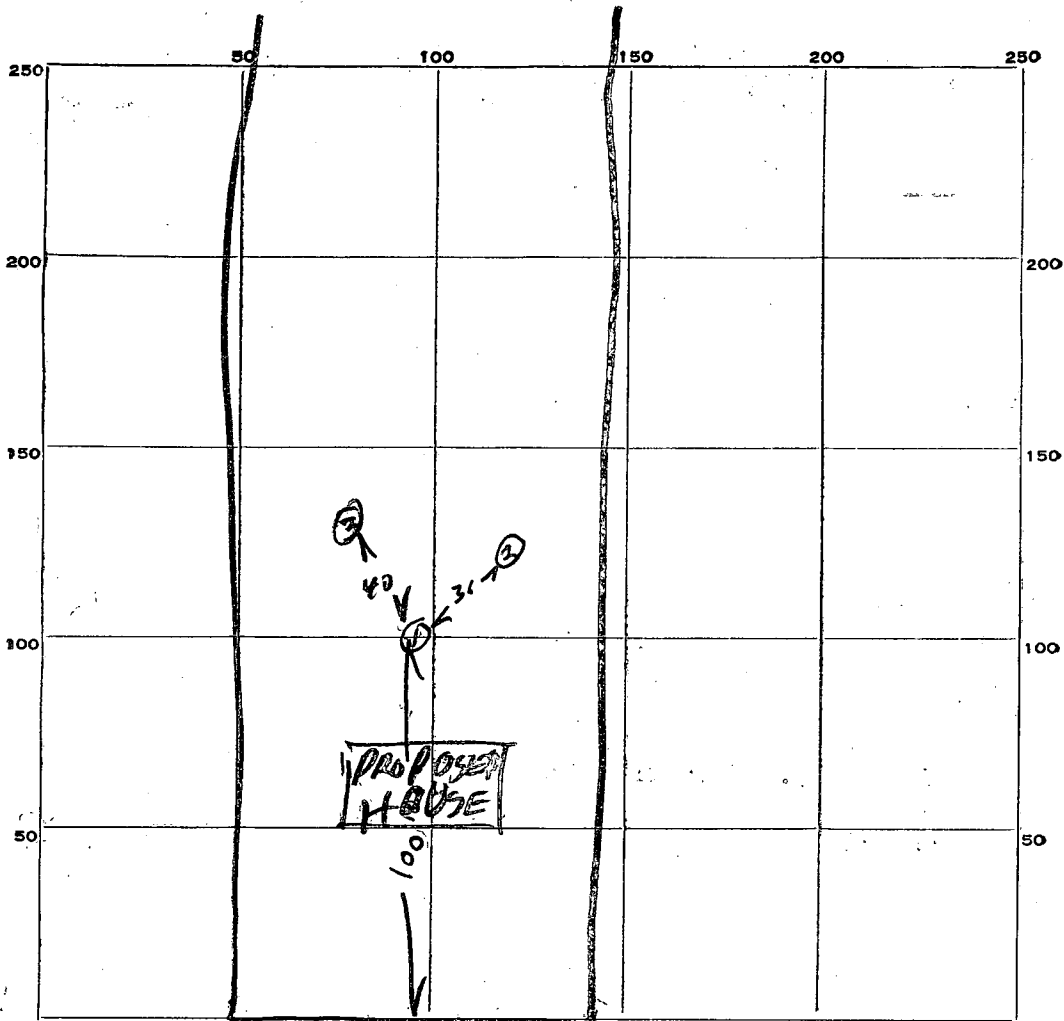

INDICATE NORTH. - NAME ADJOINING ROADWAY AS BASE LINE.

DIRT LANE

DATE	TEST NO.	DEPTH	PRE-WET		TEST - 1" DROP		TIME
			START	STOP	START	STOP	
7/20/60	1	3	947	950	950	955	5 min
	2	3	951	954	954	960	7 min
	3	3	954	956	956	958	2 min

SOIL AUGER FINDING None

TESTED BY Raymond Hodges

REMARKS _____

ALSO PRESENT Richard Hill LOT NO. _____

BIRMINGHAM
HOWARD CO.

Meeting
Point

RD. 99

High Ridge
Road
1/10 mi.

High Ridge
Road
2/10 mi.

ROSEMAR DR.

1/2 mi.

Rt. 40

BALTO →

~~RD. 29~~


RD 103

175

Rt. # 1

WATERLOO
BARRACKS



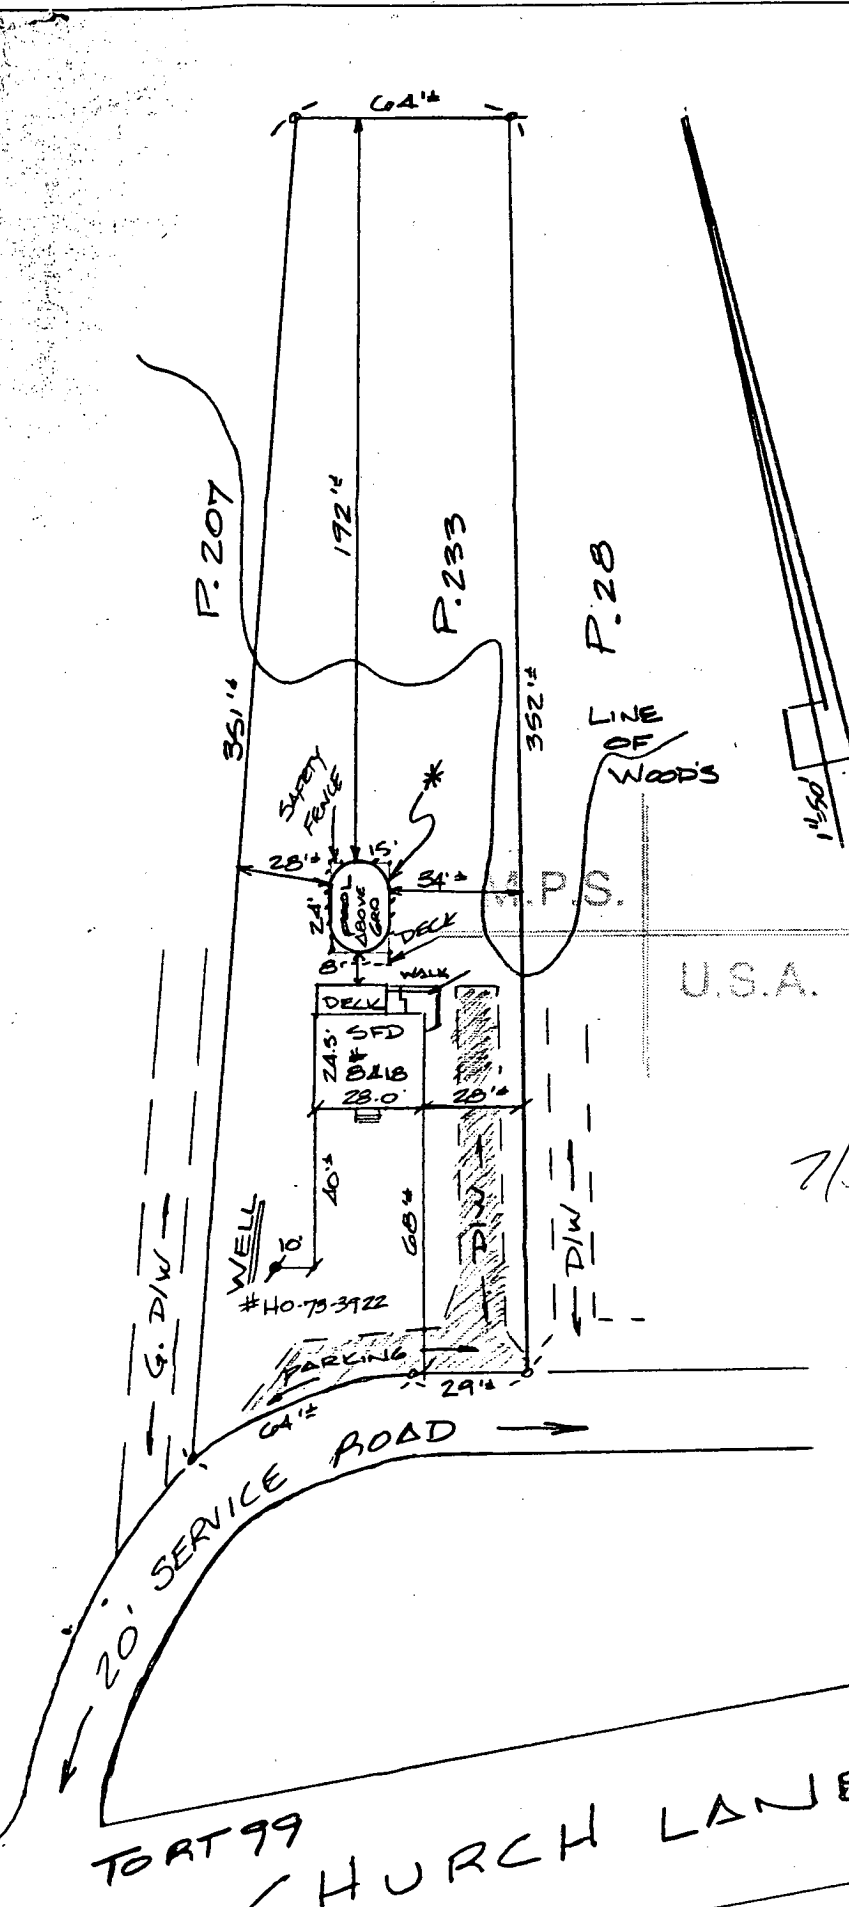

POOL LOCATION PLAN

8418 CHURCH LANE
 2ND DIST. HOWARD CO.
 MAP # 18 BLK # 13 PARCEL # 233
 .67 AC

NOTE

LOT IS SERVICED BY:
 WELL IN FRONT YARD
 PUBLIC SEWER SYS.
 * OWNER TO PREPARE POOL
 SITE AREA TO A 4" GRADE

INSTALLING

NEW SWIMMING POOL
 ABOVE GROUND TYPE
 15' X 24' OVAL SIZE
 SAFETY FENCE & DECK AREA
 CART. FILTER SYS. N/B WASH SYS
 OWNER TO FILL POOL W/WATER

7/5/84 OR. JED

OWNERS

GENEVIEVE F. & WIFE
 "BIERMAN"
 8418 CHURCH LANE
 ELLICOTT CITY MD 21043
 PH. # 465-1675
 HOWARD CO. MD