

SEPTIC SYSTEM REPAIR / UPGRADE / EVALUATION REQUEST

Please fill out this form completely and check off the reason for the request:

Date requested: _____

Reason for Request

Failing System (includes surface discharge or inadequate treatment zone) _____

Has the contractor verified through excavation/pumping evaluation, that there are no pipe blockages? _____

In support of a building permit. Type of building addition: 1 Brm

*System relocation for proposed addition for setback compliance _____

*Verification of adequate system capacity per COMAR 26.04.02.02D (4) _____

To replace collapsed septic tank or upgrade tank capacity

To replace collapsed drywell _____

Septic Contractor: Fogle's Septic Clean Inc

Contractor's Address: 580 Obrecht Rd

Sykesville, MD

Contractor's Phone #: 410 795-5670

Property Address: 3356 Danmark Dr

Property (Subdivision) & Lot # _____

Owner's Name: Christine Callahan

Is public sewer available/nearby: N/A

Names of Any Previous Owners: _____

Year House Built: _____

of Existing Bedrooms: 4

of Bedrooms after completion of addition: 5

Has this request been discussed previously with a Sanitarian, who? _____


If public sewer is close, further research will be performed to verify availability and possible hook up to public sewer.

A Sanitarian will be in contact within three business days depending upon the urgency of the situation to coordinate the scheduling of the repair /upgrade/evaluation. No inspection will be performed without fee collection at the office.

Environmental Sanitarian tentatively assigned _____

1. SITE ADDRESS: 3356 DANMARK DRIVE, GLENWOOD, MD.
2. EXISTING ZONING IS RR-DEO
3. BOUNDARY LINES SHOWN HEREON ARE BASED ON BOUNDARY EVIDENCE
4. THE LOTS SHOWN HEREON COMPLY WITH THE MINIMUM OWNERSHIP WIDTH AND LOT AREA AS REQUIRED BY THE MARYLAND STATE DEPARTMENT OF THE ENVIRONMENT.
5. AREA OF THE PROPOSED SEPTIC EASEMENT 10,000 SQUARE FEET
6. TO THE BEST OF MY KNOWLEDGE AND BELIEF ALL SEPTIC SYSTEMS, WELLS AND SEWAGE DISPOSAL EASEMENTS WITHIN 100 FEET OF THE BOUNDARY LINES HAVE BEEN LOCATED.
7. ALL EXISTING WELLS AND SEPTIC SYSTEMS WITHIN 100' OF THE PROPERTY BOUNDARIES HAVE BEEN SHOWN. ALL REASONABLE EFFORTS WERE USED TO FIND THE LOCATION OF ALL SURROUNDING WELL AND SEPTIC SYSTEMS.
8. ANY CHANGES TO A PRIVATE SEWAGE EASEMENT SHALL REQUIRE A REVISED PERCOLATION CERTIFICATION PLAN.
9. EXISTING SEPTIC TANK WILL BE UPGRADED TO 2,000 GALLONS PRIOR TO BUILDING PERMIT APPROVAL
10. THIS PLAN IS IN SUPPORT OF THE ADDITIONS AS SHOWN ON THIS PLAN.

THIS AREA DESIGNATES A MINIMUM 10,000 SQUARE FOOT PRIVATE SEWAGE EASEMENT REQUIRED BY THE MARYLAND STATE DEPARTMENT OF THE ENVIRONMENT FOR INDIVIDUAL SEWAGE DISPOSAL IMPROVEMENTS OF ANY NATURE IN THIS AREA ARE RESTRICTED UNTIL PUBLIC SEWAGE IS AVAILABLE. THESE EASEMENTS SHALL BE NULL AND VOID UPON CONNECTION TO A PUBLIC SYSTEM. THE COUNTY HEALTH OFFICER SHALL HAVE THE AUTHORITY TO GRANT VARIANCES FOR ENCROACHMENT INTO THE PRIVATE SEWAGE EASEMENT. RECORDATION OF A MODIFIED SEWAGE EASEMENT SHALL NOT BE NECESSARY.

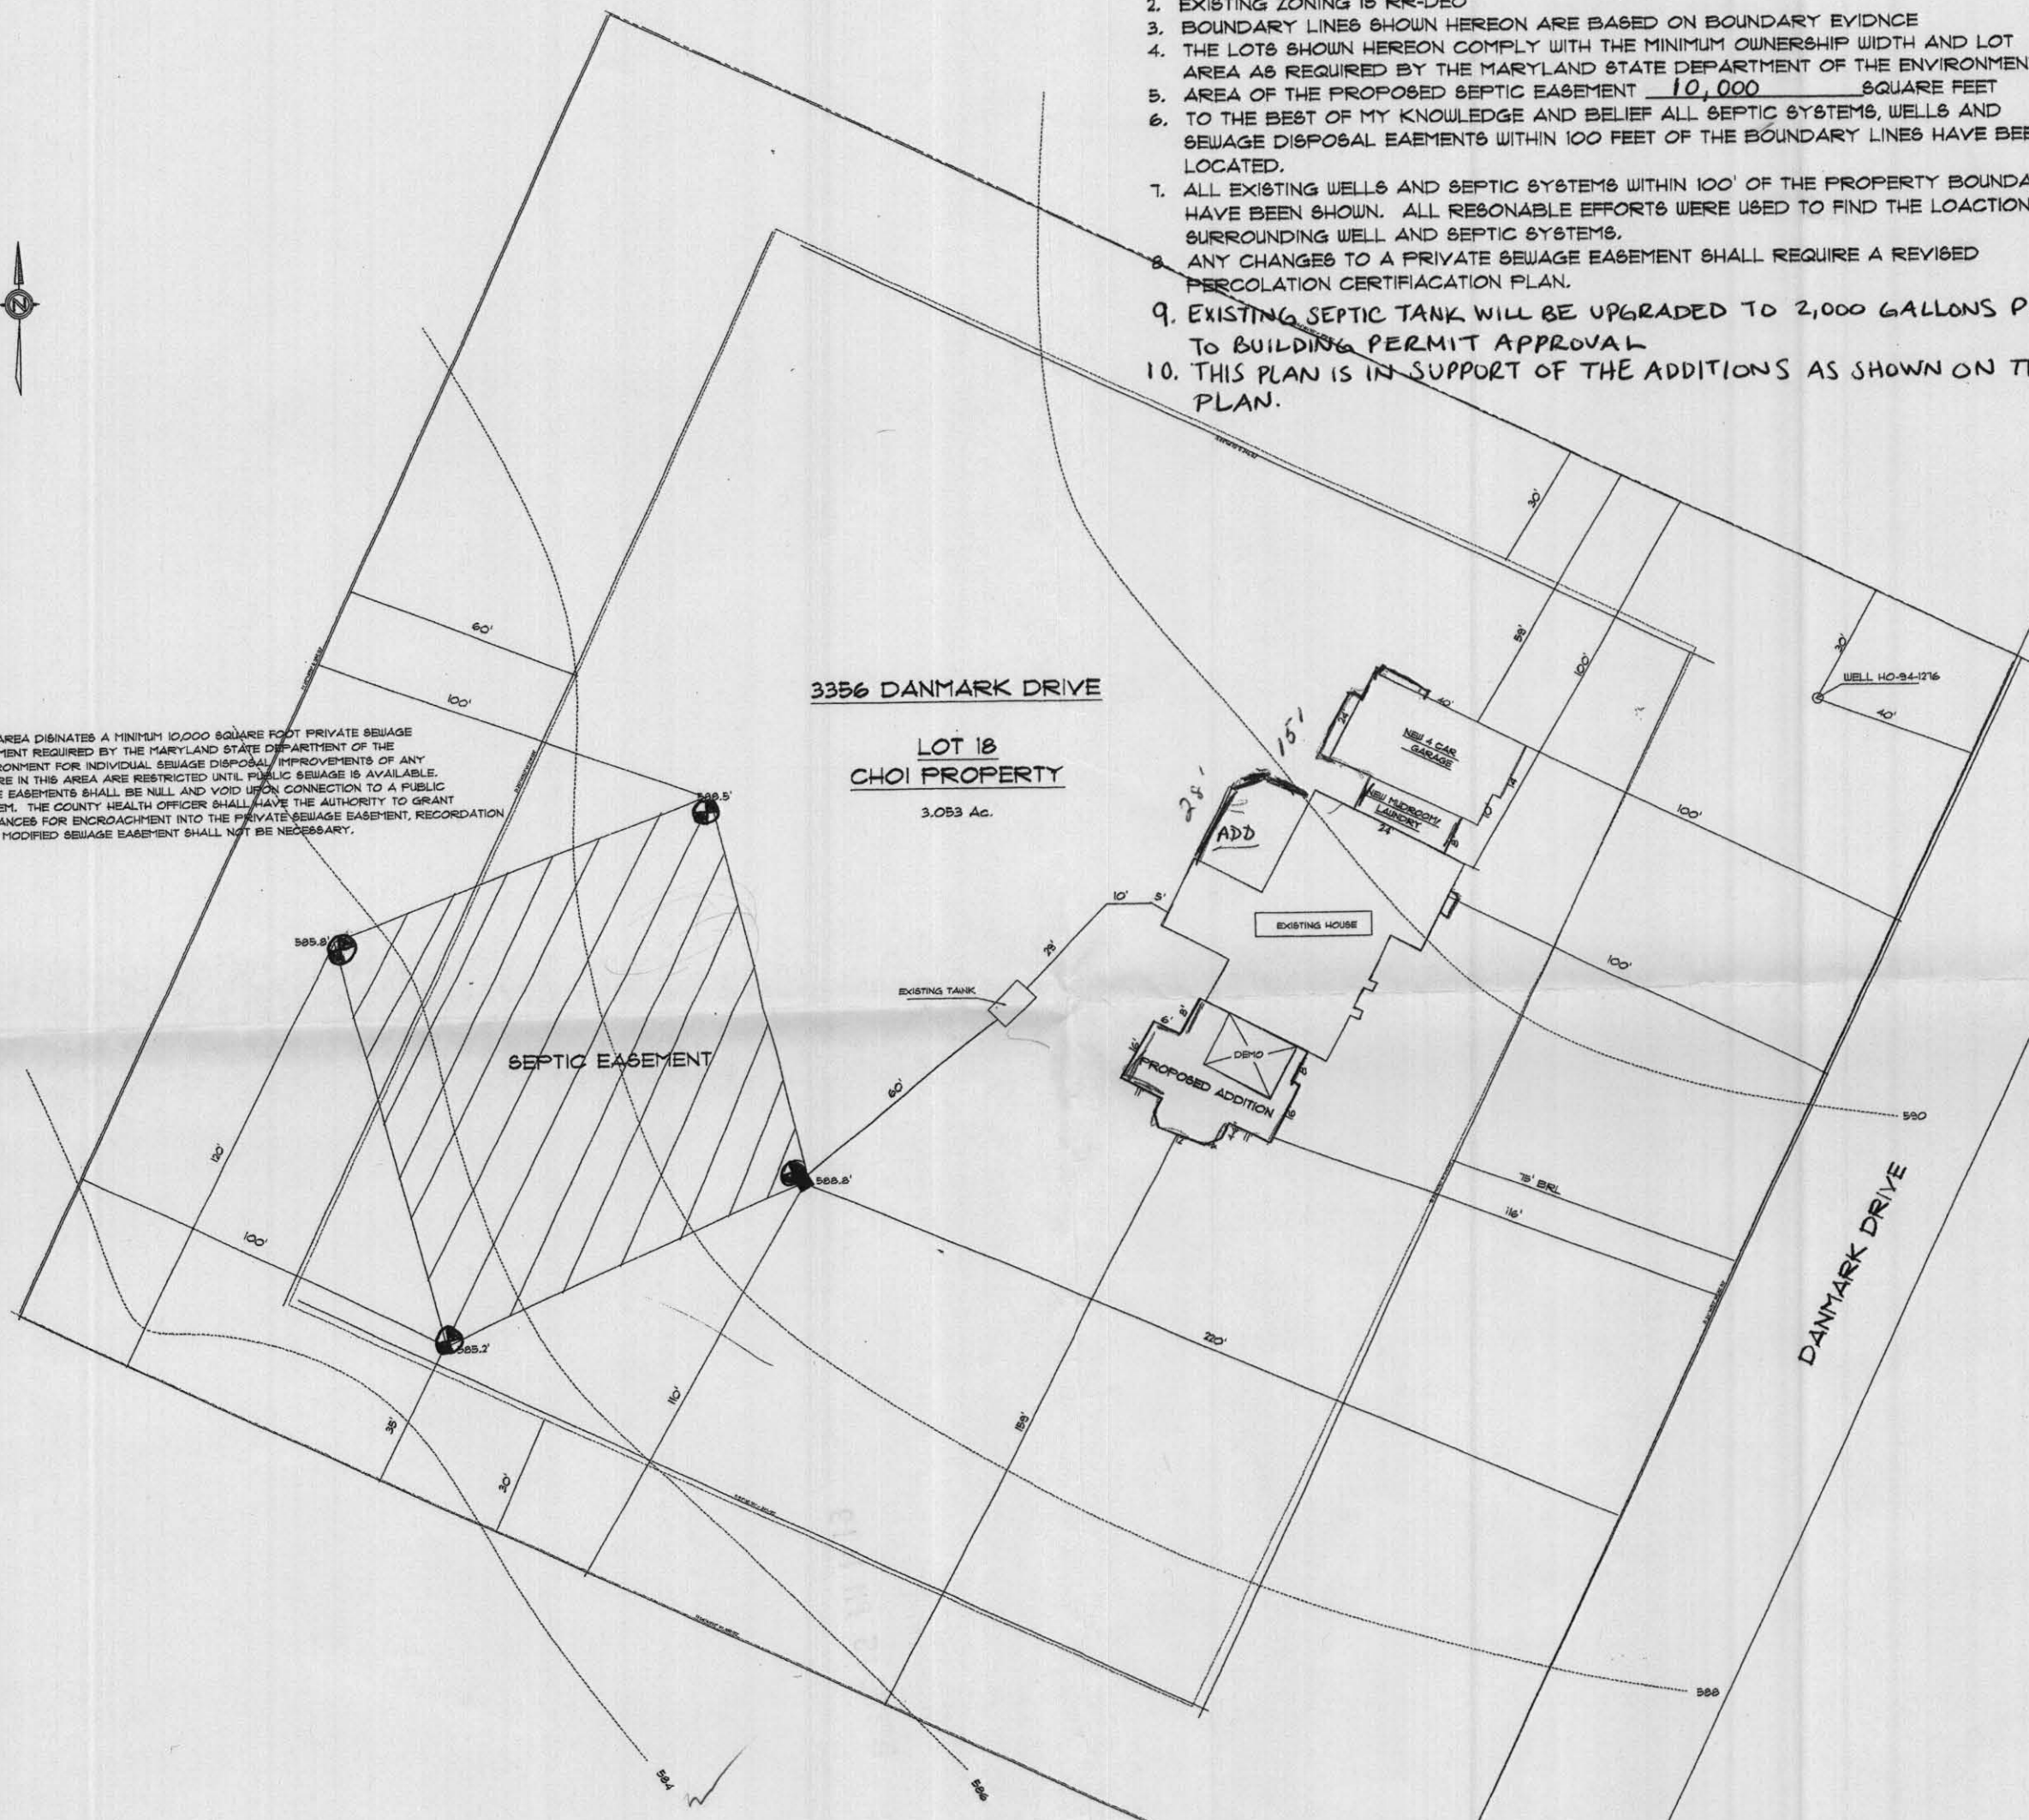

3356 DANMARK DRIVE

LOT 18
CHOI PROPERTY

3.053 Ac.

SEPTIC EASEMENT

**PERCOLATION
CERTIFICATION PLAN**

DATE 07/12/08

SCALE 1" = 40'

OWNER: STEVE & CHRISTINE CALLAHAN
3356 DANMARK DRIVE
GLENWOOD, MD
410.442.0010

⊕ passed perc test

BOUNDARY SURVEY AND HOUSE LOCATION SURVEY
AS BASED ON DATA AS PREPARED BY:
FISHER, COLLINS & CARTER, INC 3.31.98
PERCOLATION PLAN PREPARED BY:
FRED C. DICKSON CO., INC.

PROPERTY TOPOGRAPHY AS PROVIDED BY HOWARD COUNTY
SEPTIC EASEMENT ELEVATIONS FIELD RAN

I CERTIFY THAT THE INFORMATION SHOWN
HEREON IS BASED ON FIELD WORK
PERFORMED BY ME OR UNDER MY DIRECT
SUPERVISION, AND IS CORRECT, TO THE
BEST OF MY KNOWLEDGE AND BELIEF

APPROVED FOR PRIVATE WATER
& PRIVATE SEWERAGE SYSTEMS
IN CONFORMANCE WITH THE
MASTER PLAN OF HOWARD COUNTY

Christine Callahan 7/17/08
OWNER'S SIGNATURE DATE

Robert J. Callahan
HEALTH OFFICER DATE
15 8/6/08