

INDEXED

PERMIT

SEWAGE DISPOSAL SYSTEM

DEPARTMENT OF HEALTH AND MENTAL HYGIENE

P _____

A 514724-C

DISTRICT _____

DATE _____

HOWARD COUNTY HEALTH DEPARTMENT

BUREAU OF ENVIRONMENTAL HEALTH

461-9933

DATE SYSTEM APPROVED _____

INSPECTOR _____

RPS # 247828

_____ IS PERMITTED TO INSTALL _____ ALTER _____

ADDRESS _____ PHONE _____

SUBDIVISION _____ LOT _____ ROAD 4363 College Ave

PROPERTY OWNER _____

ADDRESS _____

SEPTIC TANK CAPACITY _____ GALLONS

NUMBER OF BEDROOMS _____

_____ SQUARE FEET PER BEDROOM

LINEAR FEET OF TRENCH REQUIRED _____

PLANS APPROVED BY _____ DATE _____

COVER NO WORK UNTIL INSPECTED AND APPROVED

NEITHER THE HOWARD COUNTY COUNCIL NOR THE HEALTH DEPARTMENT IS RESPONSIBLE FOR THE SUCCESSFUL OPERATION OF ANY SYSTEM

NOTE: CLEANOUT REQUIRED EVERY 70 FEET OF SEWER LINE AND/OR AT 90° SWEEPS IN LINES FROM HOUSE TO DRAIN FIELDS, 90° ELBOWS NOT ACCEPTABLE.

NOTE: ALL PARTS OF SEPTIC SYSTEMS (I.E. TANK, DISTRIBUTION BOX TRENCHES) TO BE 100 FEET FROM WELL (UNLESS OTHERWISE SPECIFICALLY AUTHORIZED)

NOTE: IF DEEP TRENCH(ES) ARE USED CALL FOR INSPECTION BEFORE AND AFTER PLACING GRAVEL IN TRENCH(ES)

NOTE: NO DRY WELL SHALL EXCEED 15 FOOT IN DIAMETER NO ABSORPTION TRENCH TO EXCEED 100 FEET IN LENGTH

NOTE: ALL PIPE FROM HOUSE TO SEPTIC TANK MUST BE CAST IRON OR SCHEDULE 35/40 PVC OR ABS


PERMIT VOID AFTER TWO YEARS

NOTE: INSTALL STAND PIPE ON SEPTIC TANK AND DRY WELL STAND PIPES MUST BE 6 INCHES IN DIAMETER CAST IRON, CONCRETE OR TERRA COTTA OR PVA OR ABS ACCEPTED. IF TOP OF SEPTIC TANK IS DEEPER THAN 3 FEET, MANHOLE TO GRADE REQUIRED.

NOTE: DISTRIBUTION BOXES MUST HAVE BAFFLES

***INSTALLER IS RESPONSIBLE FOR OBTAINING FINAL APPROVAL ON THIS PERMIT**

A 514724C

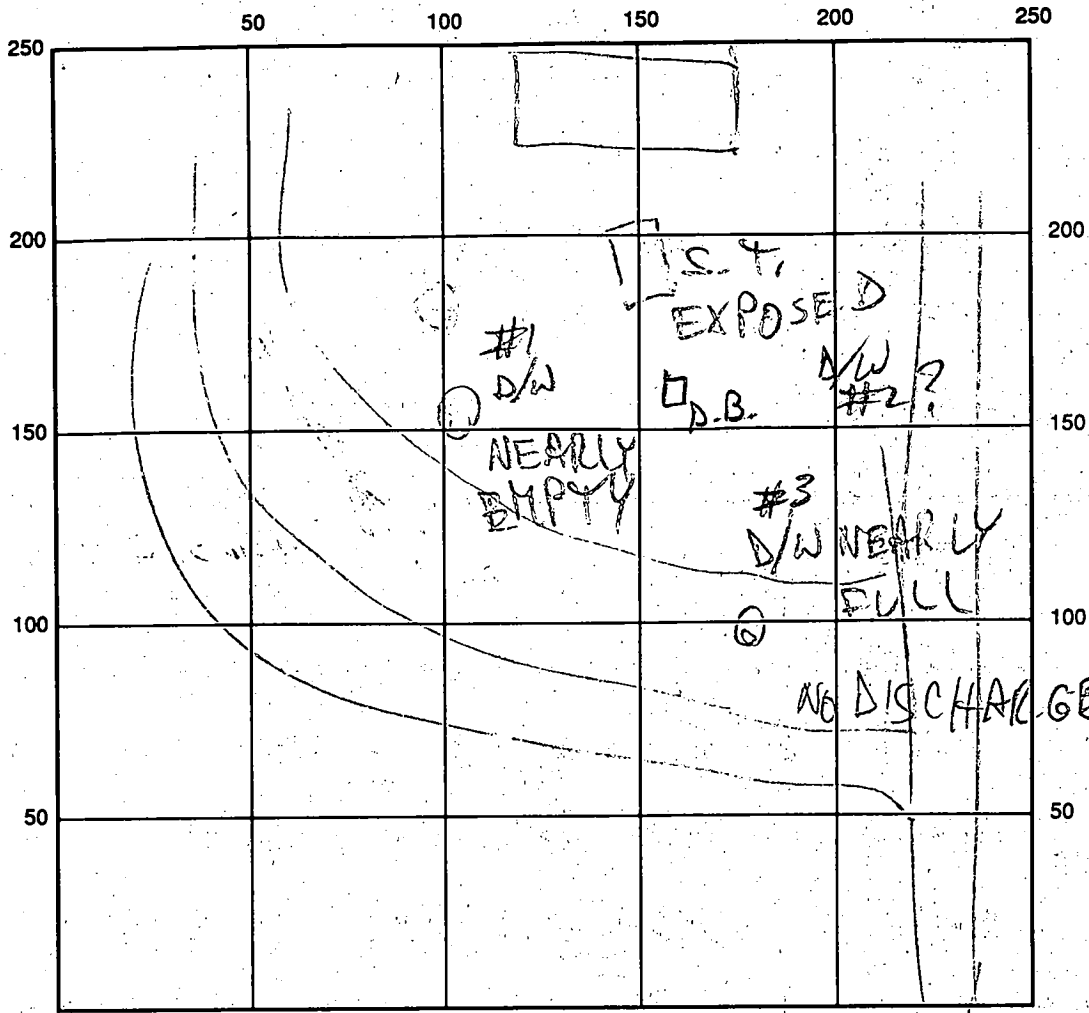

INDICATE NORTH - NAME ADJOINING ROADWAY AS BASE LINE

SEPTIC TANK LEVEL _____ CLEANOUTS _____

DISTRIBUTION BOX LEVEL _____

DRAIN FIELD/TITLE DEPTH _____ FT. TRENCH WIDTH _____ FT. INLET DEPTH _____ FT.

EFFECTIVE GRAVEL DEPTH _____ FT. TOTAL LENGTH _____ FT.

NUMBER OF TRENCHES _____ ONE SIDEWALL/BOTTOM AREA _____ SQ. FT.

DRYWALL INSIDE DIAMETER _____ FT. EFFECTIVE DEPTH BELOW INLET _____ FT.

ABSORBENT AREA _____ SQ. FT.

REMARKS: 5/3/95 D/W #3 TAKING ALL H₂O => DISCHARGE; D/W #1 LOCATED, NEARLY EMPTY; OWNER TO RESET PIPES @ D.B. TO PROVIDE EVEN FLOW; MR 5/5/95 OWNER REPAIRING DETERIORATED D.B. BY REPOURING FORM; WILL RESET PIPES TO MINIMIZE/ELIMINATE FLOW TO D/W #3, MAXIMIZE FLOW TO #1, #2 MR 5/10/95 NO DISCHARGE OBS'D MR 5/12/95 NO

DATE SYSTEM APPROVED _____ INSPECTOR _____

DISCHARGE OBS'D MR 6/2/95 NO DISCHARGE OBS'D DB COVERED ONLY BY TARP (MR)



HOWARD COUNTY HEALTH DEPARTMENT

Joyce M. Boyd, M.D., County Health Officer

June 2, 1995

Mr. Harry Byrns
4363 College Avenue
Ellicott City, MD 21043

RE: Termination of Notice of Violation
4363 College Avenue

Dear Mr. Byrns,

On May 10, May 12, and June 2, 1995, Mark Rifkin, a sanitarian from this office conducted follow-up inspections at your property located at the above referenced address. These inspections were conducted to evaluate the status of your septic system and the effectiveness of the repairs which had been performed in the preceding weeks. On those dates, Mr. Rifkin observed that the sewage discharge which had been previously noted had ceased.

Therefore, the Notice of Violation issued on April 24, 1995 pursuant to Section 12.110 of the Howard County Code is hereby terminated.

Please be advised that backfilling all parts of the septic system is the most effective method to prevent injuries and limit inputs of rainwater or other foreign materials. If you wish to maintain easy access to the distribution box, installation of a manhole would be appropriate.

Please note that: 1) all septic systems will fail eventually due to saturation of surrounding soils; 2) because of their age, older systems are more likely to be close to failure; 3) and more extensive repairs will likely be necessary when the septic system fails again. Any repair extensive enough to require a new septic tank or new drainfields also requires a septic system repair permit (fee \$25).

If you have any questions, please call me at 313-2640. Thank you very much for your cooperation in this matter.

Very truly yours,

Mark E. Rifkin, R.S.
Water and Sewerage Program

MER

cc: File

Bureau of Environmental Health
3525-H Ellicott Mills Drive Ellicott City, Maryland 21043-4544
Water and Sewerage, Permits (410) 313-2640 Community Environmental Health (410) 313-2644
Food Protection Program (410) 313-2642 TDD (410) 313-2323

Is your RETURN ADDRESS completed on the reverse side?

SENDER:

- Complete items 1 and/or 2 for additional services.
- Complete items 3, and 4a & b.
- Print your name and address on the reverse of this form so that we can return this card to you.
- Attach this form to the front of the mailpiece, or on the back if space does not permit.
- Write "Return Receipt Requested" on the mailpiece below the article number.
- The Return Receipt will show to whom the article was delivered and the date delivered.

I also wish to receive the following services (for an extra fee):

1. Addressee's Address
2. Restricted Delivery

Consult postmaster for fee.

3. Article Addressed to:

Mr. Harry Byrns
 4363 College Avenue
 Ellicott City, Maryland 21043

4a. Article Number
 Z 398 831 884

4b. Service Type

Registered Insured
 Certified COD
 Express Mail Return Receipt for Merchandise

7. Date of Delivery
 4/28/95

5. Signature (Addressee)
Beverly J. Byrns

6. Signature (Agent)

8. Addressee's Address (Only if requested and fee is paid)

Thank you for using Return Receipt Service.



HOWARD COUNTY HEALTH DEPARTMENT

Joyce M. Boyd, M.D., County Health Officer

April 24, 1995

Mr. Harry Byrns
4363 College Avenue
Ellicott City, Maryland 21043

NOTICE OF VIOLATION

Address: 4363 College Avenue
Tax Map 25, Parcel 261

Dear Mr. Byrns:

On March 29, 1995, Mr. Mark Rifkin, Sanitarian from this office inspected your property known as Tax Map 25, Parcel 261, located at 4363 College Avenue in response to a report of an overflowing septic system. On that occasion, Mr. Rifkin observed sewage flowing into a pvc pipe installed under the driveway, eventually discharging into the nearby stream.

This condition is in violation of Section 12.110 of the Howard County Code.

As the failing septic system creates a condition which is, or may be hazardous to the public health, you are hereby ordered to apply to this office for a septic system repair permit and effect repairs within fifteen (15) days of receipt of this letter. The cost of the septic repair permit is \$25.00. Until repairs are completed you must immediately (within 48 hours) have the septic tank and drywell contents pumped by a licensed sewage scavenger; and continue pumping, as often as necessary to prevent future sewage overflows.

Based on your report of financial difficulties, enclosed is an application packet for financial assistance offered by the Howard County Office of Housing and Community Development.

If you believe that the condition described above is not and could not be a hazard to health, or that the Health Department is not acting in compliance with pertinent laws and regulations, you may request a formal hearing before the Board of Health within ten (10) days of receipt of this letter. If you wish to discuss the evidence, the regulations, or your individual circumstances, you are encouraged to request a meeting with us by calling 313-2640 and scheduling an appointment.


Mr. Harry Byrns

Page 2

The investigation of this complaint and the enforcement powers of the Health Department are set forth in Section 12 of the Howard County Code, a copy of which is available for your investigation at this office.

If you have any questions, please contact Mr. Mark Rifkin or myself at 313-2640.

Very truly yours,



Craig Williams, Program Director
Water and Sewerage Program

CW:vr

cc: Mark Rifkin, Sanitarian
File

Enclosure:

Harry Burns

gravel drive

used to be Taylor's Dr

sewage installed ^{one} month ago
under drive to

drainage ditch to stream

light bluish green house

one hill before Bonnie Branch

after new arrows at

bottom hill (no #s on mailbox
black mailbox)

REGION _____

AREA _____ RATING _____

ACKNOWLEDGMENT AND CONTROLS	DATE

Howard County (Department of Health)
BUREAU OF ENVIRONMENTAL HEALTH

RECORD OF INVESTIGATION

DISPOSITION	DATE

LOCATION 4363 College Ave ZIP _____

OWNER Harry Burns ADDRESS same PHONE 465-5345

OCCUPANT _____ ADDRESS _____ PHONE _____

COMPLAINANT Anonymous ADDRESS _____ PHONE _____

REASON FOR INVESTIGATION quickie "repair" of failing septic to stream via drainage ditch

RECEIVED BY M. Rifkin DATE 3/28/85 ASSIGNED TO M.R DATE 3/29

DATE OF INVESTIGATION 3/29 TIME 3:30 WEATHER cool, cloudy

REPORT 3/29 ~~W~~ TALKED TO OWNERS WHO READILY ADMITTED DISCHARGE; OWNERS ELDERLY / ~~CK~~ POOR, WILLING TO ~~REPAIR~~ REPAIR SYSTEM, SMALL SLOT, LOOKS ROCKY, VERY LIMITED REPAIR OPTIONS; ADVISED OWNERS I WOULD LOOK INTO FINANCIAL ASSISTANCE; THEY WOULD "GET BACK TO US AS SOON AS POSSIBLE"; ALSO REQUESTED PUMP JOB BUT THEY ADVISED ME THAT WAS DIFFICULT GIVEN MONEY SITUATION (SANITARIAN OBS'D ~~POOR~~ SEWAGE FLOWING INTO INSTALLED DISCHARGE PIPE LEADING TO THE NEARBY STREAM)

DATE SUBMITTED _____ SANITARIAN _____

SITE INSPECTION SHEET

OWNER: Harry Burns

DATE REQUESTED: 3/29/95

PHONE #: _____


CONTRACTOR: _____

ADDRESS: 4363 College Ave

WELL TAG #: _____

COUNTY #: _____


PROPOSAL: failing septic "repaired" to stream
drainage ditch

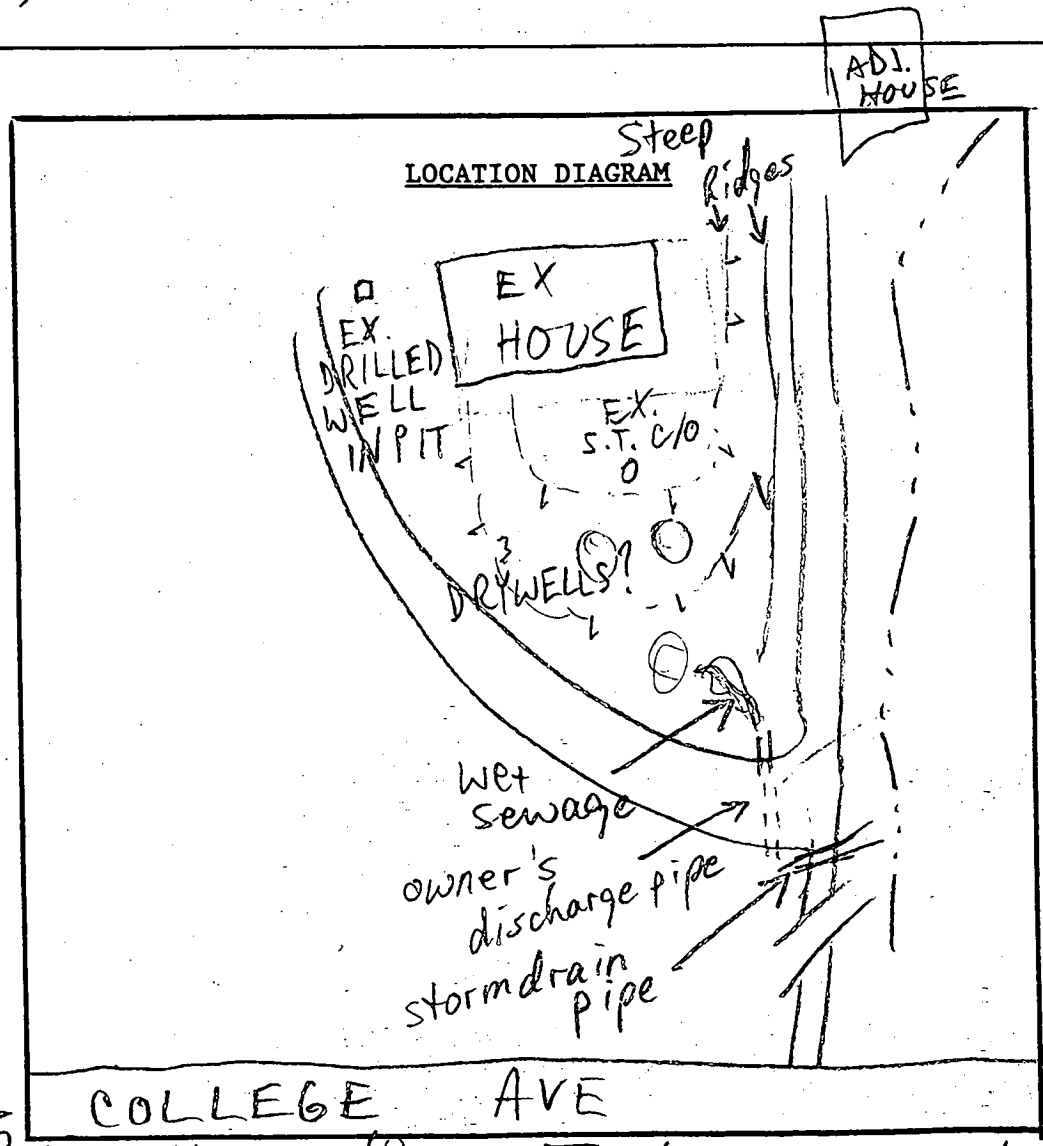

3/28/95
COMMENTS: 1960 House (Burns, Taylor poss. ownership listing)

DATE: _____ INSPECTOR: _____

BALTIMORE COUNTY
MAP 100

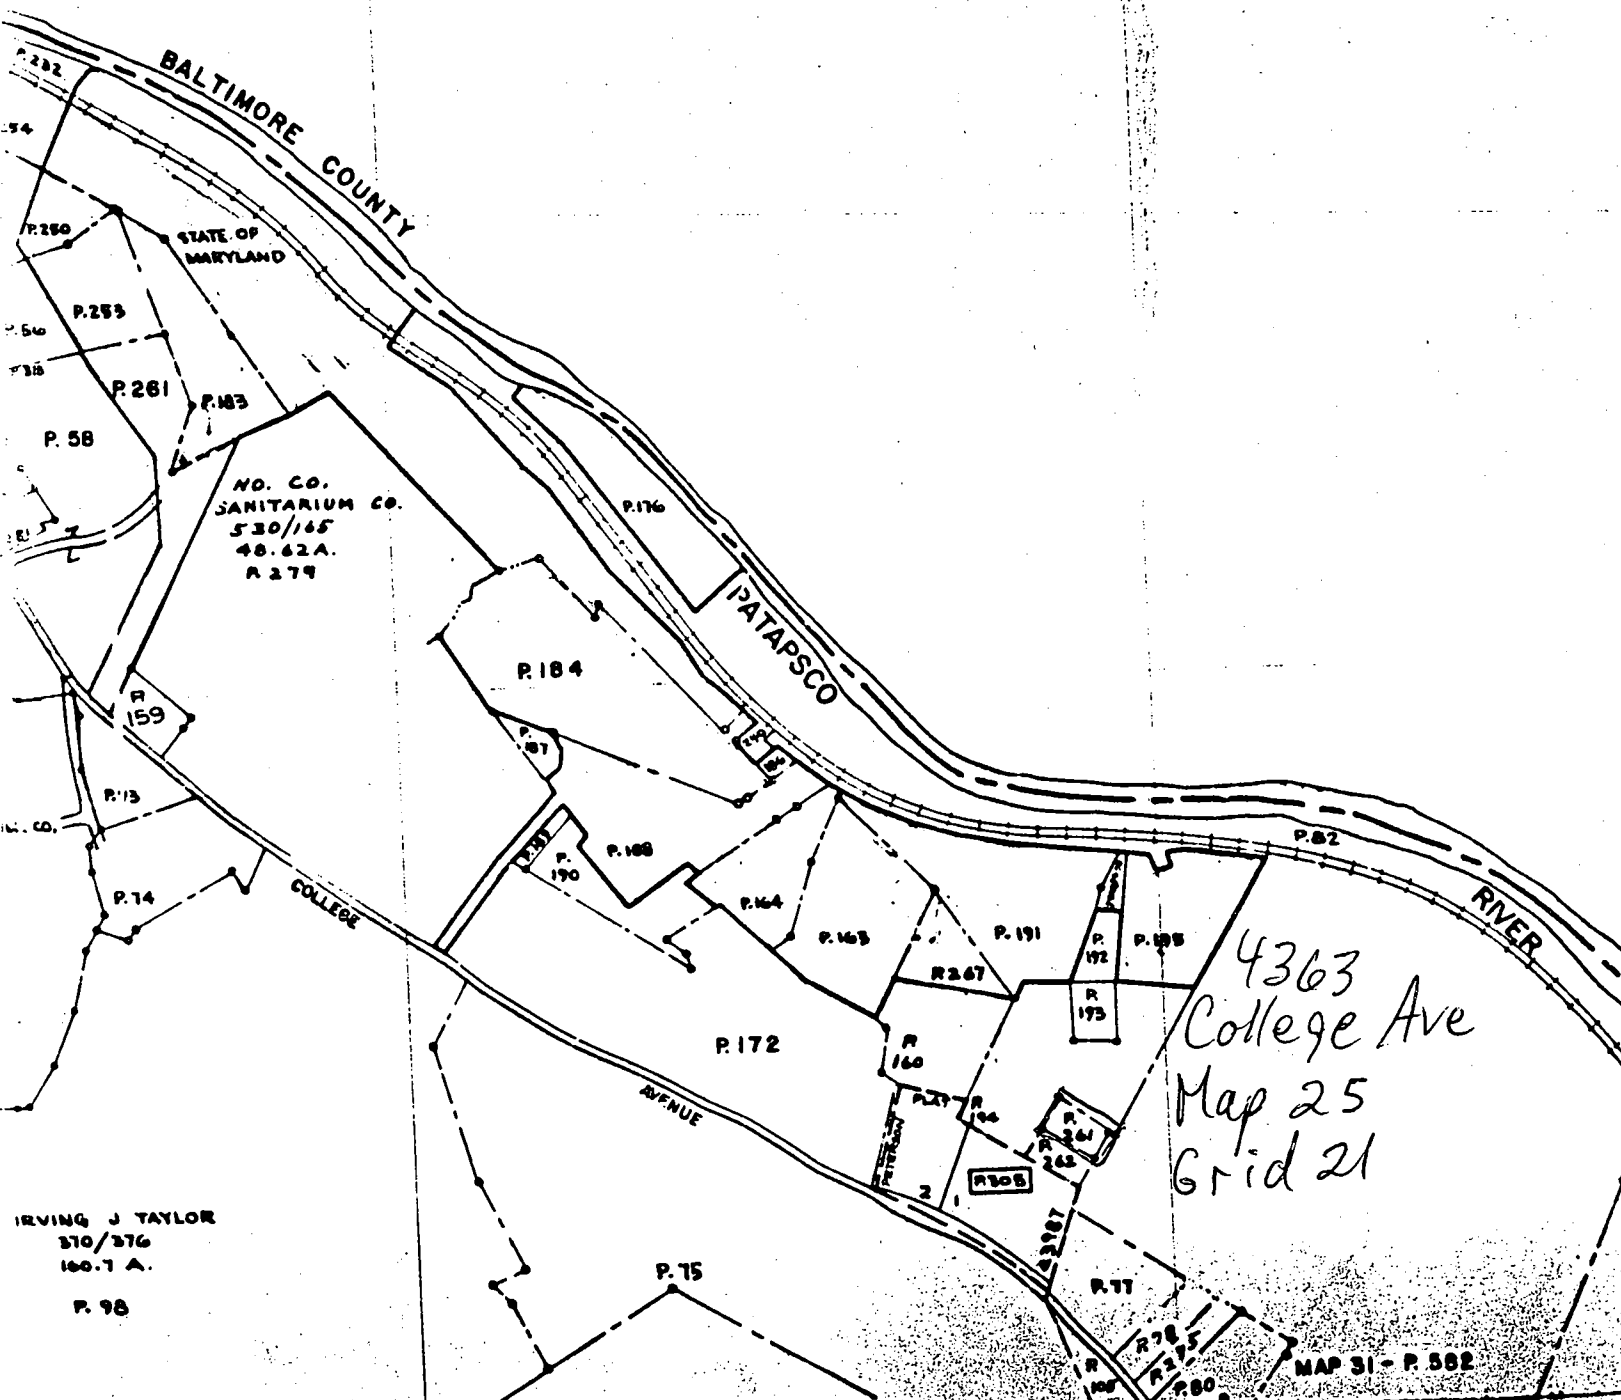

4363
College Ave
Map 25
Grid 21

IRVING J TAYLOR
370/376
160.7 A.
P. 98

NO. CO.
SANITARIUM CO.
530/165
48.62A.
R 279