


A# 07110

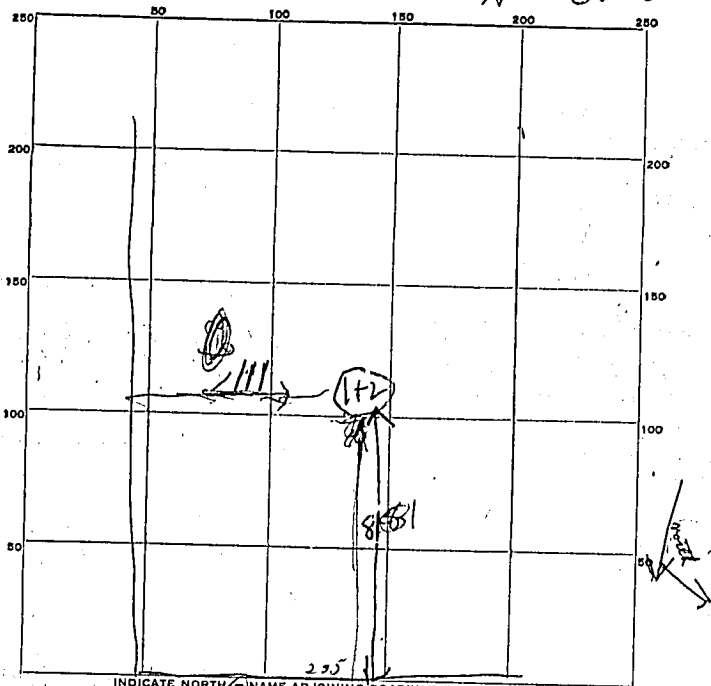

INDICATE NORTH - NAME ADJOINING ROADWAY AS BASE LINE.

Day Road

| DATE    | TEST NO. | DEPTH | PRE-WET |      | TEST - 1" DROP |      | TIME  |
|---------|----------|-------|---------|------|----------------|------|-------|
|         |          |       | START   | STOP | START          | STOP |       |
| 7/12/63 | 1        | 9     | 9:53    | 9:26 | 956            | 959  | 4 min |
|         | 2        | 5     | 1000    |      |                | 1001 | 1 min |
|         |          |       |         |      |                |      |       |
|         |          |       |         |      |                |      |       |
SOIL AUGER FINDING first 5ft rocky - then sand rest of hole.

TESTED BY 7/12/63 DWM

REMARKS \_\_\_\_\_

ALSO PRESENT David R. Mallet LOT NO. 3