

RPS# 335627

PERMIT

SEWAGE DISPOSAL SYSTEM

DEPARTMENT OF HEALTH AND MENTAL HYGIENE

P _____

A 5147339

DISTRICT _____

DATE _____

HOWARD COUNTY HEALTH DEPARTMENT
BUREAU OF ENVIRONMENTAL HEALTH
461-9933

INDEXED

DATE SYSTEM APPROVED _____

INSPECTOR _____

Jack Fyack IS PERMITTED TO INSTALL _____ ALTER _____

ADDRESS _____ PHONE _____

SUBDIVISION Glenwood Estates LOT 28 ROAD 14629 Mustang Path

PROPERTY OWNER Thomas Ulrich

ADDRESS _____

PLANS APPROVED BY _____ DATE _____

COVER NO WORK UNTIL INSPECTED AND APPROVED

NEITHER THE HOWARD COUNTY COUNCIL NOR THE HEALTH DEPARTMENT IS RESPONSIBLE FOR THE SUCCESSFUL OPERATION OF ANY SYSTEM

NOTE: CLEANOUT REQUIRED EVERY 70 FEET OF SEWER LINE AND/OR AT 90° SWEEPS IN LINES FROM HOUSE TO DRAIN FIELDS, 90° ELBOWS NOT ACCEPTABLE.

NOTE: ALL PARTS OF SEPTIC SYSTEMS (I.E. TANK, DISTRIBUTION BOX TRENCHES) TO BE 100 FEET FROM WELL (UNLESS OTHERWISE SPECIFICALLY AUTHORIZED)

NOTE: IF DEEP TRENCH(ES) ARE USED CALL FOR INSPECTION BEFORE AND AFTER PLACING GRAVEL IN TRENCH(ES)

NOTE: NO DRY WELL SHALL EXCEED 15 FOOT IN DIAMETER NO ABSORPTION TRENCH TO EXCEED 100 FEET IN LENGTH

NOTE: ALL PIPE FROM HOUSE TO SEPTIC TANK MUST BE CAST IRON OR SCHEDULE 35/40 PVC OR ABS

PERMIT VOID AFTER TWO YEARS

NOTE: INSTALL STAND PIPE ON SEPTIC TANK AND DRY WELL STAND PIPES MUST BE 6 INCHES IN DIAMETER CAST IRON, CONCRETE OR TERRA COTTA OR PVA OR ABS ACCEPTED. IF TOP OF SEPTIC TANK IS DEEPER THAN 3 FEET, MANHOLE TO GRADE REQUIRED.

NOTE: DISTRIBUTION BOXES MUST HAVE BAFFLES

*INSTALLER IS RESPONSIBLE FOR OBTAINING FINAL APPROVAL ON THIS PERMIT

*CALL 461-9933 FOR INSPECTION OF SEPTIC SYSTEMS

5147339

SEWAGE DISPOSAL TESTING

STATE OF MARYLAND - DEPARTMENT OF HEALTH AND MENTAL HYGIENE

HOWARD COUNTY HEALTH DEPARTMENT
ENVIRONMENTAL HEALTH SERVICES

P. O. BOX 476, ELLICOTT CITY, MARYLAND 21043
TELEPHONE: 469-8686, EXT. 338

DISTRICT 400

DATE 12/20/78

TO: THE COUNTY HEALTH OFFICER
ELLICOTT CITY, MARYLAND

I, HEREBY, APPLY FOR THE NECESSARY TEST IN ORDER TO CONSTRUCT (OR RECONSTRUCT) A SEWAGE DISPOSAL SYSTEM.

PROPERTY OWNER Justice Tract Joint Venture

ADDRESS 1131 University Blvd. W. #215, Silver Spring, Md. 20902 PHONE 301-649-1500

PROPERTY LOCATION:

SUBDIVISION Glenwood Estates LOT NO. 47 Sec I

ROAD AND DESCRIPTION E.E. Southwest of intersection of Shady Lane & Barnstead Rd.

SIZE OF LOT 60,000 s.f. TYPE BLDG. 3-4 Bedrooms
NUMBER OF BEDROOMS

IF NOT SINGLE RESIDENCE DESCRIBE _____

THE SYSTEM INSTALLED UNDER THIS APPLICATION IS ACCEPTABLE ONLY UNTIL PUBLIC FACILITIES BECOME AVAILABLE.

SIGNATURE OF APPLICANT Justice Tract Joint Venture By [Signature] Partner


APPROVED BY _____ FOR _____ DATE _____
(KIND OF SYSTEM)

REJECTED BY _____ FOR _____ DATE _____
(KIND OF SYSTEM)

HOLD PENDING FURTHER TESTS _____ DATE _____

REASONS FOR REJECTION OR HOLDING _____

THIS IS NOT A PERMIT

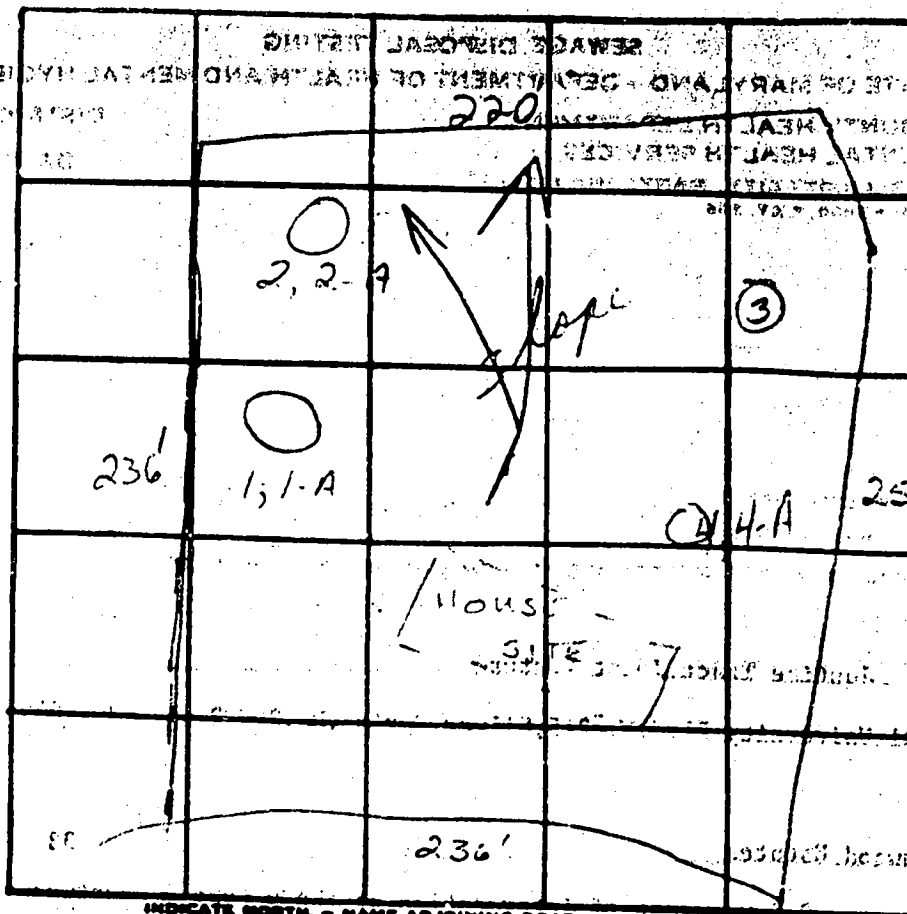

Lot 33


E = 93 mm

INDICATE NORTH - NAME ADJOINING ROADWAY AS BASE LINE
UNNAMED ROAD

DATE	TEST NO.	DEPTH	PRE-WET		TEST - 1" DROP		TIME	
			START	STOP	START	STOP		
1/74	1	5	12:19	12:31	12:31	12:57	26	
	1-A	12	12:18	12:22	12:22	12:31	9	
	2	5	12:27	12:37	12:37	12:58	18	
	2-A	12	12:27	12:33	12:33	12:39	6	
	3	1 1/2	Visual, sim to 1-1-A; dry					
	4	4 1/2	1:05	1:08	1:08	1:16	8	
	4-A	12	1:02	1:02	1:07	1:15	8	

REMARKS W/E Also present AM

TYPE OF SOIL loam-sand

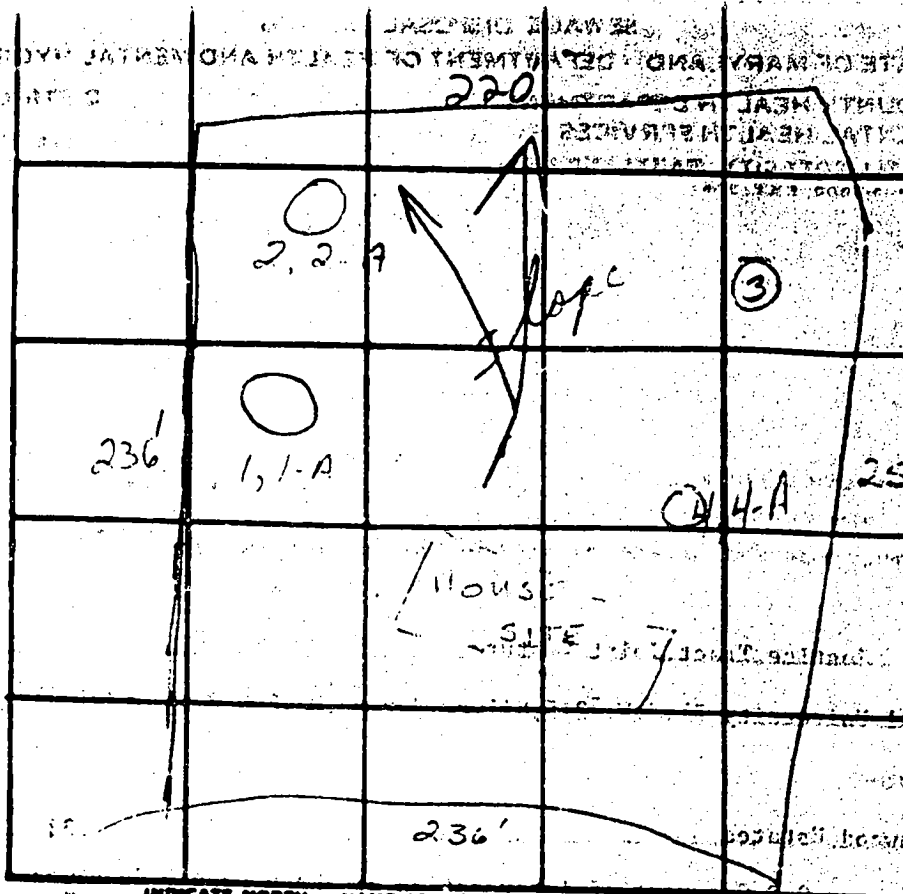

INDICATE NORTH - NAME ADJOINING ROADWAY AS BASE LINE

UNNAMED ROAD

Lot 33

E = 13 ft

DATE	TEST NO.	DEPTH	PRE-WET		TEST - 1" DROP		TIME	
			START	STOP	START	STOP		
1/74	1	5	12:19	12:31	12:31	12:57	26	
	1-A	12	12:18	12:22	12:22	12:31	9	
	2	5	12:29	12:37	12:37	12:55	18	
	2-A	12	12:27	12:33	12:33	12:39	6	
	3	1 1/2	Visual; sim to 1, 1-A; dry					
	4	4 1/2	1:05	1:08	1:08	1:16	8	
	4-A	12	1:02	1:07	1:07	1:15	8	

REMARKS WWZ Also present PM

TYPE OF SOIL shady brown

SEQUENCE NO. (OEP USE ONLY)

STATE OF MARYLAND WELL COMPLETION REPORT

THIS REPORT MUST BE SUBMITTED WITHIN 45 DAYS AFTER WELL IS COMPLETED.

IS TO BE PUNCHED IN BOXES 3-6, ON ALL CARDS

COUNTY NUMBER A 34031

DATE Received

DATE WELL COMPLETED 07/19/87

Depth of Well 225 (TO NEAREST FOOT)

PERMIT NO. FROM "PERMIT TO DRILL WELL" 40-81-0630

OWNER Ulrich Thomas, STREET OR RFD Mustang Path, TOWN Glenwood, SUBDIVISION Glenwood Estates, SECTION 1, LOT 28

WELL LOG table with columns: DESCRIPTION, FEET (FROM, TO), Check if water bearing. Includes entries for Brown shale, Sand, and Gray mica shale.

GROUTING RECORD: WELL HAS BEEN GROUTED (Y), TYPE OF GROUTING MATERIAL: CEMENT CM, BENTONITE CLAY BC, NO. OF BAGS 12, NO. OF POUNDS 128

CASING RECORD: MAIN CASING TYPE ST, Nominal diameter 6, Total depth 100

OTHER CASING (if used) section with empty boxes for diameter and depth.

SCREEN RECORD: screen type or open hole HO, insert appropriate code below

DEPTH (nearest ft.) table with rows 1-3 and columns 8-21, 23-36, 38-51

A WELL WAS ABANDONED AND SEALED WHEN THIS WELL WAS COMPLETED

I HEREBY CERTIFY THAT THIS WELL HAS BEEN CONSTRUCTED IN ACCORDANCE WITH COMAR 10.17.13 "WELL CONSTRUCTION"

DRILLERS IDENT. NO. 238, DRILLERS SIGNATURE Joseph T. Moyn

SITE SUPERVISOR (sign. of driller or journeyman responsible for sitework if different from permittee)

SLOT SIZE 1 2 3, DIAMETER OF SCREEN (NEAREST INCH)

GRAVEL PACK IF WELL DRILLED WAS FLOWING WELL INSERT F IN BOX 68

OEP USE ONLY (NOT TO BE FILLED IN BY DRILLER) T, LOG INDICATOR, WQ, OTHER DATA

PUMPING TEST: HOURS PUMPED 3, PUMPING RATE 62, METHOD USED TO MEASURE PUMPING RATE Bucket, WATER LEVEL BEFORE PUMPING 35, WHEN PUMPING 132, TYPE OF PUMP USED S (submersible)

PUMP INSTALLED: DRILLER WILL INSTALL PUMP YES (NO), TYPE OF PUMP INSTALLED PLACE (A,C,J,P,R,S,T,O) IN BOX - SEE ABOVE: S

