

PERMIT

SEWAGE DISPOSAL SYSTEM

MARYLAND STATE DEPARTMENT OF HEALTH

HOWARD COUNTY

ELLCOTT CITY

DISTRICT 4

DATE 10/1/77

INDEXED

7/22/77

RPS# 314301

(1521) 514735-A

Lee Eckard IS PERMITTED TO INSTALL ALTER

ADDRESS 955 Fairbore Drive, Rockville, Md. PHONE 877-4960

A SEWAGE DISPOSAL SYSTEM LOCATED AT

SUBDIVISION Nursery View ROAD 767 17356 Old Frederick Rd LOT 7

PROPERTY OWNER Lee Eckard

ADDRESS

SPECIFICATIONS - 4 bedrooms

DRAIN FIELD _____ DEPTH _____ FEET, BOTTOM AREA _____ SQ. FT.

SEEPAGE PITS _____ ABSORBENT SIDE-WALL AREA _____ SQ. FT.

SEPTIC TANK CAPACITY 1,200 GALLONS

FOR GARBAGE GRINDER, INCREASE DISPOSAL AREA 25% & TANK CAPACITY 50%

OTHER Dry well - 100 sq. ft. absorbent sidewall area per bedroom to begin below the first 4 ft. of non-absorbent ground. Max. depth permitted for dry well is 12 ft. below original ground level.
Place dry well 66 ft. from front lot line and 75 ft. from left lot line as seen when facing lot from front lot line.

NOTE: ALL PIPE FROM HOUSE TO DRY WELL MUST BE CAST IRON.

PERMIT VOID AFTER THREE YEARS.

NOTE: INSTALL STAND PIPE ON SEPTIC TANK AND DRY WELL.

PLANS APPROVED BY D. W. Monaghan DATE 4/13/77

FILL SEPTIC TANK AND DISTRIBUTION BOX WITH WATER BEFORE CALLING FOR AN INSPECTION. COVER NO WORK UNTIL INSPECTED AND APPROVED.

NEITHER THE HOWARD COUNTY COMMISSIONERS NOR THE HEALTH DEPARTMENT IS RESPONSIBLE FOR THE SUCCESSFUL OPERATION OF ANY SYSTEM.

BLDG. PERMIT SIGNED

AND RETURNED 11/10/2001
B00 127881 - SUN ROOM

BLDG. PERMIT SIGNED


AND RETURNED 8/4/86
Sua A 72144

514735-A

PERMIT

SEWAGE DISPOSAL SYSTEM
MARYLAND STATE DEPARTMENT OF HEALTH

BOLLING CITY DISTRICT

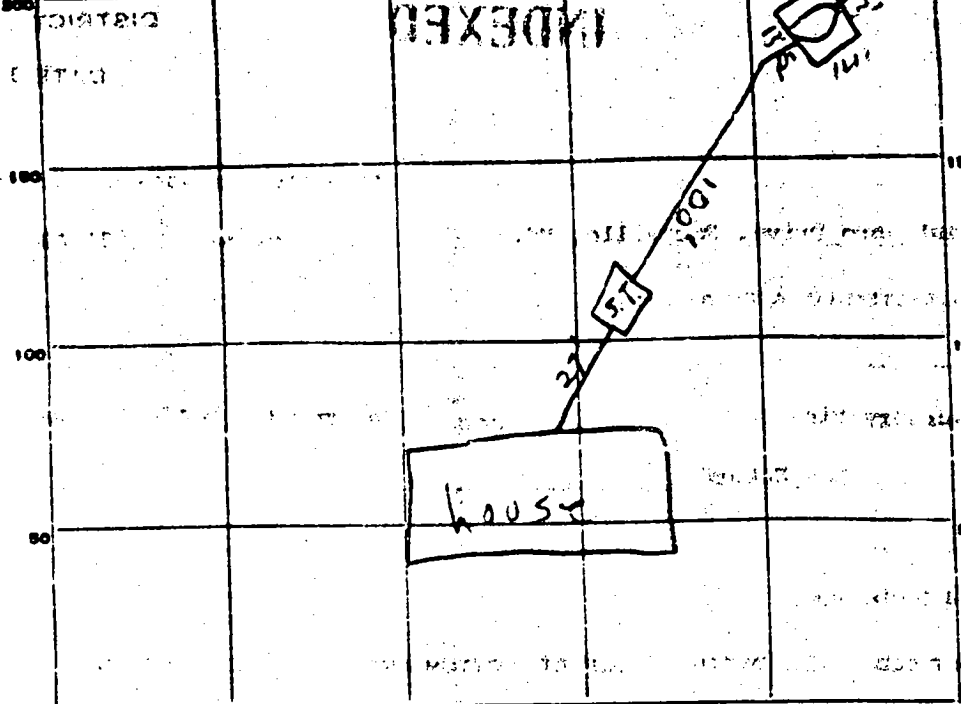

Old (road) Waterville Rd

14
14
13
13

54

PERMIT CARD

S.T. D.W.

SEPTIC TANK, LEVEL

CLEANOUTS

DISTRIBUTION BOX, LEVEL

TILE FIELD, DEPTH

TRENCH WIDTH

40

GRAVEL DEPTH

TOTAL LENGTH

NUMBER OF TRENCHES

TOTAL BOTTOM AREA

SEEPAGE PITS, INSIDE DIAMETER 54 FT.

DEPTH BELOW INLET .82 FT.

73 possible

ABSORBENT AREA 3405 SQ. FT.

REMARKS 7/18/74 Inlet at 3' below original grade; No stand pipe in
in driveway and septic tank Partial Checked only

DATE SYSTEM APPROVED 7/25/74

INSPECTOR R. Mansfield
(cut out of file)

A16234

SEWAGE DISPOSAL TESTING

P _____

MARYLAND STATE DEPARTMENT OF HEALTH

HOWARD COUNTY

ELLICOTT CITY

DISTRICT 4

DATE 8/16/71

TO: THE COUNTY HEALTH OFFICER
ELLICOTT CITY, MARYLAND

I, HEREBY, APPLY FOR THE NECESSARY TESTS IN ORDER TO CONSTRUCT (OR RECONSTRUCT) A SEWAGE DISPOSAL SYSTEM.

PROPERTY OWNER Harry Dove, Nicie Dove, Marie Chason

ADDRESS Route 1, Prospect Road, Mt. Airy, Md.

PHONE 829-0214

PROPERTY LOCATION:

SUBDIVISION NURSERY VIEW

LOT NO. 7

ROAD AND DESCRIPTION Proposed frontage road - relocated Watersville Road

OCCUPANT _____

PHONE _____

PERSON TO CONSTRUCT SYSTEM _____

ADDRESS _____

PHONE _____

SIZE OF LOT 40,000 sq. ft.

TYPE BLDG. 3 or 4

NUMBER OF BEDROOMS _____

IF NOT SINGLE RESIDENCE DESCRIBE _____

SIGNATURE OF APPLICANT /s/ Nicie Dove

APPROVED BY [Signature]

FOR

[Signature]
(KIND OF SYSTEM)

DATE

4-13-72

REJECTED BY _____

FOR

(KIND OF SYSTEM)

DATE


HOLD PENDING FURTHER TESTS _____

DATE

REASONS FOR REJECTION OR HOLDING _____

THIS IS NOT A PERMIT

18 OCT 1971

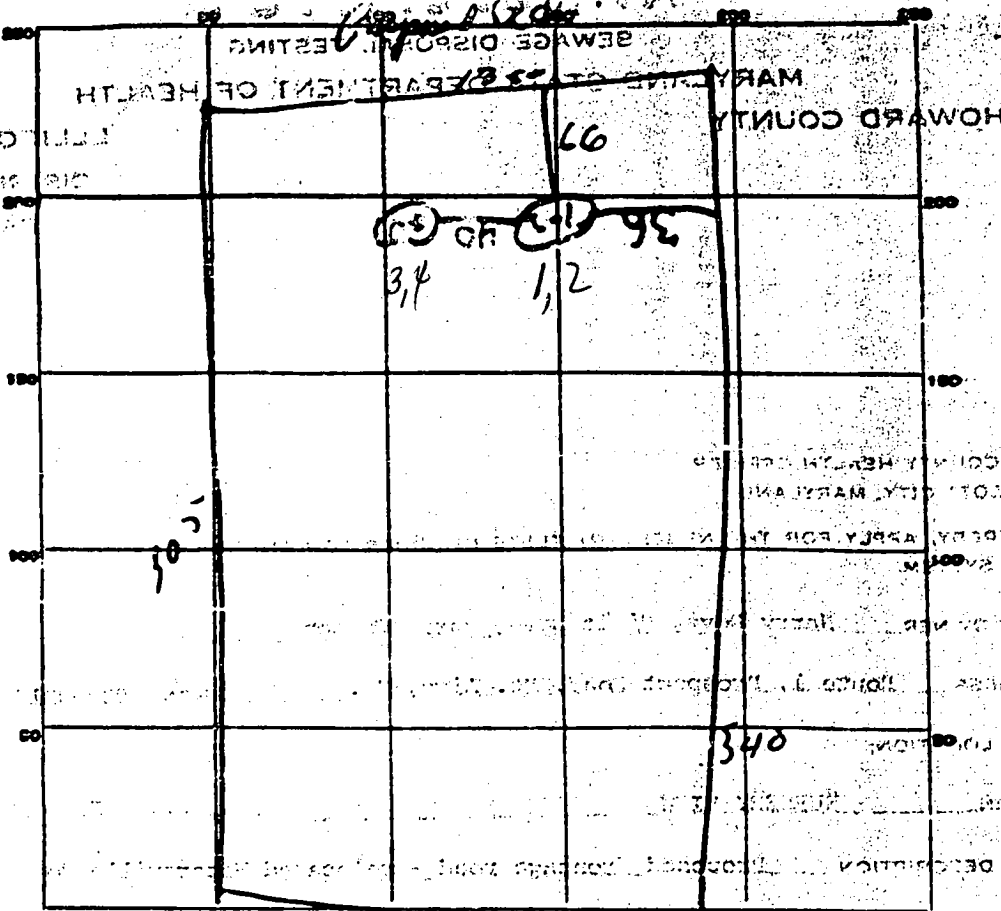

DATE	TEST NO.	DEPTH	PRE-WET		TEST - 1" DROP		TIME
			START	STOP	START	STOP	
06/17/71	1	4 1/2'	10 41	10 45	10 42	10 50	5 pm
	2	6 1/2'	10 42	10 43	10 42	10 49	6 pm
	3	4 1/2'	10 45	10 50	10 46	10 59	9 pm
	4	1 1/2'	10 45	10 46	10 46	10 51	9 pm

SOIL AUGER FINDING _____

TESTED BY _____

REMARKS _____

THIS IS NOT A TEST REPORT
 7. 21 2111

Norsey View

SECTION ONE LOT #7
 1.002 ACRE
 PLAT BOOK 22 pg 93

Lee Eckard


855 MARLBORO DR.
 ROCKVILLE, Md. 20851

Phone:

Home 340-6251

Work 871-4360

D110234

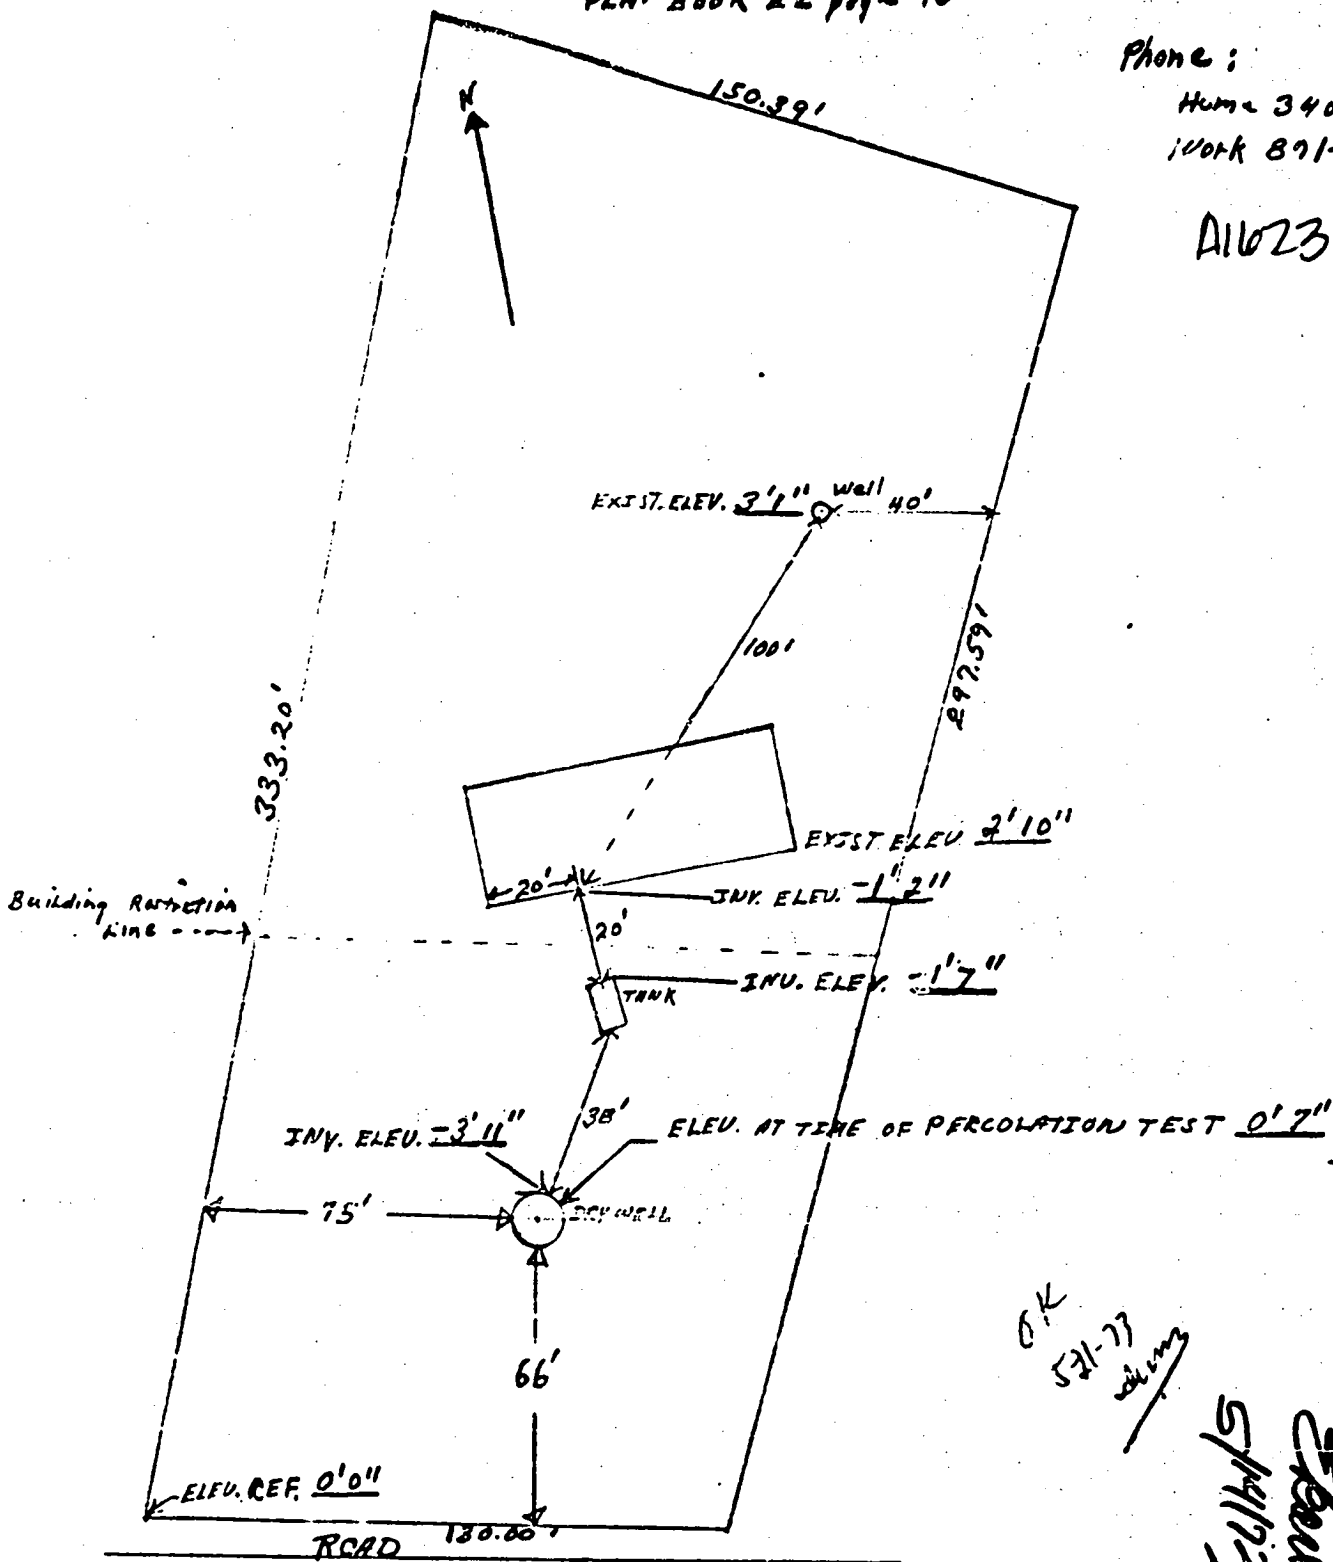

I CERTIFY THE ABOVE MEASUREMENTS AND ELEVATION DIFFERENCES ARE ACTUAL AND CORRECT FOR THIS PROPERTY.

SIGNED: Lee A. Eckard

OK
 5/21-73
 [Signature]

#18011 Lee Eckard
 [Signature]
 5/14/73

HO-73-0246?

WELL COMPLETION REPORT

COUNTY NUMBER 3800 A16234

DATE RECEIVED 9-10-73 DATE WELL COMPLETED 9-10-73 DEPTH OF WELL 280 (TO NEAREST FOOT)

PERMIT NO. FROM "PERMIT TO DRILL WELL" 100-73-0340

DRILLER'S IDENTIFICATION NO. 1111

OWNER SOUTH WISCONSIN HOUSING CORP

STREET OR RFD

POST OFFICE

WELL LOG

STATE THE KIND OF FORMATIONS PENETRATED, THEIR COLOR, DEPTH, THICKNESS AND IF WATER BEARING

DESCRIPTION (USE APPROPRIATE SYMBOLS)	FEET FROM	TO	EXCESS OF WATER
DIRT	0	10	
SLATE	10	280	V

GRouting RECORD

WELL HAS BEEN GROUTED (CIRCLE APPROPRIATE BOX) YES NO

TYPE OF GROUTING MATERIAL (CIRCLE APPROPRIATE BOX) CEMENT BENTONITE CLAY

NO. OF BAGS 7 NO. OF POUNDS 637

GALLONS OF WATER 75

DEPTH OF GROUT SEAL (TO NEAREST FOOT) FROM 0 FT. TO 28 FT.

CASING RECORD

CASING TYPES (CIRCLE APPROPRIATE CODE BELOW) STEEL CONCRETE PLASTIC OTHER

MAIN CASING TYPE NOMINAL DIAMETER TOP (MAIN CASING) (NEAREST INCH) 6 TOTAL DEPTH OF MAIN CASING (NEAREST FOOT) 40

OTHER CASING (IF USED)

DIAMETER (INCH)	DEPTH (FEET) FROM	TO

SCREEN RECORD

SCREEN TYPE OR OPEN HOLE (CIRCLE APPROPRIATE CODE BELOW) STEEL BRASS OR BRONZE OPEN HOLE PLASTIC OTHER

DEPTH (NEAREST WHOLE FOOT) FROM 37 TO 80

NUMBER OF SCREENS

SCREEN NO.	DEPTH (FEET) FROM	TO
1	37	80
2		
3		

SLOT SIZE 1. 2. 3.

DIAMETER OF SCREEN 58 (NEAREST INCH) FROM 58 TO 58

GRAVEL PACK

IF WELL DRILLED WAS A FLOWING WELL (CIRCLE BOX) YES NO

OUR USE ONLY (NOT TO BE FILLED IN BY DRILLER)

TELESCOPE CASING LOG INDICATOR OTHER DATA AVAILABLE

PUMPING TEST

HOURS PUMPED (TO NEAREST HOUR) 1

PUMPING RATE (GALLONS PER MINUTE TO NEAREST GALLON) 2

METHOD USED TO MEASURE PUMPING RATE

WATER LEVEL (DISTANCE FROM LAND SURFACE) BEFORE PUMPING 58 (NEAREST FOOT)

WHEN PUMPING BEGAN 22 (NEAREST FOOT)

TYPE OF PUMP USED (CIRCLE APPROPRIATE BOX) (FOR PUMPING TEST) A AIR P PISTON T TURBINE C CENTRIFUGAL R ROTARY O OTHER (DESCRIBE BELOW) J JET S SUBMERSIBLE

PUMP INSTALLED

TYPE OF PUMP (WRITE APPROPRIATE LETTER IN BOX - SEE ABOVE: A, C, J, P, R, S, T, O)


DRILLER WILL INSTALL PUMP (CIRCLE APPROPRIATE BOX) YES NO

CAPACITY: GALLONS PER MINUTE (TO NEAREST GALLON) 31

PUMP HORSE POWER 37

PUMP COLUMN LENGTH (NEAREST FOOT) 43

CASING HEIGHT (CIRCLE APPROPRIATE BOX AND ENTER CASING HEIGHT) ABOVE BELOW LAND SURFACE (NEAREST FOOT) 50

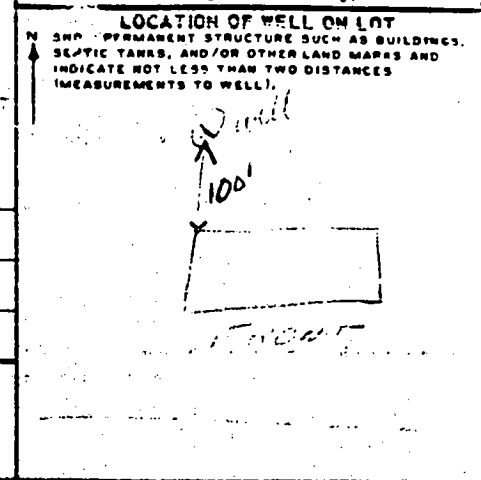

CIRCLE APPROPRIATE BOXES

A WELL WAS ABANDONED AND SEALED WHEN THIS WELL WAS COMPLETED

ELECTRIC LOG OBTAINED

TEST WELL CONVERTED TO PRODUCTION WELL


I HEREBY CERTIFY THAT I HAVE COMPLIED WITH ALL CONDITIONS STATED ON THE ABOVE-CAPTIONED "PERMIT TO DRILL WELL", AND THAT INFORMATION CONTAINED IN THIS REPORT IS TRUE, ACCURATE, AND COMPLETE TO THE BEST OF MY KNOWLEDGE, INFORMATION AND BELIEF.

DRILLER'S NAME

SIGNATURE

DO NOT DISCARD

W. Waverlyville Rd

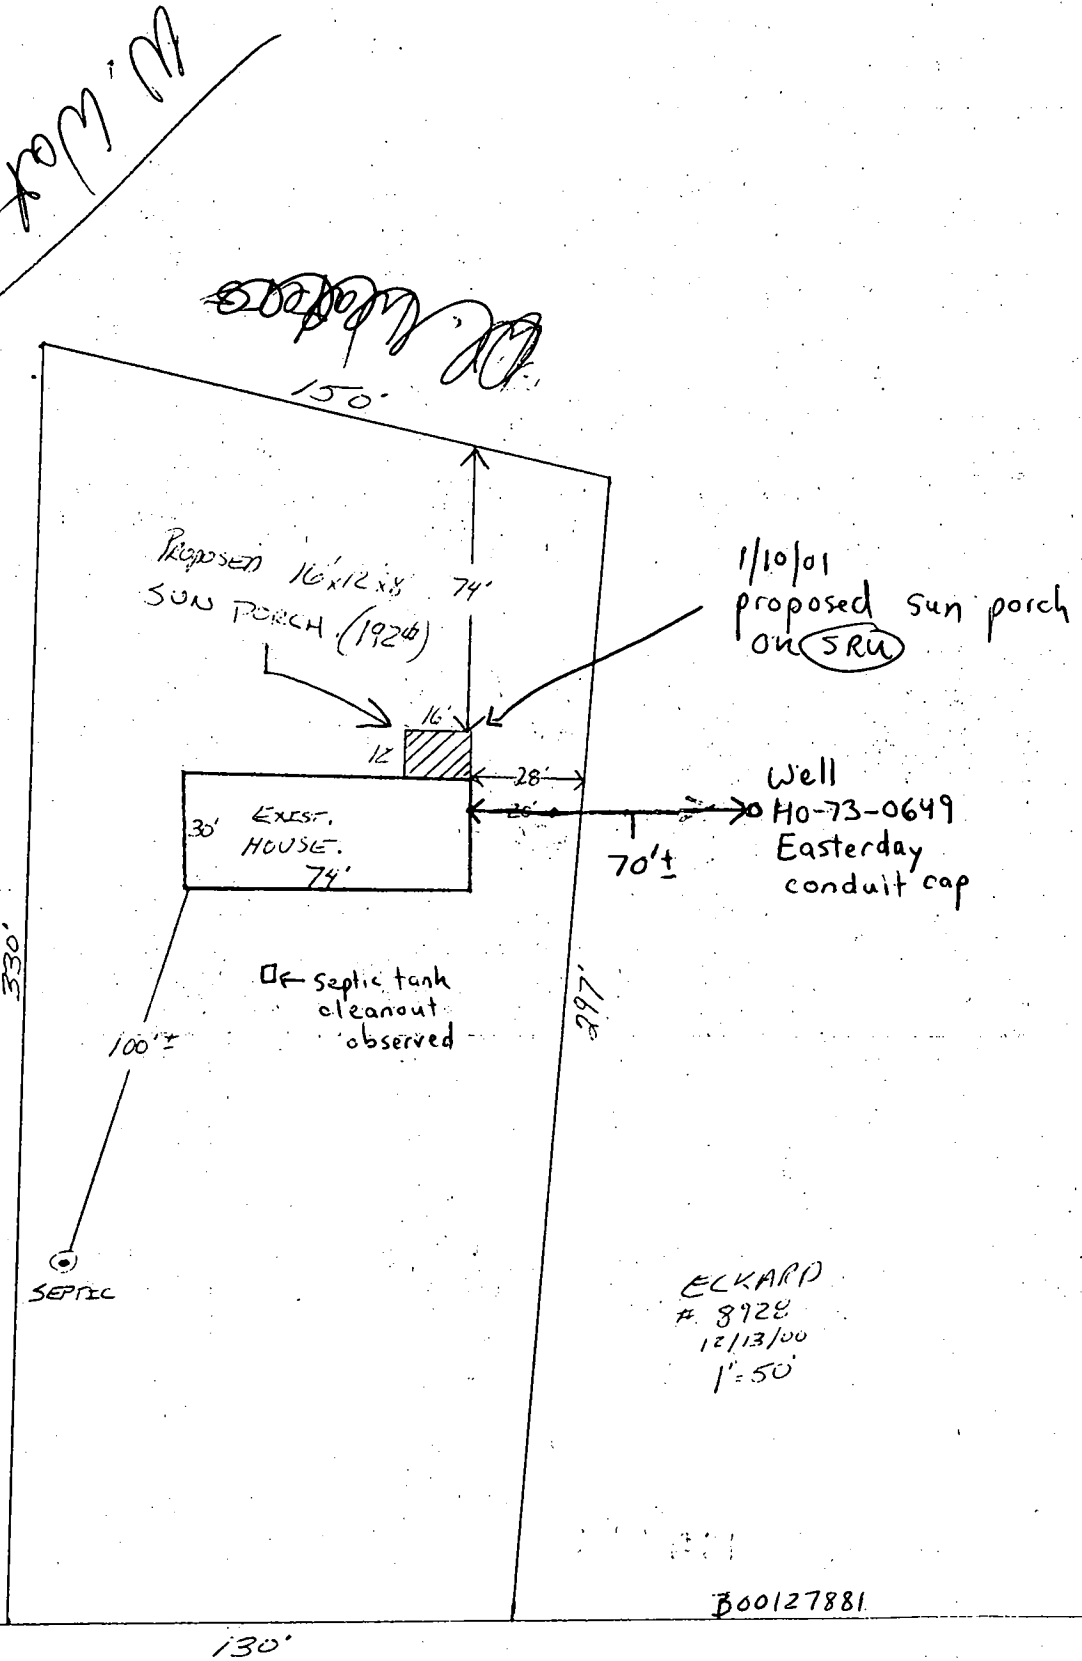

ECKARD
8928
12/13/00
1" = 50'

300127881

ULT FREDERICK RD