

# APPLICATION

SEWAGE DISPOSAL TESTING

A 08115

P \_\_\_\_\_

MARYLAND STATE DEPARTMENT OF HEALTH

HOWARD COUNTY

ELLCOTT CITY

DISTRICT 3

DATE 3/9/64

Septic tank - 750 gal  
Dry Well - 300 sq. ft. absorbent sidewall area  
below inlet pipe. Inlet pipe must be 4 ft below  
original ground level  
Locate drywell <sup>30'</sup> ft from front lot line and <sup>115'</sup> ft  
from ~~left~~ right side line as lot is seen facing  
from Day Road

TO: THE COUNTY HEALTH OFFICER  
ELLCOTT CITY, MARYLAND

I, HEREBY, APPLY FOR THE NECESSARY TESTS IN ORDER TO CONSTRUCT (OR RECONSTRUCT) A SEWAGE DISPOSAL SYSTEM.

PROPERTY OWNER Clarence Bassler

ADDRESS Day Rd., - Sykesville, Maryland PHONE \_\_\_\_\_

PROPERTY LOCATION:

SUBDIVISION \_\_\_\_\_ LOT NO. \_\_\_\_\_

ROAD AND DESCRIPTION Day Rd. - about 1000 ft. from Rt. <sup>32</sup> ~~144~~ at

(about 3 mi. from W. E.) after passing West Friendship

OCCUPANT \_\_\_\_\_ PHONE \_\_\_\_\_

PERSON TO CONSTRUCT SYSTEM \_\_\_\_\_

ADDRESS \_\_\_\_\_ PHONE \_\_\_\_\_

SIZE OF LOT 5 acres TYPE BLDG. 3

NUMBER OF BEDROOMS

IF NOT SINGLE RESIDENCE DESCRIBE \_\_\_\_\_

SIGNATURE OF APPLICANT Carroll W. Keller

APPROVED BY Carroll W. Keller FOR Day Rd. 2.0 DATE 3/17/64

(KIND OF SYSTEM)


REJECTED BY \_\_\_\_\_ FOR \_\_\_\_\_ DATE \_\_\_\_\_

(KIND OF SYSTEM)

HOLD PENDING FURTHER TESTS \_\_\_\_\_ DATE \_\_\_\_\_

REASONS FOR REJECTION OR HOLDING \_\_\_\_\_

## THIS IS NOT A PERMIT

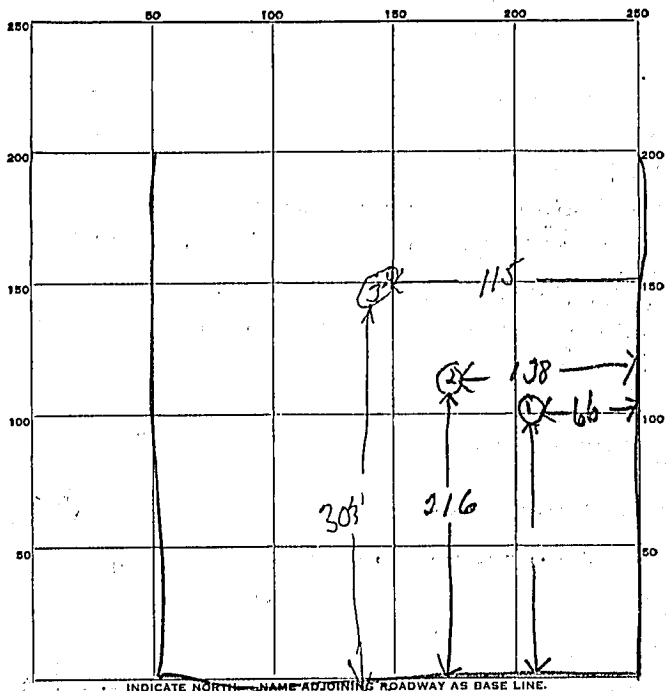

DATE	TEST NO.	DEPTH	PRE-WET		TEST - 1" DROP		TIME
			START	STOP	START	STOP	
3/17/64	1	4ft	117				
	2	9ft	122	124	124	128	4 min
3/11/64	3	4ft	10 <sup>00</sup>	10 <sup>02</sup>	10 <sup>02</sup>	10 <sup>05</sup>	3 min
	4	9ft	10 <sup>00</sup>	10 <sup>02</sup>	10 <sup>02</sup>	10 <sup>06</sup>	4 min

SOIL AUGER FINDING fine red clay

TESTED BY Dum RA = 3/17/64

REMARKS \_\_\_\_\_

ALSO PRESENT Carroll Kelley LOT NO. \_\_\_\_\_