

3/29/69
H. J. [Signature]

off. 3-28-60
[Signature]

PERMIT

SEWAGE DISPOSAL SYSTEM

MARYLAND STATE DEPARTMENT OF HEALTH

HOWARD COUNTY

ELLICOTT CITY

DISTRICT 3

DATE 3/3/69 as
of 12/27/68

P 14190
13926
A 08115

INDEXED

Calvin Miles IS PERMITTED TO INSTALL ALTER

ADDRESS Fulton, Maryland PHONE _____

A SEWAGE DISPOSAL SYSTEM LOCATED AT _____

SUBDIVISION _____ ROAD Day Road LOT 3-B

PROPERTY OWNER Clarence Bassler - now Gordon Walker Property

ADDRESS Day Rd., Sykesville, Md.

SPECIFICATIONS - 3 bedrooms

DRAIN FIELD _____ DEPTH _____ FEET, BOTTOM AREA _____ SQ. FT.

SEEPAGE PITS _____ ABSORBENT SIDE-WALL AREA _____ SQ. FT.

SEPTIC TANK CAPACITY 750 GALLONS

FOR GARBAGE GRINDER, INCREASE DISPOSAL AREA 22% & TANK CAPACITY 50%.

OTHER Dry well - 375 sq. ft. absorbent sidewall area to begin below the first 4 ft. of non-absorbent ground. Max. depth permitted for dry well below original grade is 12 ft. Place dry well 70 ft. from front lot line and 76 ft. from right side line as seen when facing from Day Road.

PERMIT VOID AFTER THREE YEARS.


NOTE: CALL FOR FINAL INSPECTION WHEN GROUND IS FIT. ALL PARTS OF SYSTEM MUST BE PLANS APPROVED BY D. W. Monaghan DATE 11/21/68 UNCOVERED.

FILL SEPTIC TANK AND DISTRIBUTION BOX WITH WATER BEFORE CALLING FOR AN INSPECTION. COVER NO WORK UNTIL INSPECTED AND APPROVED.

NEITHER THE HOWARD COUNTY COMMISSIONERS NOR THE HEALTH DEPARTMENT IS RESPONSIBLE FOR THE SUCCESSFUL OPERATION OF ANY SYSTEM.

NOTIFY THE HEALTH DEPARTMENT 48 HOURS BEFORE EXCAVATIONS ARE TO BE BACK FILLED.

13926

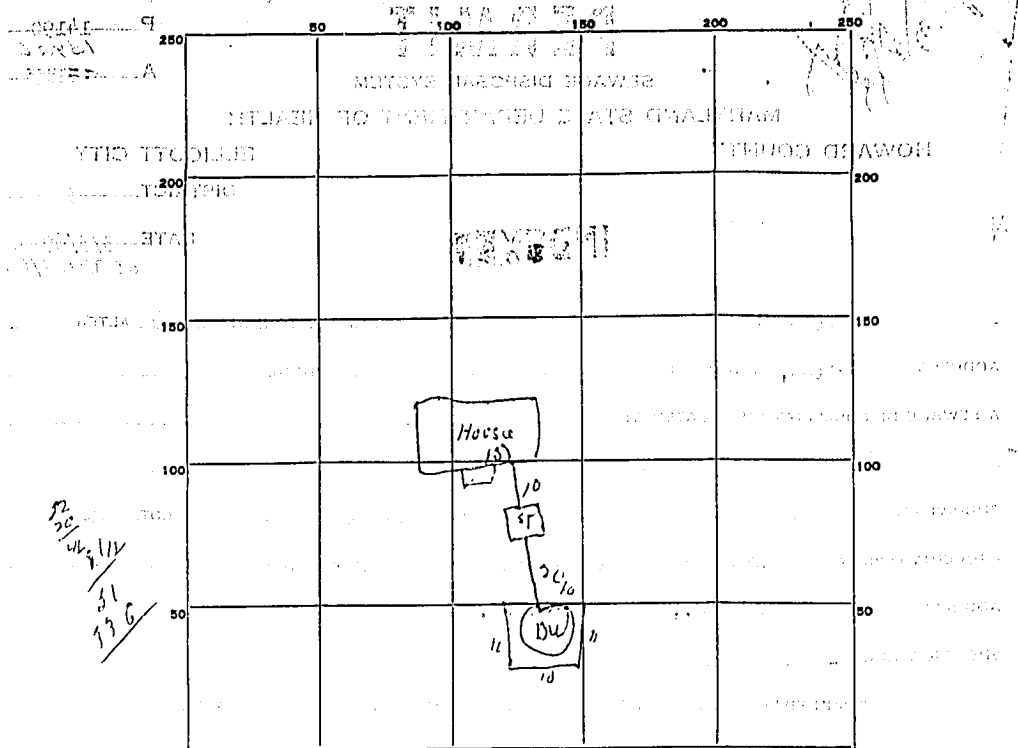

$\frac{52}{20}$
 $\frac{46}{11}$
 $\frac{51}{36}$

INDICATE NORTH. -- NAME ADJOINING ROADWAY AS BASE LINE.

Day Rd

PERMIT CARD not filled

SEPTIC TANK, LEVEL 0.12

CLEANOUTS 0.12

DISTRIBUTION BOX, LEVEL _____

TILE FIELD, DEPTH _____ FT. TRENCH WIDTH _____ FT.

GRAVEL DEPTH _____ IN. TOTAL LENGTH _____ FT.

NUMBER OF TRENCHES _____ TOTAL BOTTOM AREA _____


SEEPAGE PITS, INSIDE DIAMETER 42 FT. DEPTH BELOW INLET 8 1/2 FT.

ABSORBENT AREA 357 SQ. FT.

REMARKS _____

DATE SYSTEM APPROVED 3/28/69 INSPECTOR Wm. W. Maney

RAY ROAD

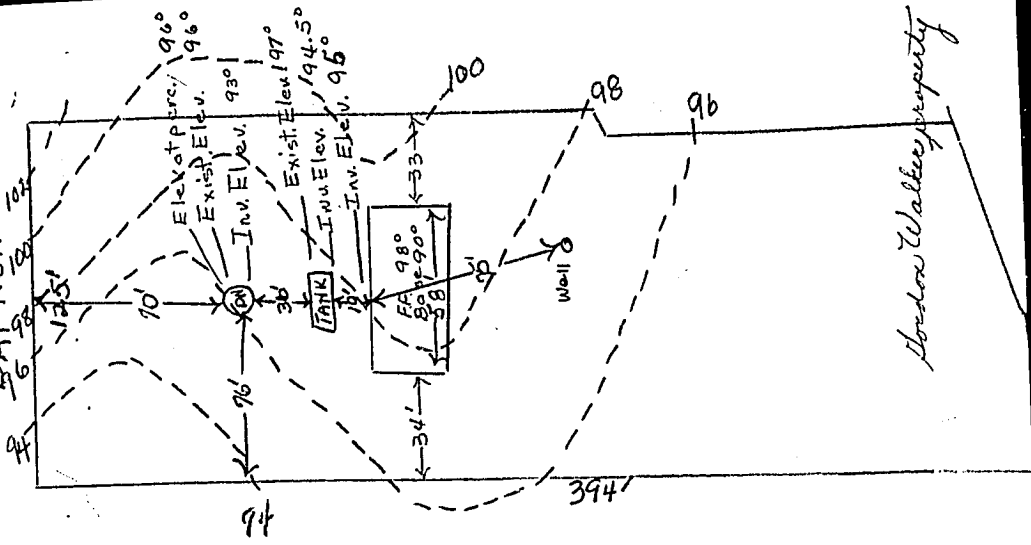

Anderson Walker property

1/11/11
C. Walker