

WR-W-4  
4-56

State Office Building  
ANNAPOLIS, MARYLAND 21401

RECEIVED  
STATE OF MARYLAND  
DEPARTMENT OF  
WATER RESOURCES

THIS REPORT  
MUST BE SUBMITTED  
WITHIN 30 DAYS  
AFTER COMPLETION  
OF THE WELL

WELL COMPLETION REPORT

WELL DESCRIPTION

Permit Number 70690102  
Owner Clarence Bowler  
Address High Street  
Subdivision Bowler Tract  
Section 18 Lot 3

WELL LOG

State the kind of formations penetrated, their color, their depth, their thickness, and if water-bearing

CASING AND SCREEN RECORD

State the kind and size and position of casing, liner, shoe, screen, and other accessories (if no casing used, give diameter of well).

Clay and top soil  
yellow rock  
gray rock  
stream  
Dept of well

FEET  
from 0 to 5  
5/33 ft  
83/  
46 ft  
35 ft  
46 ft

DIAM.  
(inches)  
1 1/2  
1 1/2

FEET  
from 0 to 3

PUMPING TEST

Hours Pumped \_\_\_\_\_  
Type of Pump Used Bowler  
Pumping Rate \_\_\_\_\_  
Gallons per Minute 6

WATER LEVEL

(Distance from land surface to water)  
Before Pumping 30 Ft.  
When Pumping 35 Ft.

APPEARANCE OF WATER

Clear partly cloudy  
Taste none  
Odor none

Height of Casing Above Land


Surface 2 Ft.

PUMP INSTALLED

Type \_\_\_\_\_  
Capacity \_\_\_\_\_  
Gallons per Minute \_\_\_\_\_  
Gallons per Hour \_\_\_\_\_  
Pump Column Length \_\_\_\_\_ Ft.

LOCATION OF WELL ON LOT

Show permanent structures such as building(s), septic tank, and/or other landmarks and indicate not less than 2 distances (measurements) to well.

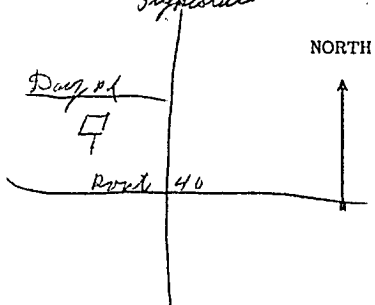

DATE  
WELL WAS  
COMPLETED

I hereby affirm that this report contains no willful misrepresentations or falsifications and that information given in this report is true, accurate and complete to the best of my knowledge and belief.

Dec 18 1948

Dwight Brown, Well Driller  
Well Driller License No.: 113