

11/27/00
16.00

RPS# 323351

PERMIT

SEWAGE DISPOSAL SYSTEM

HOWARD COUNTY HEALTH DEPARTMENT
BUREAU OF ENVIRONMENTAL HEALTH
410-313-2640

P 514663A

A REPAIR

ISSUE DATE 11/21/00

APPROVAL DATE 11/28/00

INDEXED

Arnold's Backhoe & Septic Service, Inc. IS PERMITTED TO INSTALL ALTER

ADDRESS P.O. Box 15, Woodbine, MD 21797 PHONE 410-795-7873

SUBDIVISION Daisy Hill Estates LOT NUMBER 16 B1A ADDRESS 15904 Meadow Walk Road

PROPERTY OWNER Thomas Beljan PROPERTY OWNER'S ADDRESS

SEPTIC TANK CAPACITY EX. 1000 GALLONS

PUMP CHAMBER CAPACITY _____ GALLONS

NUMBER OF BEDROOMS 4

SQUARE FEET PER BEDROOM 210

LINEAR FEET OF TRENCH REQUIRED 140

TRENCHES: Trenches to be 2 feet wide. Inlet 5 feet below original grade. Bottom maximum depth

11 feet below original grade. 6 feet of stone below distribution box.

LOCATION:

REPAIR - PURPOSE - Existing septic system has failed. (Failed Dry Well)

Call for inspection when ground is opened so sanitarian can recommend repair. 11/8/00

PLANS APPROVED _____ DATE _____

PERMIT VOID AFTER 2 YEARS

NOTE: CONTRACTOR RESPONSIBLE FOR SCHEDULING A PRE-CONSTRUCTION INSPECTION FOR ALL INSTALLATIONS

NOTE: TOP OF SEPTIC TANKS ARE TO BE NO DEEPER THAN 3.0 FEET BELOW FINISH GRADE

NOTE: WATERTIGHT SEPTIC TANKS REQUIRED

NOTE: CLEANOUT REQUIRED EVERY 70 FEET OF SEWER LINE AND/OR AT 90° SWEEPS IN LINES FROM HOUSE TO DRAIN FIELDS, 90° ELBOWS ARE NOT ACCEPTABLE

NOTE: ALL PARTS OF SEPTIC SYSTEMS (I.E. TANK, DISTRIBUTION BOX, DRAINFIELDS) TO BE 100 FEET FROM ANY WATER WELL UNLESS OTHERWISE SPECIFICALLY AUTHORIZED

NOTE: NO ABSORPTION TRENCH TO EXCEED 100 FEET IN LENGTH UNLESS SPECIFICALLY AUTHORIZED

NOTE: ALL PIPE FROM HOUSE TO SEPTIC TANK MUST BE CAST IRON OR SCHEDULE 35/40 PVC OR ABS

NOTE: MANHOLE RISERS REQUIRED ON ALL SEPTIC TANKS AND PUMP CHAMBERS

NOTE: DISTRIBUTION BOXES MUST HAVE BAFFLES

NOTE: IF PUMPED SEPTIC SYSTEM REQUIRED, (1) SEPTIC PUMP DETAIL TO BE PROVIDED BY INSTALLER PRIOR TO ISSUANCE OF SEPTIC PERMIT (2) PUMP PERFORMANCE TEST IS NECESSARY PRIOR TO HEALTH DEPARTMENT APPROVAL OF SEPTIC PERMIT


BUILDING PERMIT SIGNED AND RETURNED

11/2/2003 300139734 NEW FRONT STOOP ADD TO DECK, REMODEL MASTER BEDROOM

NEITHER THE HOWARD COUNTY COUNCIL NOR THE HEALTH DEPARTMENT IS RESPONSIBLE FOR THE SUCCESSFUL OPERATION OF ANY SYSTEM PERMITTEE RESPONSIBLE FOR OBTAINING FINAL APPROVAL ON THIS PERMIT CALL 410-313-2640 FOR INSPECTION OF SEPTIC SYSTEM

P 514663A

NOT TO SCALE

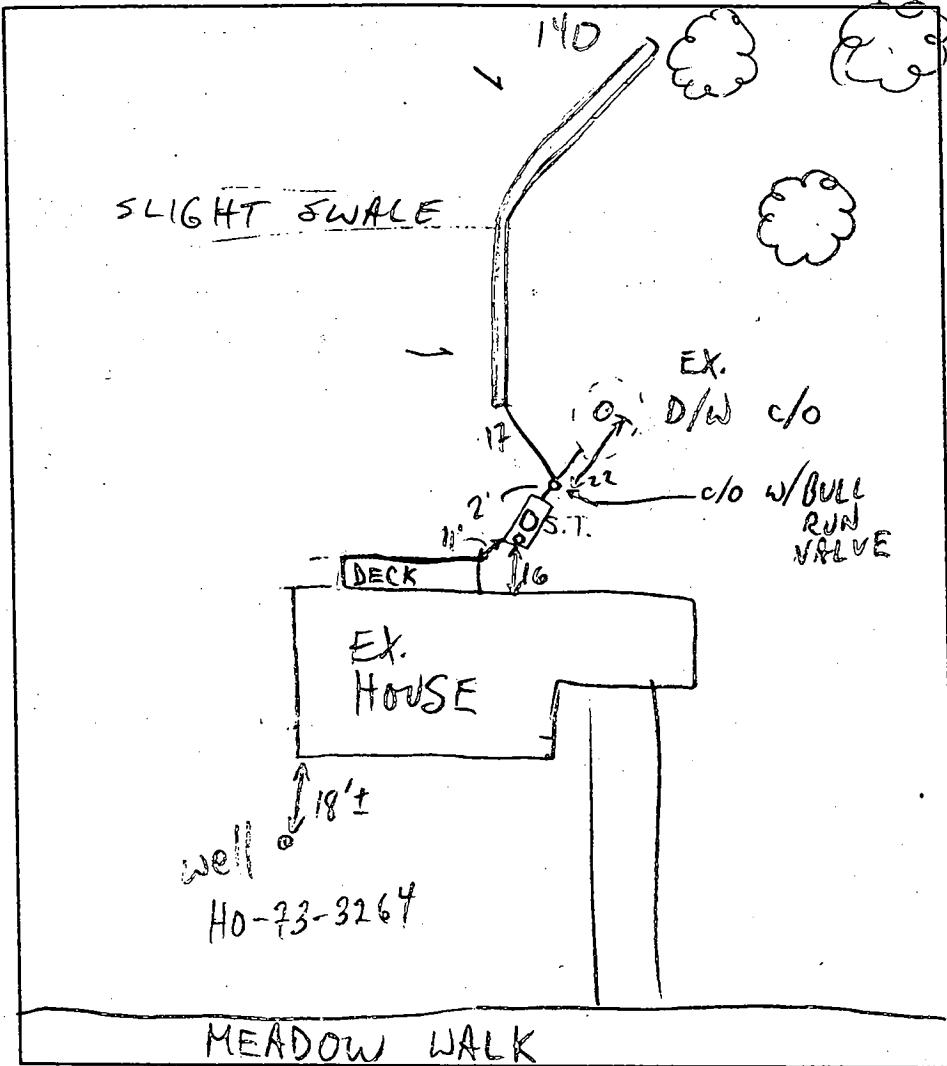

TRENCH DATA

TRENCH WIDTH 2
 TRENCH INLET DEPTH 4-5
 TRENCH BOTTOM DEPTH 10-11
 DEPTH OF STONE 6
 NUMBER OF TRENCHES 1
 TOTAL TRENCH LENGTH 140
 ABSORBENT AREA 8.40
 DISTRIBUTION BOX LEVEL -
 BAFFLE IN DISTRIBUTION BOX -

SEPTIC TANK DATA

SEPTIC TANK EX - 1000 GALLONS
 MANHOLE RISER _____
 6 INCH INSPECTION PORT _____

PUMP CHAMBER DATA

~~PUMP CHAMBER GALLONS _____
 MANHOLE RISER _____
 ALARM _____
 PUMP PERFORMANCE TEST _____~~

PRE-CONSTRUCTION INSPECTION: 11/27/00 a.m. OK TO START (MR) AND RETURNED

INSPECTION COMMENTS: 11/27/00 p.m. OK TO CONTINUE; TRENCH 1' OUT OF GRADE, BOTTOM LEVEL (MR)
11/28/00 OK TO COVER (MR)

INSPECTOR M. Ripkin DATE SYSTEM APPROVED 11/28/00

8/10/77
8/14/79
8/27/79
HOWARD COUNTY

PERMIT

SEWAGE DISPOSAL SYSTEM

P 3000
A 16699

MARYLAND STATE DEPARTMENT OF HEALTH

ELLICOTT CITY
DISTRICT 4th

INDEXED

DATE 8/8/79

Howard Pickett IS PERMITTED TO INSTALL ALTER

ADDRESS W. Orville Road, Mt. Airy, Maryland 21771 PHONE 829-0543

SUBDIVISION Daisy Hill Estates ROAD 15904 Meadow Walk Road LOT 16, 81k.

PROPERTY OWNER Thomas NE Anderson

ADDRESS _____

SPECIFICATIONS 3 bedrooms

SEPTIC TANK CAPACITY 1000 GALLONS
DRAIN FIELD _____ DEPTH _____ FEET. BOTTOM AREA _____ SQ. FT.
DEEP TRENCH _____ DEPTH _____ FEET. BOTTOM AREA _____ SQ. FT.
SEEPAGE PITS ABSORBENT SIDE-WALL AREA 185 SQ. FT. PER bedroom.
INLET PIPE 4 FT. BELOW ORIGINAL GRADE. MAXIMUM DEPTH 11 FT. BELOW ORIGINAL GRADE
EFFECTIVE DEPTH AT _____ FT. BELOW ORIGINAL GRADE.
LOCATE DISPOSAL AREA 2' FT. FROM right LOT LINE AND 175 FT. FROM edge of road
FACING LOT FROM road.

PLANS APPROVED BY Charles R. Streaker DATE 8/23/74

COVER NO WORK UNTIL INSPECTED AND APPROVED.

NEITHER THE HOWARD COUNTY COUNCIL NOR THE HEALTH DEPARTMENT IS RESPONSIBLE FOR THE SUCCESSFUL OPERATION OF ANY RY.

NOTE: IF TRENCH IS USED CALL FOR INSPECTION BEFORE PLACING GRAVEL IN TRENCH.

NOTE: NO DRY WELL SHALL EXCEED 18 FOOT IN DIAMETER.

NOTE: ALL PIPE FROM HOUSE TO DISPOSAL AREA MUST BE CAST IRON.

PERMIT VOID AFTER THREE YEARS.

NOTE: INSTALL STAND PIPE ON SEPTIC TANK AND DRY WELL. STAND PIPES MUST BE 6 INCHES IN DIAMETER. CAST IRON. CONCRETE OR COTTA ACCEPTED.

***INSTALLER IS RESPONSIBLE FOR OBTAINING FINAL APPROVAL ON THIS PERM**

APPLICATION

SEWAGE DISPOSAL TESTING

MARYLAND STATE DEPARTMENT OF HEALTH

HOWARD COUNTY

ELLCOTT CITY

DISTRICT

DATE Feb 22

encl
✓



TO: THE COUNTY HEALTH OFFICER
ELLCOTT CITY, MARYLAND

I, HEREBY, APPLY FOR THE NECESSARY TESTS IN ORDER TO CONSTRUCT (OR RECONSTRUCT) A SEWAGE DISPOSAL SYSTEM.

(E)
↔

PROPERTY OWNER Daisy Hill, Joint Venture

ADDRESS 1131 Univ. Blvd, Silver Spring, Md PHONE 649-1500

PROPERTY LOCATION:

SUBDIVISION Daisy Hill Estates #11 LOT NO. Lot 16, Block A, 8c

ROAD AND DESCRIPTION South side of Union Chapel Road, 350' east of Daisy Road

OCCUPANT None PHONE

PERSON TO CONSTRUCT SYSTEM 28 928 228 4 PHONE side

ADDRESS 1214 104 104 228 0 PHONE side

SIZE OF LOT 62 737 000 000 004 122 1/2 TYPE BLDG. three NUMBER OF BEDROOMS

IF NOT SINGLE RESIDENCE DESCRIBE 08 104 004 0

SIGNATURE OF APPLICANT Daisy Hill, Joint Venture, By *Ann Rosenberg* PRT


APPROVED BY _____ FOR _____ DATE _____

REJECTED BY _____ FOR _____ DATE _____

HOLD PENDING FURTHER TESTS _____ DATE _____

REASONS FOR REJECTION OR HOLDING _____

THIS IS NOT A PERMIT

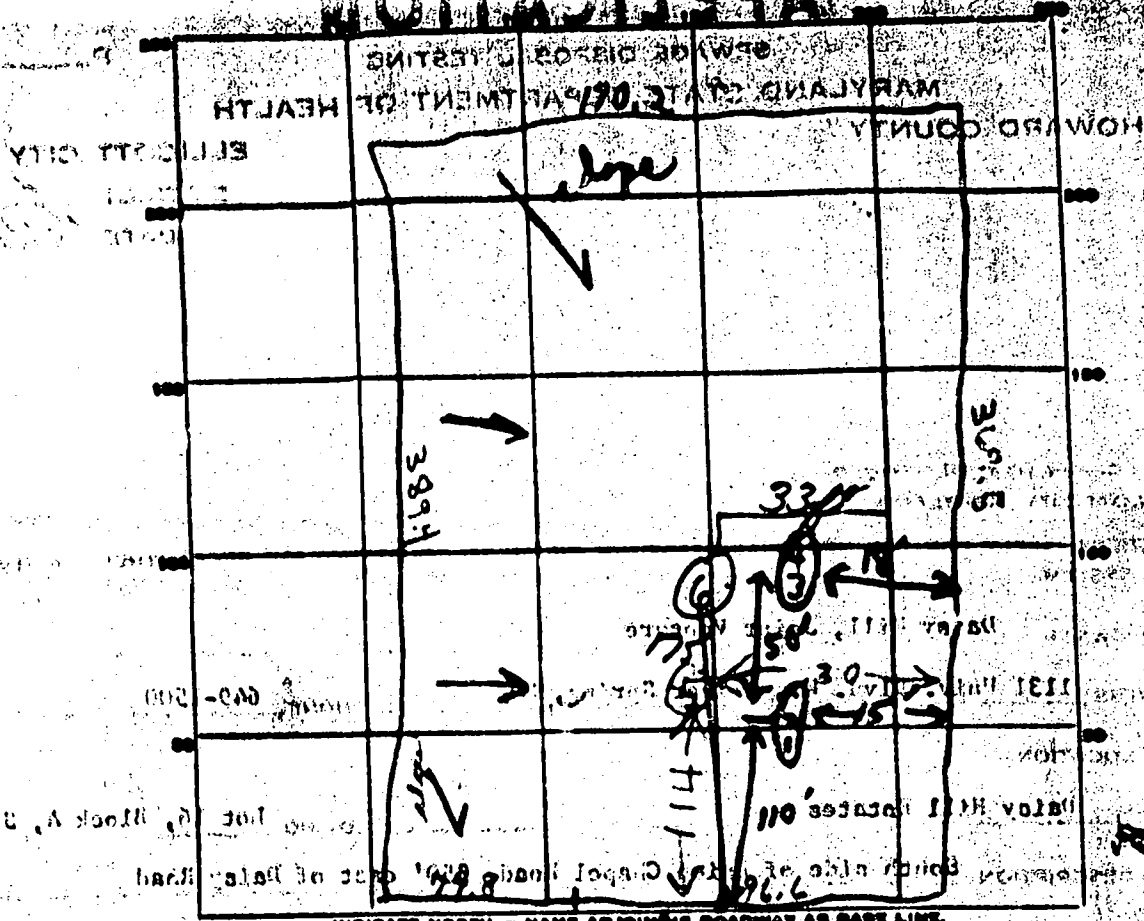

2816 Street A

DATE	TEST NO.	DEPTH	PRELUET		TEST - 1" DROP		TIME
			START	STOP	START	STOP	
2/1/72	1	4'	356	359	357	359	22
2/6/72	2	11	356	407	409	4:31	29
	3	3 1/2'	359	410	410	4:50	20
	4	11	400	407	407	4:30	23
4/30/76	5	11	TOP 4 FT SANDY		TOP 7 FT SANDY		1:19 / 19 min
5/12/79	6	11 1/2'	TOP 4 FT SANDY		TOP 7 FT SANDY		

Holes H2

OBSERVED 1406


SOIL AUGER FINDING 4/30/76 - B2 & HB VISUAL NO. 215

TESTED BY R.S.

REMARKS 3000 1000 2000

11/20/29

Lot 16 Dossy Hill Est

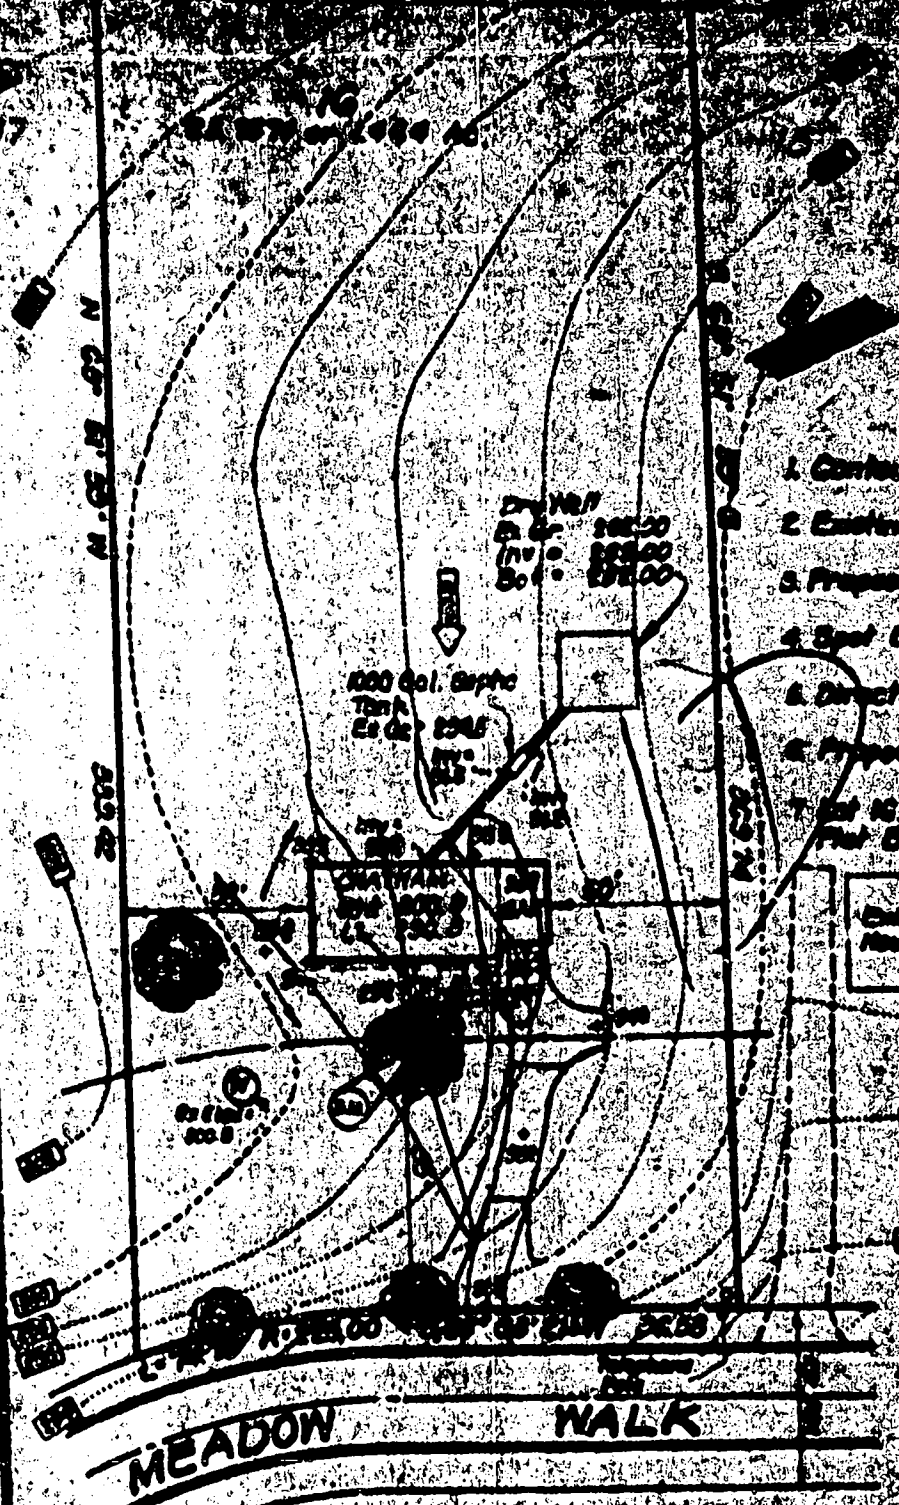


- 1. Contour Interval 2 FT
- 2. Existing Contours
- 3. Proposed Contours
- 4. Spot Elevations
- 5. Direction of Drainage
- 6. Proposed Well Location
- 7. Lot 16, Blk A is recorded in Plat Book 24, Page 51



Bench Mark
 PK nail in 12" Oak
 Assumed Elev
 500.00

CLARK, FINEROCK & SACKETT
 ENGINEERS AND SURVEYORS
 1100 Broadway, New York, N.Y.

1/2/03
OK for
revised
w/ the increase
in bedrooms
JB

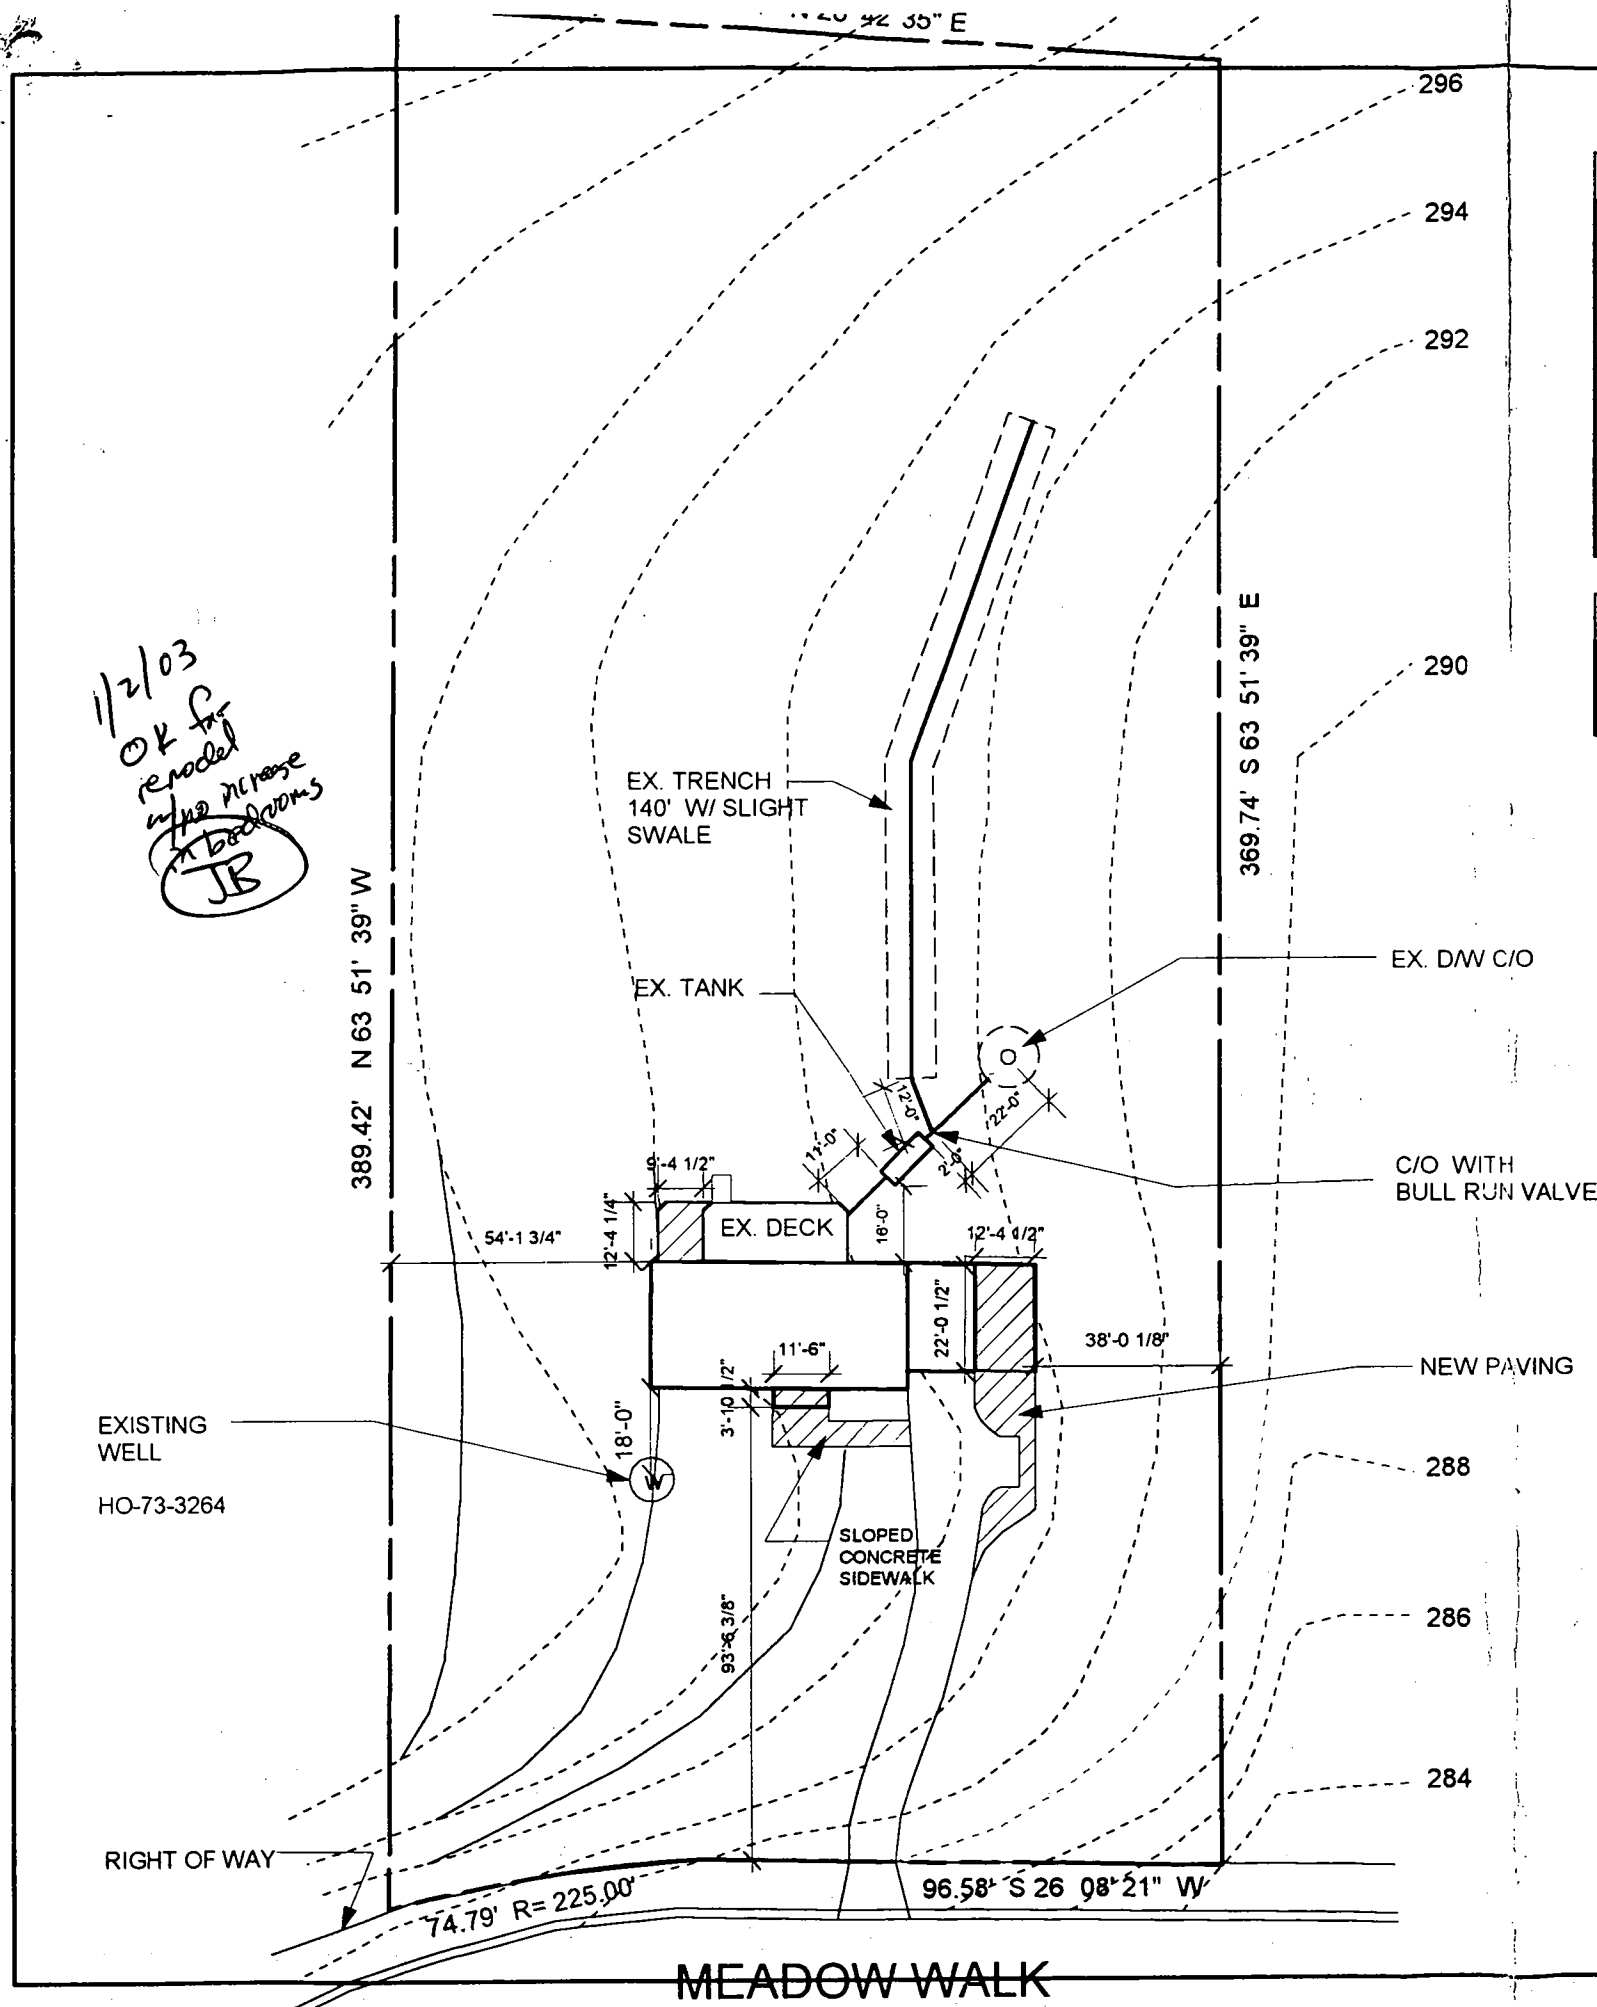


TRENCH DATA	
TRENCH WIDTH	2'
TRENCH INLET DEPTH	4'-5"
TRENCH BOTTOM DEPTH	10'-11"
DEPTH OF STONE	6"
NUMBER OF TRENCHES	1
TOTAL TRENCH LENGTH	140'
ABSORBENT AREA	840'
DISTRIBUTION BOX LEVEL	-
BAFFLE IN DISTRIBUTION BOX	-

SEPTIC TANK DATA	
SEPTIC TANK	EX. 1000 GALLONS

DRAWING LIST	
SP-1	SITE PLAN
D-1	LOWER FLOOR DEMOLITION PLAN
D-2	UPPER FLOOR DEMOLITION PLAN
D-3	ROOF DEMOLITION PLAN
D-4	EX. FRONT ELEV. DEMO PLAN
A-1	LOWER FLOOR PLAN
A-2	UPPER FLOOR PLAN
A-3	ROOF PLAN
A-4	BUILDING ELEVATIONS
A-5	BUILDING ELEVATIONS
A-6	TYPICAL WALL SECTION
A-7	BUILDING SECTION
A-8	NEW MAIN ENTRANCE SECTION
A-9	NEW MAIN ENTRANCE SECTION
A-10	WALL/ PLANTER SECTION
A-11	SIDEWALK/ PLANTER SECTION
A-12	ENTRANCE CROSS SECTION
A-13	OFFICE ENTRANCE SECTION
	NEW MAIN ENTRANCE SECTION
A-14	ROOF OVERHANG DETAIL
	CHIMNEY DETAIL
A-15	PILASTER DETAIL
	NEWEL POST DETAIL
A-16	BRACKET DETAIL
	EYEBROW ROOF DETAIL
A-17	INTERIOR ELEVATIONS
A-18	SCHEDULES
S-1	FOUNDATION PLAN
S-2	UPPER FLOOR FRAMING PLAN
S-3	ROOF FRAMING PLAN
E-1	LOWER FLOOR ELECTRICAL PLAN
E-2	UPPER FLOOR ELECTRICAL PLAN

W	WELL
- - - -	EXISTING CONTOURS
— — — —	PROPOSED CONTOURS
[Solid Box]	EXISTING BUILDING
[Hatched Box]	NEW CONSTRUCTION

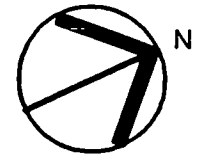

© SETH HARRY & ASSOCIATES, INC.
These drawings are instruments of service and remain the property of the Architect. The Architect retains all rights to the design represented herein. No copies of these drawings or design can be made, nor any part thereof, without the express written consent of the Architect. The contractor shall verify all dimensions in the field and shall notify the Architect of any discrepancies prior to construction.

SETH HARRY & ASSOCIATES, INC.
606 MORGAN STATION ROAD
WOODBINE, MARYLAND 21797
TEL 410 489 4726 FAX 410 489 7664

BELJAN RESIDENCE
15904 Meadow Walk
Woodbine, MD 21797

SITE PLAN

DATE: 12-2-02
SCALE: 1" = 40'

SP-1