

# APPLICATION

A. 15929

P. \_\_\_\_\_

## SEWAGE DISPOSAL TESTING

MARYLAND STATE DEPARTMENT OF HEALTH

HOWARD COUNTY *Septic tank for 3 bedrooms 1000 gal* ELLICOTT CITY

DISTRICT 3

*Dry well to be 300 sq ft of absorption, situated  
area below the inlet pipe ~~for~~ - inlet pipe DATE 7/14/71  
3 ft below original grade. 111 sq ft depth of dry well to be  
11 ft below original grade. locate dry well 18 ft from Day  
Road and 84 ft from left side line as lot is now standing  
on Day Rd facing lot.*

TO: THE COUNTY HEALTH OFFICER  
ELLICOTT CITY, MARYLAND

I, HEREBY, APPLY FOR THE NECESSARY TESTS IN ORDER TO CONSTRUCT (OR RECONSTRUCT) A SEWAGE DISPOSAL SYSTEM.

PROPERTY OWNER George P. Garratt, Jr.

ADDRESS Forsythe Road, Sykesville, Md. PHONE \_\_\_\_\_

PROPERTY LOCATION:

SUBDIVISION \_\_\_\_\_ LOT NO. 3

ROAD AND DESCRIPTION Day Road - off Rt. 32 - 3/4 miles in on right side

look for SOLD SIGN Lassovitch

OCCUPANT \_\_\_\_\_ PHONE \_\_\_\_\_

PERSON TO CONSTRUCT SYSTEM \_\_\_\_\_

ADDRESS \_\_\_\_\_ PHONE \_\_\_\_\_

SIZE OF LOT 5.859 acres TYPE BLDG. 3  
NUMBER OF BEDROOMS  
(Single Fmly. Dwlg.)

IF NOT SINGLE RESIDENCE DESCRIBE \_\_\_\_\_

SIGNATURE OF APPLICANT Thomas J. Blueford Jr. 765-7834

APPROVED BY James T. Wright FOR dry well (KIND OF SYSTEM) DATE 6/21/71

REJECTED BY \_\_\_\_\_ FOR \_\_\_\_\_ (KIND OF SYSTEM) DATE \_\_\_\_\_


HOLD PENDING FURTHER TESTS \_\_\_\_\_ DATE \_\_\_\_\_

REASONS FOR REJECTION OR HOLDING \_\_\_\_\_

# THIS IS NOT A PERMIT

CSOPL

48  
34  
46  
17  
E  
EVANS

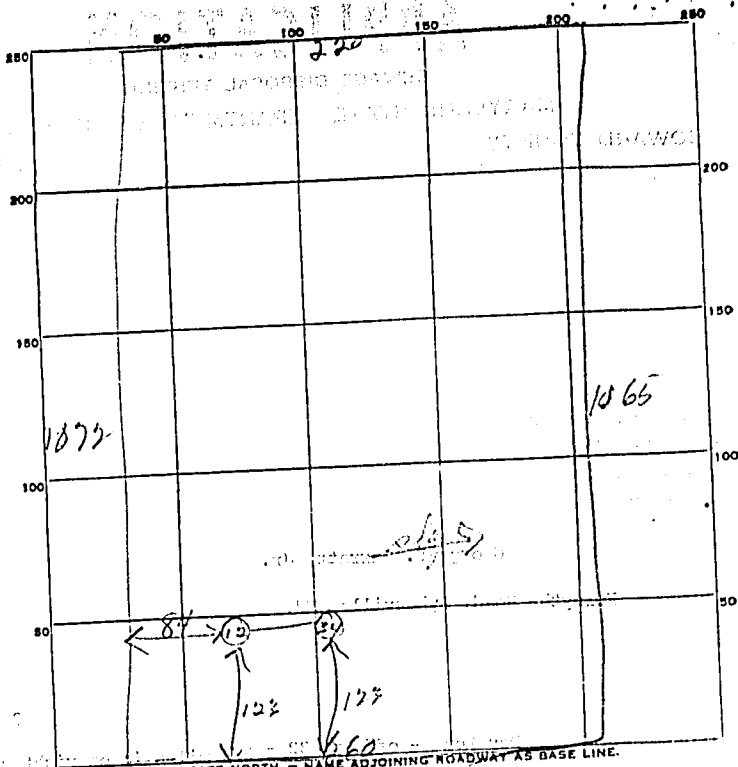

INDICATE NORTH - NAME ADJOINING ROADWAY AS BASE LINE.

Day KA

DATE	TEST NO.	DEPTH	PRE-WET		TEST - 1" DROP		TIME
			START	STOP	START	STOP	
1/15/71	1	11'	1002	1006	1006	1008	2 min
	2	3'	956	958	958	1000	2 min
	3	11'	1010	1012	1012	1016	4 min
	4	3'	1006	1007	1007	1010	4 min


Sim  
AV

SOIL AUGER FINDING

TESTED BY

REMARKS

A15929

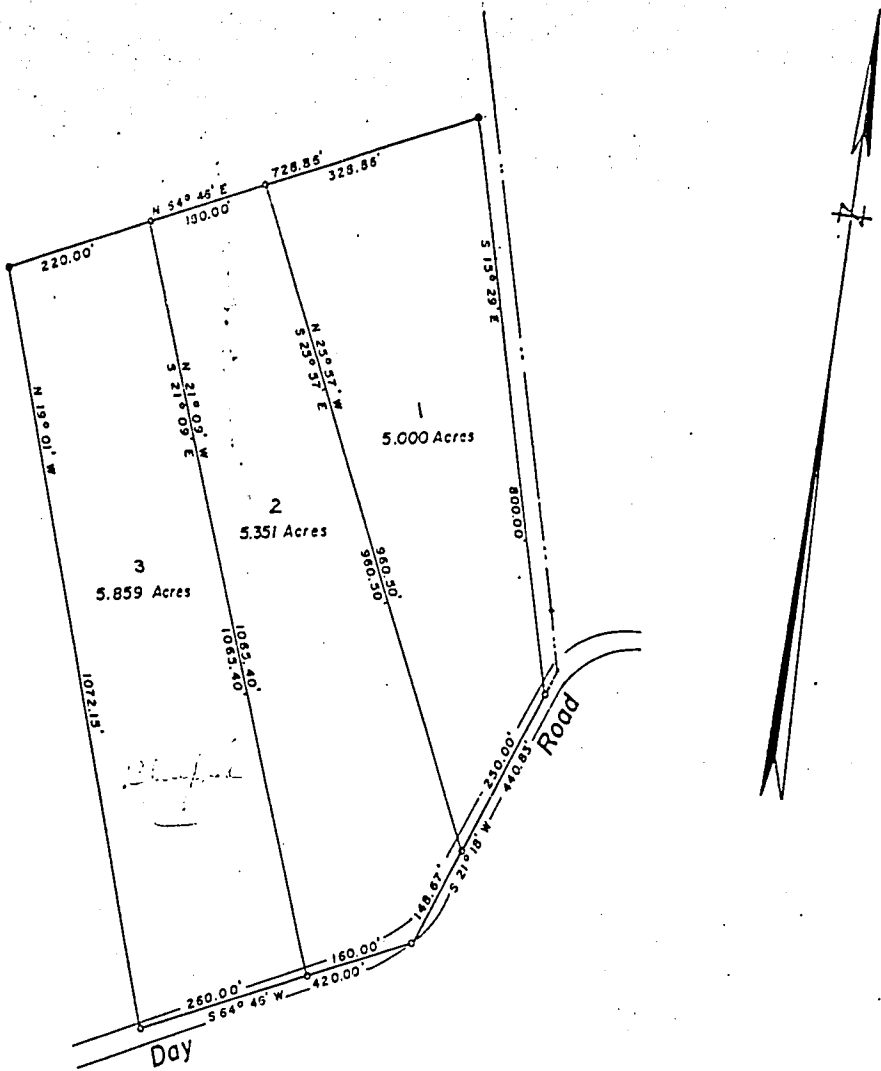

PLAT OF SURVEY  
FOR  
GEORGE P. GARRATT JR.  
THIRD ELECTION DISTRICT OF HOWARD COUNTY  
SYKESVILLE, MARYLAND  
SCALE: 1 IN. = 200 FT. JANUARY 25, 1971

*Claude M. Hennis*

