

PERMIT CARD _____

SEPTIC TANK, LEVEL OK. concrete 1000 CLEANOUTS K

DISTRIBUTION BOX, LEVEL 6' above ground

TILE FIELD, DEPTH _____ FT. TRENCH WIDTH _____ FT.

GRAVEL DEPTH _____ IN. TOTAL LENGTH _____ FT.

NUMBER OF TRENCHES _____ TOTAL BOTTOM AREA _____

SEEPAGE PITS, INSIDE DIAMETER 12 FT. DEPTH BELOW INLET _____ FT.

ABSORBENT AREA _____ SQ. FT.

REMARKS 4/30/73 - Remnant of Dry Well the 55 FT
Seawall to dry well are not installed could not
measure depth of Dry Well Hole in top is plugged
Well not yet installed, OK to cover tank
@ House Sewer R/H
5/8/73 Dry well eff. depth below inlet ~ 7 1/2'
 DATE SYSTEM APPROVED 5/8/73 INSPECTOR W.H. Zupp


A15929

1065.40'


1072.15'

D L A N I
: 1st = CO

12/29/78
9/10

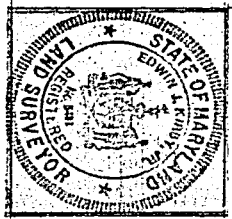

MR. & MRS. T
3RD ELEC. DIS
Proc

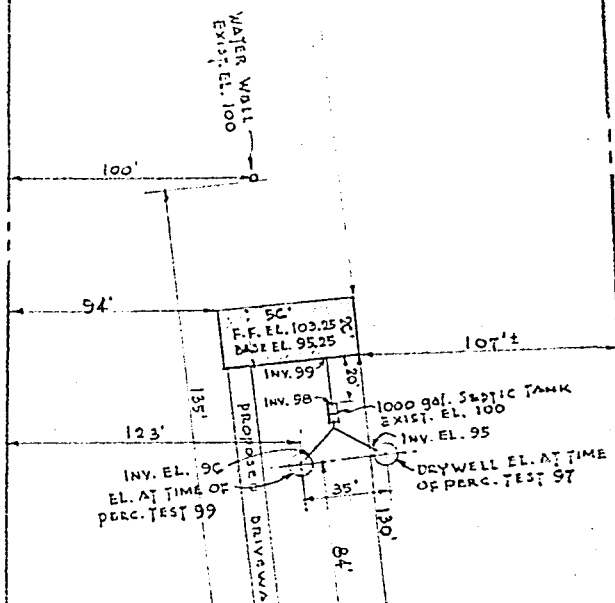

off
1-8-79
swm