

PERMIT

SEWAGE DISPOSAL SYSTEM
HOWARD COUNTY HEALTH DEPARTMENT
BUREAU OF ENVIRONMENTAL HEALTH
410-313-2640

P 514726

A REPAIR

ISSUE DATE 01/02/2001

APPROVAL DATE 1/4/01

INDEXED

Hatfield's Equipment

IS PERMITTED TO INSTALL ALTER

ADDRESS 13785 Burntwoods Road, Glenelg, MD 21737 PHONE 301-854-6172

SUBDIVISION Countryside LOT NUMBER 9 ADDRESS 3559 Countryside Drive

PROPERTY OWNER Tracy Herriotts PROPERTY OWNER'S ADDRESS

SEPTIC TANK CAPACITY ex: 1000 GALLONS

PUMP CHAMBER CAPACITY NA GALLONS

NUMBER OF BEDROOMS 3

SQUARE FEET PER BEDROOM 180 ft²

LINEAR FEET OF TRENCH REQUIRED 108'

DNE?

TRENCHES: Trenches to be 2 feet wide. Inlet 3 feet below original grade. Bottom maximum depth 8 feet below original grade. 5 feet of stone below distribution box.

LOCATION:

REPAIR - PURPOSE - Existing septic system has failed.

Call for inspection when ground is opened so sanitarian can recommend repair. 1/2/01

Run 2 (54') TRENCHES TOWARDS THE DRIVEWAY

KEEP TRENCHES 7' EDGE TO EDGE

PLANS APPROVED Steven R. Krieg DATE 1/3/01

PERMIT VOID AFTER 2 YEARS

NOTE: CONTRACTOR RESPONSIBLE FOR SCHEDULING A PRE-CONSTRUCTION INSPECTION FOR ALL INSTALLATIONS

NOTE: TOP OF SEPTIC TANKS ARE TO BE NO DEEPER THAN 3.0 FEET BELOW FINISH GRADE

NOTE: WATERTIGHT SEPTIC TANKS REQUIRED

NOTE: CLEANOUT REQUIRED EVERY 70 FEET OF SEWER LINE AND/OR AT 90° SWEEPS IN LINES FROM HOUSE TO DRAIN FIELDS, 90° ELBOWS ARE NOT ACCEPTABLE

NOTE: ALL PARTS OF SEPTIC SYSTEMS (I.E. TANK, DISTRIBUTION BOX, DRAINFIELDS) TO BE 100 FEET FROM ANY WATER WELL UNLESS OTHERWISE SPECIFICALLY AUTHORIZED

NOTE: NO ABSORPTION TRENCH TO EXCEED 100 FEET IN LENGTH UNLESS SPECIFICALLY AUTHORIZED

NOTE: ALL PIPE FROM HOUSE TO SEPTIC TANK MUST BE CAST IRON OR SCHEDULE 35/40 PVC OR ABS

NOTE: MANHOLE RISERS REQUIRED ON ALL SEPTIC TANKS AND PUMP CHAMBERS

NOTE: DISTRIBUTION BOXES MUST HAVE BAFFLES

NOTE: IF PUMPED SEPTIC SYSTEM REQUIRED, (1) SEPTIC PUMP DETAIL TO BE PROVIDED BY INSTALLER PRIOR TO ISSUANCE OF SEPTIC PERMIT (2) PUMP PERFORMANCE TEST IS NECESSARY PRIOR TO HEALTH DEPARTMENT APPROVAL OF SEPTIC PERMIT

NEITHER THE HOWARD COUNTY COUNCIL NOR THE HEALTH DEPARTMENT IS RESPONSIBLE FOR THE SUCCESSFUL OPERATION OF ANY SYSTEM


PERMITTEE RESPONSIBLE FOR OBTAINING FINAL APPROVAL ON THIS PERMIT
CALL 410-313-2640 FOR INSPECTION OF SEPTIC SYSTEM

514726

11:00

RPS#

Well HO-73-4162
NOT TO SCALE

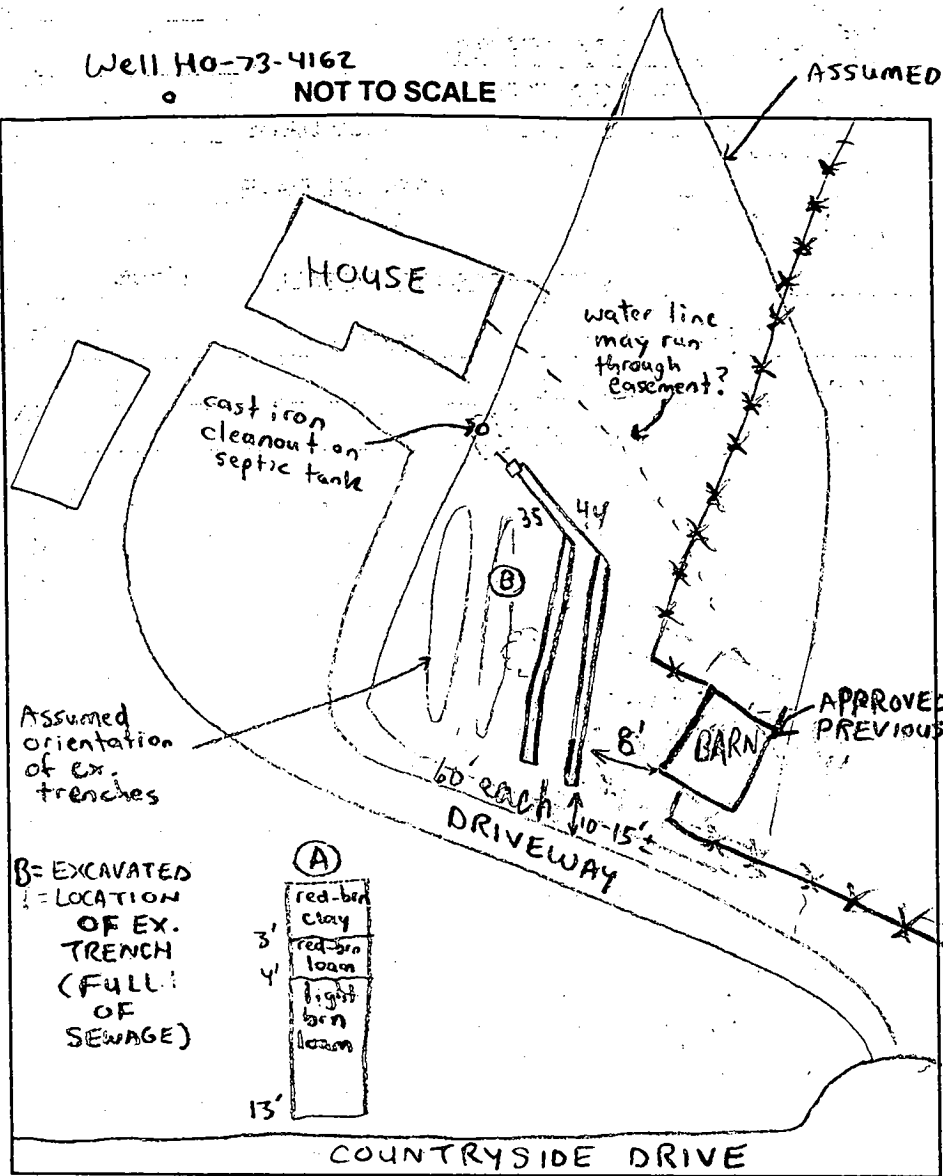

TRENCH DATA	
TRENCH WIDTH	<u>2</u>
TRENCH INLET DEPTH	<u>3</u>
TRENCH BOTTOM DEPTH	<u>8</u>
DEPTH OF STONE	<u>5</u>
NUMBER OF TRENCHES	<u>2</u>
TOTAL TRENCH LENGTH	<u>120</u>
ABSORBENT AREA	<u>600</u>
DISTRIBUTION BOX LEVEL	<u>EX.</u>
BAFFLE IN DISTRIBUTION BOX	<u>EX.</u>

SEPTIC TANK DATA	
SEPTIC TANK	_____ GALLONS
MANHOLE RISER	_____
6 INCH INSPECTION PORT	_____
PUMP CHAMBER DATA	
PUMP CHAMBER GALLONS	_____
MANHOLE RISER	_____
ALARM	_____
PUMP PERFORMANCE TEST	_____

PRE-CONSTRUCTION INSPECTION: 1/3/01 - INSTALL TRENCHES AS SPECIFIED ON FRONT OF PERMIT HOLE DUG IN LOCATION (B) & (A), SEE SOIL PROFILE, OK TO COVER MIDDLE OF TRENCHES BUT KEEP ENDS OPEN, POLE BARN (APPROVED PREVIOUSLY) IMPACTS PORTION OF SEPTIC EASEMENT, ADVISED HOME OWNER FUTURE REPAIRS MAY INVOLVE THE REROUTING OF WATER LINE AROUND EASEMENT IF INSPECTION COMMENTS: APPLICABLE PIPE FROM SEPTIC TANK TO EX. DBOX REPLACED W/ PVC PRIOR TO 1/3/01 BY CONTRACTOR, OK TO BEGIN WORK - (SRM)

1/4/01 OK TO FINISH & COVER (MR)

INSPECTOR M. Ripkin DATE SYSTEM APPROVED 1/4/01



MARYLAND DEPARTMENT OF THE ENVIRONMENT

2500 Broening Highway • Baltimore, Maryland 21224
(410) 631-3000 • 1-800-633-6101 • <http://www.mde.state.md.us>

Parris N. Glendening
Governor

Jane T. Nishida
Secretary

September 24, 2001

Tracy & Karen Herriotts
3559 Countryside Drive
Glenwood MD 21738

Re: Water Appropriation Permit
Number: HO82GAP006
*** SECOND NOTICE ***

Dear Mr. & Mrs. Herriotts:

Our records show that the above referenced permit (copy enclosed) to appropriate and use waters of the state has expired. This permit was previously issued to Ronald & Frayda Glass for water use in a residential ground water heat pump. A review of current assessment and taxation records indicates that you are the current owner of this property. Renewal of this permit for the current use may be initiated by completing the enclosed application form and returning it to this office within 30 days of the above date.

A new permit will be forwarded upon completion of the processing of the application, providing there has been no significant changes in your water use or changes in the conditions affecting your withdrawal. You will be contacted regarding any additional information required to complete the processing of your application. This permit is required for any commercial, institutional, and industrial use, community water supplies, and residential/industrial heating and cooling that withdraw water from a well, spring, or waterway.

If you have any questions or require assistance in completing the application form, please contact Phyllis Palewicz or me at (410) 631-3591.

Sincerely,

Marianna L. Eberle
Public Health Engineer
Water Rights Division

Enclosures

*cc: Howard County Health Dept
Tax Map 21 Par 48*