

APPLICATION

SEWAGE DISPOSAL TESTING

MARYLAND STATE DEPARTMENT OF HEALTH

HOWARD COUNTY *Septic Tank - 750 gal.*

ELLICOTT CITY

A 14420
P _____

Dry Well - 468 sq. ft. absorbent sidewalk area to begin below the first 5 ft. non-porous soil. Maximum depth permitted for dry well 13 ft. below original grade. Locate dry well 197 ft. off left side line and 87 ft. off front lot line as seen from Day Rd.

DISTRICT _____
DATE 3
4/15/69

TO: THE COUNTY HEALTH OFFICER
ELLICOTT CITY, MARYLAND

I, HEREBY, APPLY FOR THE NECESSARY TESTS IN ORDER TO CONSTRUCT (OR RECONSTRUCT) A SEWAGE DISPOSAL SYSTEM.

PROPERTY OWNER John Jacob Noyes

ADDRESS 1728 Spence St., Balto., Md. PHONE 644-8821

PROPERTY LOCATION: _____

SUBDIVISION _____ LOT NO. 1

ROAD AND DESCRIPTION Day Rd. off Rt. 32, Sykesville

OCCUPANT _____ PHONE _____

PERSON TO CONSTRUCT SYSTEM _____

ADDRESS _____ PHONE _____

SIZE OF LOT 6.83 acres TYPE BLDG. _____

IF NOT SINGLE RESIDENCE DESCRIBE _____

SIGNATURE OF APPLICANT _____


APPROVED BY John Jacob Noyes FOR Dry Well DATE 4/18/69
Robert Noyes (KIND OF SYSTEM)

REJECTED BY _____ FOR _____ DATE _____
(KIND OF SYSTEM)

HOLD PENDING FURTHER TESTS _____ DATE _____

REASONS FOR REJECTION OR HOLDING _____

THIS IS NOT A PERMIT

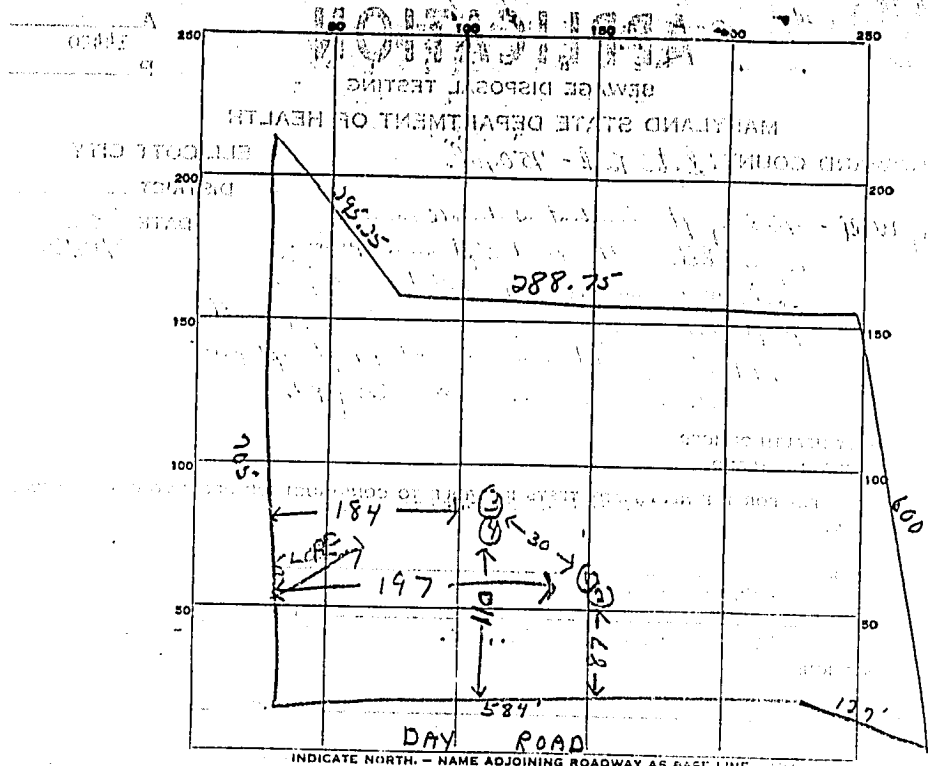

DATE	TEST NO.	DEPTH	PRE-WET		TEST - 1" DROP		TIME	
			START	STOP	START	STOP		
6/18/69	1	13 ft	10 02	10 12	10 12	10 27	15 min	
	2	45 ft	10 30	10 40	10 40	10 59	19 min	
	3	12 1/2 ft	10 18	10 22	10 22	10 28	6 min	
	4	4 ft	10 35	Slow Perc.				

SOIL AUGER FINDING Good soil after 6 ft.
 TESTED BY R. Tunc

R. A. TUN, CIVIL