

INDICATE NORTH. - NAME ADJOINING ROADWAY AS BASE LINE.

16
16

Handwritten notes and signatures in the top right corner of the grid area.

PERMIT CARD not needed

SEPTIC TANK, LEVEL OK CLEANOUTS OK

DISTRIBUTION BOX, LEVEL OK

TILE FIELD, DEPTH 12 FT. TRENCH WIDTH 18 FT.

GRAVEL DEPTH 12 IN. TOTAL LENGTH 100 FT.


NUMBER OF TRENCHES 4 TOTAL BOTTOM AREA 480 SQ. FT.

SEEPAGE PITS, INSIDE DIAMETER Perimeter 48 FT. DEPTH BELOW INLET 10 FT.

ABSORBENT AREA 480 SQ. FT.

REMARKS _____

DATE SYSTEM APPROVED 10-20-70 INSPECTOR D.W. Menaghan

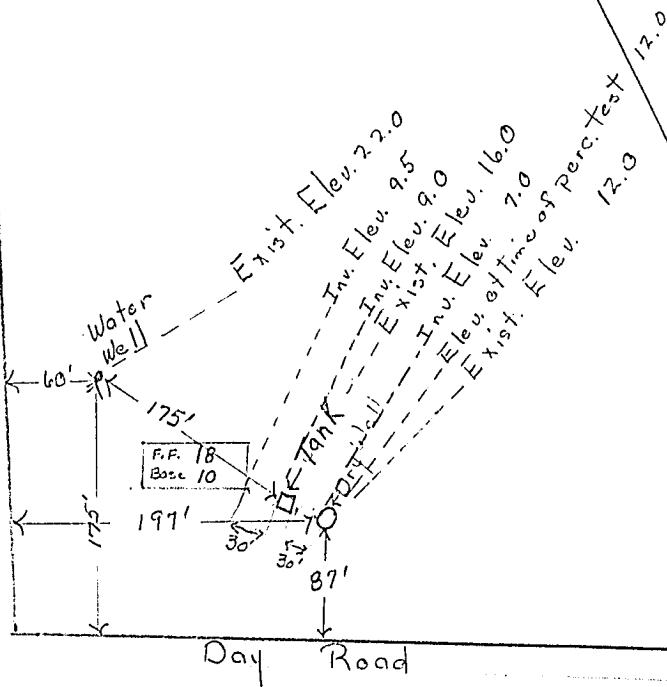

Plans OK

R. Tane

ENGINEER

Assumed Elevation Used

John Jacob Noyes

1913