

Purpose of change statement:


The proposed revision to the layout of the septic field at address: 14624 Corys Court Glenelg, Maryland 21737 is to provide ample space for planned outdoor living space as well as landscape plantings and a possible "future" pool installation on the property. The revision will allow for the planned spaces to be designed in a single area of the yard. This will leave the rest of the yard undisturbed.

Prepared by Craig D. Hood Signed [Signature]

- All wells and septic systems located within 100' of the property boundaries and 200' downgradient of any wells and/or septic systems have been shown.
- The topography of this plat is taken from plot plan LOT# 17 "Edgewood Farm Liber 4174, Folio 0436 Plat no. 19267 ESE Land Planning Engineering Land Surveying and is verified to accurately represent the relative changes on the subject property.
- Any changes to a private sewage easement shall require a revised percolation certification plan.
- The lot shown hereon complies with the minimum ownership width and lot area as required by the Maryland Department of Environment.

"Approved For Private Water and Private Sewerage Systems"

[Signature] for Peter B. Selvenson 9/6/2011
 Health Officer, Howard County Health Department Date ngd

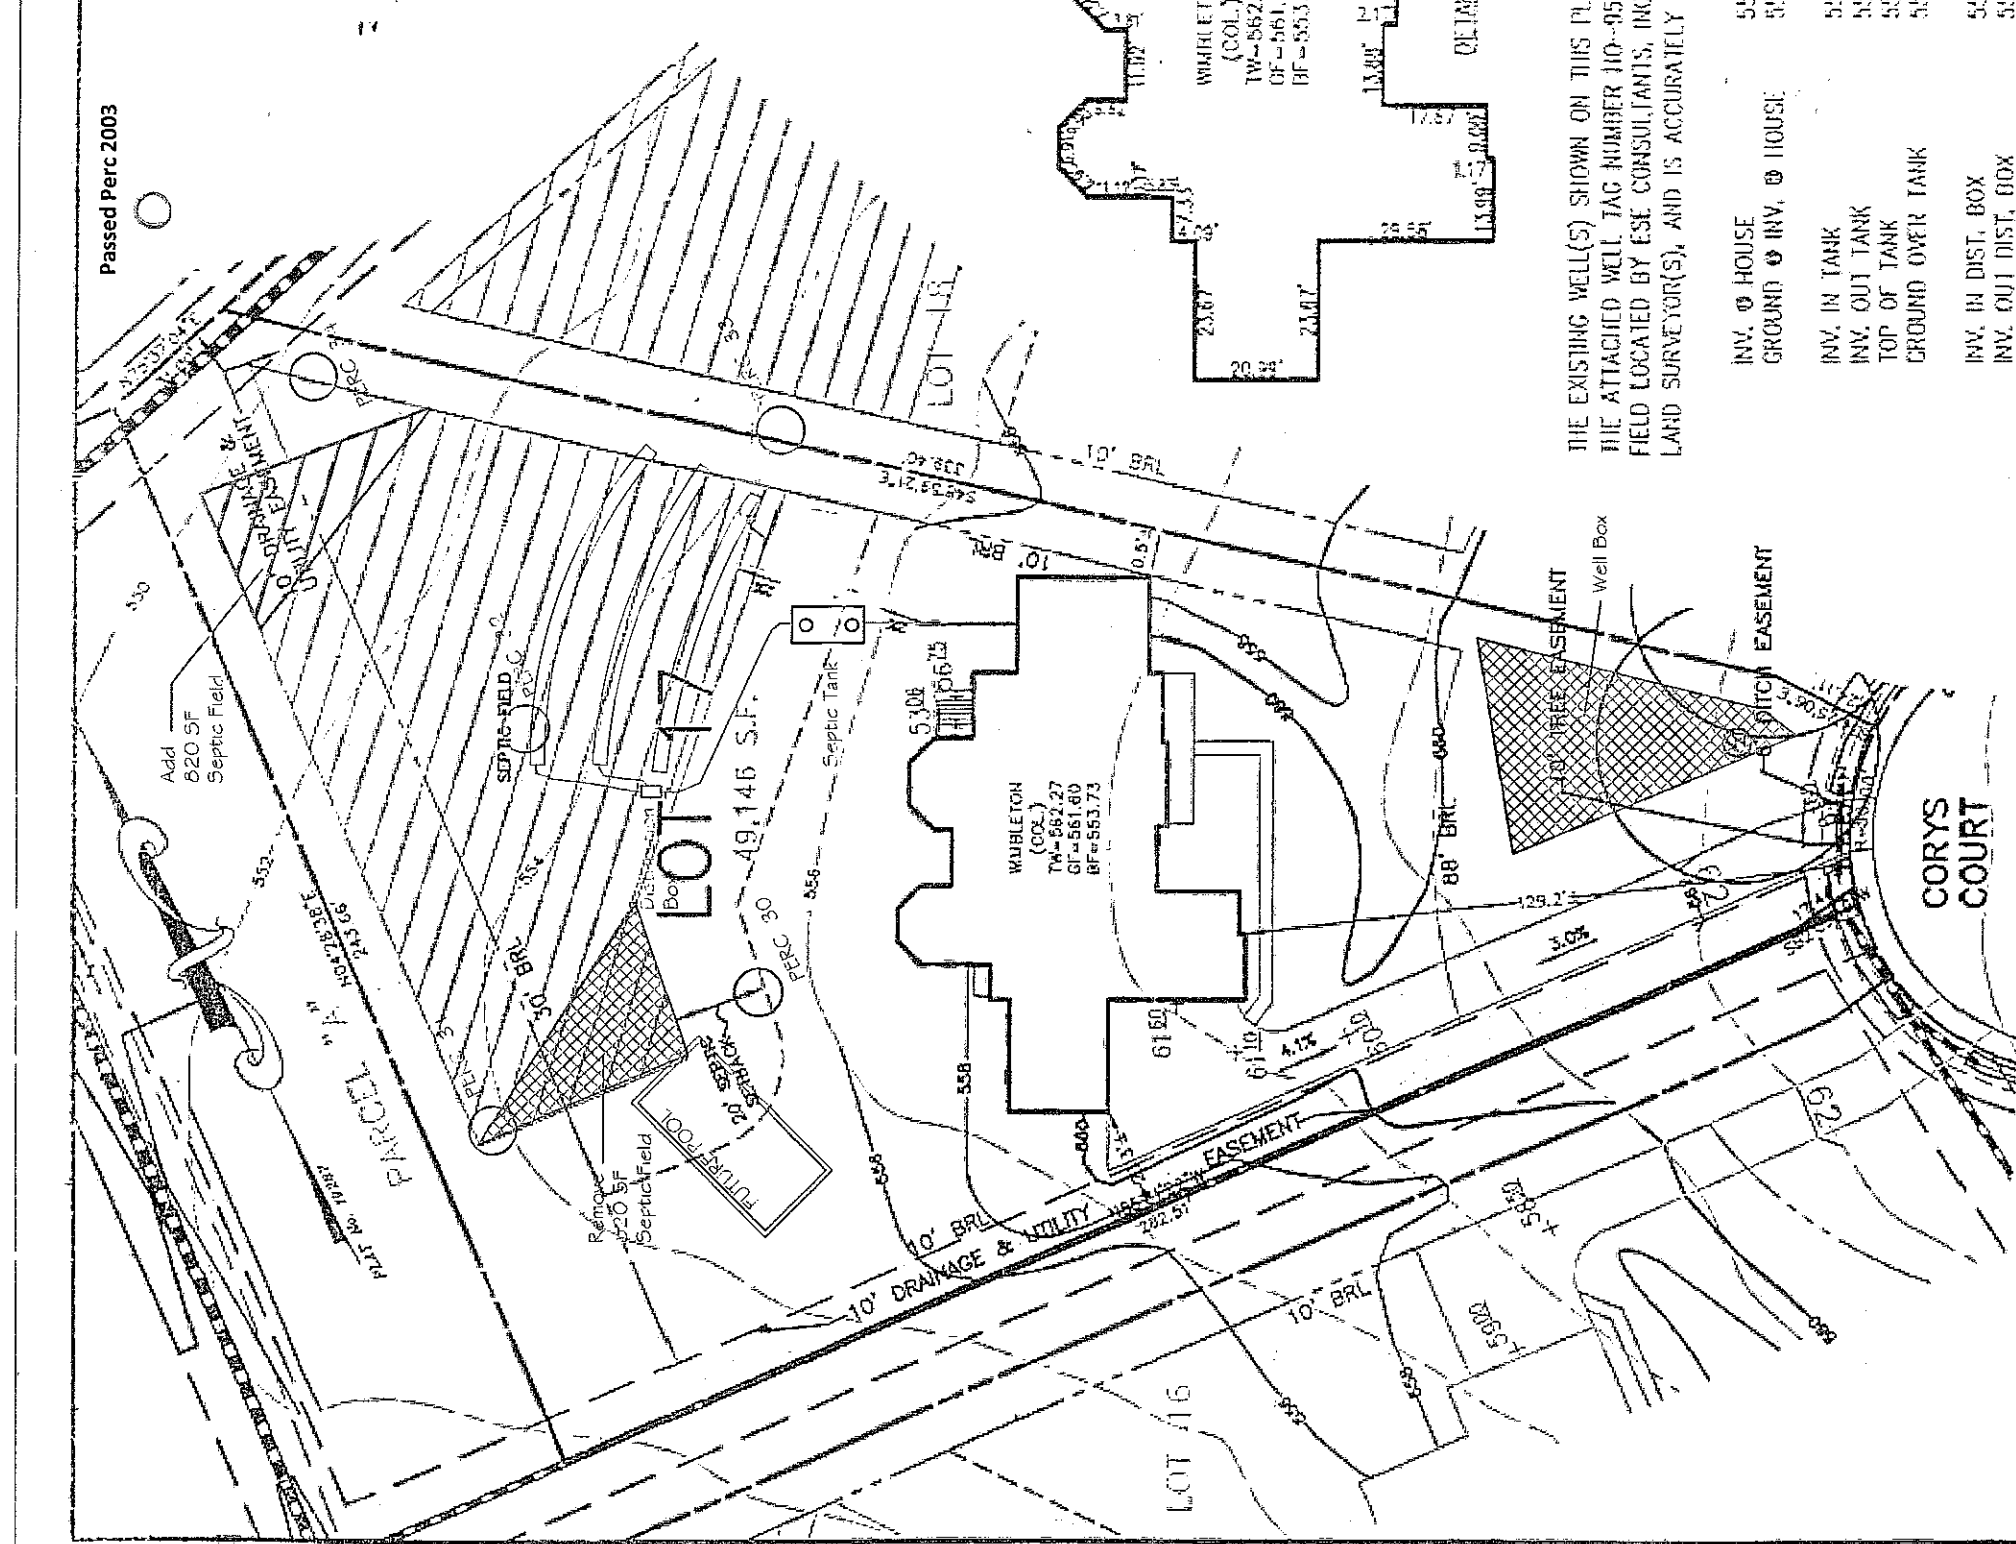

THE EXISTING WELL(S) SHOWN ON THIS PLAN (IDENTIFIED WITH THE ATTACHED WELL TAG NUMBER HO--95-0774) HAS BEEN FIELD LOCATED BY ESE CONSULTANTS, INC., PROFESSIONAL LAND SURVEYOR(S), AND IS ACCURATELY SHOWN.

INV. @ HOUSE	552.3
GROUND @ INV. @ HOUSE	557.0
INV. IN TANK	551.5
INV. OUT TANK	551.2
TOP OF TANK	552.5
GROUND OVER TANK	555.3
INV. IN DIST. BOX	551.1
INV. OUT DIST. BOX	550.8
GROUND @ BOX	554.8

WELL No. 110-95-0774

ADDRESS: 14624 CORYS COURT
 GLENELG, MD 21737

PLOT PLAN
 LOT #17
EDGEWOOD FARM
 LIBER 4174, FOLIO 0436
 PLAT No. 19267.

MDE statement for lots created after March 1972:

This area designates a private sewage disposal area of at least 10,000 sq. ft. as required by the Maryland Department of Environment for individual sewage disposal. Improvements of any nature in this area are restricted. This sewage disposal area shall become null and void upon connection to a public sewage system. The County Health Officer shall have authority to grant adjustments to the private sewage easement. Recardation of a revised sewage easement shall not be necessary.

BUILDING SETBACKS (B.R.L.'s) SHOWN HEREON PER SITE DEVELOPMENT PLAN SETBACK DISTANCES SHOWN HEREON AS \pm HAVE AN ACCURACY OF $\pm 0.1'$ FOOT.

- TYPE: WIMBLETON (COLONIAL):
- DAYLIGHT BASEMENT
 - EXPANDED FAMILY ROOM
 - GRAND CONSERVATORY ELITE
 - ADD'L 1' TO HEIGHT OF BASEMENT
 - HAPLES SUNROOM
 - DOUBLE-WIDE TAIL ON DRIVEWAY
 - STONE TO GRADE 4 SIDES
 - CUSTOM 4TH & 5TH CAR GARAGE
- OPTION No. 018
 - OPTION No. 023
 - OPTION No. 037
 - OPTION No. 070
 - OPTION No. 529
 - OPTION No. 851
 - OPTION No. XXX
 - OPTION No. XXX