

Building Address 14516 Edgewood Way  
Glenely MD 21737

Suite/Apt. #: \_\_\_\_\_ SDP/WP/Petition #: \_\_\_\_\_

Census Tract \_\_\_\_\_ Subdivision \_\_\_\_\_

Section \_\_\_\_\_ Area \_\_\_\_\_ Lot 600

Tax Map 21 Parcel 90 Grid 22

Zoning \_\_\_\_\_ Map Coordinates \_\_\_\_\_ Lot size 1.05

Property Owner's Name Toll MD V LP

Address 7164 Columbia Colony Dr #210

City Columbia State MD Zip Code 21046

Phone 410 479 2275 Phone 410 271 8369

Applicant's Name & Mailing Address, (if other than stated hereon):

Phone 410 479 2275 Fax 410 479 2278

Existing Use Vacant Lot

Proposed Use Single Family Dwelling

Estimated Construction Cost \$ 335,000

Description of Work 11/2 bath conversion - 4 BR  
(4) full bath (1) 1/2 bath

Contractor Company Toll MD V LP

Contact Person Tom Vyserec

Address 14516 Edgewood Way

City Glenely State MD Zip Code \_\_\_\_\_

License No. \_\_\_\_\_

Phone 410 479 2275 Fax 410 479 2278

Occupant or Tenant Toll MD V LP

Contact Name Tom Vyserec

Address 14516 Edgewood Way

City Glenely State MD Zip Code 21737

Phone 410 479 2275 Fax 410 479 2278

Engineer or Architect Company ESC

Contact Person Chad Conway

Address 7164 Columbia Colony Dr

City Columbia State MD Zip Code 21046

Phone 410 872 4870 Fax 410 872 4870

<b>BUILDING DESCRIPTION - COMMERCIAL</b>	<b>BUILDING DESCRIPTION - RESIDENTIAL</b>
--	---

Building Characteristics	Utilities
Height: _____	Water Supply: _____ _____ Public _____ Private
No. of stories: _____	Sewage Disposal: _____ _____ Public _____ Private
Gross area, sq. ft. per floor: _____	Electric Yes <input type="checkbox"/> No <input type="checkbox"/>
Use group: _____	Gas Yes <input type="checkbox"/> No <input type="checkbox"/>
Construction type: _____ _____ Reinforced Concrete _____ Structural Steel _____ Masonry _____ Wood Frame	Heating System: _____ Electric <input type="checkbox"/> Oil <input type="checkbox"/> Natural Gas <input type="checkbox"/> Propane Gas <input type="checkbox"/>
_____ State Certified Modular	Sprinkler system: N/A <input type="checkbox"/> _____ Full _____ Partial _____ Other Suppression _____ # of Heads

Building Characteristics	Utilities
SF Dwelling <input type="checkbox"/> SF Townhouse <input type="checkbox"/>	Water Supply: _____ _____ Public _____ Private
1st floor: <u>75</u> Depth <u>82</u> Width <u>82</u>	Sewage Disposal: _____ _____ Public _____ Private
2nd floor: <u>78</u>	Electric Yes <input checked="" type="checkbox"/> No <input type="checkbox"/>
Basement: <u>75</u>	Gas Yes <input type="checkbox"/> No <input type="checkbox"/>
Finished Basement <input checked="" type="checkbox"/> Unfinished Basement <input type="checkbox"/>	Heating System: _____ Electric <input type="checkbox"/> Oil <input type="checkbox"/> Natural Gas <input type="checkbox"/> Propane Gas <input type="checkbox"/>
Crawl space <input type="checkbox"/> Slab on Grade <input type="checkbox"/>	Sprinkler system: N/A <input checked="" type="checkbox"/> _____ NFPA #13D _____ NFPA #13R _____ Other:
No. of Bedrooms <u>3</u>	
Height: <u>35</u>	
Multi-family dwellings: _____	
No. of efficiency units: _____	
No. of 1 BR units: _____	
No. of 2 BR units: _____	
No. of 3 BR units: _____	
Other Structure: _____	
Dimensions: _____	
Footings: _____	
Roof Height: _____	
_____ State Certified Modular _____ Manufactured Home	

THE UNDERSIGNED HEREBY CERTIFIES AND AGREES AS FOLLOWS: (1) THAT HE/SHE IS AUTHORIZED TO MAKE THIS APPLICATION; (2) THAT THE INFORMATION IS CORRECT; (3) THAT HE/SHE WILL COMPLY WITH ALL REGULATIONS OF HOWARD COUNTY WHICH ARE APPLICABLE THERETO; (4) THAT HE/SHE WILL PERFORM NO WORK ON THE ABOVE REFERENCED PROPERTY NOT SPECIFICALLY DESCRIBED IN THIS APPLICATION; (5) THAT HE/SHE GRANTS COUNTY OFFICIALS THE RIGHT TO ENTER ONTO THIS PROPERTY FOR THE PURPOSE OF INSPECTING THE WORK PERMITTED AND POSTING NOTICES.

Applicant's Signature [Signature]

Title/Company [Signature]

Print Name Tom Vyserec


Date 6/20/08

Checks payable to: **DIRECTOR OF FINANCE OF HOWARD COUNTY**  
**\*\* PLEASE WRITE NEATLY AND LEGIBLY. \*\***

AGENCY	DATE	SIGNATURE APPROVAL	DPZ SETBACK INFORMATION	PROPERTY ID#:
<input checked="" type="checkbox"/> Land Development, DPZ			Front: _____	Filing fee \$ <u>100.00</u>
<input checked="" type="checkbox"/> State Highways			Rear: _____	Permit fee \$ _____
<input checked="" type="checkbox"/> Building Official			Side: _____	Excise tax \$ _____
<input checked="" type="checkbox"/> Dev. Engineering, DPZ			Side St.: _____	Add'l per. fee \$ _____
<input checked="" type="checkbox"/> Health	<u>7/15/08</u>	<u>[Signature]</u>	All minimum setbacks met?	TOTAL FEES \$ _____
<input checked="" type="checkbox"/> Fire Protection			YES <input type="checkbox"/> NO <input type="checkbox"/>	Sub-total paid \$ _____
Is Sediment Control approval required prior to issuance?			Is Entrance Permit required?	Balance due \$ _____
YES <input type="checkbox"/> NO <input checked="" type="checkbox"/>			YES <input type="checkbox"/> NO <input type="checkbox"/>	Check # <u>080808 21</u>
CONTINGENCY CONSTRUCTION START: <input type="checkbox"/>			Historic District?	Validation # _____
ONE STOP SHOP: <input type="checkbox"/>			YES <input type="checkbox"/> NO <input type="checkbox"/>	
Distribution of Copies -			Lot Coverage for NewTown Zone _____	
White: Building Official			SDP/Red-line approval date _____	Accepted by <u>[Signature]</u>
Green: LDD, DPZ				
Yellow: DED, DPZ				
Pink: Health				
Gold: SHA				

B08001888

# EDGEWOODS WAY

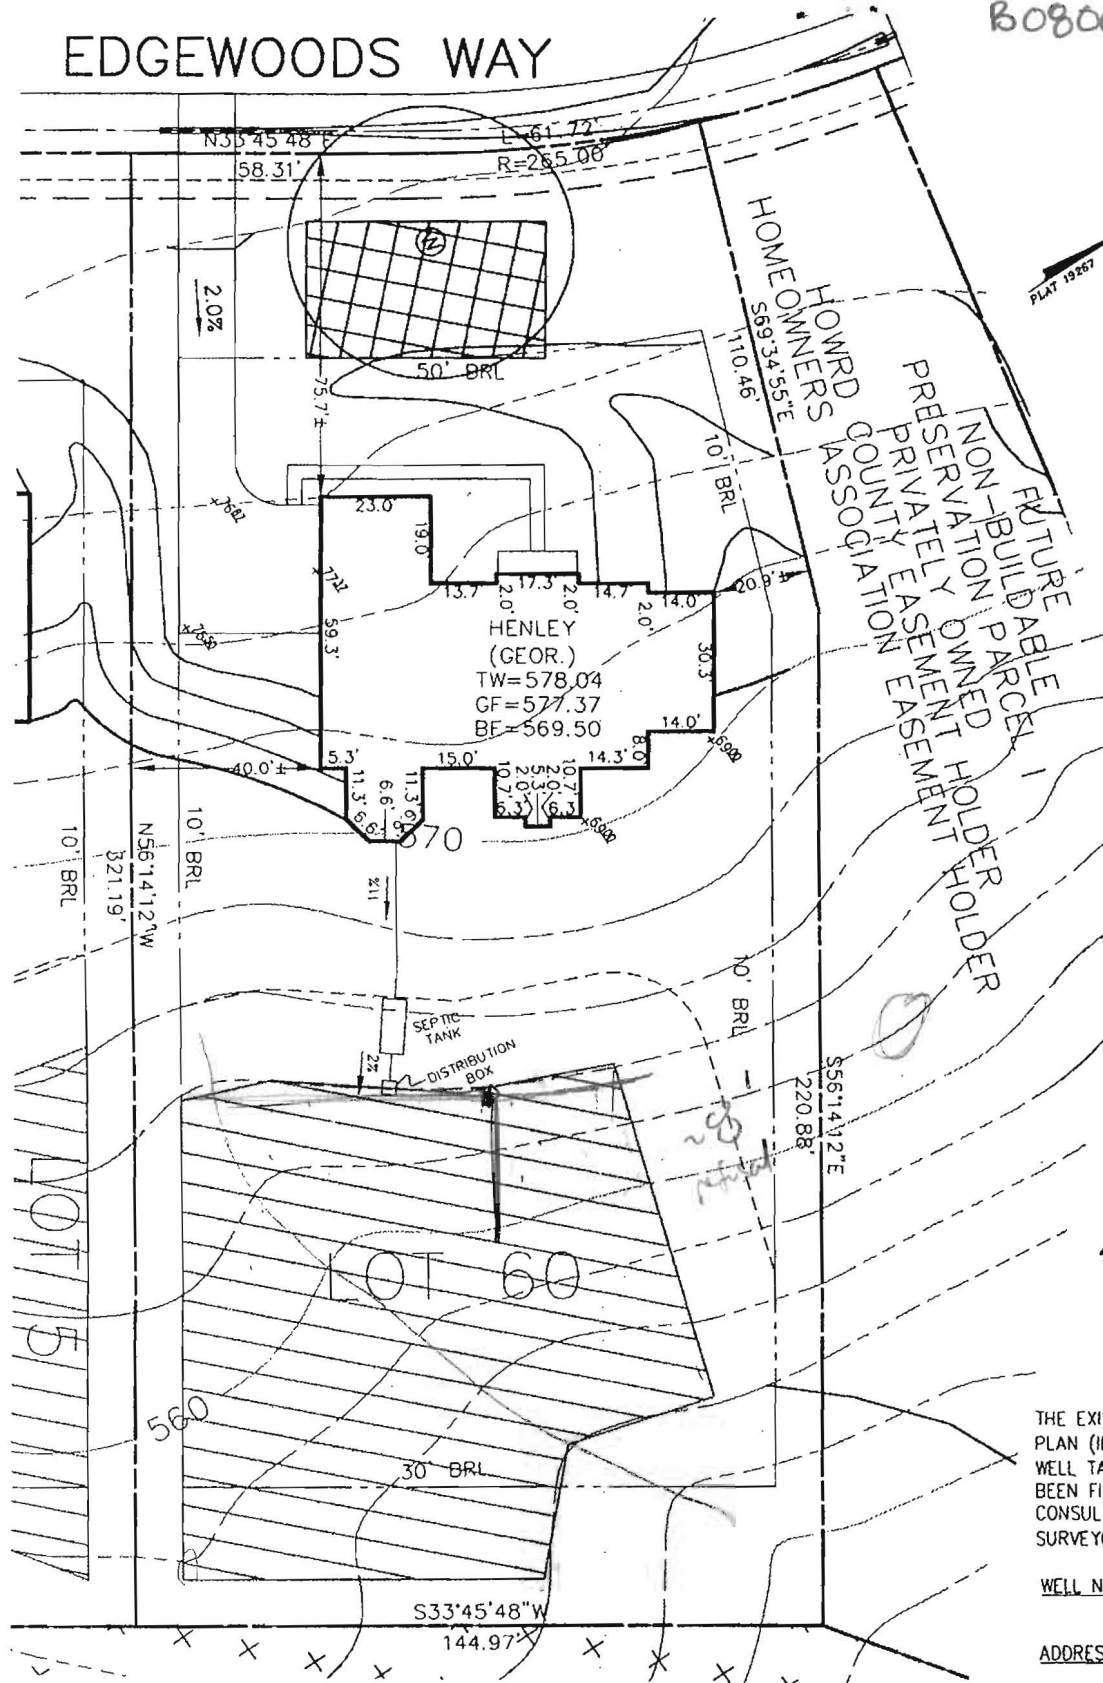

INV. @ HOUSE	566.5
GROUND @ INV. @ HOUSE	569.5
INV. IN TANK	562.5
INV. OUT TANK	562.2
TOP OF TANK	563.5
GROUND OVER TANK	566.0
INV. IN DIST. BOX	562.1
INV. OUT DIST. BOX	561.8
GROUND @ BOX	564.0

Approved Office  
 Howard County Department  
 Signature: *[Signature]*  
 Date: 7/15/08

THE EXISTING WELL(S) SHOWN ON THIS PLAN (IDENTIFIED WITH THE ATTACHED WELL TAG NUMBER HO-95-1060) HAS BEEN FIELD LOCATED BY ESE CONSULTANTS, INC. - PROFESSIONAL LAND SURVEYOR(S), AND IS ACCURATELY SHOWN.

WELL No. HO-95-1060



ADDRESS: 14516 EDGEWOODS WAY  
 GLENELG, MD 21737

BUILDING SETBACKS (B.R.L.'s) SHOWN HEREON PER SITE DEVELOPMENT PLAN SETBACK DISTANCES SHOWN HEREON AS "±" HAVE AN ACCURACY OF ±0.1' FOOT.

TYPE: HENLEY (GEORGIAN)  
 WALKOUT BASEMENT  
 ADD'L 1' TO HEIGHT OF BASEMENT  
 EXPANDED FAMILY ROOM  
 CONSERVATORY FLITE ADDITION  
 NAPLES SUNROOM  
 BRICK FRONT STOOP  
 BRICK TO GRADE SIDES

OPTION No. 017  
 OPTION No. 070  
 OPTION No. 023  
 OPTION No. 039  
 OPTION No. 529  
 OPTION No. 663  
 OPTION No. 90060003

PLOT PLAN  
 LOT #60  
**EDGEWOOD FARM**  
 LIBER 4174, FOLIO 0436  
 PLAT No. 19266, et seq  
 FOURTH ELECTION DISTRICT  
 HOWARD COUNTY, MARYLAND

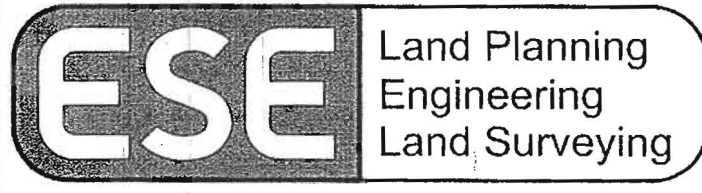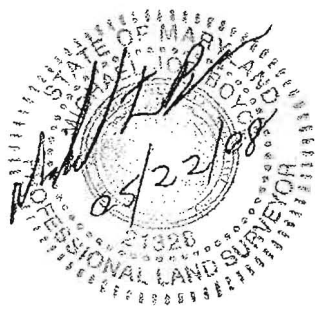

ESE Consultants Inc.  
 7164 Columbia Gateway Dr.  
 Suite 203  
 Columbia, MD 21046  
 TEL: 410-872-9105  
 FAX: 410-872-4870

DATE: 05/21/08      SCALE: 1"=40'      FILE: LOT 60  
 CHK'D: MJB      JOB#: 1498      DRAWN: GVS