

LAYOUT 11/16/09 BB INSP 4 _____
 INSP 2 11/24/05 KW INSP 5 _____
 INSP 3 11/30/07 KW INSP 6 _____

ISSUE DATE: _____

APPROVAL DATE: _____

11/30/09 KW

PERMIT

P 531995
 A 531977

Tax ID # 04372408

**ON-SITE SEWAGE DISPOSAL SYSTEM
 HOWARD COUNTY HEALTH DEPARTMENT
 BUREAU OF ENVIRONMENTAL HEALTH**

Fogles Septic Clean Inc IS PERMITTED TO INSTALL ALTER

ADDRESS: 580 Obrecht Sykesville PHONE NUMBER: 410-795-5670

SUBDIVISION: Edgewood Farm LOT NUMBER: 20

ADDRESS: 14525 Edgewoods Way PROPERTY OWNER: Toil MD V LP

SEPTIC TANK CAPACITY (GALLONS): 2000 OUTLET BAFFLE FILTER REQUIRED

PUMP CHAMBER CAPACITY (GALLONS): _____ COMPARTMENTED TANK REQUIRED

NUMBER OF BEDROOMS: 4 APPLICATION RATE: 0.8

SQUARE FOOTAGE OF HOUSE: 4900

LINEAR FEET OF TRENCH REQUIRED: 140

*2' Wide
 Inlet 4.5'
 Bottom 8.5'
 2-70' Trenches*

TRENCHES:	Trenches to be 3.0 feet wide. Inlet 3.0 feet below original grade. Bottom maximum depth 6.0 feet below grade. Effective area begins at 3.5 feet below original grade 3.0 feet of stone below distribution pipe.
LOCATION:	Set septic tank per plan location with only 2 feet of soil over tank. Set distribution box at plan location and for trench inlet at 3 feet depth. Install 2x 70' trenches on contour toward east septic easement corner. Install sewer line cleanout at bends and every 70' feet proceeding sewer from foundation.
NOTES:	Stake septic easement corners. Call for layout inspection. Mark utilities. Gravel tickets must be available for Environmental Sanitarians.

PLANS APPROVED: Robert Bricker DATE: 6/23/09

- NOTE: PERMIT VOID AFTER 2 YEARS
- NOTE: CONTRACTOR RESPONSIBLE FOR SCHEDULING A PRE-CONSTRUCTION INSPECTION FOR ALL INSTALLATIONS
- NOTE: WATERTIGHT SEPTIC TANKS REQUIRED
- NOTE: ALL PARTS OF SEPTIC SYSTEM SHALL BE 100 FEET FROM ANY WATER WELL
- NOTE: MANHOLE RISERS REQUIRED ON ALL SEPTIC TANKS AND PUMP CHAMBERS

NEITHER THE HOWARD COUNTY COUNCIL OR THE HEALTH DEPARTMENT IS RESPONSIBLE FOR THE SUCCESSFUL OPERATION OF ANY SYSTEM PERMITTEE RESPONSIBLE FOR OBTAINING FINAL APPROVAL ON THIS PERMIT CALL 410-313-1771 FOR INSPECTION OF SEPTIC SYSTEM

NOT TO SCALE

See As-Built Drawing
On Separate Sheet

ROAD NAME

TRENCH/DRAINFIELD DATA

WIDTH 2' INLET 4.5' BOTTOM 8.5'
NUMBER OF TRENCHES 2
TOTAL LENGTH 140'
ABSORPTION AREA 284+SW
DISTRIBUTION BOX LEVEL Yes
DISTRIBUTION BOX BAFFLE Yes
DISTRIBUTION BOX PORT Yes

SEPTIC TANK DATA

SEPTIC TANK 1 LEVEL Yes
MANUFACTURER Babylon
CAPACITY 2000 GAL
SEAM LOC Top
TANK LID DEPTH 3'-3.5'
BAFFLES Yes
BAFFLE FILTER _____
MANHOLE LOC Front/Rear
6" PORT LOC None
WATERTIGHT TEST _____
SLOTTED Yes
DATE ON LID _____

PUMP/SEPTIC TANK LEVEL N/A

MANUFACTURER _____
CAPACITY _____ GAL
SEAM LOC _____
TANK LID DEPTH _____
BAFFLES _____
BAFFLE FILTER _____
MANHOLE LOC _____
6" PORT LOC _____
WATERTIGHT TEST _____
SLOTTED _____
DATE ON LID _____

PRE-CONSTRUCTION

11/16/09 (BBS)



INSTALLATION: 11/24/09 Contractor set s.t and D box as instructed @ layout. 4" s.pvc installed. No trenches installed. (KW)
11/30/09 Trenches installed per layout. D box leveled. no levels needed. Depths of stone looked dirty 50% fines or more. ok to cover (KW)

FINAL INSPECTOR


Jh. Wolf

DATE OF APPROVAL

11/30/09

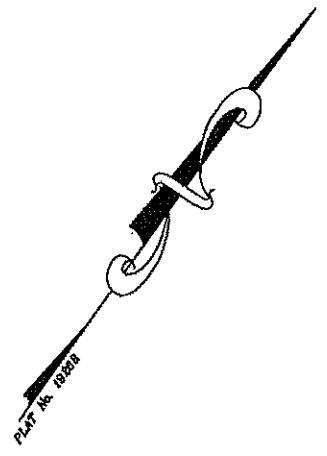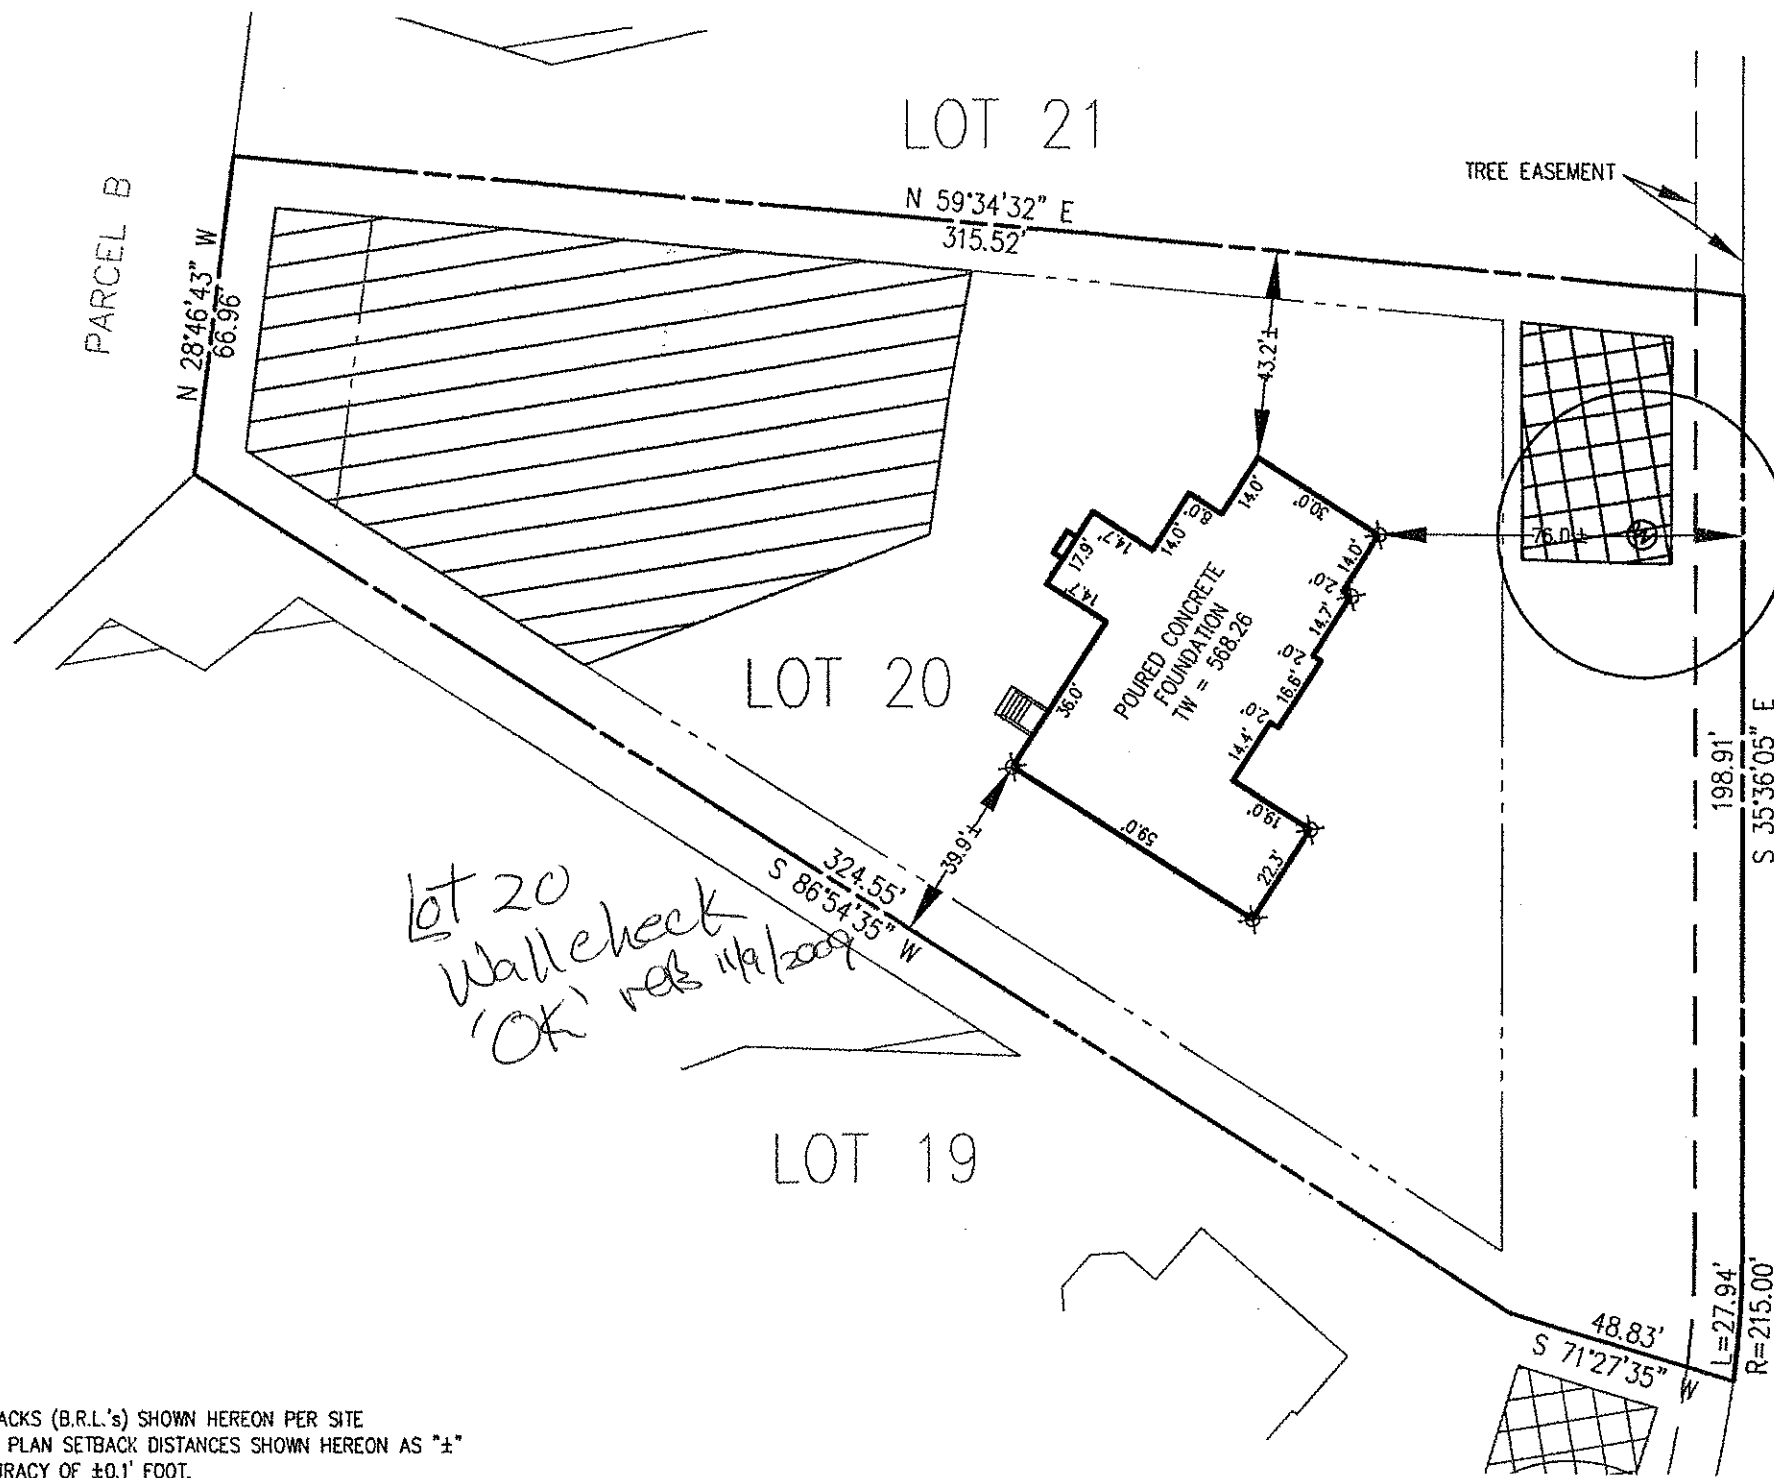


EDGEWOODS WAY

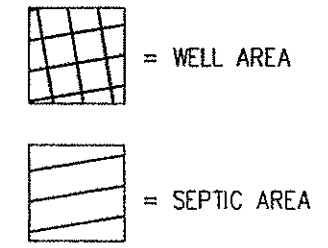

WELL No. HO-95-0777
 ADDRESS: 14525 EDGEWOODS WAY
 GLENELG, MD 21737

BUILDING SETBACKS (B.R.L.'s) SHOWN HEREON PER SITE
 DEVELOPEMENT PLAN SETBACK DISTANCES SHOWN HEREON AS "±"
 HAVE AN ACCURACY OF ±0.1' FOOT.

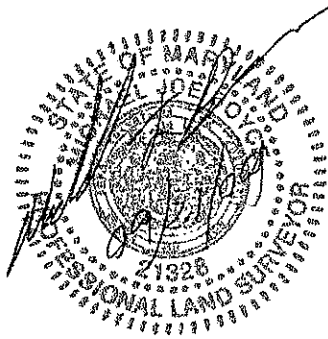

SURVEYOR'S CERTIFICATE
 I HEREBY CERTIFY THAT THE POSITION OF THE EXISTING IMPROVEMENTS SHOWN HEREON HAVE BEEN CAREFULLY ESTABLISHED BY ACCEPTED LAND SURVEYING PRACTICES AND THAT, UNLESS SHOWN, THERE ARE NO VISIBLE ENCROACHMENTS EITHER WAY ACROSS THE PROPERTY LINES. THE PLANS IS OF BENEFIT TO A CONSUMER ONLY INSOFAR AS IT IS REQUIRED BY A LENDER OR A TITLE INSURANCE COMPANY OR ITS AGENT IN CONNECTION WITH CONTEMPLATED TRANSFER, FINANCING, OR REFINANCING. THE PLAN IS NOT TO BE RELIED UPON FOR THE ESTABLISHMENT OR LOCATION OF FENCES, GARAGES, BUILDINGS, OR OTHER EXISTING OR FUTURE IMPROVEMENTS. THE PLAN DOES NOT PROVIDE FOR THE ACCURATE IDENTIFICATION OF PROPERTY BOUNDARY LINES, BUT SUCH IDENTIFICATION MAY NOT BE REQUIRED FOR THE TRANSFER OF TITLE OR SECURING FINANCING OR REFINANCING. THIS DRAWING WAS PREPARED W/O THE BENEFIT OF A TITLE REPORT.
 SIGNATURE: MICHAEL JOE BOYCE 21328 MD. LIC NO. DATE

WALLCHECK
 LOT #20
EDGEWOOD FARM
 LIBER 4174, FOLIO 0436
 PLAT No. 19266, et seq
 FOURTH ELECTION DISTRICT
 HOWARD COUNTY, MARYLAND

ESE Land Planning
 Engineering
 Land Surveying

ESE Consultants Inc.
 7164 Columbia Gateway Dr.
 Suite 203
 Columbia, MD 21046
 TEL: 410-872-9105
 FAX: 410-872-4870

DATE: 9/18/09 SCALE: 1" = 40' FILE: WC-20
 CHK'D: MJB JOB#: 1498 DRAWN: GTC