

# APPLICATION

PERCOLATION TESTING

A 518264 AAA

F \_\_\_\_\_

HOWARD COUNTY HEALTH DEPARTMENT  
BUREAU OF ENVIRONMENTAL HEALTH  
3525-H ELLICOTT MILLS DRIVE/ELLICOTT CITY, MARYLAND 21043  
TELEPHONE: 313-2640

DISTRICT 4TH

DATE 5/13/03  
~~5/20/03~~

11/4/03

TO: THE COUNTY HEALTH OFFICER  
ELLICOTT CITY, MARYLAND

I HEREBY APPLY FOR THE NECESSARY TEST PRIOR TO APPLICATION FOR PERMIT TO CONSTRUCT (OR RECONSTRUCT) A SEWAGE DISPOSAL SYSTEM.

PROPERTY OWNER EDGEWOOD FARM, INC.

ADDRESS 14919 ROXBURY RD GLENELG MD 21737 PHONE \_\_\_\_\_

AGENT OR PROSPECTIVE BUYER TOLL BROTHERS, INC.

7164 COLUMBIA GATEWAY DR SUITE 230  
ADDRESS COLUMBIA, MD 21046 PHONE (410) 872-9105

PROPERTY LOCATION:

SUBDIVISION EDGEWOOD FARM LOT NO. 52 NO LOT 50 (AREA) LOT 48

ROAD AND DESCRIPTION ROXBURY RD

TAX MAP 21 PARCEL # 20

SIZE OF LOT 1 Ac ± TYPE BLDG. SINGLE FAMILY  
(SINGLE FAMILY DWELLING OR COMMERCIAL)

THE SYSTEM INSTALLED UNDER THIS APPLICATION IS ACCEPTABLE ONLY UNTIL PUBLIC FACILITIES BECOME AVAILABLE. I FULLY UNDERSTAND THE FEE CONNECTED WITH THE FILING OF THIS PERC TEST APPLICATION IS NON-REFUNDABLE UNDER ANY CIRCUMSTANCES. I ALSO AGREE TO COMPLY WITH ALL M.O.S.H.A. REQUIREMENTS IN TESTING THIS LOT.

Bruce R. O'Neil  
BRUCE R. O'NEIL (SIGNATURE OF APPLICANT)

APPROVED BY \_\_\_\_\_ FOR \_\_\_\_\_ DATE \_\_\_\_\_

DISAPPROVED BY \_\_\_\_\_ FOR \_\_\_\_\_ DATE \_\_\_\_\_

HOLD PENDING FURTHER TESTS \_\_\_\_\_

REASONS FOR REJECTION OR HOLDING \_\_\_\_\_

PERCOLATION TEST PLAT/PRELIMINARY PLAT - TITLE OR I.D. # \_\_\_\_\_ DATE \_\_\_\_\_

SITE DEVELOPMENT PLAN/FINAL PLAT - TITLE OR I.D. # \_\_\_\_\_ DATE \_\_\_\_\_

# THIS IS NOT A PERMIT

COUNTY #

SOIL PROFILE

326

0' Brown loam 8"

2' Red Brown gravelly loam 2'

5' Red Silty loam 5'

Yellow Brown Silty loam 20-30 50

Cloudy mica shell fragments to bottom 1 1/2"

325

0' Brown loam 8"

1' Brown Gravelly loam 1 1/2"

Yellow Brown Silty loam 25-30 70

Cloudy mica shell fragments to bottom 10 1/2"

324

0' Brown loam 10"


3 1/2' Red Brown gravelly loam 3 1/2'

Yellow Brown + Light Brown Silty loam 4'

Heavy mica shell fragments to bottom 40 20-30 70 1/2"

SOIL PROFILE

0'

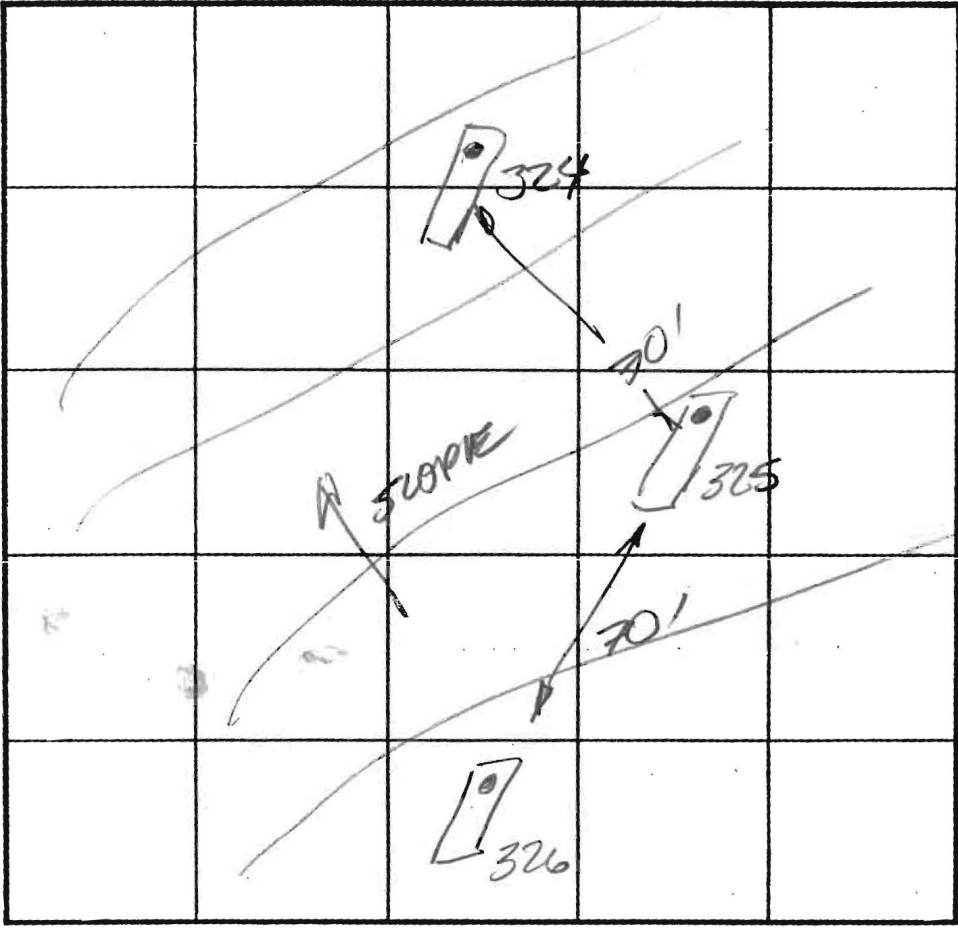

INDICATE NORTH - NAME ADJOINING ROADWAY AS BASE LINE.

DATE	TEST NO.	DEPTH	PRE-WET		TEST - 1" DROP		TIME
			START	STOP	START	STOP	
11/4/03	326	5 1/2' / 1 1/2"	10 27	10 31	10 31	10 33	2 min
	325	5 1/2' / 10 1/2"	10 30	10 32 00	10 32 06	10 34 11	2 min
	324	5' / 1 1/2"	10 31	10 34	10 34	10 41	7 min

REMARKS \_\_\_\_\_

TYPE OF SOIL \_\_\_\_\_

TESTED BY FA ALSO PRESENT Dele Johnson  
Bob Sheasley  
Mark Johnson  
Wille

TRENCH DESIGN DATA: AVERAGE PERCOLATION TIME \_\_\_\_\_ TRENCH WIDTH \_\_\_\_\_

INLET DEPTH \_\_\_\_\_ MAXIMUM BOTTOM DEPTH \_\_\_\_\_ SQ. FT./BEDROOM \_\_\_\_\_

# APPLICATION

203    204  
205  
207    206

PERCOLATION TESTING

A 51896444  
P \_\_\_\_\_

HOWARD COUNTY HEALTH DEPARTMENT  
BUREAU OF ENVIRONMENTAL HEALTH  
3525-H ELLICOTT MILLS DRIVE/ELLICOTT CITY, MARYLAND 21043  
TELEPHONE: 313-2640

DISTRICT 4TH  
DATE 5/13/03  
5/22/03

TO: THE COUNTY HEALTH OFFICER  
ELLICOTT CITY, MARYLAND

I HEREBY APPLY FOR THE NECESSARY TEST PRIOR TO APPLICATION FOR PERMIT TO CONSTRUCT (OR RECONSTRUCT) A SEWAGE DISPOSAL SYSTEM.

PROPERTY OWNER EDGEWOOD FARM, INC.

ADDRESS 14919 ROXBURY RD GLENELG MD 21737 PHONE \_\_\_\_\_

AGENT OR PROSPECTIVE BUYER TOLL BROTHERS, INC.

ADDRESS 7164 COLUMBIA GATEWAY DR SUITE 230  
COLUMBIA, MD 21046 PHONE (410) 872-9105

PROPERTY LOCATION:

SUBDIVISION EDGEWOOD FARM LOT NO. 5148 LOT 50

ROAD AND DESCRIPTION ROXBURY RD

TAX MAP 21 PARCEL # 20

SIZE OF LOT 1 Ac ± TYPE BLDG. SINGLE FAMILY  
(SINGLE FAMILY DWELLING OR COMMERCIAL)

THE SYSTEM INSTALLED UNDER THIS APPLICATION IS ACCEPTABLE ONLY UNTIL PUBLIC FACILITIES BECOME AVAILABLE. I FULLY UNDERSTAND THE  
FEE CONNECTED WITH THE FILING OF THIS PERC TEST APPLICATION IS NON-REFUNDABLE UNDER ANY CIRCUMSTANCES. I ALSO AGREE TO  
COMPLY WITH ALL M.O.S.H.A. REQUIREMENTS IN TESTING THIS LOT.

Bruce R. Oxlley  
BRUCE R. OXLEY (SIGNATURE OF APPLICANT)

PROVED BY \_\_\_\_\_ FOR \_\_\_\_\_ DATE \_\_\_\_\_

APPROVED BY \_\_\_\_\_ FOR \_\_\_\_\_ DATE \_\_\_\_\_

CONDITIONS PENDING FURTHER TESTS \_\_\_\_\_

REASONS FOR REJECTION OR HOLDING \_\_\_\_\_

PERCOLATION TEST PLAT/PRELIMINARY PLAT - TITLE OR I.D. # \_\_\_\_\_ DATE \_\_\_\_\_

DEVELOPMENT PLAN/FINAL PLAT - TITLE OR I.D. # \_\_\_\_\_ DATE \_\_\_\_\_

# THIS IS NOT A PERMIT

518964


COUNTY #

SOIL PROFILE

0' 206  
Brown Loam 1'  
Red Brown Silty Clay Loam 3'  
Brown Silty Loam 8'  
Brown Silty Loam 30-40% Charly Mica Schist 11'

707  
Brown Loam 1'  
Brown Silty Clay Loam 4'  
Brown Silty Loam 10 1/2'  
Brown Silty Loam 50-90 Charly Mica Schist 10 1/2'

705  
Brown Loam 10"  
Red Brown Silty Clay Loam 4'  
Lt Brown Silty Loam 5-10% Cobbley Gneiss 11'

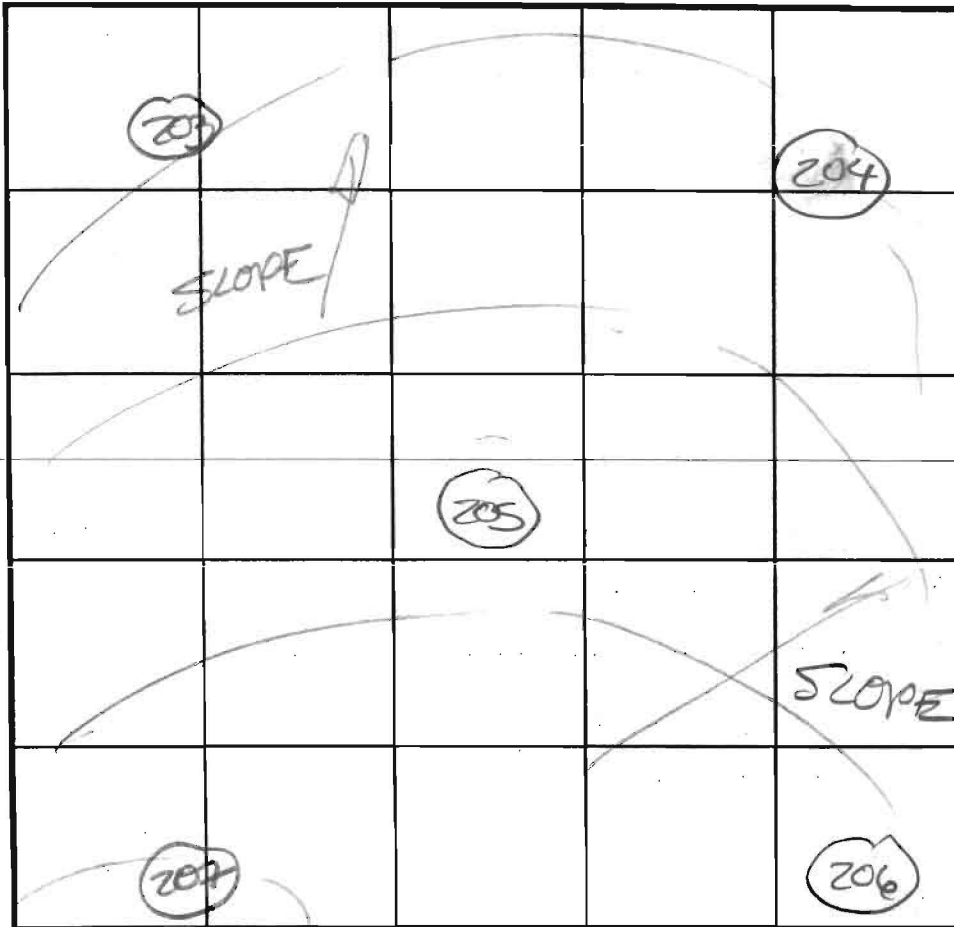

SOIL PROFILE

0' 204  
Brown Loam 8"  
Red Silty Clay Loam 3 1/2'  
Lt Brown Loam Sand 10-20% Charly Gneiss Frag. HARD BOTTOM 8 1/2'  
703  
Brown Loam 1'  
Red Brown Clay Loam 2 1/2'  
Brown Silty Loam 11'

INDICATE NORTH - NAME ADJOINING ROADWAY AS BASE LINE.

DATE	TEST NO.	DEPTH	PRE-WET		TEST - 1" DROP		TIME	
			START	STOP	START	STOP		
7/8/03	206	5 1/2" / 11"	10 <sup>07</sup>	10 <sup>09</sup>	10 <sup>09</sup>	10 <sup>12</sup>	3min	P
	205	5 1/2" / 11"	10 <sup>18</sup>	10 <sup>22</sup>	10 <sup>22</sup>	10 <sup>24</sup>	2min	P
	204	5 1/2" / 8 1/2"	10 <sup>34</sup>	10 <sup>35</sup>	10 <sup>35</sup>	10 <sup>36</sup>	1min	F
	207	5 1/2" / 10 1/2"	9 <sup>57</sup>	10 <sup>01</sup>	10 <sup>01</sup>	10 <sup>04</sup>	3min	F
	203	5 1/2" / 11"	10 <sup>34</sup>	10 <sup>36</sup>	10 <sup>36</sup>	10 <sup>41</sup>	5min	P


REMARKS \_\_\_\_\_

TYPE OF SOIL \_\_\_\_\_

TESTED BY FA ALSO PRESENT Bob Sheesley  
Mark Johnson

TRENCH DESIGN DATA: AVERAGE PERCOLATION TIME \_\_\_\_\_ TRENCH WIDTH \_\_\_\_\_

INLET DEPTH \_\_\_\_\_ MAXIMUM BOTTOM DEPTH \_\_\_\_\_ SQ. FT./BEDROOM \_\_\_\_\_

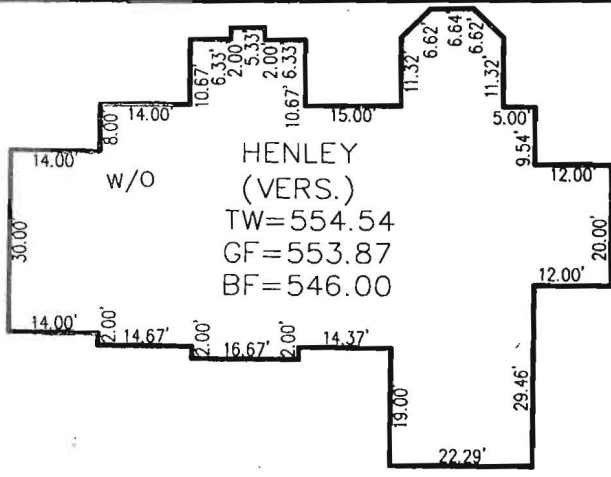

DETAIL: 1"=30'

WELL No. HO-95-1055

BASEMENT NOT SERVICED VIA GRAVITY  
PUMP REQUIRED IN BASEMENT


INV. @ HOUSE	549.6
GROUND @ INV. @ HOUSE	552.5
INV. IN TANK	547.9
INV. OUT TANK	547.6
TOP OF TANK	548.9
GROUND OVER TANK	550.9
INV. IN DIST. BOX	547.4
INV. OUT DIST. BOX	547.1
GROUND @ BOX	551.1

THIS AREA DESIGNATES A PRIVATE SEWERAGE EASEMENT OF AT LEAST 10,000 SQ. FT. AS REQUIRED BY THE STATE DEPARTMENT OF THE ENVIRONMENT FOR INDIVIDUAL SEWAGE DISPOSAL. IMPROVEMENTS OF ANY NATURE IN THIS AREA IS RESTRICTED UNTIL PUBLIC SEWER IS AVAILABLE. THIS EASEMENT SHALL BECOME NULL AND VOID UPON CONNECTION TO A PUBLIC SEWER SYSTEM. THE COUNTY HEALTH OFFICER SHALL HAVE THE AUTHORITY TO GRANT ADJUSTMENTS TO THE PRIVATE SEWERAGE EASEMENT. ANY CHANGES TO A PRIVATE SEWERAGE EASEMENT SHALL REQUIRE A REVISED PERCOLATION CERTIFICATION PLAN. RECORDATION OF A MODIFIED EASEMENT PLAT SHALL NOT BE NECESSARY.

REVISED SEPTIC AREA HAS AN AREA OF 10,197 SQUARE FEET.

BUILDING SETBACKS (B.R.L.'s) SHOWN HEREON. PER SITE DEVELOPMENT PLAN SETBACK DISTANCES SHOWN HEREON AS "±" HAVE AN ACCURACY OF ±0.1' FOOT.

THE EXISTING WELL(S) SHOWN ON THIS PLAN (IDENTIFIED WITH THE ATTACHED WELL TAG NUMBER HO-95-1055) HAS BEEN FIELD LOCATED BY ESE CONSULTANTS, INC. - PROFESSIONAL LAND SURVEYOR(S), AND IS ACCURATELY SHOWN.

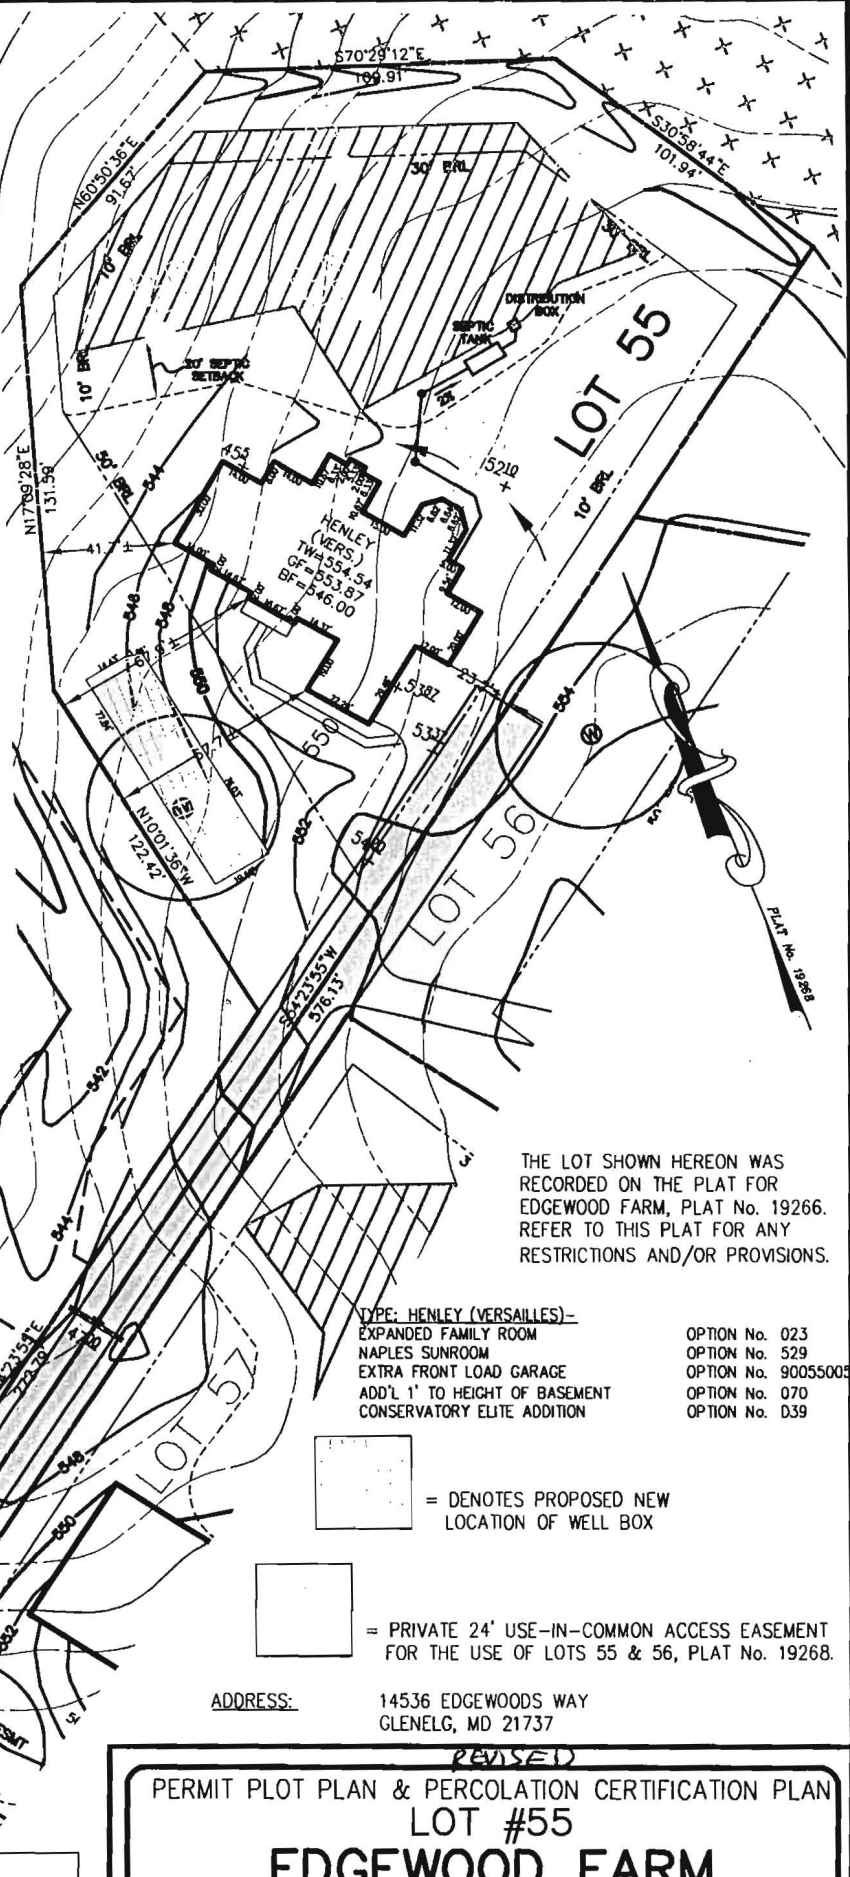

THE LOT SHOWN HEREON WAS RECORDED ON THE PLAT FOR EDGEWOOD FARM, PLAT No. 19266. REFER TO THIS PLAT FOR ANY RESTRICTIONS AND/OR PROVISIONS.

TYPE: HENLEY (VERSAILLES)-  
 EXPANDED FAMILY ROOM  
 NAPLES SUNROOM  
 EXTRA FRONT LOAD GARAGE  
 ADD'L 1' TO HEIGHT OF BASEMENT  
 CONSERVATORY ELITE ADDITION

- OPTION No. 023
- OPTION No. 529
- OPTION No. 90055003
- OPTION No. 070
- OPTION No. 039

[Symbol] = DENOTES PROPOSED NEW LOCATION OF WELL BOX

[Symbol] = PRIVATE 24' USE-IN-COMMON ACCESS EASEMENT FOR THE USE OF LOTS 55 & 56, PLAT No. 19268.

ADDRESS: 14536 EDGEWOODS WAY  
 GLENELG, MD 21737

APPROVED:  
 FOR PRIVATE WATER & PRIVATE SEWAGE SYSTEMS  
 HOWARD COUNTY HEALTH DEPARTMENT

For: *[Signature]*  
 COUNTY HEALTH OFFICER  
 DATE: 6/23/08

PERMIT PLOT PLAN & PERCOLATION CERTIFICATION PLAN  
 LOT #55  
**EDGEWOOD FARM**  
 LIBER 4174, FOLIO 0436  
 PLAT No. 19266, et seq  
 FOURTH ELECTION DISTRICT  
 HOWARD COUNTY, MARYLAND



**ESE** Land Planning  
 Engineering  
 Land Surveying

ESE Consultants Inc.  
 7164 Columbia Gateway Dr.  
 Suite 203  
 Columbia, MD 21046  
 TEL: 410-872-9105  
 FAX: 410-872-4870

DATE: 6/4/08 SCALE: 1"=60' FILE: LOT\_55  
 CHK'D: MJB JOB#: 1498 DRAWN: GVS/CRC

*Signed perc  
cert 3/26/01*

MATCH LINE



M1C3 B

M1C2

NON-BUILDABLE PRESERVATION PARCEL  
DEDICATED TO HOWARD COUNTY PRESERVATION ASSOCIATION EASEMENT-HOLDER

M1C3 B

M1B

G1B2 B

G1B2 B

NON-BUILDABLE PRESERVATION PARCEL  
DEDICATED TO HOWARD COUNTY PRESERVATION ASSOCIATION EASEMENT-HOLDER  
PUBLIC STORMWATER MANAGEMENT ASSOCIATION

S1C3 B

NON-BUILDABLE PRESERVATION PARCEL  
PRIVATELY OWNED  
HOWARD COUNTY PRESERVATION ASSOCIATION EASEMENT-HOLDER

LOT 53  
50,563 S.F.

LOT 56  
53,673 S.F.

LOT 57  
42,142 S.F.

LOT 58  
41,456 S.F.

LOT 59  
44,695 S.F.

LOT 20  
49,356 S.F.

LOT 21  
225 S.F.

LOT 54  
46,405 S.F.

LOT 55  
838 S.F.

PERC 204

PERC 205

PERC 206

PERC 478

PERC 47

Signed Percolation Certification  
Plan on 5/9/05 by Robert Weber  
(aka SP-05-014) for lots 1-60 of  
Edgewood Farm

MATCH LINE SEE SHEET 2

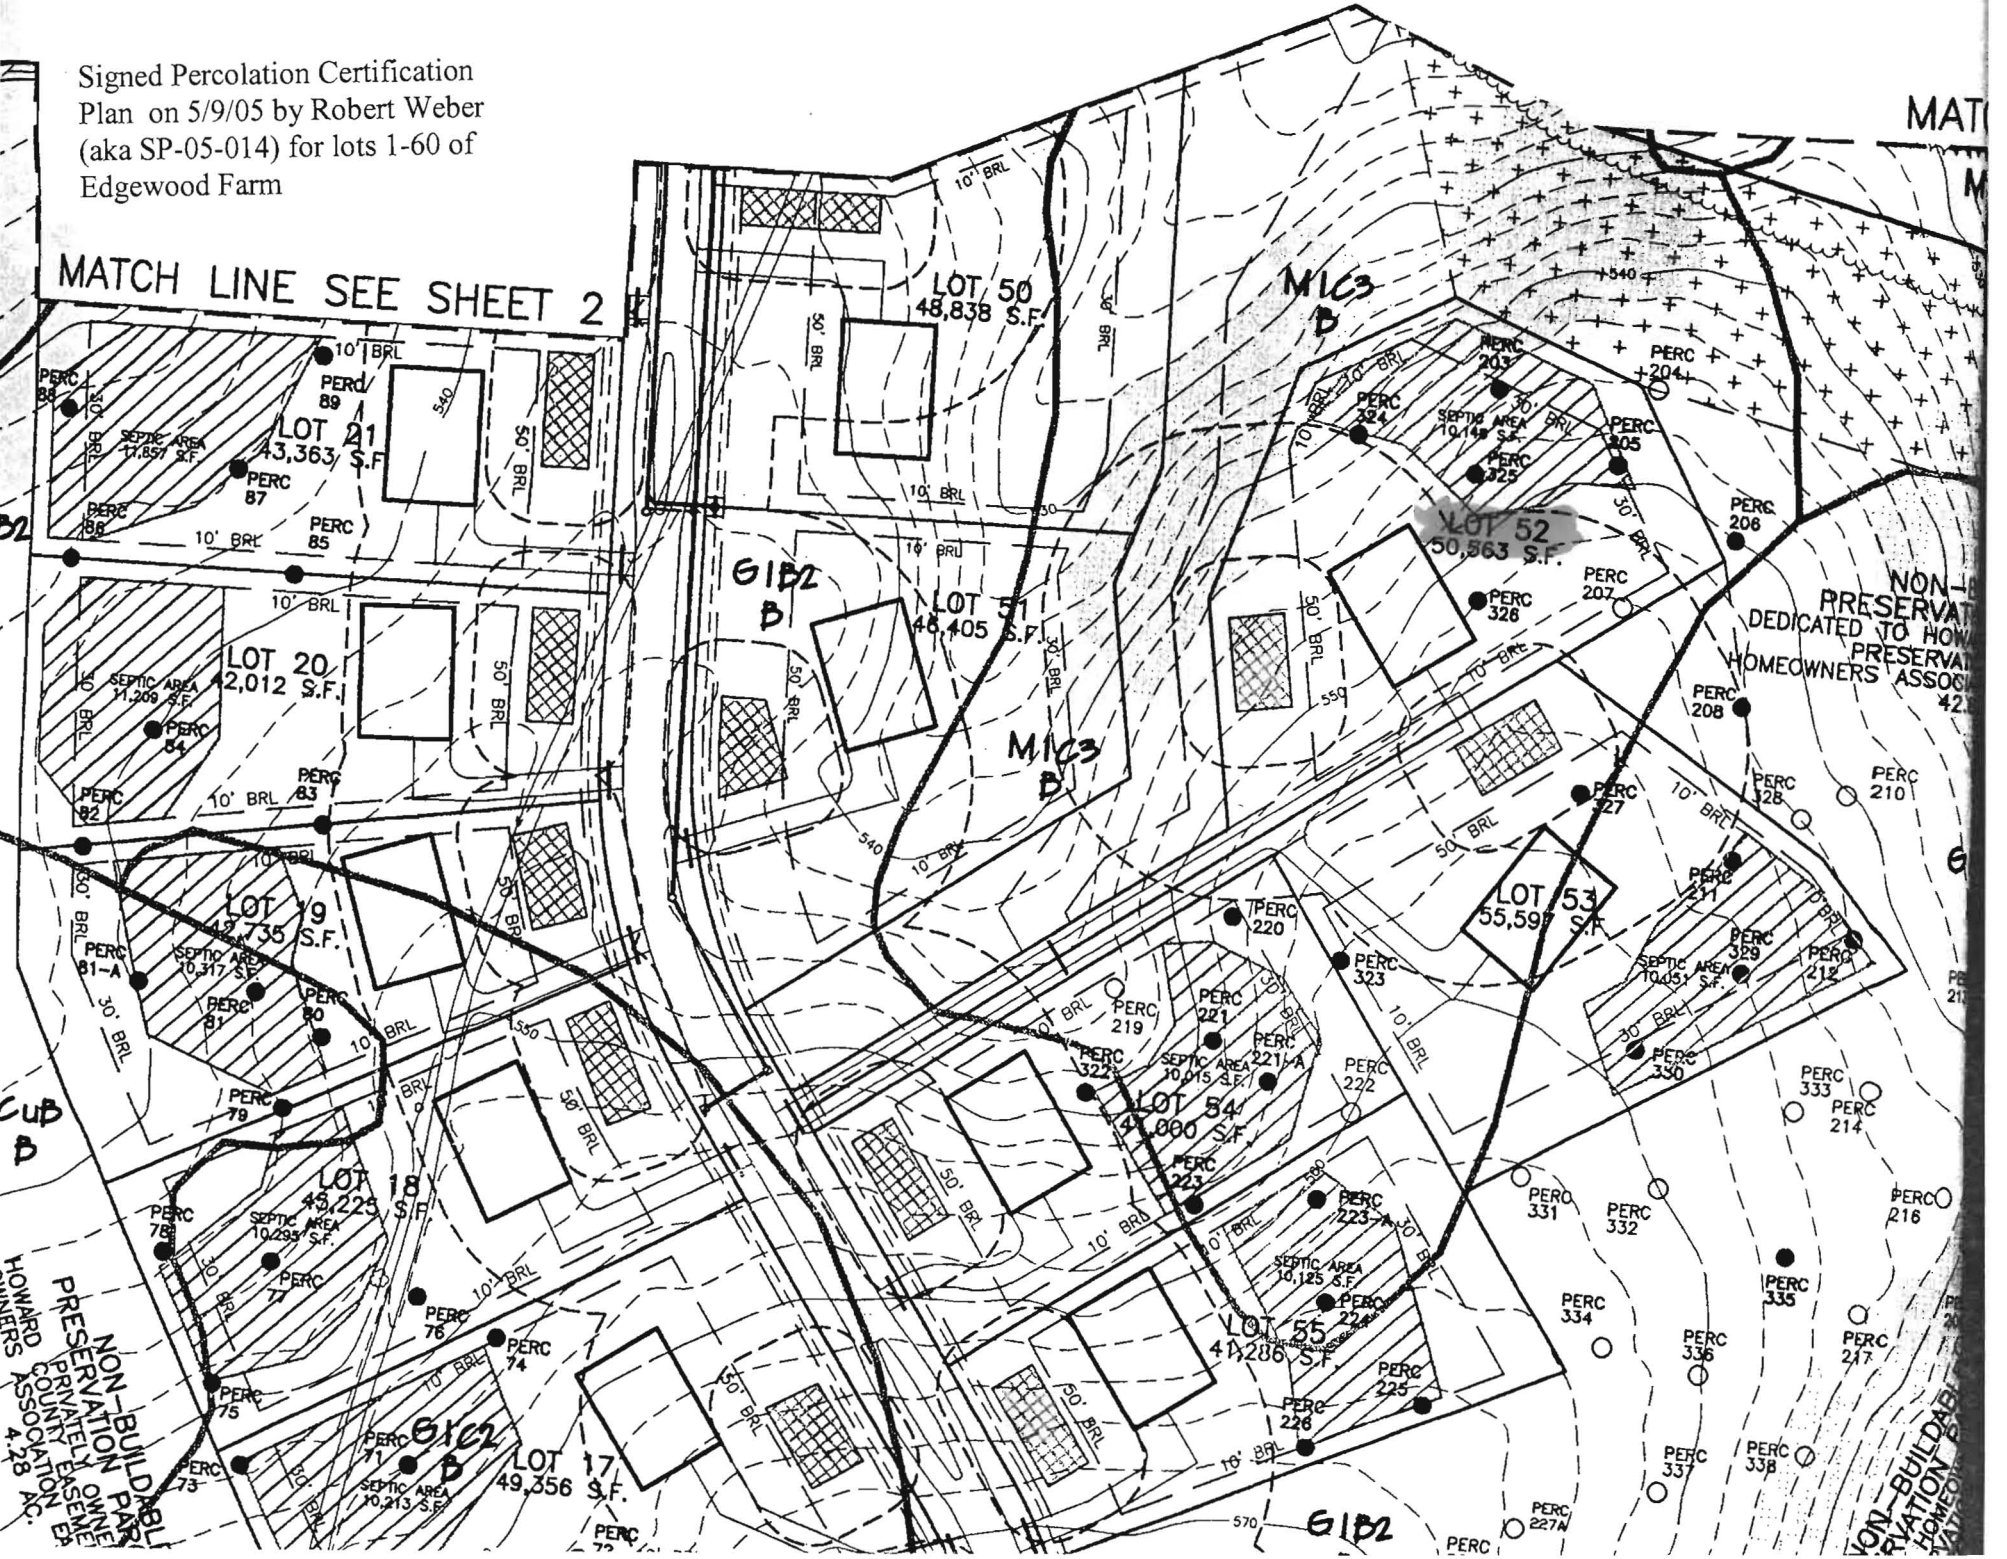

MAT

M

NON-BUILDABLE PRESERVATION DEDICATED TO HOMEOWNERS ASSOCIATION

G

PERC 210

PERC 216

PERC 217

PERC 218

PERC 219

CUB

NON-BUILDABLE PRESERVATION DEDICATED TO HOMEOWNERS ASSOCIATION

G1B2

NON-BUILDABLE PRESERVATION DEDICATED TO HOMEOWNERS ASSOCIATION

CURVE	RADIUS	ARC	DELTA	TANGENT	CHORD
51-52	325.00'	192.00'	33°50'52"	98.89'	N16°40'39"W 189.22'
120-61	50.00'	143.47'	164°24'08"	365.06'	N73°04'00"W 89.08'
62-63	520.00'	137.47'	15°08'49"	69.14'	N16°42'28"E 137.07'
64-119	120.00'	81.18'	38°45'35"	42.21'	S43°39'40"W 79.64'
82-179	275.00'	146.15'	30°26'58"	74.84'	S16°58'42"E 144.43'
84-192	265.00'	48.36'	10°27'22"	24.25'	S30°22'24"W 48.29'

PLAT AREA  
 PLAT REDUCTION  
 1/8" = 100'  
 1/4" = 200'  
 1/2" = 400'  
 1" = 800'  
GRID-NORTH  
 N 579.720  
 E 1,394.800

LEON PARCEL 28  
 & WIFE  
 AND FRANKLIN  
 & FRANKLIN  
 ZONED RC-DEED

THE REQUIREMENTS 1-3-108, THE REAL PROPERTY ARTICLE ANNOTATED CODE OF MARYLAND, 1988 REPLACEMENT VOLUME (AS SUPPLEMENTED) AS FAR AS THEY RELATE TO THE MAKING OF THIS PLAT AND THE SETTING OF MARKERS HAVE BEEN COMPLIED WITH.

*Donald Maon 5/6/07*

DONALD A. MAON  
 REGISTERED PROFESSIONAL LAND SURVEYOR  
 MARYLAND NO. 21320

*William M. Hahn 5/14/07*

WILLIAM M. HAHN  
 TOLL MD V LIMITED PARTNERSHIP

AREA TABULATION CHART

TOTAL NUMBER OF LOTS AND/OR PARCELS TO BE RECORDED	21 and P/O 1
BUILDABLE	0
OPEN SPACE	0
BUILDABLE PRESERVATION PARCELS	0
NON-BUILDABLE PRESERVATION PARCELS	0
NON-BUILDABLE BULK PARCELS	0
TOTAL AREA OF LOTS AND/OR PARCELS TO BE RECORDED	
BUILDABLE	23,444 AC.
OPEN SPACE	N/A
BUILDABLE PRESERVATION PARCELS	N/A
NON-BUILDABLE PRESERVATION PARCELS	N/A
NON-BUILDABLE BULK PARCELS	N/A
TOTAL AREA OF ROADWAY TO BE RECORDED (INCLUDING MIDENING STRIPS)	N/A
TOTAL AREA OF SUBDIVISION TO BE RECORDED	23,444 AC.

APPROVED: FOR PRIVATE WATER, PRIVATE SEWER AND SHARED SEPTIC SYSTEMS, USE OF THE SHARED SEWERAGE SYSTEM IS IN CONFORMANCE WITH THE COUNTY PLAN, HOWARD COUNTY HEALTH DEPARTMENT

*Bruce A. Peter Baileman MD 6/8/2007*  
 HOWARD COUNTY HEALTH OFFICER

APPROVED: HOWARD COUNTY DEPARTMENT OF PLANNING AND ZONING

*Alan Dawson 7/6/07*  
 CHIEF, DEVELOPMENT ENGINEERING DIVISION

*Pertha K. Ayer 7/6/07*  
 DIRECTOR

SURVEYOR'S CERTIFICATE

I HEREBY CERTIFY TO THE BEST OF MY KNOWLEDGE, INFORMATION AND BELIEF THAT THE INFORMATION SHOWN HEREON IS CORRECT, THAT IT IS ALL OF LAND ACQUIRED BY TOLL MD V LIMITED PARTNERSHIP FROM EDGEWOOD FARM, INC. BY DEED DATED MAY 4, 2007 AND RECORDED IN LIBER 10077 AT FOLIO 461 AND THAT ALL MONUMENTS ARE IN PLACE OR WILL BE IN PLACE PRIOR TO ACCEPTANCE OF THE ROADS BY HOWARD COUNTY, IN ACCORDANCE WITH THE ANNOTATED CODE OF MARYLAND, AS AMENDED.

MDR PLAT NO. 19268

RECEIVED JUL 27 2007  
 FOR RECORD

*Donald Maon 5/6/07*  
 DONALD A. MAON  
 REGISTERED PROFESSIONAL LAND SURVEYOR  
 MARYLAND NO. 21320

OWNER'S CERTIFICATE

TOLL MD V LIMITED PARTNERSHIP, OWNER OF THE PROPERTY SHOWN HEREON, HEREBY ADOPTS THIS PLAN OF SUBDIVISION AND BY CONSIDERATION OF APPROVAL OF THIS FINAL PLAT BY THE DEPARTMENT OF PLANNING AND ZONING, ESTABLISHES THE MINIMUM BUILDING RESTRICTION LINES AND GRANTS TOLL MD V LIMITED PARTNERSHIP, ITS SUCCESSORS AND ASSIGNS, (1) THE RIGHT TO LAY, CONSTRUCT AND MAINTAIN SEWERS, DRAINS, WATER PIPES, AND OTHER MUNICIPAL UTILITIES AND SERVICES, IN AND UNDER ALL ROADS AND STREET RIGHTS-OF-WAY, AND THE SPECIFIC EASEMENT AREAS SHOWN HEREON, (2) THE RIGHT TO REQUIRE DEDICATION FOR PUBLIC USE THE BEDS OF THE STREETS AND/OR ROADS, FLOODPLAINS AND OPEN SPACE WHERE APPLICABLE, AND FOR GROUND AND OTHER VALUABLE CONSIDERATION, HEREBY GRANTS THE RIGHT AND OPTION TO HOWARD COUNTY TO ACQUIRE THE FEE SIMPLE TITLE TO THE BEDS OF THE STREETS AND/OR ROADS AND FLOODPLAINS, STORM DRAINAGE FACILITIES AND OPEN SPACE WHERE APPLICABLE, (3) THE RIGHT TO REQUIRE DEDICATION OF WATERWAYS AND DRAINAGE EASEMENTS FOR THE SPECIFIC PURPOSE OF THEIR CONSTRUCTION, REPAIR AND MAINTENANCE, AND (4) THAT NO BUILDING OR SIMILAR STRUCTURE OF ANY KIND SHALL BE ERECTED ON OR OVER THE SAID EASEMENTS AND RIGHTS-OF-WAY, WITHIN OUR HANDS THIS 19TH DAY OF MAY, 2007.

*William M. Hahn 5/14/07*  
 TOLL MD V LIMITED PARTNERSHIP

OWNER:  
 TOLL MD V LIMITED PARTNERSHIP  
 250 GILBERTER ROAD  
 HORSHAM, PENNSYLVANIA 19044

BENCHMARK  
 ENGINEERING, INC.

8400 BALTIMORE NATIONAL PIKE & SUITE 418  
 ELICOTT CITY, MARYLAND 21043  
 phone: 410-465-8105 & fax: 410-465-8644  
 www.benchmark-engineering.com

RECORDED AS PLAT NO. \_\_\_\_\_  
 ON \_\_\_\_\_ AMONG THE LAND  
 RECORDS OF HOWARD COUNTY, MARYLAND.


EDGEWOOD FARM  
 PHASE 2  
 LOTS 8 - 60 AND  
 NON-BUILDABLE PRESERVATION PARCELS 'H' AND 'I'

A RESUBDIVISION OF  
 NON-BUILDABLE BULK PARCELS 'AA'-'HH'  
 PLAT NOS. 14155-19461  
 SP-05-D14 F-06-108 RE-06-10

FOURTH ELECTION DISTRICT OF HOWARD COUNTY, MARYLAND  
 TAX MAP: 21  
 GRID: 22  
 PARCEL: 80  
 ZONED: RC-DEED  
 SCALE: AS SHOWN  
 DATE: MAY, 2007  
 SHEET: 3 OF 4

PLAN VIEW  
 SCALE: 1" = 100'

LOT NO.	GROSS AREA	PIPESTEM AREA	MINIMUM LOT SIZE
28	53,280	3,498	49,784
29	46,268	1,603	44,663
35	46,162	2,941	43,221
55	50,563	3,273	47,290
58	53,673	3,674	49,999

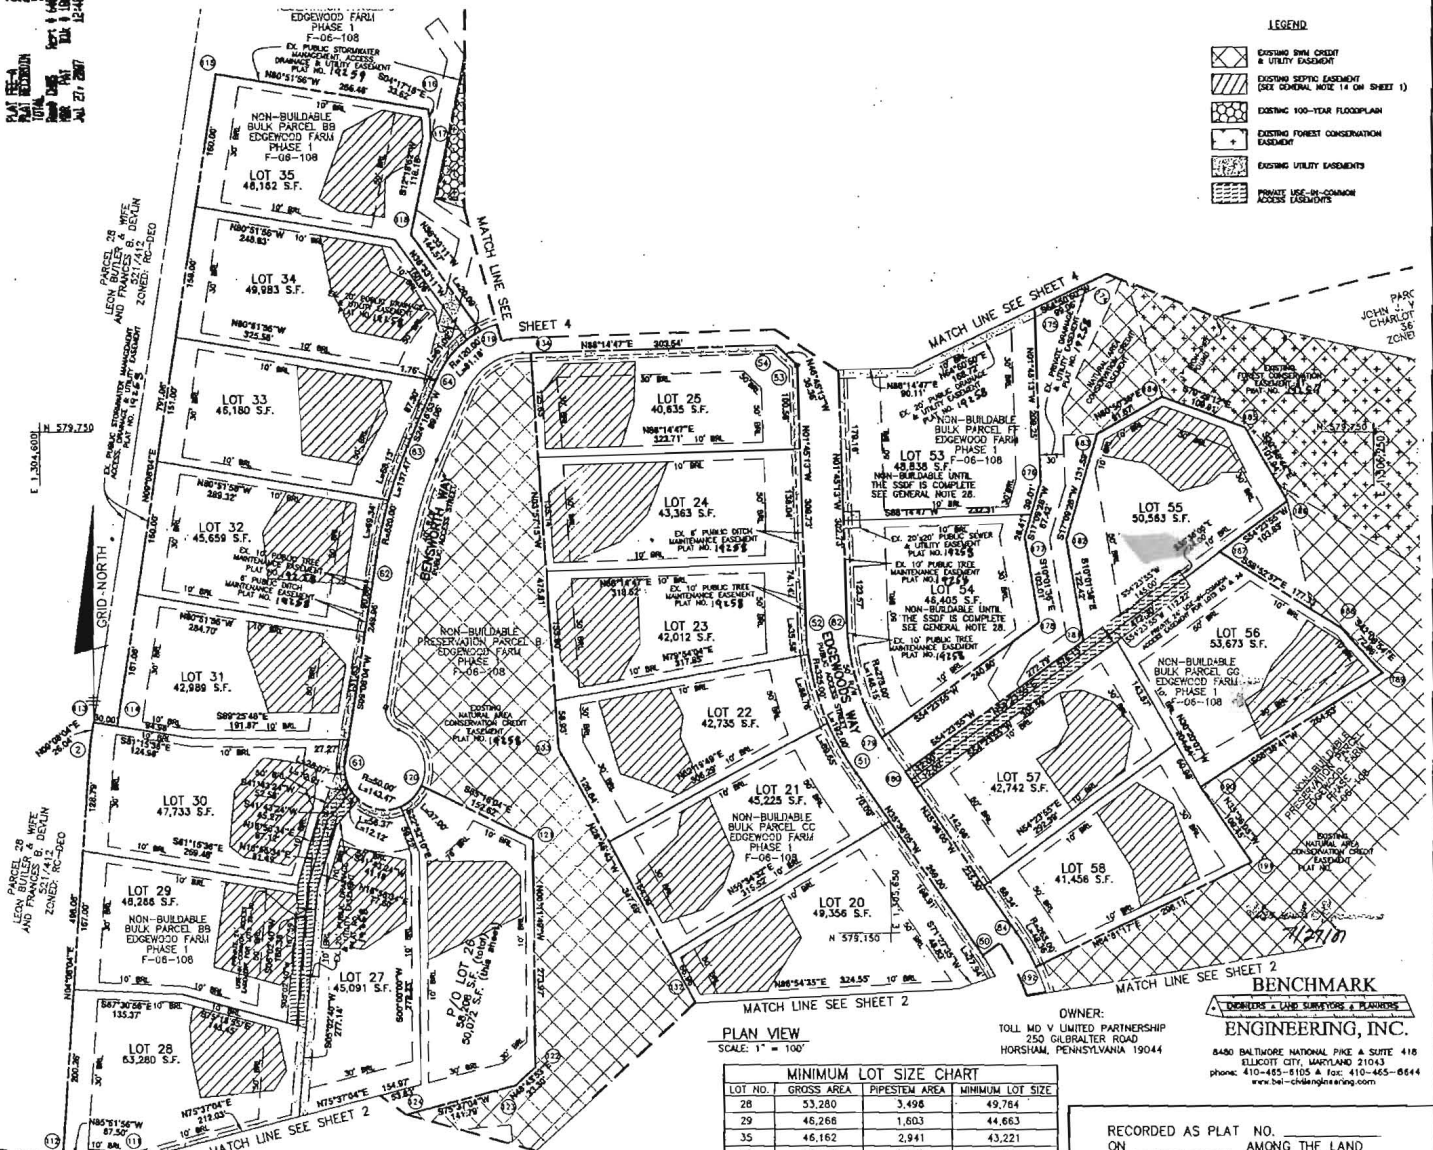

LEGEND

[Symbol]	EXISTING BULK COSEPT & UTILITY EASEMENT
[Symbol]	EXISTING SEPTIC EASEMENT (SEE GENERAL NOTE 14 ON SHEET 1)
[Symbol]	EXISTING 100-YEAR FLOODPLAIN
[Symbol]	EXISTING FOREST CONSERVATION EASEMENT
[Symbol]	EXISTING UTILITY EASEMENTS
[Symbol]	PRIVATE USE-IN-COMMON ACCESS EASEMENTS