

PRELIMINARY

APPLICATION

A 26610

SEWAGE DISPOSAL TESTING

P _____

STATE OF MARYLAND - DEPARTMENT OF HEALTH AND MENTAL HYGIENE

DISTRICT 5th

HOWARD COUNTY HEALTH DEPARTMENT
ENVIRONMENTAL HEALTH SERVICES
P. O. BOX 476, ELLICOTT CITY, MARYLAND 21043
TELEPHONE: 465-5000, EXT. 356

DATE 8/16/77

9/22/77
9:30 A.M.

TO: THE COUNTY HEALTH OFFICER
ELLICOTT CITY, MARYLAND

I, HEREBY, APPLY FOR THE NECESSARY TEST IN ORDER TO CONSTRUCT (OR RECONSTRUCT) A SEWAGE DISPOSAL SYSTEM.

PROPERTY OWNER ~~William Mitchell~~ Steve Pitman

ADDRESS _____ PHONE Paul Kottis
421-9433

PROPERTY LOCATION: See S Area I Final Lot 2
NEW LOT 11

SUBDIVISION Dayton Meadows LOT NO. ~~3, Block A~~

ROAD AND DESCRIPTION Green Bridge Road 13809 DAYTON MEADOWS 1/2 of Lot 2, Blk. A,
to be combined with
CA. this lot.

SIZE OF LOT 40,000 sq. ft. TYPE BLDG. 3 or 4 bedrooms
NUMBER OF BEDROOMS _____

IF NOT SINGLE RESIDENCE DESCRIBE _____

THE SYSTEM INSTALLED UNDER THIS APPLICATION IS ACCEPTABLE ONLY UNTIL PUBLIC FACILITIES BECOME AVAILABLE.

SIGNATURE OF APPLICANT /s/ Paul Kottis

APPROVED BY S. Abel FOR Deep trenches DATE 5-19-88
(KIND OF SYSTEM)

REJECTED BY _____ FOR _____ DATE _____
(KIND OF SYSTEM)


HOLD PENDING FURTHER TESTS _____ DATE _____

REASONS FOR REJECTION OR HOLDING _____

BLDG. PERMIT SIGNED
AND RETURNED 5-26-88

BP 18662
Seb

THIS IS NOT A PERMIT

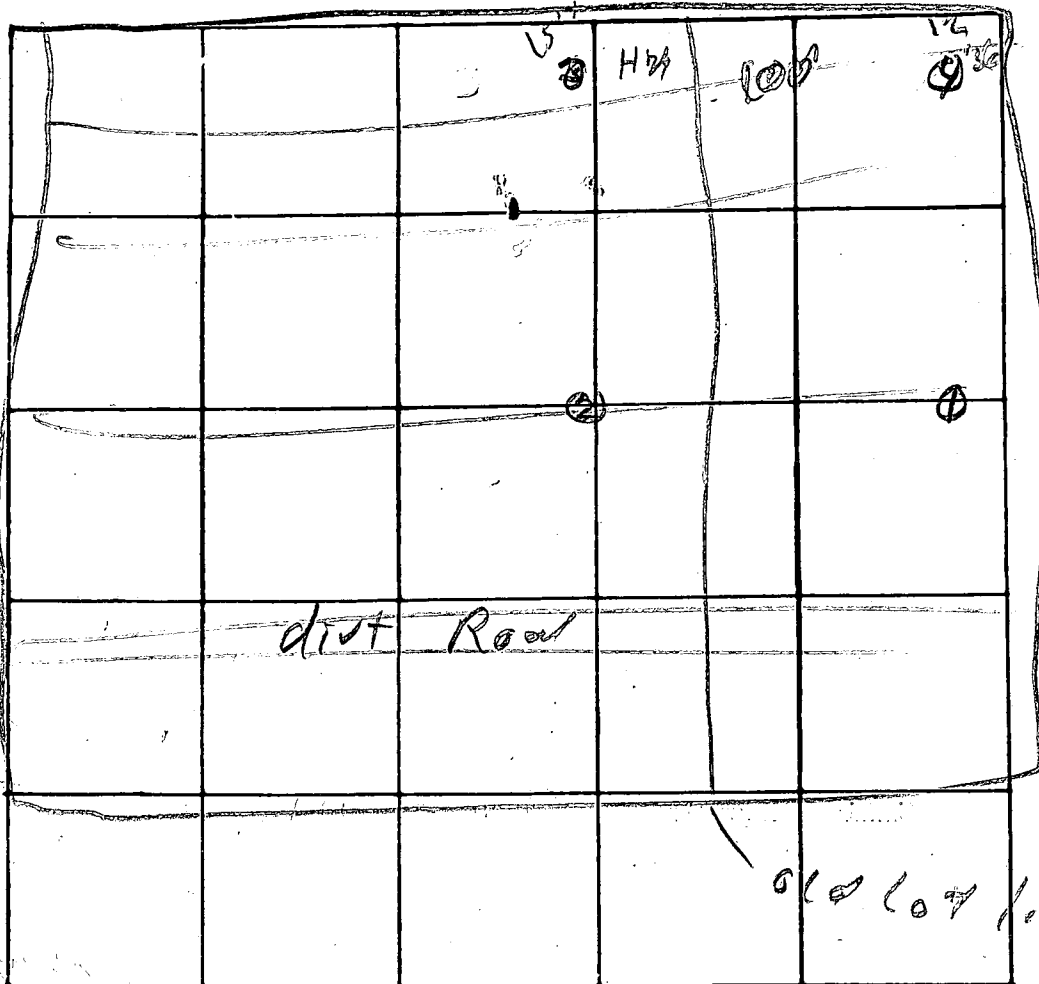

INDICATE NORTH. - NAME ADJOINING ROADWAY AS BASE LINE

DATE	TEST NO.	DEPTH	PRE-WET		TEST - 1" DROP		TIME
			START	STOP	START	STOP	
9/27/79	1s	3 1/2'	11:00			11:08	6
	d	14 1/2'	11:17	11:22	11:22	11:42	20
	2s	3'	11:01			11:05	6
	d	14'	11:22	11:31	11:31	11:41	10
	3s	3'	11:03			11:09	3
	d	14'	11:29	11:33	11:33	11:39	6
	4 or	23'	04	2 1/2 - 781			

REMARKS All ground excellent

TYPE OF SOIL 2 1/2" layers / loam

TESTED BY DJON ALSO PRESENT: Kott's

PRELIMINARY

APPLICATION

A 26623

P _____

SEWAGE DISPOSAL TESTING

STATE OF MARYLAND - DEPARTMENT OF HEALTH AND MENTAL HYGIENE

HOWARD COUNTY HEALTH DEPARTMENT
ENVIRONMENTAL HEALTH SERVICES
P O. BOX 476, ELLICOTT CITY, MARYLAND 21043
TELEPHONE: 465-5000, EXT. 356

DISTRICT 5th
DATE 8/16/77

TO: THE COUNTY HEALTH OFFICER
ELLICOTT CITY, MARYLAND

I, HEREBY, APPLY FOR THE NECESSARY TEST IN ORDER TO CONSTRUCT (OR RECONSTRUCT) A SEWAGE DISPOSAL SYSTEM.

PROPERTY OWNER William Mitchell

ADDRESS _____ PHONE Paul Kottis
421-9433

PROPERTY LOCATION: _____

SUBDIVISION Dayton Meadows LOT NO. SECT. 1 AREA 2
NEW LOT 5
6, Block B

ROAD AND DESCRIPTION Green Bridge Road

SIZE OF LOT 40,000 sq. ft. TYPE BLDG. 3 or 4 bedrooms
NUMBER OF BEDROOMS

IF NOT SINGLE RESIDENCE DESCRIBE _____

THE SYSTEM INSTALLED UNDER THIS APPLICATION IS ACCEPTABLE ONLY UNTIL PUBLIC FACILITIES BECOME AVAILABLE.

SIGNATURE OF APPLICANT /s/ Paul Kottis


APPROVED BY _____ FOR _____ DATE _____
(KIND OF SYSTEM)

REJECTED BY _____ FOR _____ DATE _____
(KIND OF SYSTEM)

HOLD PENDING FURTHER TESTS _____ DATE _____

REASONS FOR REJECTION OR HOLDING _____

THIS IS NOT A PERMIT

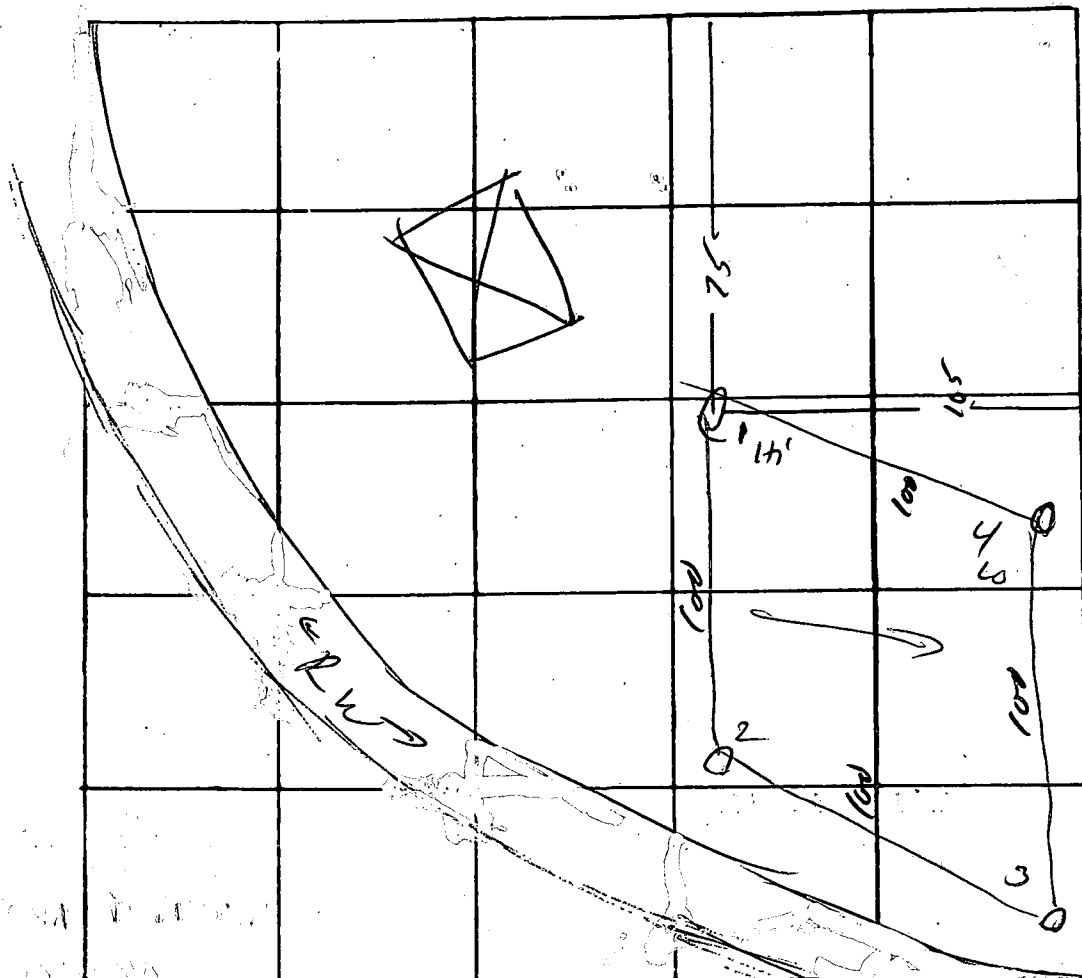

Lot 6 B

INDICATE NORTH. - NAME ADJOINING ROADWAY AS SHOWN

DATE	TEST NO.	DEPTH	PRE-WET		TEST - 1" DROP		TIME
			START	STOP	START	STOP	
26 Aug 73	1	3 1/2	2 11	2 15	2 15	2 24	9
		13 1/2	"	"	"	2 24	9
	2	13	vis		same		
	3	3	2 13	2 21	2 21	2 35	14
		14	"	2 15	2 15	2 20	5
	4	3	2 08	2 14	2 14	2 22	8
		14	"	"	"	2 23	9

REMARKS _____

TYPE OF SOIL _____

TESTED BY M / CBS ALSO PRESENT: _____