

PRELIMINARY

APPLICATION

A 28230

P _____

SEWAGE DISPOSAL TESTING

STATE OF MARYLAND - DEPARTMENT OF HEALTH AND MENTAL HYGIENE

HOWARD COUNTY HEALTH DEPARTMENT
ENVIRONMENTAL HEALTH SERVICES
P. O. BOX 476, ELLICOTT CITY, MARYLAND 21043
TELEPHONE: 465-5000, EXT. 356

DISTRICT 3rd

DATE 6/21/78

TO: THE COUNTY HEALTH OFFICER
ELLICOTT CITY, MARYLAND

I, HEREBY, APPLY FOR THE NECESSARY TEST IN ORDER TO CONSTRUCT (OR RECONSTRUCT) A SEWAGE DISPOSAL SYSTEM.

PROPERTY OWNER Glenelg Manor Associates

ADDRESS _____ PHONE _____

PROPERTY LOCATION:

SUBDIVISION Glenelg Manor LOT NO. 10B, Section 2

ROAD AND DESCRIPTION Folly Quarter Road

SIZE OF LOT ? TYPE BLDG. 3 or 4 bedrooms
NUMBER OF BEDROOMS

IF NOT SINGLE RESIDENCE DESCRIBE _____

THE SYSTEM INSTALLED UNDER THIS APPLICATION IS ACCEPTABLE ONLY UNTIL PUBLIC FACILITIES BECOME AVAILABLE.

SIGNATURE OF APPLICANT /s/ John Rettaliata

APPROVED BY _____ FOR _____ DATE _____
(KIND OF SYSTEM)


REJECTED BY _____ FOR _____ DATE _____
(KIND OF SYSTEM)

HOLD PENDING FURTHER TESTS _____ DATE _____

REASONS FOR REJECTION OR HOLDING 2/8/83 PERC OK Certify Holes RH

THIS IS NOT A PERMIT

10B

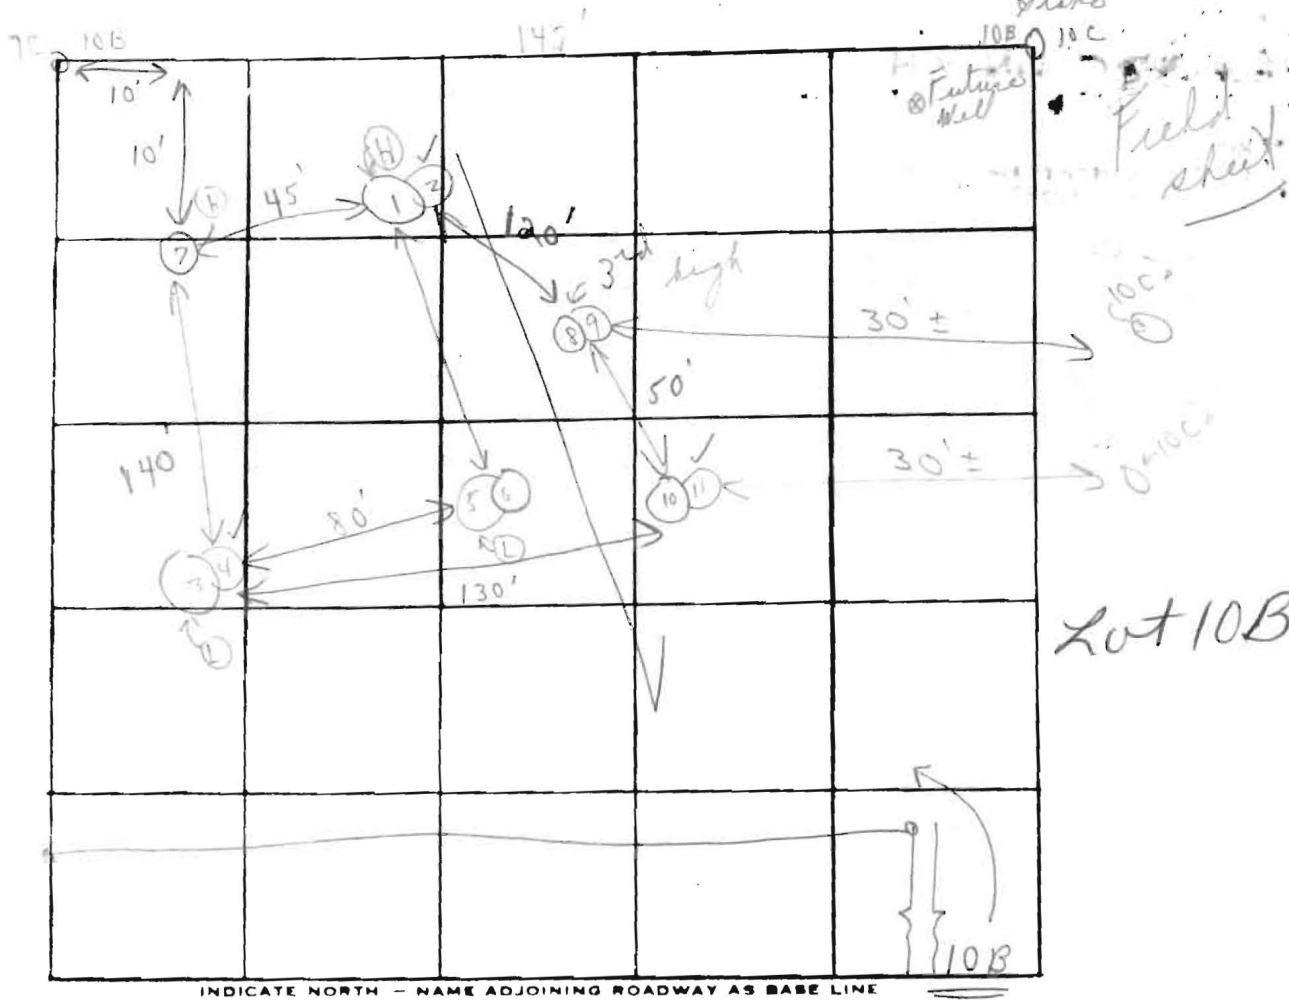

DATE	TEST NO.	DEPTH	PRE-WET		TEST - 1" DROP		TIME
			START	STOP	START	STOP	
1/2/72	1	4 1/2'	9:47	9:49	9:49	9:51	2m
	(H) 2	14'	9:47	9:49	9:49	9:51	2m
	3	4'	9:55	9:58	9:58	10:06	8m
	(L) 4	13'	9:55	9:56	9:56	9:58	2m
	5	3 1/2'	:	:	:	:	
	(L) 6	13'	:	:	:	:	
	(H) 7	4 1/2' 13'	:	:	:	:	
	8	5'	:	:	:	:	
	9	13'	:	:	:	:	
	10	4'	9:52	9:58	9:58	10:07	9m
	11	13'	9:52	9:57	9:57	10:04	7m

Tests
per
stake
all holes
staked

REMARKS

Tests in open field Hold for certified hole

TYPE OF SOIL

Not dug when contractor arrived

TESTED BY

C. R. O.

ALSO PRESENT:

Brittenham men
Skeps, Surg

HOWARD COUNTY HEALTH DEPARTMENT

HD - 109

P.O. BOX 476
ELLCOTT CITY, MARYLAND 21043
TELEPHONE: 992-2333

February 5, 1980

MEMORANDUM

TO: Mr. Jack Boender
FROM: Donald W. Monaghan

This is to advise that the house site for Lot 10B, Glenelg Manor, Section 2, does not meet Planning and Zoning regulations regarding rear and side setback lines.

DWM:hs