

11:30 7/16/03 Final

PUB. SEWER STATUS VERIFIED BY NA

ISSUE DATE: 6/11/2003

P 519010-A

APPROVAL DATE: 7/16/03

PERMIT INDEXED

A REPAIR (A32706)

**ON-SITE SEWAGE DISPOSAL SYSTEM
HOWARD COUNTY HEALTH DEPARTMENT
BUREAU OF ENVIRONMENTAL HEALTH**

05-374391

INDEXED

Freedom Septic IS PERMITTED TO INSTALL ALTER

ADDRESS: 239 West Old Liberty Rd, 21784 PHONE NUMBER: 410-795-2947

SUBDIVISION: Glenelg Manor II LOT NUMBER: 10-B

ADDRESS: 12755 Folly Quarter Road PROPERTY OWNER: Steve Roaner

SEPTIC TANK CAPACITY (GALLONS): 1250 (W) (410) 736-7589

PUMP CHAMBER CAPACITY (GALLONS): — (H) 410 531-1107

NUMBER OF BEDROOMS: 4

SQUARE FEET PER BEDROOM: 180

LINEAR FEET OF TRENCH REQUIRED: 150'

TRENCHES:	Trench to be 3 feet wide. Inlet 4 feet below original grade. Bottom maximum depth 6 feet below original grade. Effective area begins at 4 feet below original grade. 2 feet of stone below distribution pipe.
LOCATION:	Abandoned old trench Pump, collapse, fill in old S. tank
PURPOSE:	In support of building permit. Call for inspection when the ground is opened so sanitarian can recommend repair.


PLANS APPROVED: [Signature] DATE: 6/16/03

- NOTE: PERMIT VOID AFTER 2 YEARS
- NOTE: CONTRACTOR RESPONSIBLE FOR SCHEDULING A PRE-CONSTRUCTION INSPECTION FOR ALL INSTALLATIONS
- NOTE: WATERTIGHT SEPTIC TANKS REQUIRED
- NOTE: ALL PARTS OF SEPTIC SYSTEM SHALL BE 100 FEET FROM ANY WATER WELL
- NOTE: MANHOLE RISERS REQUIRED ON ALL SEPTIC TANKS AND PUMP CHAMBERS

NEITHER THE HOWARD COUNTY COUNCIL NOR THE HEALTH DEPARTMENT IS RESPONSIBLE FOR THE SUCCESSFUL OPERATION OF ANY SYSTEM PERMITTEE RESPONSIBLE FOR OBTAINING FINAL APPROVAL ON THIS PERMIT BUILDING PERMIT SIGNED-313-2640 FOR INSPECTION OF SEPTIC SYSTEM AND RETURNED

9-4-03 600143 807 - ADDITION 16 x 68

NOT TO SCALE

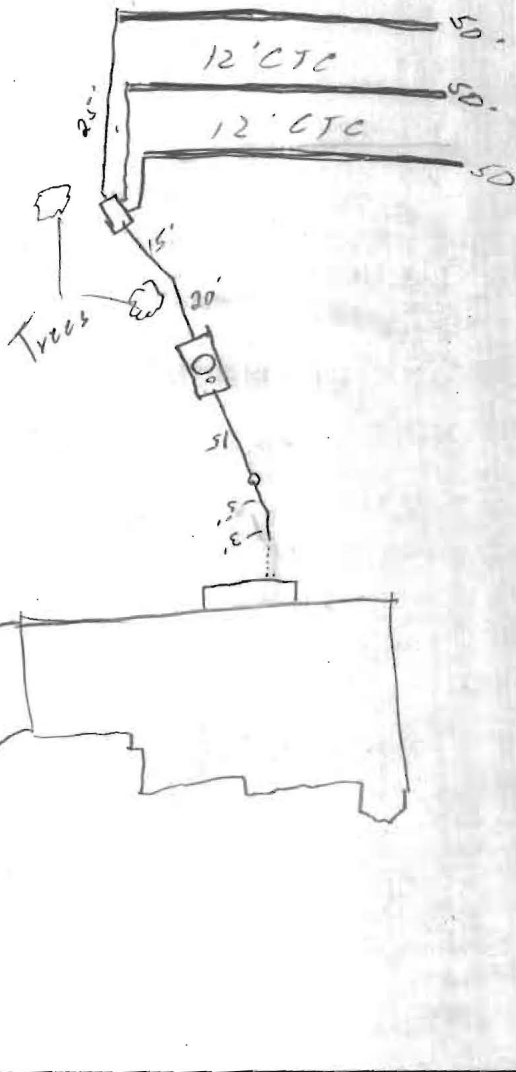

TRENCH/DRAINFIELD DATA		
WIDTH	INLET	BOTTOM
3'	4'	6'
NUMBER OF TRENCHES		3
TOTAL LENGTH		150'
ABSORPTION AREA		450A
DISTRIBUTION BOX LEVEL		<input checked="" type="checkbox"/>
DISTRIBUTION BOX BAFFLE		<input checked="" type="checkbox"/>
DISTRIBUTION BOX PORT		<input type="checkbox"/>

SEPTIC TANK DATA	
SEPTIC TANK 1 LEVEL	<input checked="" type="checkbox"/>
CAPACITY	1500 GAL
SEAM LOC	Top
TANK LID DEPTH	2'
BAFFLES	<input checked="" type="checkbox"/>
BAFFLE FILTER	<input type="checkbox"/>
MANHOLE LOC	Center
6" PORT LOC	Front
WATERTIGHT TEST	<input type="checkbox"/>
SEPTIC TANK 2 LEVEL	<input type="checkbox"/>
CAPACITY	_____ GAL
SEAM LOC	_____
TANK LID DEPTH	_____
BAFFLES	N/A
BAFFLE FILTER	<input type="checkbox"/>
MANHOLE LOC	_____
6" PORT LOC	_____
WATERTIGHT TEST	<input type="checkbox"/>

Folly, QTV

ROAD

PRE-CONSTRUCTION 6/13/03 - Met w/ owner, bu.ldr. & contractor.

Addition on back of home over ex. tank (SO)

INSTALLATION 6/16/03 Call to homeowner to give specs. Left message

w/ contr. 6/23/03 Call from contr. gave him specs 7/15/03

Tank set, 1st trench installed (SO) 7/15/03 2nd trench installed OK

to cover work completed (SO) 7/16/03 3rd trench installed

OK to cover all work (SO)

BUILDING PERMIT SIGNED
AND RETURNED

FINAL INSPECTOR [Signature]

DATE OF APPROVAL 7/16/03