

PRELIMINARY

APPLICATION

A 26619

P _____

SEWAGE DISPOSAL TESTING

STATE OF MARYLAND - DEPARTMENT OF HEALTH AND MENTAL HYGIENE

HOWARD COUNTY HEALTH DEPARTMENT
ENVIRONMENTAL HEALTH SERVICES

P. O. BOX 476, ELLICOTT CITY, MARYLAND 21043
TELEPHONE: 465-5000, EXT. 356

DISTRICT 5th

DATE 8/16/77

TO: THE COUNTY HEALTH OFFICER
ELLICOTT CITY, MARYLAND

I, HEREBY, APPLY FOR THE NECESSARY TEST IN ORDER TO CONSTRUCT (OR RECONSTRUCT) A SEWAGE DISPOSAL SYSTEM.

PROPERTY OWNER William Mitchell Trinity Builders

ADDRESS _____ PHONE Paul Kottis 421-9433

PROPERTY LOCATION:

SECT. 1 AREA 1 FINAL #12

~~NEW LOT 21~~

SUBDIVISION Dayton Meadows LOT NO. ~~2~~ Block B

ROAD AND DESCRIPTION Green Bridge Road 13814 Dayton Meadows Court

SIZE OF LOT 40,000 sq. ft. TYPE BLDG. 3 or 4 bedrooms
NUMBER OF BEDROOMS

IF NOT SINGLE RESIDENCE DESCRIBE _____

THE SYSTEM INSTALLED UNDER THIS APPLICATION IS ACCEPTABLE ONLY UNTIL PUBLIC FACILITIES BECOME AVAILABLE.

SIGNATURE OF APPLICANT /s/ Paul Kottis

APPROVED BY _____ FOR _____ DATE _____
(KIND OF SYSTEM)


REJECTED BY _____ FOR _____ DATE _____
(KIND OF SYSTEM)

HOLD PENDING FURTHER TESTS _____ DATE _____

REASONS FOR REJECTION OR HOLDING _____

BLDG. PERMIT SIGNED
AND RETURNED 8/31/77
Serial # 44716 - SFD
4 Bedrooms

THIS IS NOT A PERMIT

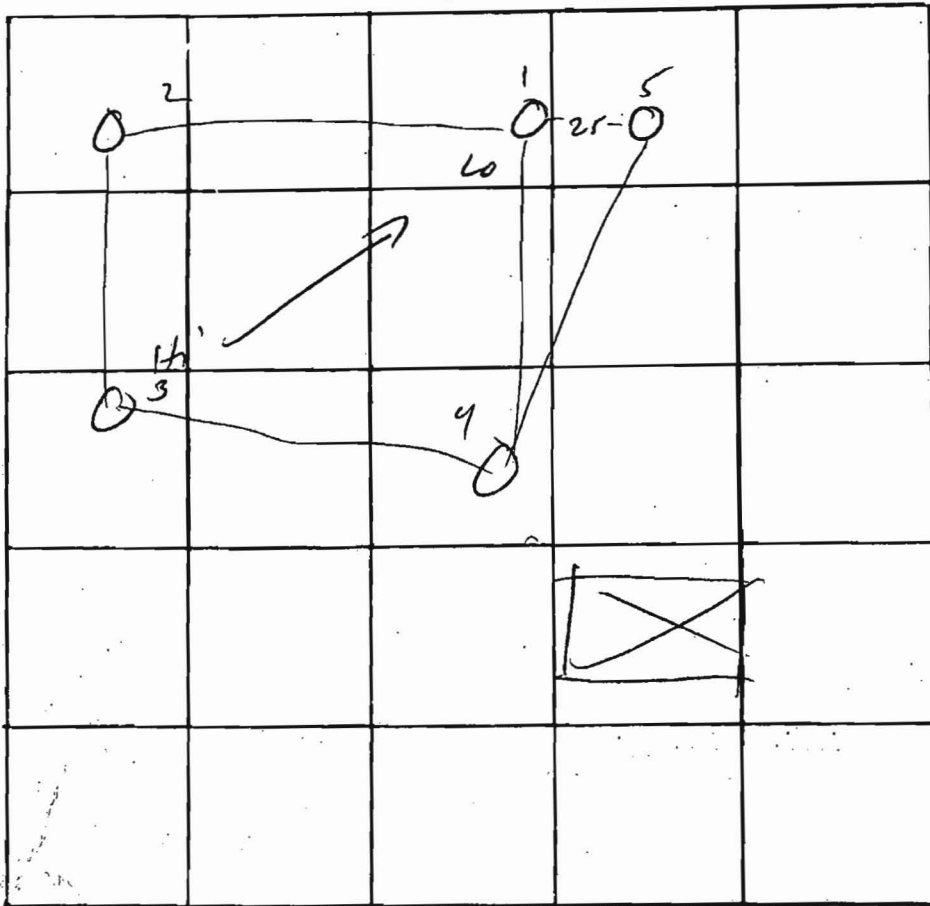

INDICATE NORTH. - NAME ADJOINING ROADWAY AS BASE LINE


①
 0
 1 day
 1 sandy loam
 1 1/2

DATE	TEST NO.	DEPTH	PRE-WET		TEST - 1" DROP		TIME
			START	STOP	START	STOP	
23 Aug 70	1	4	3 ¹⁷	3 ²⁸	3 ²⁸	—	7:30
	1A	14 1/2	3 ¹⁷	3 ²²	3 ²²	3 ³⁰	8
24 Aug	2	5	9 ⁴⁵	10 ⁰⁰	10 ⁰⁰	10 ²⁵	25
23 Aug	2A	14 1/2	3 ²⁴	3 ²⁸	3 ²⁸	3 ³⁷	9
	2B	4	3 ²⁵	15 min = 1/2"	—	—	7:30
24 Aug	5B	5 ²	9 ⁴⁵	10 ⁰²	10 ⁰²	10 ³⁰	28
	1B	5	9 ⁵³	9 ⁵⁸	9 ⁵⁸	10 ⁰³	6
	3	14	10 ⁰⁶	10"	10"	10 ¹⁶	5
	3A	5	11 ⁰⁶	11 ⁰⁸	11 ⁰⁸	11 ¹⁶	8
	4	14	vis	Some			

REMARKS _____

TYPE OF SOIL _____

TESTED BY M ALSO PRESENT: _____

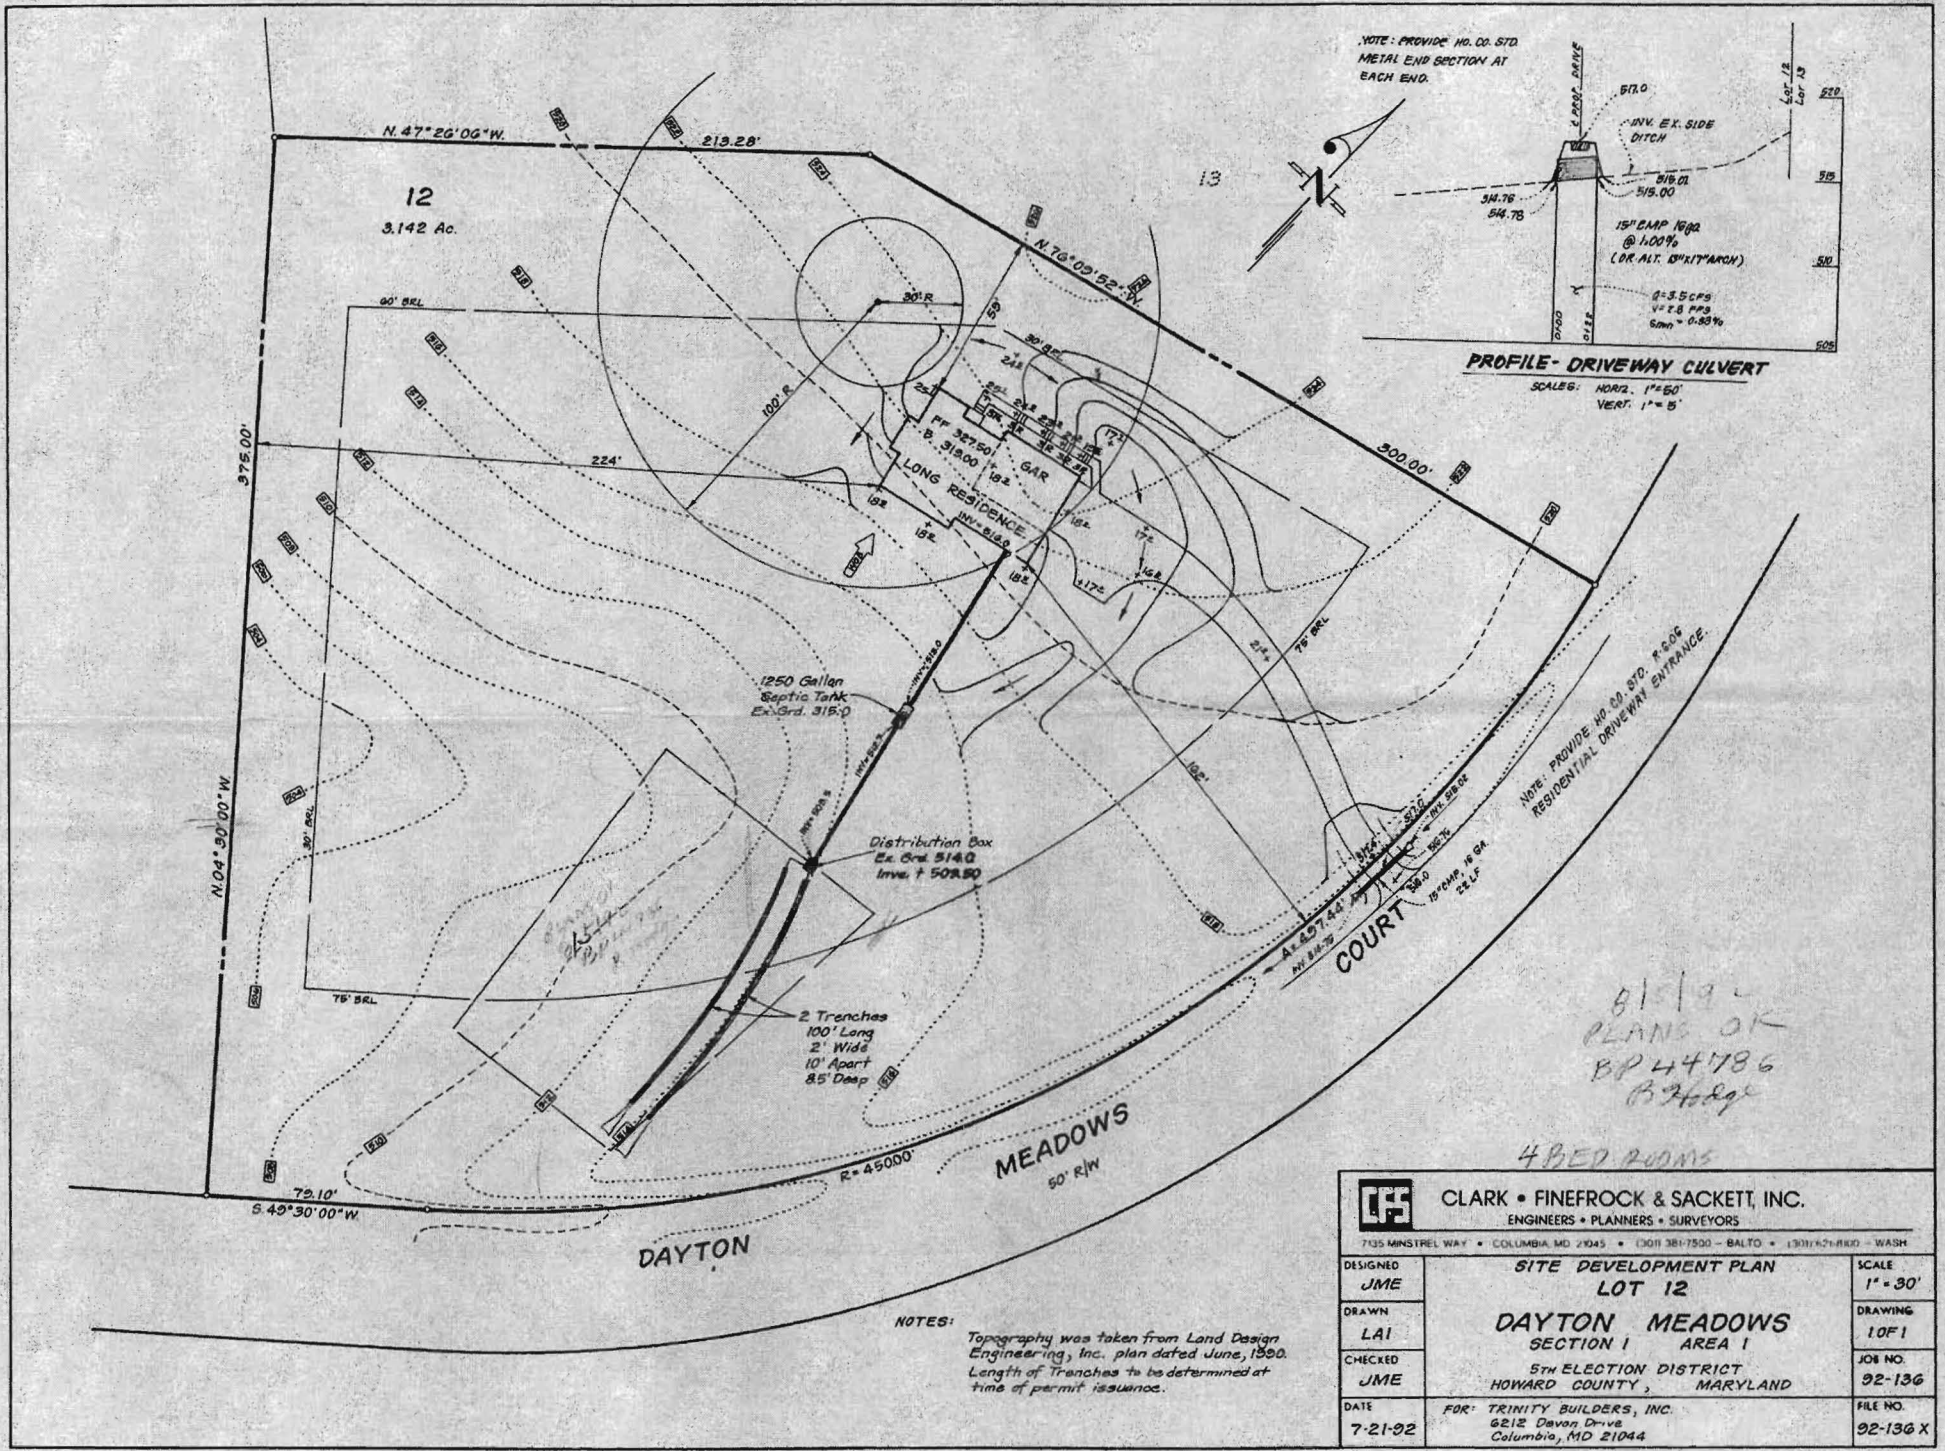

NOTES:
 Topography was taken from Land Design Engineering, Inc. plan dated June, 1990.
 Length of Trenches to be determined at time of permit issuance.

8/1/94
 PLANS OK
 BP 44786
 B. Hedge

4 BED ROOMS

 CLARK • FINECROCK & SACKETT, INC. ENGINEERS • PLANNERS • SURVEYORS 7135 MINSTREL WAY • COLUMBIA, MD 21045 • (301) 381-7500 - BALTO • (301) 621-8100 - WASH		SCALE
		1" = 30'
DESIGNED	SITE DEVELOPMENT PLAN LOT 12 DAYTON MEADOWS SECTION 1 AREA 1 5TH ELECTION DISTRICT HOWARD COUNTY, MARYLAND	DRAWING
DRAWN		10F1
CHECKED		JOB NO.
JME		92-136
DATE	FOR: TRINITY BUILDERS, INC. 6212 Dayton Drive Columbia, MD 21044	FILE NO.
7-21-92		92-136 X