



# APPLICATION

FOR PERCOLATION TESTING AND SITE EVALUATION

TEST DATE(S) \_\_\_\_\_ TEST TIME \_\_\_\_\_

AD 520126-f

AGENCY REVIEW: \_\_\_\_\_

DATE 3/31/2004

DO NOT WRITE ABOVE THIS LINE

I HEREBY APPLY FOR THE NECESSARY TESTING/EVALUATION PRIOR TO ISSUANCE OF SEWAGE DISPOSAL SYSTEM PERMIT(S) TO:

CHECK AS NEEDED:

CHECK AS NEEDED:

- CONSTRUCT NEW SEPTIC SYSTEM(S)
- REPAIR/ADD TO AN EXISTING SEPTIC SYSTEM
- REPLACE AN EXISTING SEPTIC SYSTEM

- NEW STRUCTURE(S)
- ADDITION TO AN EXISTING STRUCTURE
- REPLACE AN EXISTING STRUCTURE

CHECK ONE:

IS THE PROPERTY WITHIN 2500' OF ANY RESERVOIR?

- CREATE NEW LOT(S)
- BUILD ON AN EXISTING LOT IN A SUBDIVISION
- BUILD ON AN EXISTING PARCEL OF RECORD

- YES
- NO

THE TYPE OF STRUCTURE IS:

- RESIDENTIAL WITH UNKNOWN PROPOSED BEDROOMS IN THE COMPLETED STRUCTURE (NOTE UNKNOWN IF APPROPRIATE)
- COMMERCIAL (PROVIDE DETAIL OF NUMBERS AND TYPES OF EMPLOYEES/ CUSTOMERS ON ACCOMPANYING PLAN)
- INSTITUTIONAL/GOVERNMENT (PROVIDE DETAIL OF NUMBERS AND TYPES OF EMPLOYEES/USERS ON ACCOMPANYING PLAN)

PROPERTY OWNER(S) 32 40 Partnership % Harry B. Cooper & Associates

DAYTIME PHONE \_\_\_\_\_ CELL \_\_\_\_\_ FAX \_\_\_\_\_

MAILING ADDRESS 10749 FALLS RD. #202 LUTHERVILLE MD 21093-7013  
STREET CITY/TOWN STATE ZIP

APPLICANT ESH Associates % Zach Fisch

DAYTIME PHONE (410) 750-2251 CELL \_\_\_\_\_ FAX (410) 750-7350

MAILING ADDRESS 8318 Forrest St. Ellicott City MD 21043  
STREET CITY/TOWN STATE ZIP

APPLICANT'S ROLE: DEVELOPER BUILDER BUYER RELATIVE/FRIEND REALTOR CONSULTANT

PROPERTY LOCATION  
SUBDIVISION/PROPERTY NAME 32 40 partnership LOT NO. 7

PROPERTY ADDRESS N Route 144 West Friendship 21794  
STREET TOWN/POST OFFICE

TAX MAP PAGE(S) 15 GRID 11 PARCEL(S) 72 PROPOSED LOT SIZE 1 Ac.

AS APPLICANT, I UNDERSTAND THE FOLLOWING: THE SYSTEM INSTALLED SUBSEQUENT TO THIS APPLICATION IS ACCEPTABLE ONLY UNTIL PUBLIC SEWERAGE IS AVAILABLE. THIS APPLICATION IS COMPLETE WHEN ALL APPLICABLE FEES AND A SUITABLE SITE PLAN HAVE BEEN RECEIVED. I ACCEPT THE RESPONSIBILITY FOR COMPLIANCE WITH ALL M.O.S.H.A. AND "MISS UTILITY" REQUIREMENTS. APPROVAL IS BASED UPON SATISFACTORY REVIEW OF A PERC CERTIFICATION PLAN.


TEST RESULTS WILL BE MAILED TO APPLICANT. Zacharia Y. Fisch  
SIGNATURE OF APPLICANT

HOWARD COUNTY HEALTH DEPARTMENT, BUREAU OF ENVIRONMENTAL HEALTH, WELL AND SEPTIC PROGRAM  
3525-H ELLICOTT MILLS DRIVE, ELLICOTT CITY, MARYLAND 21043-4544 (410) 313-1771 FAX (410) 313-2648  
TDD (410) 313-2323 TOLL FREE 1-877-4MD-DHMH

633  
 heavy orange brown micaceous SiCL  
 5  
 fine damp micaceous SL w/ 20-30%  
 6 water

632  
 heavy orange brown SiCL  
 5  
 orange brown micaceous L  
 8  
 orange brown micaceous SL w/ < 5% weak sp  
 13

634  
 heavy orange brown SiCL w/ < 10% coarse sand  
 6 1/2  
 orange brown fine SL  
 13

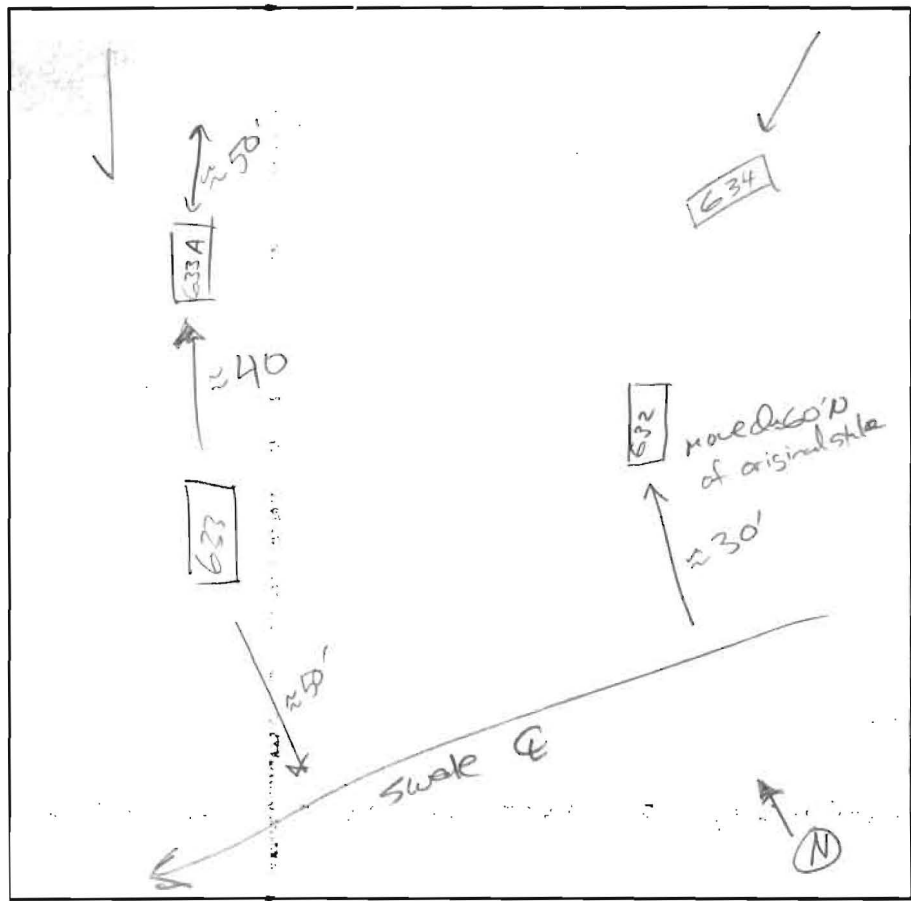


633A  
 orange brown SiCL  
 2  
 orange brown CWL  
 4  
 orange brown micaceous SL  
 13

633B  
 SiCL  
 ↓  
 ↓  
 5  
 orange brown SL  
 8

DATE	TEST #	DEPTH	START	BREAK 1" DROP	STOP 2" DROP	TIME OF 2ND INCH	P/F/H
5/11/04	633	10V	insuf.	perm. material			F
	632	6/13	11:18	11:22	11:32	10	P
	634	6/13	11:22	stopped @ 11:46	1/8" mud		F
	634	7 1/2/13	11:54	12:01	12:12	11	P
	633A	5 1/2/13	12:12	12:15	12:22	7	P
7/16/04	633B	8V	Auger				

REMARKS 635 see 629, 631 see 627, did not dig 631 [633B Auger]  
 SANITARIAN J. Boris BACKHOE Level Land OTHERS P. Revell  
 TEST HOLES USED IN SDA \_\_\_\_\_ AVG. PERC TIME \_\_\_\_\_ SQ. FT/BR \_\_\_\_\_  
 TRENCH WIDTH \_\_\_\_\_ INLET DEPTH \_\_\_\_\_ MAX. BOT DEPTH \_\_\_\_\_ EFFECTIVE SW \_\_\_\_\_

Signed per cert  
1/22/07

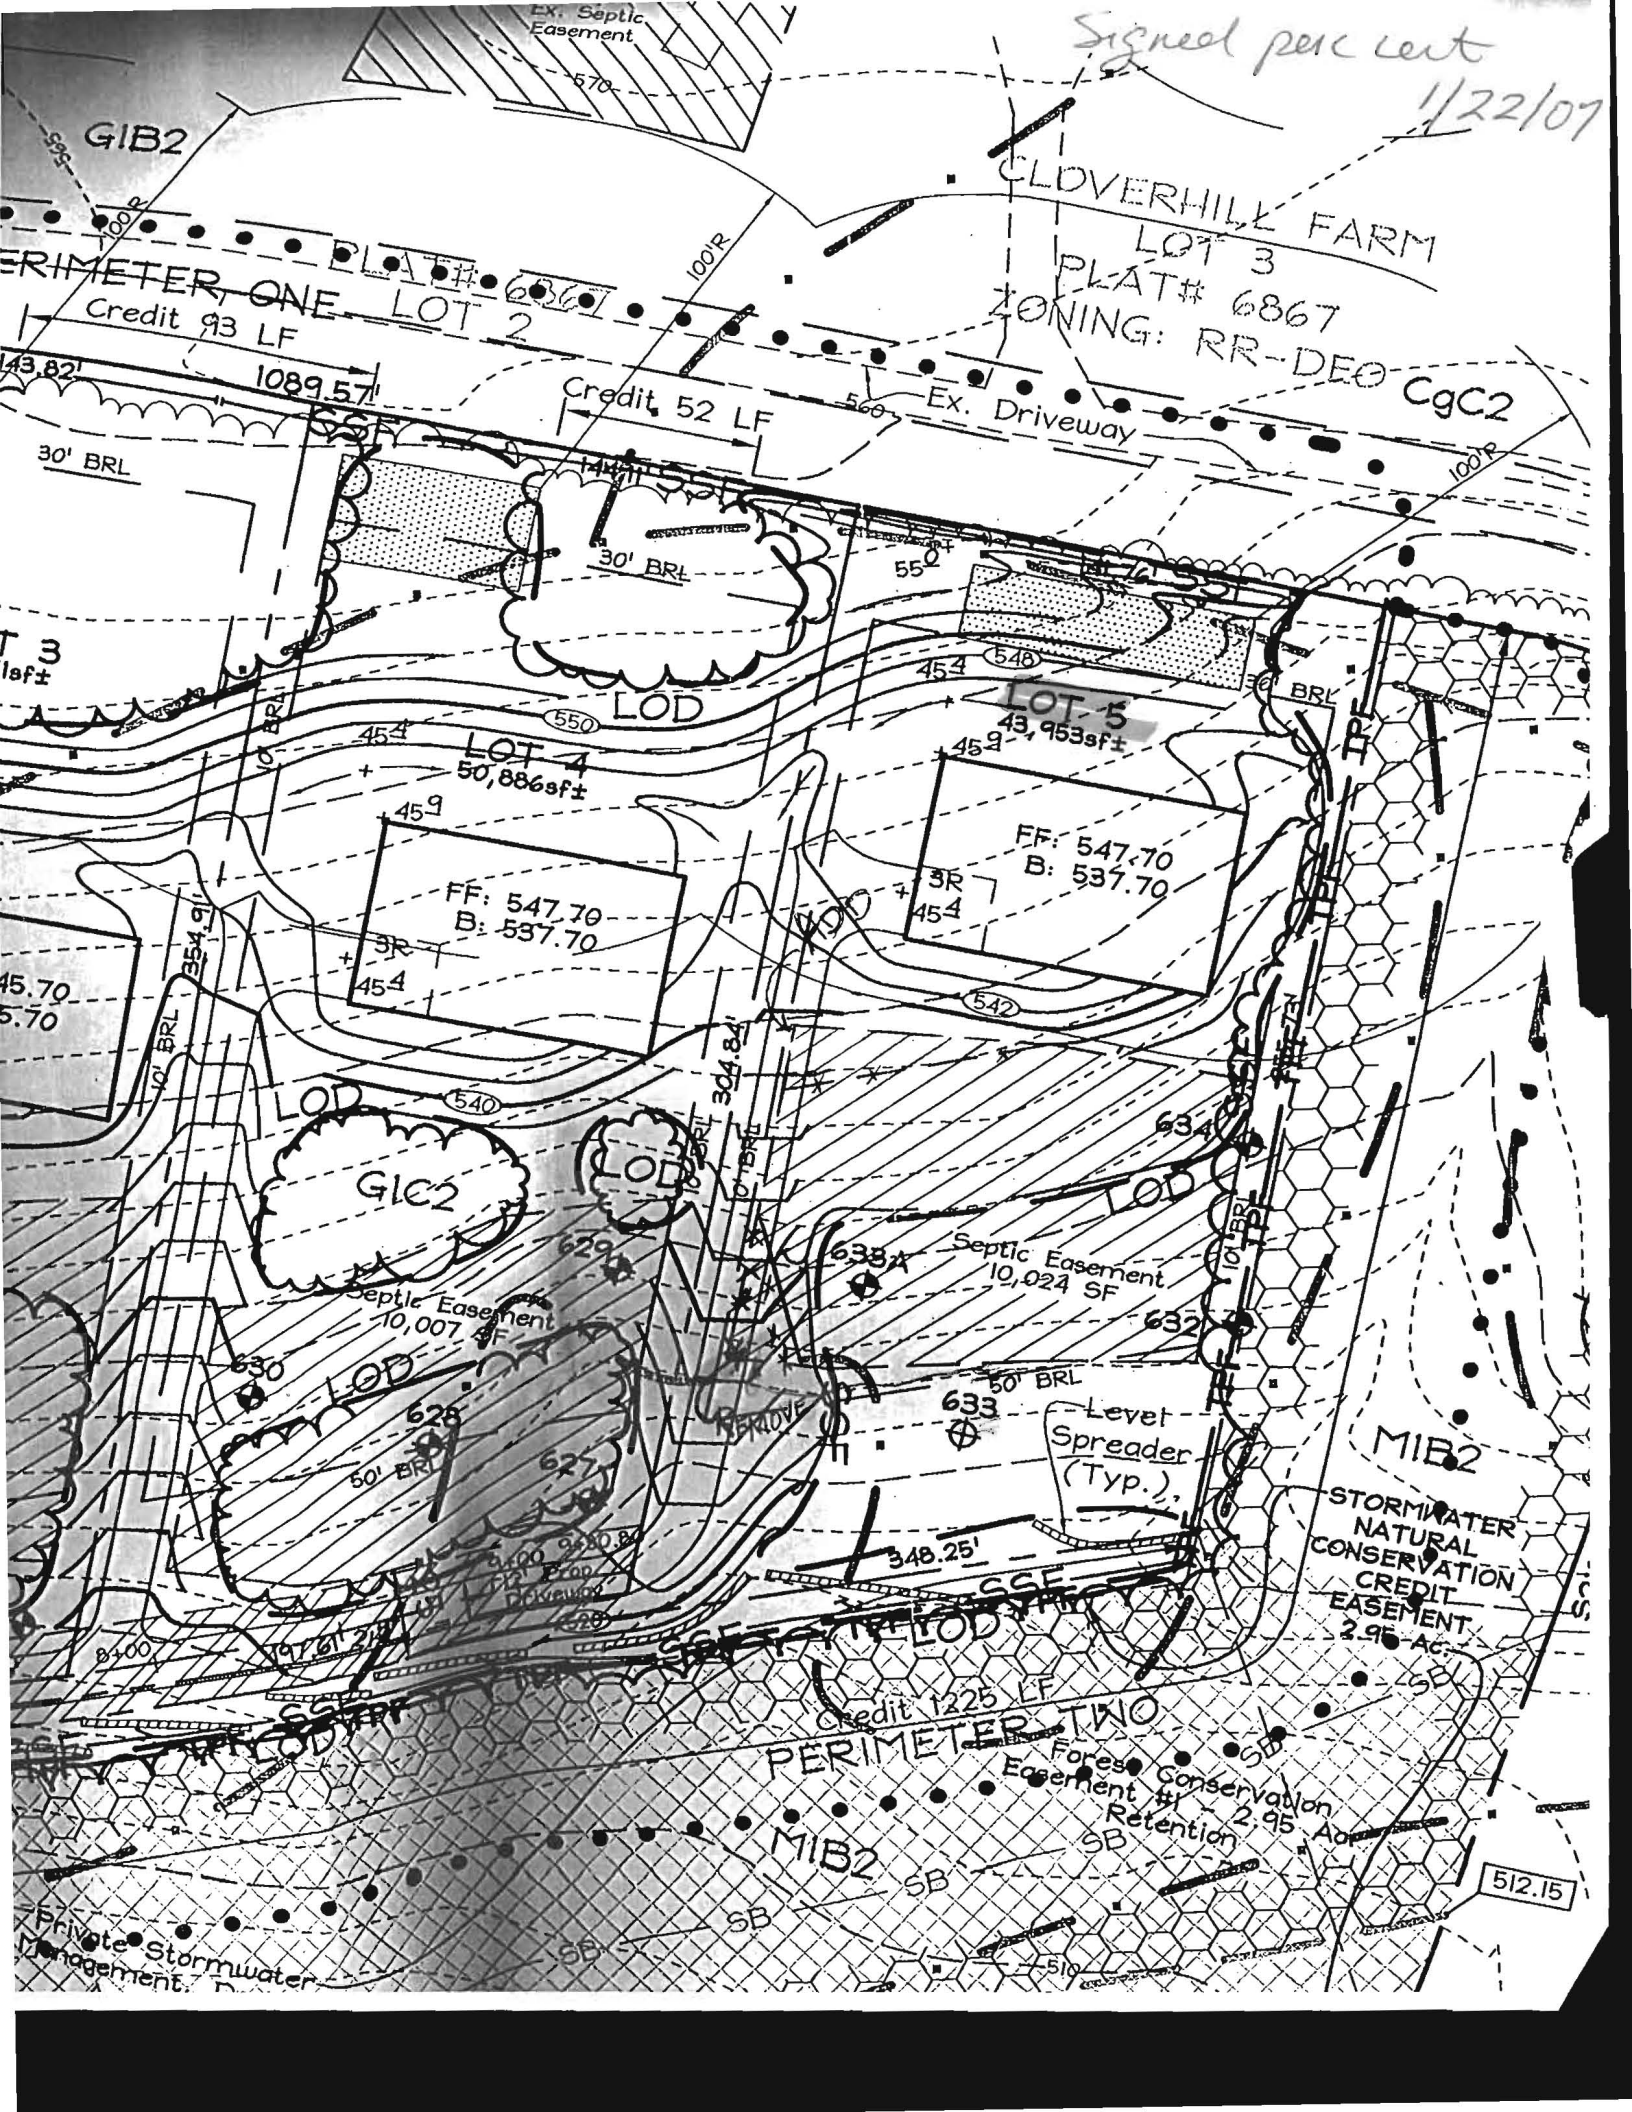

GIB2

CLOVERHILL FARM  
LOT 3  
PLAT# 6867

ZONING: RR-DEO CgC2

PERIMETER ONE LOT 2

Credit 52 LF

Credit 93 LF

Ex. Driveway

30' BRL

30' BRL

LOD

LOT 4  
50,886sf±

LOT 5  
43,953sf±

FF: 547.70  
B: 537.70

FF: 547.70  
B: 537.70

GIC2

Septic Easement  
10,024 SF

Septic Easement  
10,024 SF

Level Spreader  
(Typ.)

MIB2

STORMWATER  
NATURAL  
CONSERVATION  
CREDIT  
EASEMENT  
2.95 Ac

PERIMETER TWO


MIB2

512.15

Private Stormwater  
Management

Forest Conservation  
Retention  
2.95 Ac

Signal  
Pre-lin  
6/3/05

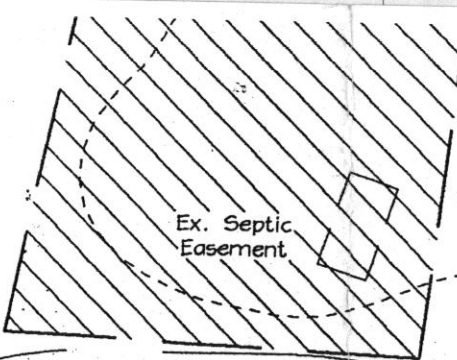

CLOVERHILL FARM  
LOT 3  
PLAT# 6867  
ZONING: RR-DEO

PLAT# 6867  
PERIMETER ONE LOT 2









Credit 615 LF

LOT 2  
51,318sf±

LOT 3  
55,533sf±

LOT 4  
51,310sf±

LOT 5  
44,367sf±

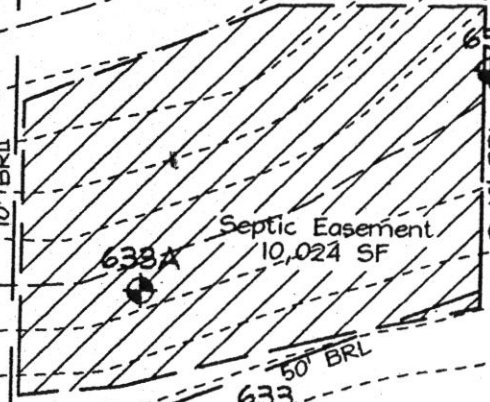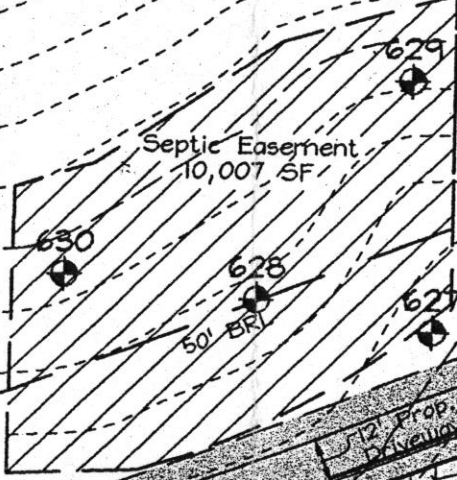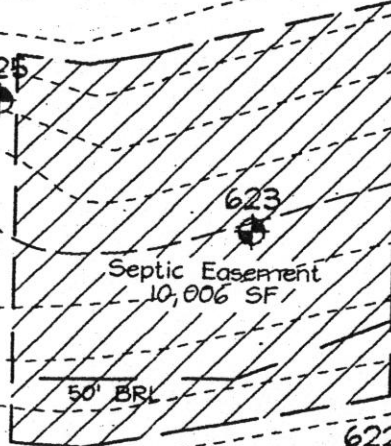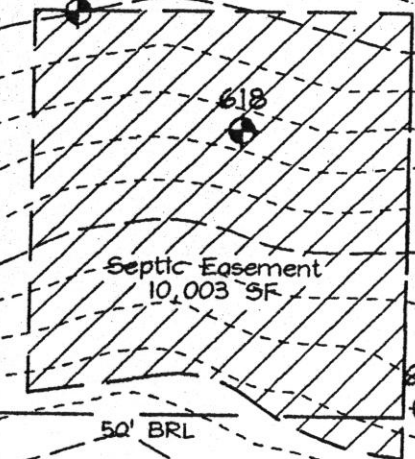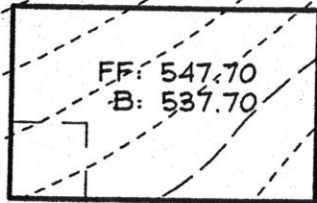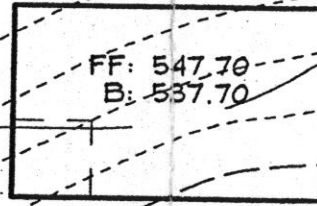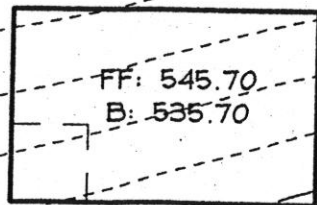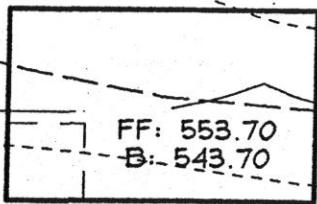

24' Private Use-in-Common Access Easement For Lots 2-5 and Parcel 'B'

