

HOWARD COUNTY
PERMIT APPLICATION

PERMIT NUMBER

307000873

Building Address 11412 BARLEY FIELD WAY
MARIOTTSVILLE, MD. 21104

Property Owner's Name TIMOTHY W. PRAGER

Suite/Apt. #: _____ SDP/WP/Petition #: _____

Address 11412 BARLEY FIELD WAY

Census Tract _____ Subdivision _____

City MARIOTTSVILLE State MD Zip Code 21104

Section _____ Area _____ Lot _____

Home Phone _____ Work Phone 443-677-7364

Tax Map _____ Parcel _____ Grid _____

Applicant's Name & Mailing Address, (if other than stated hereon):

Zoning _____ Map Coordinates _____ Lot size _____

Phone _____ Fax _____

Existing Use _____

Contractor Company SELF

Proposed Use _____

Contact Person _____

Estimated Construction Cost \$ 40,000.00

Description of Work 24 X 42' GARAGE

Address _____

Occupant or Tenant _____

Engineer or Architect Company _____

Contact Name TIMOTHY W. PRAGER

Contact Person _____

Address 11412 BARLEY FIELD WAY

Address _____

City MARIOTTSVILLE State MD Zip Code 21104

City _____ State _____ Zip Code _____

Phone 443-677-7364 Fax _____

Phone _____ Fax _____

BUILDING DESCRIPTION - COMMERCIAL

BUILDING DESCRIPTION - RESIDENTIAL

Building Characteristics

Utilities

Height: _____
No. of stories: _____
Gross area, sq. ft. per floor: _____
Use group: _____
Construction type:
 Reinforced Concrete
 Structural Steel
 Masonry
 Wood Frame
 State Certified Modular

Water Supply:
 Public
 Private
Sewage Disposal:
 Public
 Private
Electric Yes No
Gas Yes No
Heating System:
Electric Oil
Natural Gas
Propane Gas
Sprinkler system: N/A
 Full
 Partial
 Other Suppression
 # of Heads

Building Characteristics

Utilities

SF Dwelling SF Townhouse
Depth _____ Width _____
1st floor: _____
2nd floor: _____
Basement: _____
Finished Basement Unfinished Basement
Crawl space Slab on Grade
No. of Bedrooms: _____
Height: _____
Multi-family dwellings:
No. of efficiency units: _____
No. of 1 BR units: _____
No. of 2 BR units: _____
No. of 3 BR units: _____
Other Structure: _____
Dimensions: _____
Footings: _____
Roof Height: _____
 State Certified Modular
 Manufactured Home

Water Supply:
 Public
 Private
Sewage Disposal:
 Public
 Private
Electric Yes No
Gas Yes No
Heating System:
Electric Oil
Natural Gas
Propane Gas
Sprinkler system: N/A
 NFPA #13D
 NFPA #13R
 Other:

THE UNDERSIGNED HEREBY CERTIFIES AND AGREES AS FOLLOWS: (1) THAT HE/SHE IS AUTHORIZED TO MAKE THIS APPLICATION; (2) THAT THE INFORMATION IS CORRECT; (3) THAT HE/SHE WILL COMPLY WITH ALL REGULATIONS OF HOWARD COUNTY WHICH ARE APPLICABLE THERETO; (4) THAT HE/SHE WILL PERFORM NO WORK ON THE ABOVE REFERENCED PROPERTY NOT SPECIFICALLY DESCRIBED IN THIS APPLICATION; (5) THAT HE/SHE GRANTS COUNTY OFFICIALS THE RIGHT TO ENTER ONTO THIS PROPERTY FOR THE PURPOSE OF INSPECTING THE WORK PERMITTED AND POSTING NOTICES.

Timothy W. Prager
Applicant's Signature
OWNER
Title/Company

TIMOTHY W. PRAGER
Print Name
3-16-07
Date

Checks payable to: **DIRECTOR OF FINANCE OF HOWARD COUNTY**
** PLEASE WRITE NEATLY AND LEGIBLY. **
- FOR OFFICE USE ONLY -

AGENCY	DATE	SIGNATURE APPROVAL	DPZ SETBACK INFORMATION	PROPERTY ID#
Land Development, DPZ			Front: _____ Filing fee \$ _____	
State Highways			Rear: _____ Permit fee \$ _____	
Building Official			Side: _____ Excise tax \$ _____	
Dev. Engineering, DPZ	<u>3/16/07</u>	<u>[Signature]</u>	Side St.: _____ Add'l per. fee \$ _____	
Health			All minimum setbacks met? YES <input type="checkbox"/> NO <input type="checkbox"/>	
Fire Protection			Is Entrance Permit required? YES <input type="checkbox"/> NO <input type="checkbox"/>	
Is Sediment Control approval required prior to issuance?			Historic District? YES <input type="checkbox"/> NO <input type="checkbox"/>	
YES <input type="checkbox"/> NO <input type="checkbox"/>			Lot Coverage for NewTown Zone _____	
CONTINGENCY CONSTRUCTION START: <input type="checkbox"/>			SDP/Red-line approval date _____	Accepted by _____
ONE STOP SHOP: <input type="checkbox"/>				
Distribution of Copies -	White: Building Official	Green: LDD, DPZ	Yellow: DED, DPZ	Pink: Health
T:\forms\PERMIT.FRM				Gold: SHA

APPROVED

WALK-THRU BUILDING PERMIT


BP# 307000873 A# 57555-A

APP. SAN SFD DATE: 3/16/07

DESC. OF WORK: Detached Garage

PRESERVATION PARCEL A

10' Wide Tree Maintenance Easement

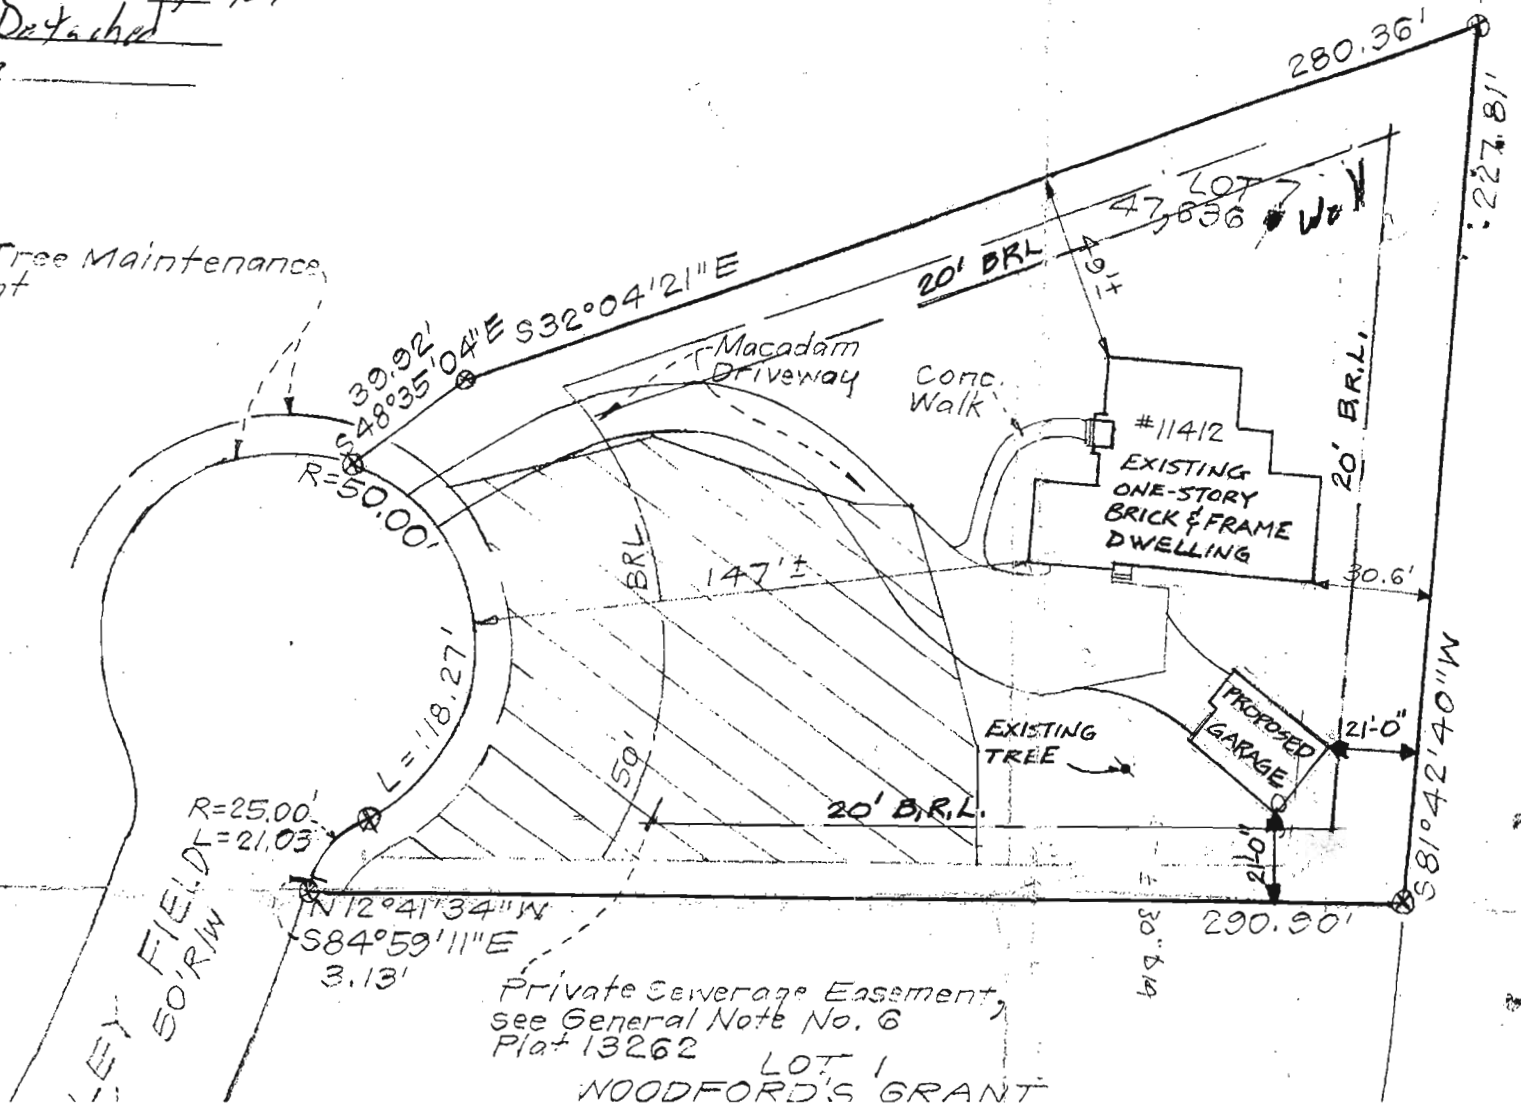

Private Sewerage Easement,
see General Note No. 6
Plat 13262 LOT 1
WOODFORD'S GRANT

