

"RIR"

APPLICATION

FOR PERCOLATION TESTING AND SITE EVALUATION

TEST DATE(S) _____ TEST TIME _____ A/P _____

AGENCY REVIEW: _____ DATE _____

DO NOT WRITE ABOVE THIS LINE

I HEREBY APPLY FOR THE NECESSARY TESTING/EVALUATION PRIOR TO ISSUANCE OF SEWAGE DISPOSAL SYSTEM PERMIT(S) TO:

CHECK AS NEEDED:

- CONSTRUCT NEW SEPTIC SYSTEM(S)
- REPAIR/ADD TO AN EXISTING SEPTIC SYSTEM
- REPLACE AN EXISTING SEPTIC SYSTEM

CHECK AS NEEDED:

- NEW STRUCTURE(S)
- ADDITION TO AN EXISTING STRUCTURE
- REPLACE AN EXISTING STRUCTURE

CHECK ONE:

- CREATE NEW LOT(S)
- BUILD ON AN EXISTING LOT IN A SUBDIVISION
- BUILD ON AN EXISTING PARCEL OF RECORD

IS THE PROPERTY WITHIN 2500' OF ANY RESERVOIR?

- YES
- NO

THE TYPE OF STRUCTURE IS:

- RESIDENTIAL WITH _____ PROPOSED BEDROOMS IN THE COMPLETED STRUCTURE (NOTE **UNKNOWN** IF APPROPRIATE)
- COMMERCIAL (PROVIDE DETAIL OF NUMBERS AND TYPES OF EMPLOYEES/ CUSTOMERS ON ACCOMPANYING PLAN)
- INSTITUTIONAL/GOVERNMENT (PROVIDE DETAIL OF NUMBERS AND TYPES OF EMPLOYEES/USERS ON ACCOMPANYING PLAN)

PROPERTY OWNER(S) _____

DAYTIME PHONE _____ CELL _____ FAX _____

MAILING ADDRESS _____
STREET CITY/TOWN STATE ZIP

APPLICANT _____

DAYTIME PHONE _____ CELL _____ FAX _____

MAILING ADDRESS _____
STREET CITY/TOWN STATE ZIP

APPLICANT'S ROLE: DEVELOPER BUILDER BUYER RELATIVE/FRIEND REALTOR CONSULTANT

PROPERTY LOCATION
SUBDIVISION/PROPERTY NAME 032/40 Partnership LOT NO. 3

PROPERTY ADDRESS _____
STREET TOWN/POST OFFICE

TAX MAP PAGE(S) _____ GRID _____ PARCEL(S) _____ PROPOSED LOT SIZE _____

AS APPLICANT, I UNDERSTAND THE FOLLOWING: THE SYSTEM INSTALLED SUBSEQUENT TO THIS APPLICATION IS ACCEPTABLE ONLY UNTIL PUBLIC SEWERAGE IS AVAILABLE. THIS APPLICATION IS COMPLETE WHEN ALL APPLICABLE FEES AND A SUITABLE SITE PLAN HAVE BEEN RECEIVED. I ACCEPT THE RESPONSIBILITY FOR COMPLIANCE WITH ALL M.O.S.H.A. AND "MISS UTILITY" REQUIREMENTS. APPROVAL IS BASED UPON SATISFACTORY REVIEW OF A PERC CERTIFICATION PLAN.

TEST RESULTS WILL BE MAILED TO APPLICANT. _____
SIGNATURE OF APPLICANT


HOWARD COUNTY HEALTH DEPARTMENT, BUREAU OF ENVIRONMENTAL HEALTH, WELL AND SEPTIC PROGRAM
3525-H ELLICOTT MILLS DRIVE, ELLICOTT CITY, MARYLAND 21043-4544 (410) 313-1771 FAX (410) 313-2648
TDD (410) 313-2323 TOLL FREE 1-877-4MD-DHMH

A/P

607
Brown
orange
rooted
L
Orange
brown
mizusidus
SL
Orange
brown
mizusidus
LS

606
orange
brown
rooted
L
orange
brown
mizusidus
SL
4/20-30%
coarse
frags

608
Orange
brown
SCL
Orange
brown
mizusidus
L
Orange
brown
mizusidus
SL
4/25%
coarse
frags

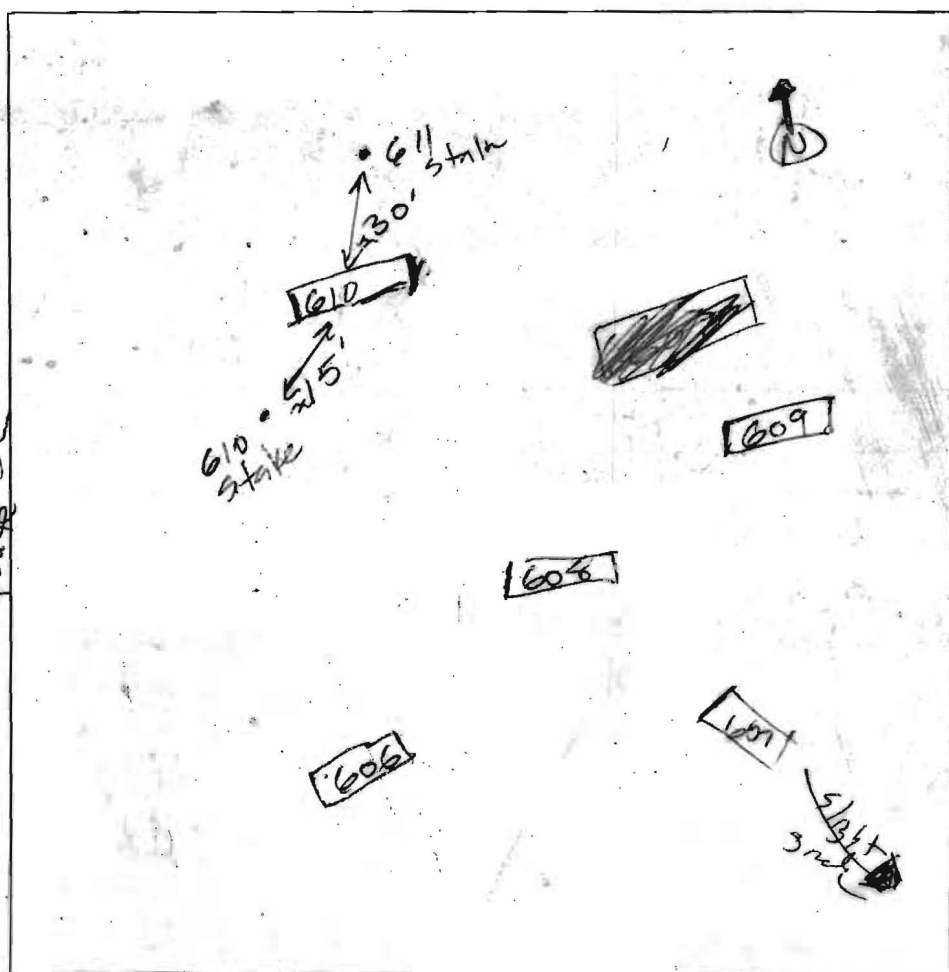


609
brown
rooted
SCL
orange
brown
SCL
orange
brown
mizusidus
SL
4/20-30%
mizusidus
frags on
End of
note

610
red
orange
rooted
SCL
red orange
mizusidus
L
red orange
mizusidus
SL

DATE	TEST #	DEPTH	START	BREAK 1" DROP	STOP 2" DROP	TIME OF 2nd INC	P/11
4/26/04	607	5 / 12	9:49	9:49	9:52	3	P
4/26/04	606	4 / 13	9:55	9:56	9:59	3	P
4/26/04	608	14V	0.2	0 3 1/2		2-7	P
4/26/04	609	4 / 13	10:04	10:05.30	10:08	2:30	P
4/26/04	610	4 / 14	10:06	10:12	10:22	10	P

REMARKS holes dug per plan unless marked share 610 on Lots 2+3
 SANITARIAN J. Boris BACKHOE Level Land OTHERS P. Reulle
 TEST HOLES USED IN SDA _____ AVG. PERC TIME _____ SQ. FT/BR _____
 TRENCH WIDTH _____ INLET DEPTH _____ MAX. BOT DEPTH _____ EFFECTIVE SWW _____

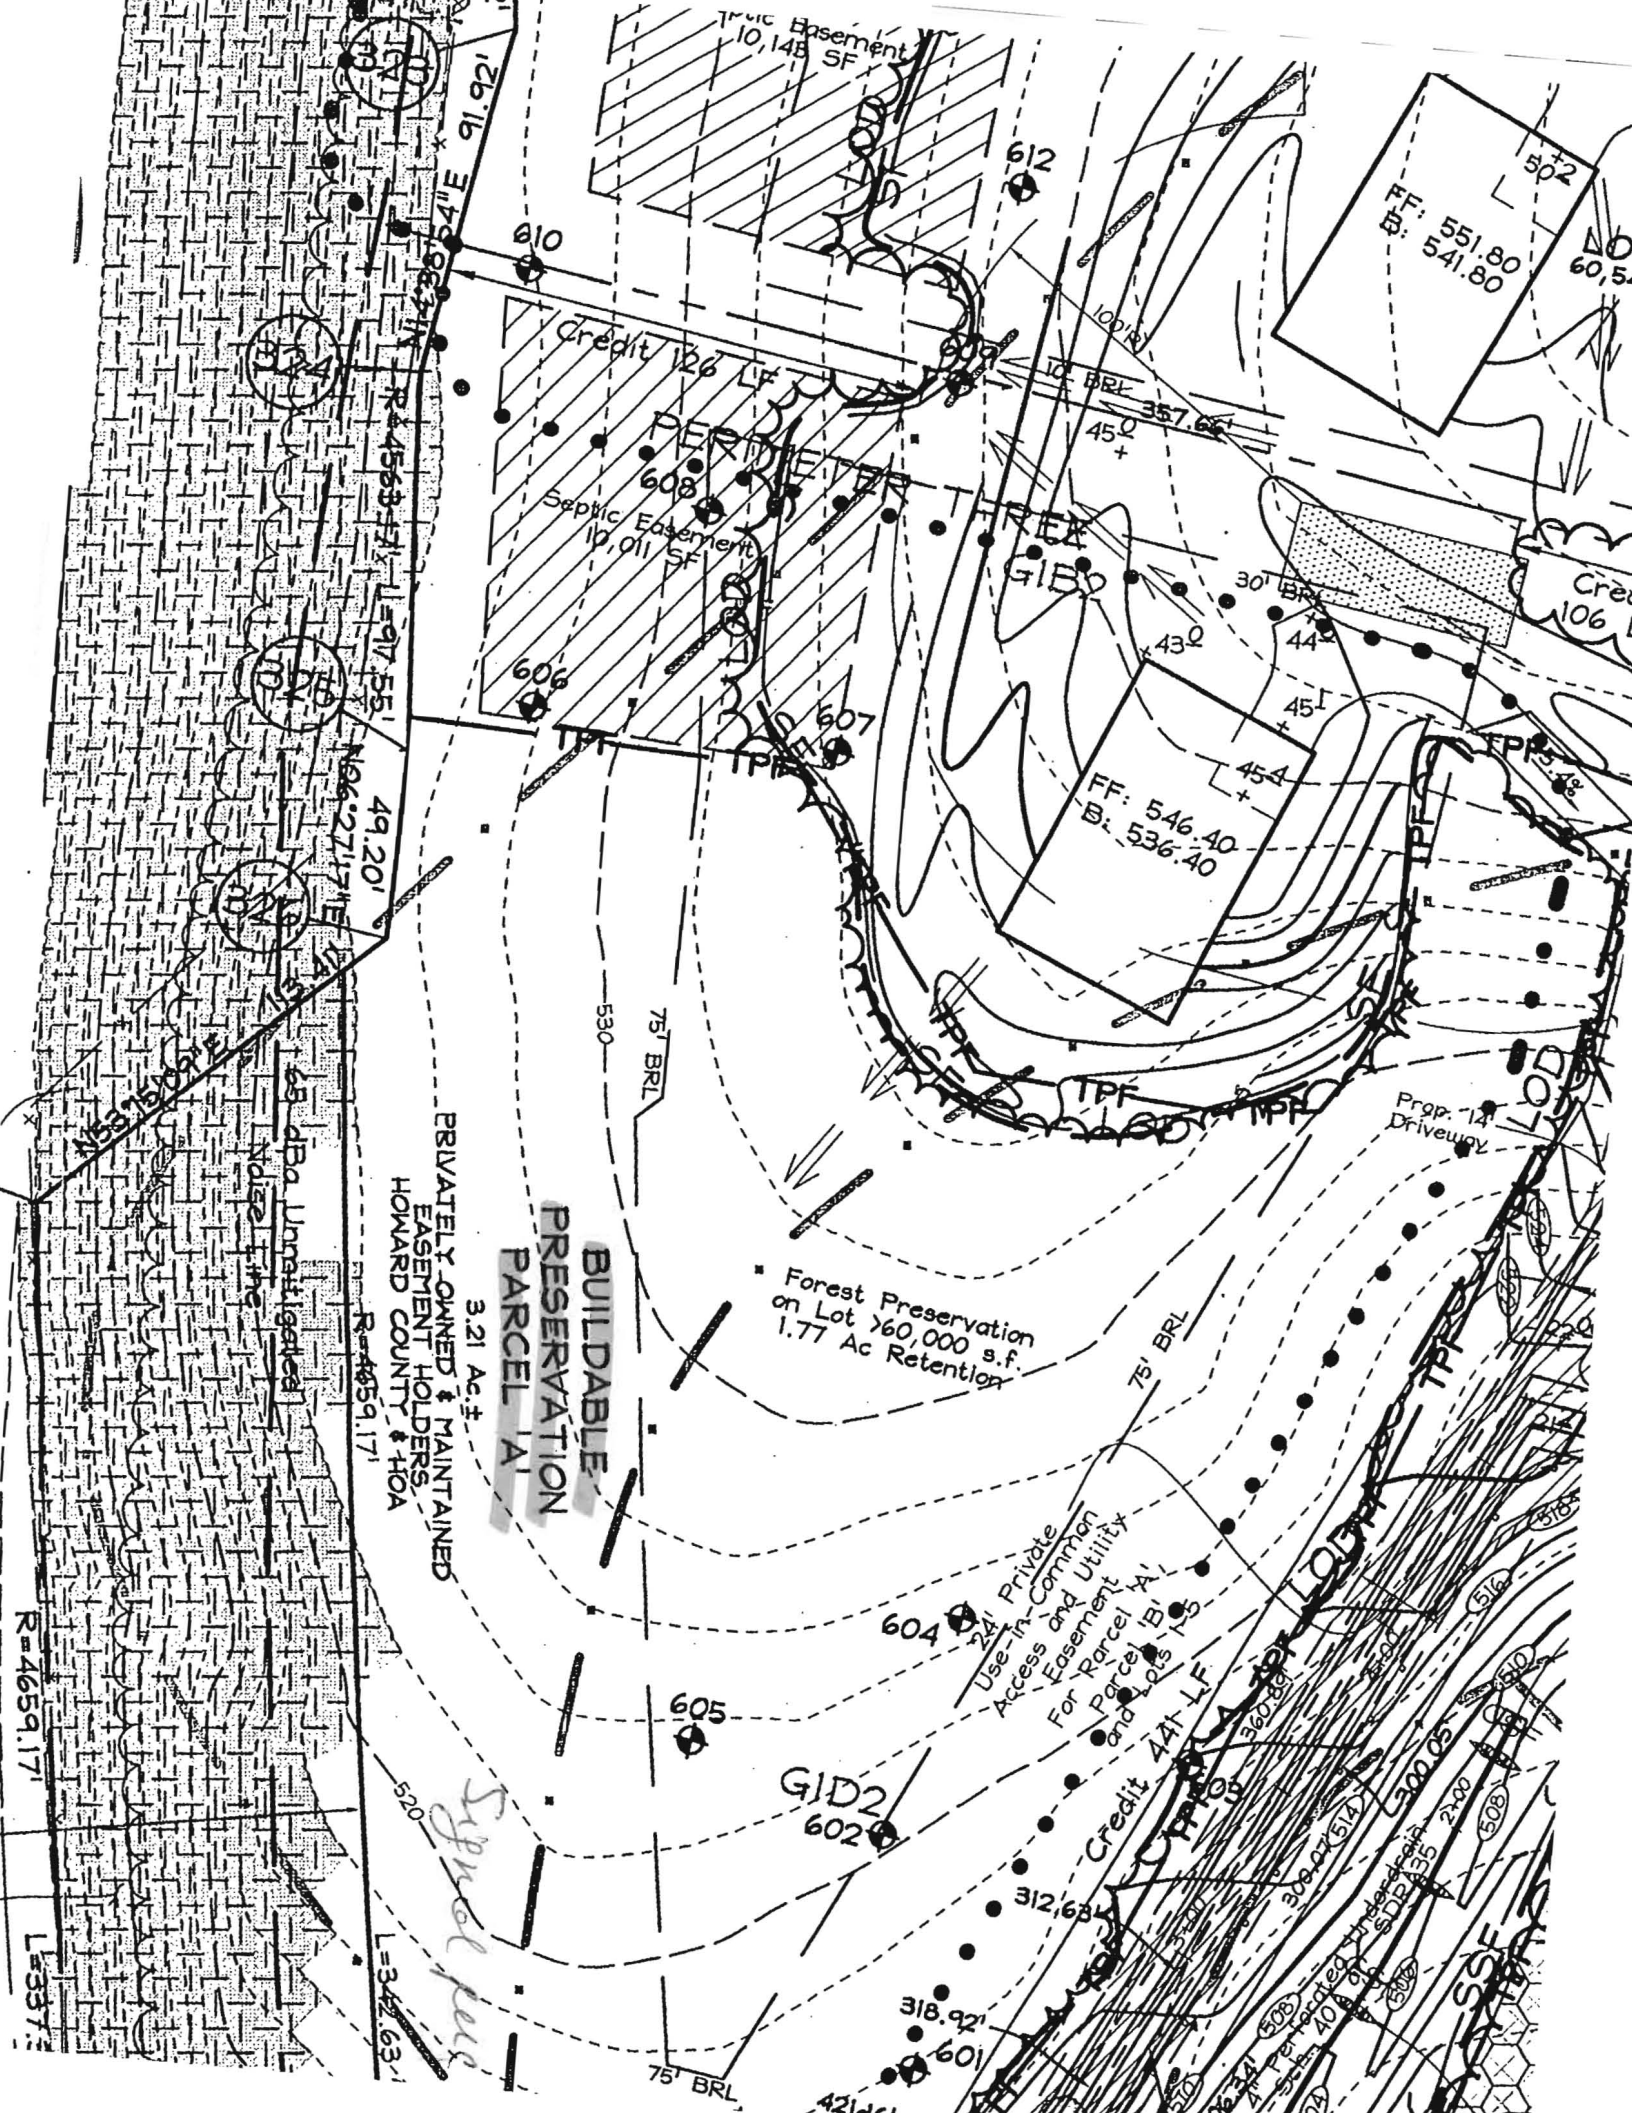

Public Easement
10,148 SF

FF: 551.80
B: 541.80

Credit 126 LF

Septic Easement
10,011 SF

FF: 546.40
B: 536.40

Forest Preservation
on Lot 760,000 s.f.
1.77 Ac Retention

**BUILDBLE
PRESEVATION
PARCEL A1**

3.21 Ac.±
PRIVATELY OWNED & MAINTAINED
EASEMENT HOLDERS
HOWARD COUNTY & HOA

24' Private
Use-in-Common
Easement and Utility
Access For Parcel A1
and Lots 605-610

Credit 441 LF

Signal path

R=4659.17'

L=337.3'

Signal Palom
6/3/05

SYKESVILLE ROAD
MARYLAND ROUTE 32
(PRINCIPAL ARTERIAL)

Vehicular Ingress and Egress is Restricted


FUTURE R/W
150'

Steep Slope =
Area on site of
30418.668 Acft
or
0.668 Acft

BUILDABLE PRESERVATION PARCEL 'A'

3.47 Ac.±
PRIVATELY OWNED & MAINTAINED
EASEMENT HOLDERS
HOWARD COUNTY & HOA

PERMETER THREE

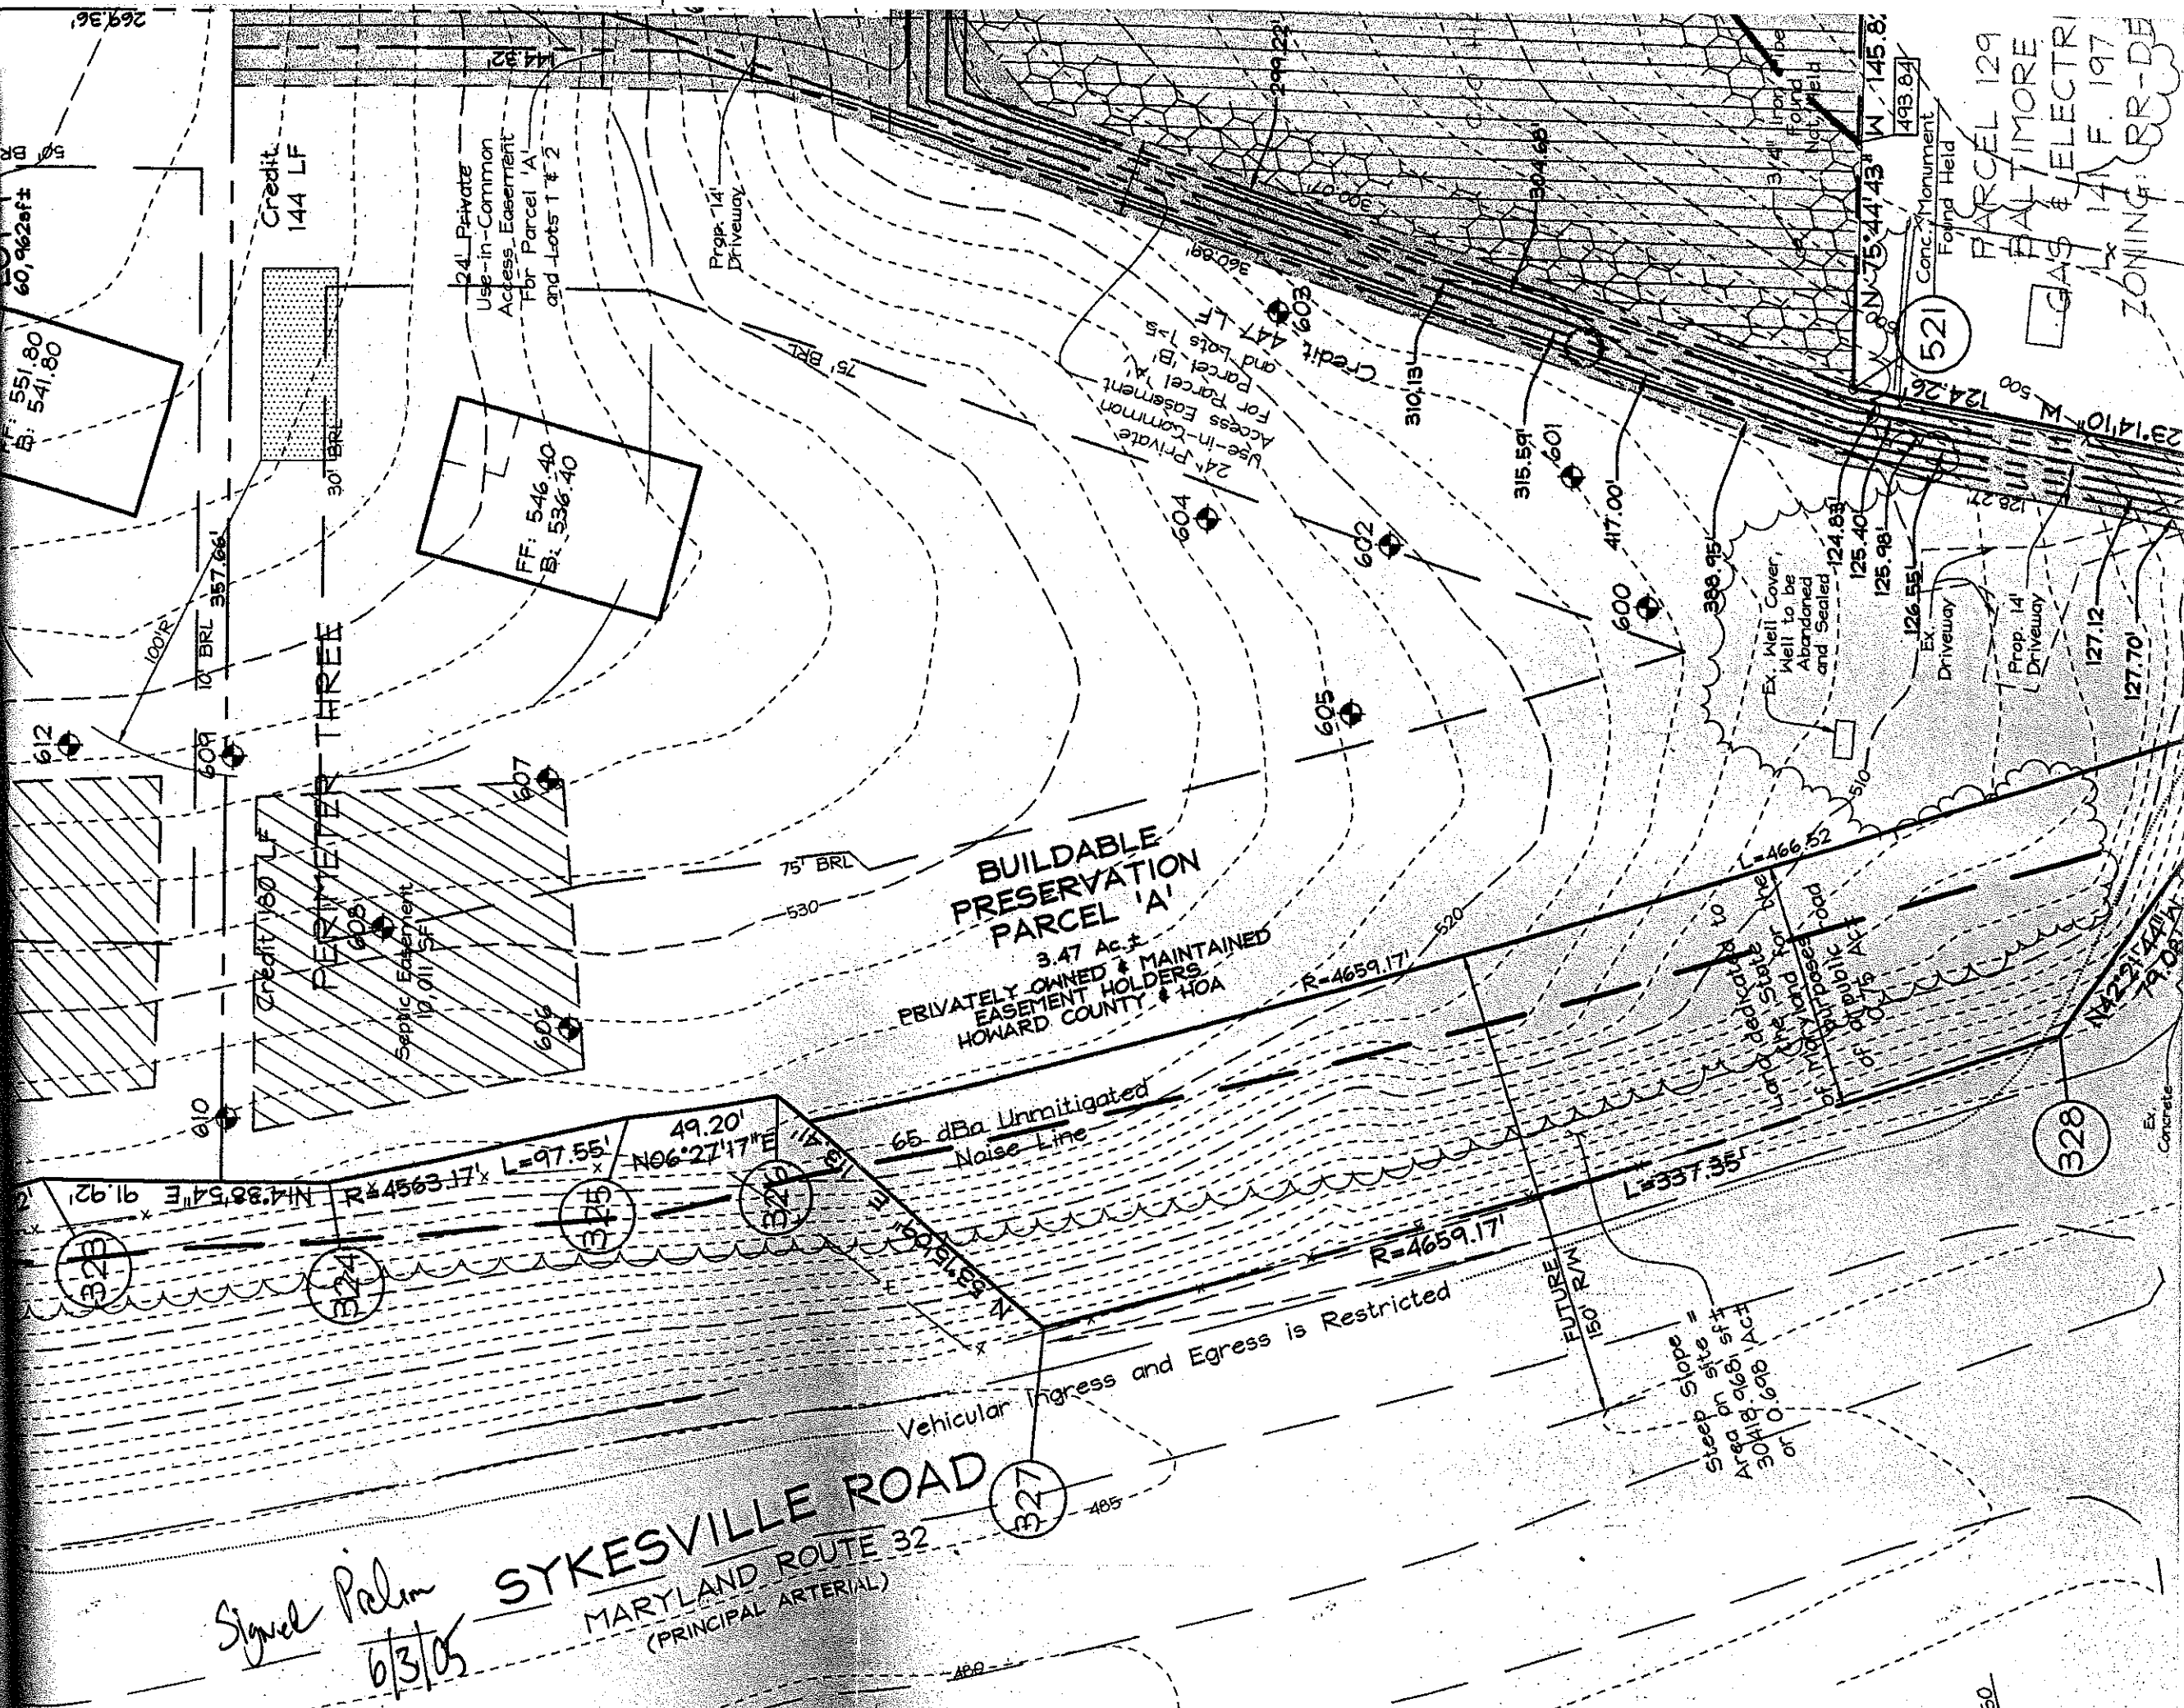

521

328

Parcel 129
BALTIMORE
GAS & ELECTRIC
F. 197
ZONING: RR-DE

269.36'

FF: 551.80
B: 541.80

Credit 144 LF

FF: 546.40
B: 536.40

24' Private Use-in-Common Access Easement For Parcel 'A' and Lots 1 & 2

Prop. 14 Driveway

24' Private Use-in-Common Access Easement For Parcel 'A' and Lots 1-5

Credit 447 LF

Ex. Well Cover, Well to be Abandoned and Sealed

Prop. 14 Driveway

Prop. 14 Driveway