

LAYOUT 3/29/10 INSP 4 4/5/10  
 INSP 2 4/1/10 INSP 5 \_\_\_\_\_  
 INSP 3 4/2/10 INSP 6 \_\_\_\_\_

ISSUE DATE: \_\_\_\_\_

# PERMIT

P 532571

APPROVAL DATE: 4/8/2010

Tax ID # 05445485

A 517386

**ON-SITE SEWAGE DISPOSAL SYSTEM  
 HOWARD COUNTY HEALTH DEPARTMENT  
 BUREAU OF ENVIRONMENTAL HEALTH**

WTC III IS PERMITTED TO INSTALL  ALTER

ADDRESS: 1820 GILLIS FALL RD 21797 PHONE NUMBER: 443-398-1782

SUBDIVISION: Fulton Ridge LOT NUMBER: 8

ADDRESS: 12134 Fulton Ridge Drive PROPERTY OWNER: Curtis Campbell

SEPTIC TANK CAPACITY (GALLONS): 2000 OUTLET BAFFLE FILTER REQUIRED

PUMP CHAMBER CAPACITY (GALLONS): \_\_\_\_\_ COMPARTMENTED TANK REQUIRED

NUMBER OF BEDROOMS: 4 APPLICATION RATE: 1.2

SQUARE FOOTAGE OF HOUSE: +3501  
 LINEAR FEET OF TRENCH REQUIRED: 110  
*Trenches can be 4'-6'.  
 Future downhill systems  
 should be shallower.*


TRENCHES:	Trenches to be 3.0 feet wide. Inlet 3.0 feet below original grade. Bottom maximum depth 5.0 feet below grade. Effective area begins at 3.0 feet below original grade. 2.0 feet of stone below distribution pipe.
LOCATION:	1. Set septic tank per approved plan. 2. Possible trench installation a 45' trench and a 65' trench on contour at high parts of SDA.
NOTES:	SDA must be staked by surveyor. Trench inlet may be raised 6" if possible.

PLANS APPROVED: Kevin Wolf DATE: 9/15/09

- NOTE: PERMIT VOID AFTER 2 YEARS
- NOTE: CONTRACTOR RESPONSIBLE FOR SCHEDULING A PRE-CONSTRUCTION INSPECTION FOR ALL INSTALLATIONS
- NOTE: WATERTIGHT SEPTIC TANKS REQUIRED
- NOTE: ALL PARTS OF SEPTIC SYSTEM SHALL BE 100 FEET FROM ANY WATER WELL
- NOTE: MANHOLE RISERS REQUIRED ON ALL SEPTIC TANKS AND PUMP CHAMBERS

**NEITHER THE HOWARD COUNTY COUNCIL OR THE HEALTH DEPARTMENT IS  
 RESPONSIBLE FOR THE SUCCESSFUL OPERATION OF ANY SYSTEM  
 PERMITTEE RESPONSIBLE FOR OBTAINING FINAL APPROVAL ON THIS PERMIT  
 CALL 410-313-1771 FOR INSPECTION OF SEPTIC SYSTEM**



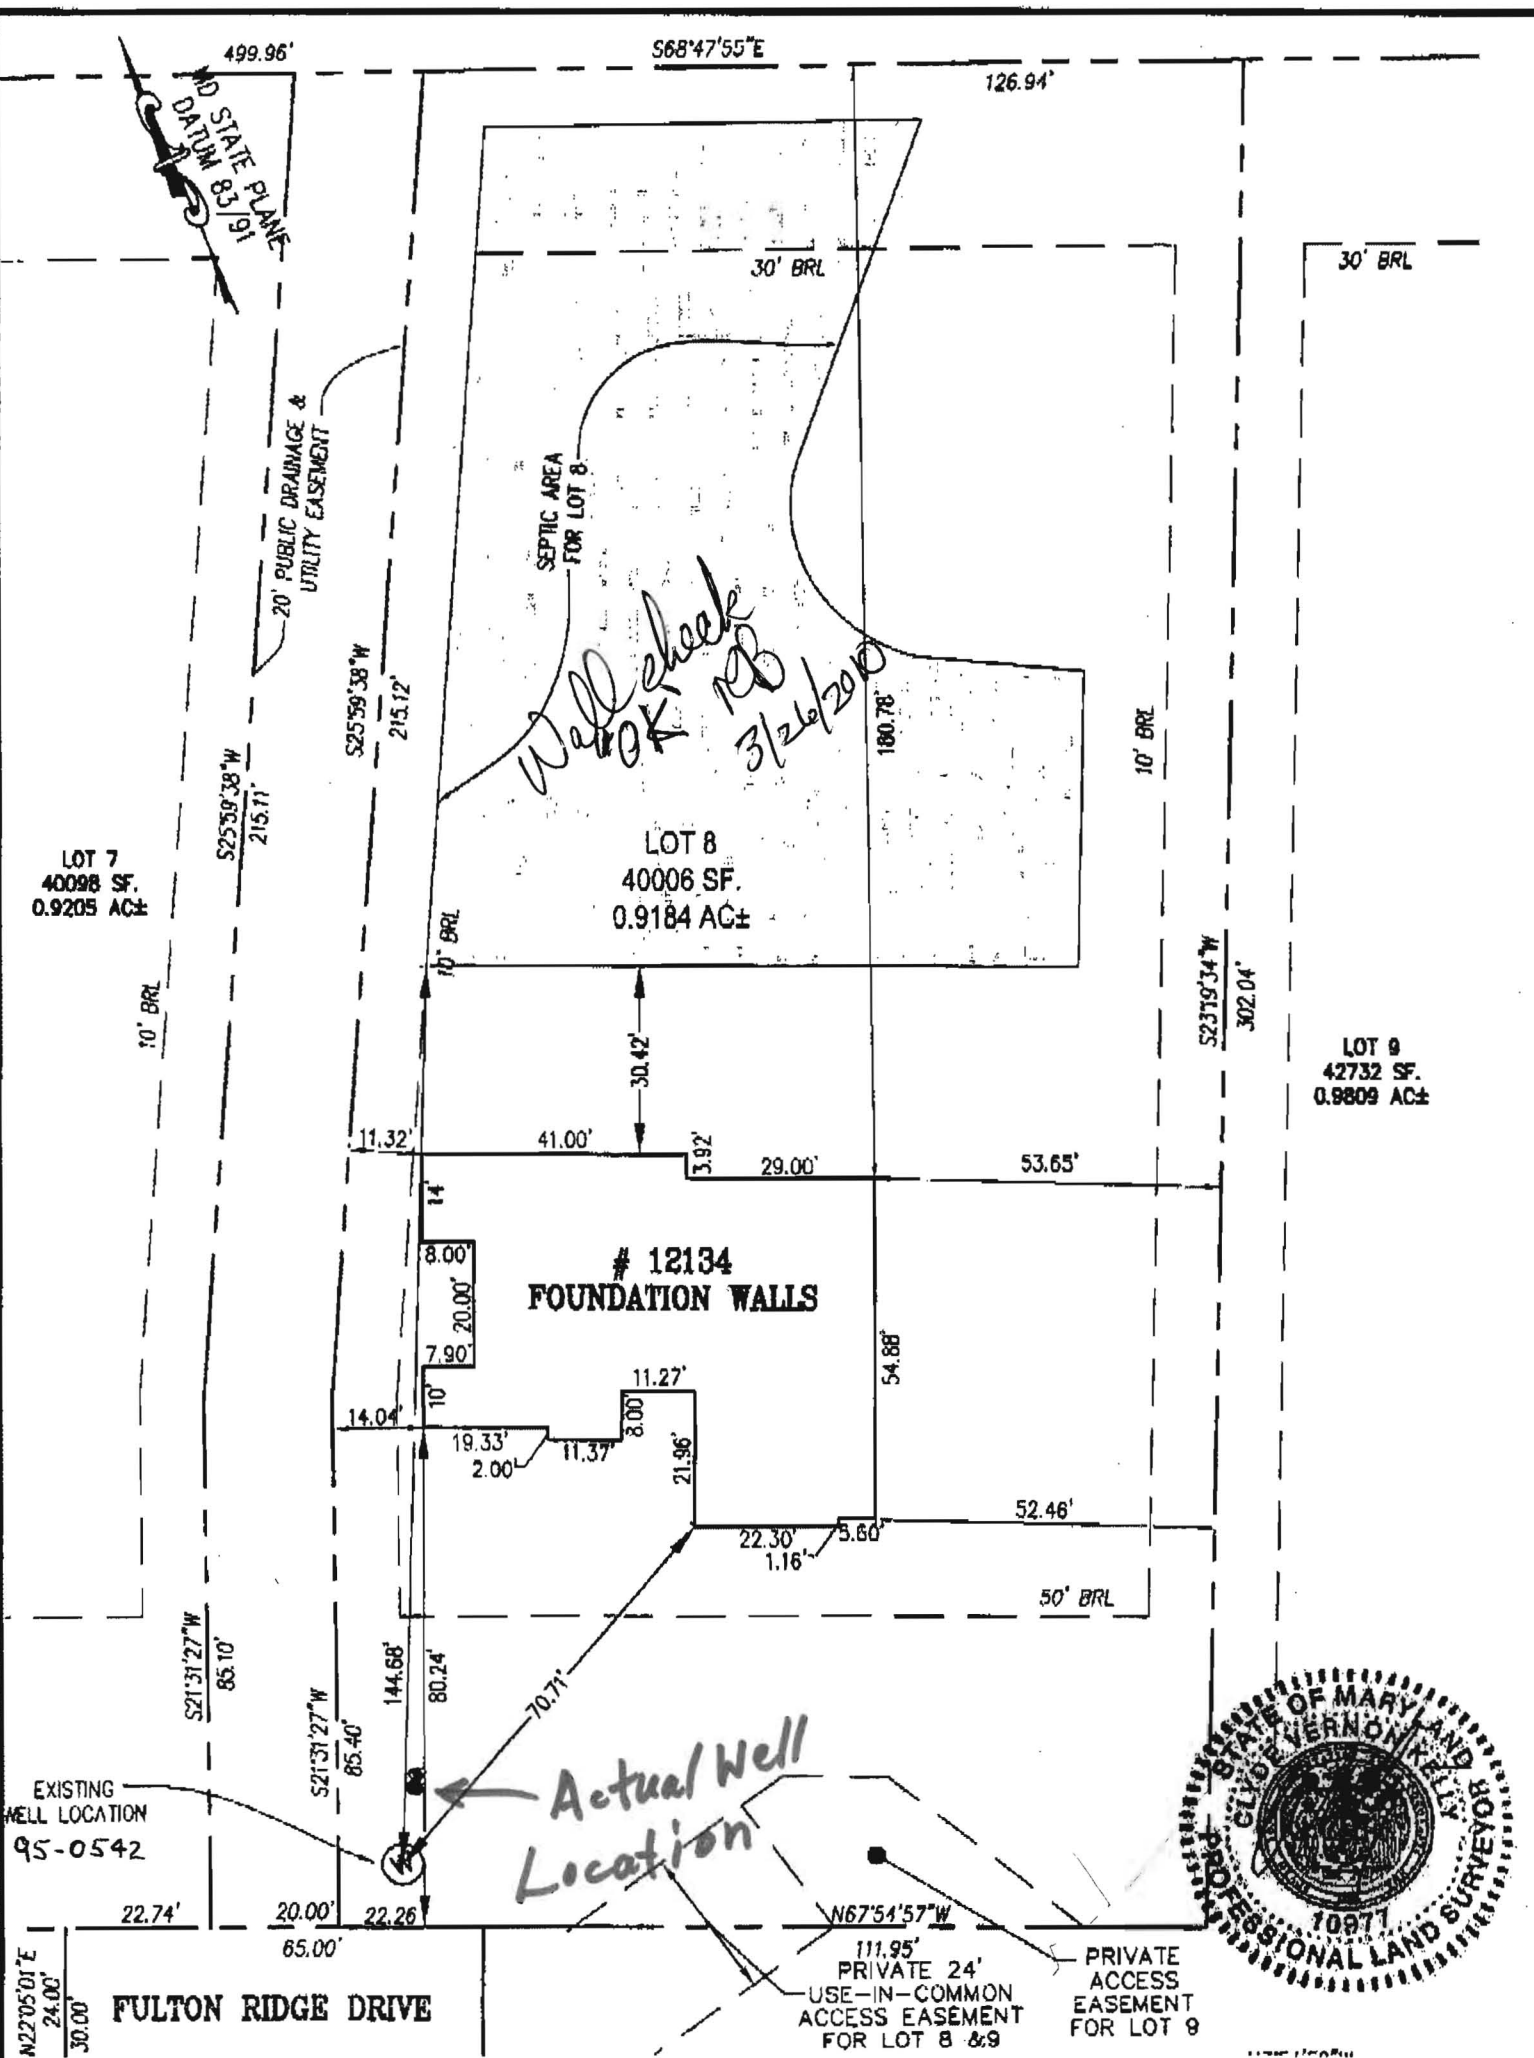

**SURVEYOR'S CERTIFICATE:**  
 I HEREBY STATE THAT THE EXISTING VISIBLE IMPROVEMENTS ON THE ABOVE DESCRIBED PROPERTY HAS BEEN CAREFULLY ESTABLISHED BY ACCEPTED METHODS AND THAT THE IMPROVEMENTS APPEAR TO LIE WITHIN FLOOD ZONE C. A FLOOD CERTIFICATION IS RECOMMENDED TO DETERMINE THE EXACT FLOOD ELEVATION AND FLOOD ZONE. THIS SURVEY IS NOT TO BE USED OR RELIED UPON FOR THE ESTABLISHMENT OF ANY FENCE, BUILDING, OR OTHER IMPROVEMENTS. THIS PLAN DOES NOT PROVIDE FOR THE ACCURATE IDENTIFICATION OF PROPERTY LINES, BUT SUCH IDENTIFICATION MAY NOT BE REQUIRED FOR THE TRANSFER OF TITLE OR SECURING FINANCING OR REFINANCING. THIS PLAN IS OF BENEFIT TO A CONSUMER ONLY INsofar AS IT IS REQUIRED BY A LENDER OR A TITLE INSURANCE COMPANY OR ITS AGENT IN CONNECTION WITH THE COMPLETED TRANSFER, FINANCING OR REFINANCING. THE LEVEL OF ACCURACY OF THIS DRAWING IS 2± FEET. NO TITLE REPORT WAS FURNISHED TO NOR DONE BY THIS COMPANY. SAID PROPERTY IS SUBJECT TO ALL NOTES, RESTRICTIONS AND EASEMENTS OF RECORD. BUILDING RESTRICTION LINES AND EASEMENTS NOT SHOWN ON THE RECORD PLAN MAY NOT BE SHOWN HEREON. IMPROVEMENTS WHICH IN THE SURVEYOR'S OPINION APPEAR TO BE IN A STATE OF DISREPAIR OR MAY BE CONSIDERED TEMPORARY MAY NOT BE SHOWN.

**WELL AND SEPTIC LOCATION SURVEY**  
 ON  
**#12134 FULTON RIDGE DR**  
**LOT 8, FULTON RIDGE**  
 TAX MAP 41, GRID 13  
 PARCEL NO. 206  
 5TH ELECTION DISTRICT  
 HOWARD COUNTY  
 MARYLAND 20759  
 NOVEMBER 2009  
 SCALE: 1" = 30'

**AB CONSULTANTS, INC.**  
 9450 ANNAPOLIS ROAD  
 LANHAM, MARYLAND 20708  
 PHONE: (301) 308-3081  
 FAX: (301) 308-3092

DRAWN BY: YJS  
 CHECKED BY: CVK  
 FILE: 2009207