

LAYOUT _____ INSP 4 _____

INSP 2 _____ INSP 5 _____

INSP 3 _____ INSP 6 _____

ISSUE DATE: 7/25/11

PERMIT

P 535910

APPROVAL DATE: 11/29/11

A 530961

SANDMOUND SYSTEM ON-SITE SEWAGE DISPOSAL SYSTEM HOWARD COUNTY HEALTH DEPARTMENT BUREAU OF ENVIRONMENTAL HEALTH

Fogles Septic

IS PERMITTED TO INSTALL ALTER

ADDRESS: 590 Obrecht Rd.

PHONE NUMBER: 410-795-5670

SUBDIVISION: Allnutt Farms Estates

LOT NUMBER: 33

ADDRESS: 13504 Golden Corn Drive

PROPERTY OWNER: Stevens Builders Inc.

SEPTIC TANK CAPACITY (GALLONS): 2000

OUTLET BAFFLE FILTER REQUIRED

PUMP CHAMBER CAPACITY (GALLONS): 1500

COMPARTMENTED TANK REQUIRED

NUMBER OF BEDROOMS: 4

SIZE(FLOW): 600 GPD

GRAVEL BED SIZE: 10'L X 60'W

LOCATION:	Sand Mound to be installed. See Approved Septic System Plan for locations and elevations. Sand mound must meet Howard County specifications. Subject to approval.
NOTES:	All Sand Mound sites should be staked. Heavy equipment should be kept off site location. Maintain a minimum 100' separation distance between sand mound system and well on neighboring property. SDA is to be fenced during building construction and grading. Layout inspection required prior to start of system installation.

PLANS APPROVED: Heidi Scott

DATE: 1/10/11

NOTES: PERMIT VOID AFTER 2 YEARS
 CONTRACTOR IS RESPONSIBLE FOR SCHEDULING A PRE-CONSTRUCTION INSPECTION FOR ALL INSTALLATIONS
 WATERTIGHT SEPTIC TANKS REQUIRED
 ALL PARTS OF SEPTIC SYSTEM SHALL BE 100 FEET FROM ANY WATER WELL UNLESS SPECIFICALLY AUTHORIZED
 MANHOLE RISERS REQUIRED ON ALL SEPTIC TANKS AND PUMP CHAMBERS UNLESS SPECIFICALLY AUTHORIZED
 CONTRACTOR RESPONSIBLE FOR COMPLIANCE WITH APPLICABLE REGULATIONS, GUIDELINES AND THE TERMS OF THIS PERMIT

NEITHER THE HOWARD COUNTY COUNCIL NOR THE HEALTH DEPARTMENT IS RESPONSIBLE FOR THE SUCCESSFUL OPERATION OF ANY SYSTEM PERMITTEE RESPONSIBLE FOR OBTAINING FINAL APPROVAL ON THIS PERMIT ALL 410-313-2640 FOR INSPECTION OF SEPTIC SYSTEM

NOT TO SCALE

019222
138082

05-22-27-0113

See As-Built Drawing
On Separate Sheet

9/1/2011 Pump and alarm working.
Laterals and bed look O.K.
around 2.5' of head in all laterals
O.K. to put cap on bed. (BB)

11/29/11 Cap looks good. (KW)

ROAD

SEPTIC TANK DATA

SEPTIC TANK 1 LEVEL Yes
 CAPACITY 2000 GAL
 SEAM LOC Top
 TANK LID DEPTH 2'-3.5'
 BAFFLES Yes
 BAFFLE FILTER Yes
 MANHOLE LOC Front+Rear
 6" PORT LOC None
 WATERTIGHT TEST No
 PUMP TANK LEVEL Yes
 CAPACITY 1500 GAL
 SEAM LOC Top
 TANK LID DEPTH 2-2.5'
 BAFFLES Front
 BAFFLE FILTER No
 MANHOLE LOC Rear
 6" PORT LOC None
 WATERTIGHT TEST No

SAND MOUND DATA

BED LENGTH 60'
 BED WIDTH 10'
 BED AREA 600 SQ FT
 MOUND LENGTH 82'+
 MOUND WIDTH 29'+
 MOUND AREA 2,378+
 BASAL AREA _____ SQ FT

PRE-CONSTRUCTION

^{7/28/11} Arrived on-site, No one there. Walked over area of mounds

No stakes were surveyed for potential mound areas. Contractor notified (KW)

INSTALLATION

8/3/11 Mound layout completed. Top of mound adjusted slightly, 3" difference adjusted to contour at bottom of mound. Tanks

may need to be pushed further downhill due to diff sewer out location. (KW) 8/8/11 No one on-site. Called me by contractor (KW)

8/24/2011 Baffle tiers installed but not pipe or filter. May need 1 H.P. pump. Mound site plowed. Putting sand on it. (BB)

8/26/11 Bed cut in. Grades checked. Bed level. OK to add gravel. Cover mound as to protect from weather event (Hurricane Irene) (KW)



FINAL INSPECTOR

K. Wolf

DATE OF APPROVAL

11/22/11

HO-95-1980

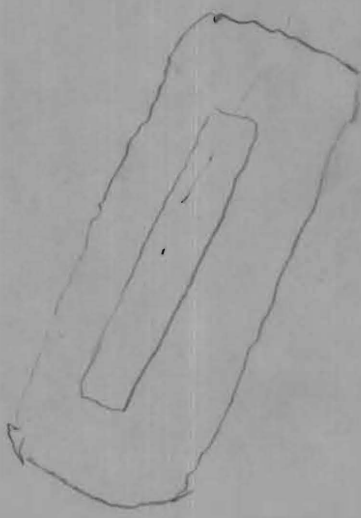
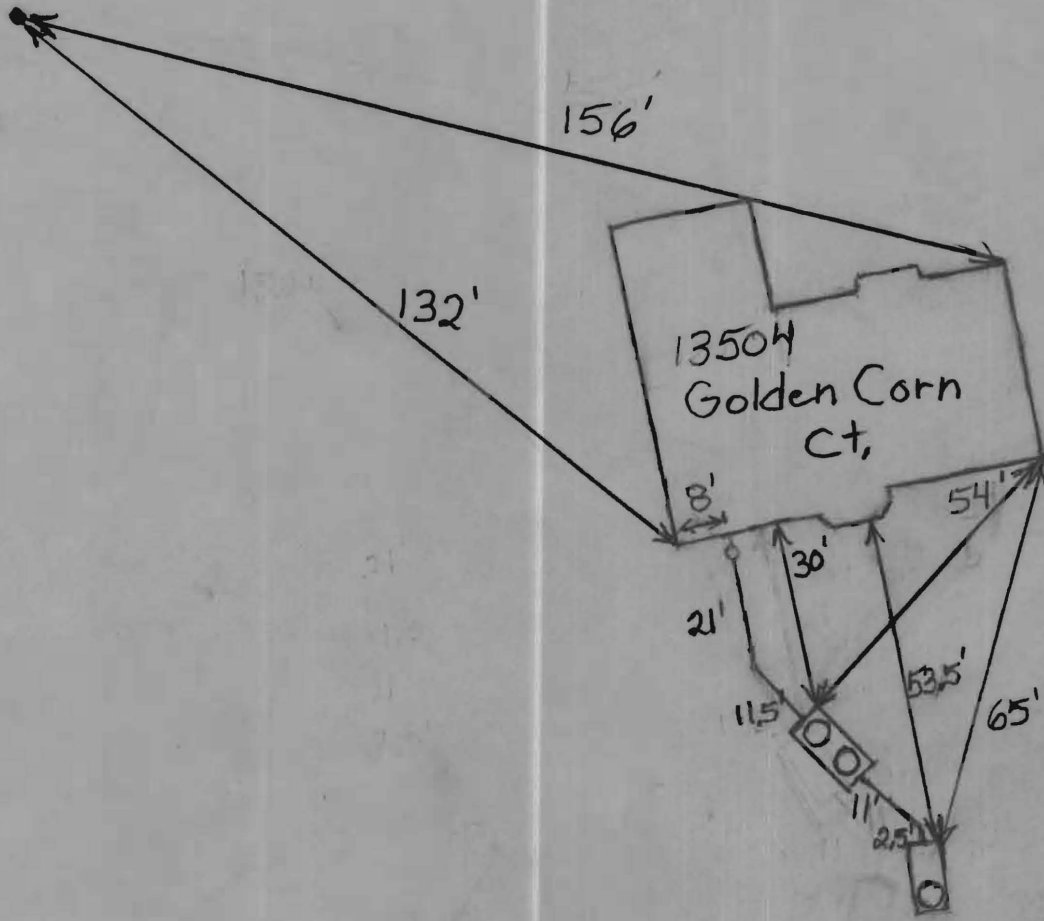


PROPERTY KNOWN AS:
 ALLNUT FARMS ESTATES
 LOT 33, SECTION 4
 TAX MAP 34, GRID 15
 P/O PARCEL 375
 5TH ELECTION DISTRICT
 HOWARD COUNTY, MARYLAND
 PLAT #3891

BUILDER:
 Hamilton Reed, LLC
 3368 Brantly Court
 Glenwood, MD 21738
 410-442-1751

CONTRACT PURCHASER
 Avery C. Van Gieson
 9328 Steeple Court
 Laurel, MD 20723

OWNER:
 Steve Allnutt
 13492 Open Space Ct.
 Highland, MD 20777

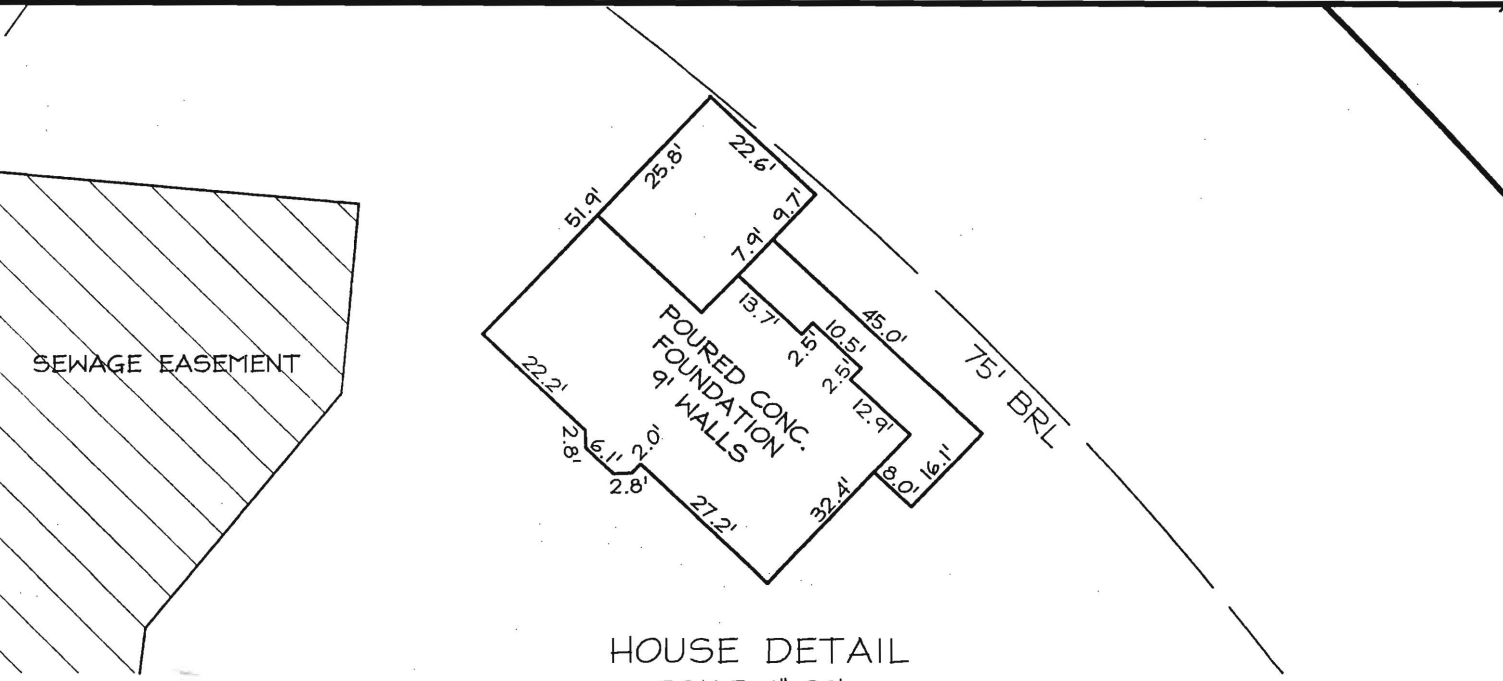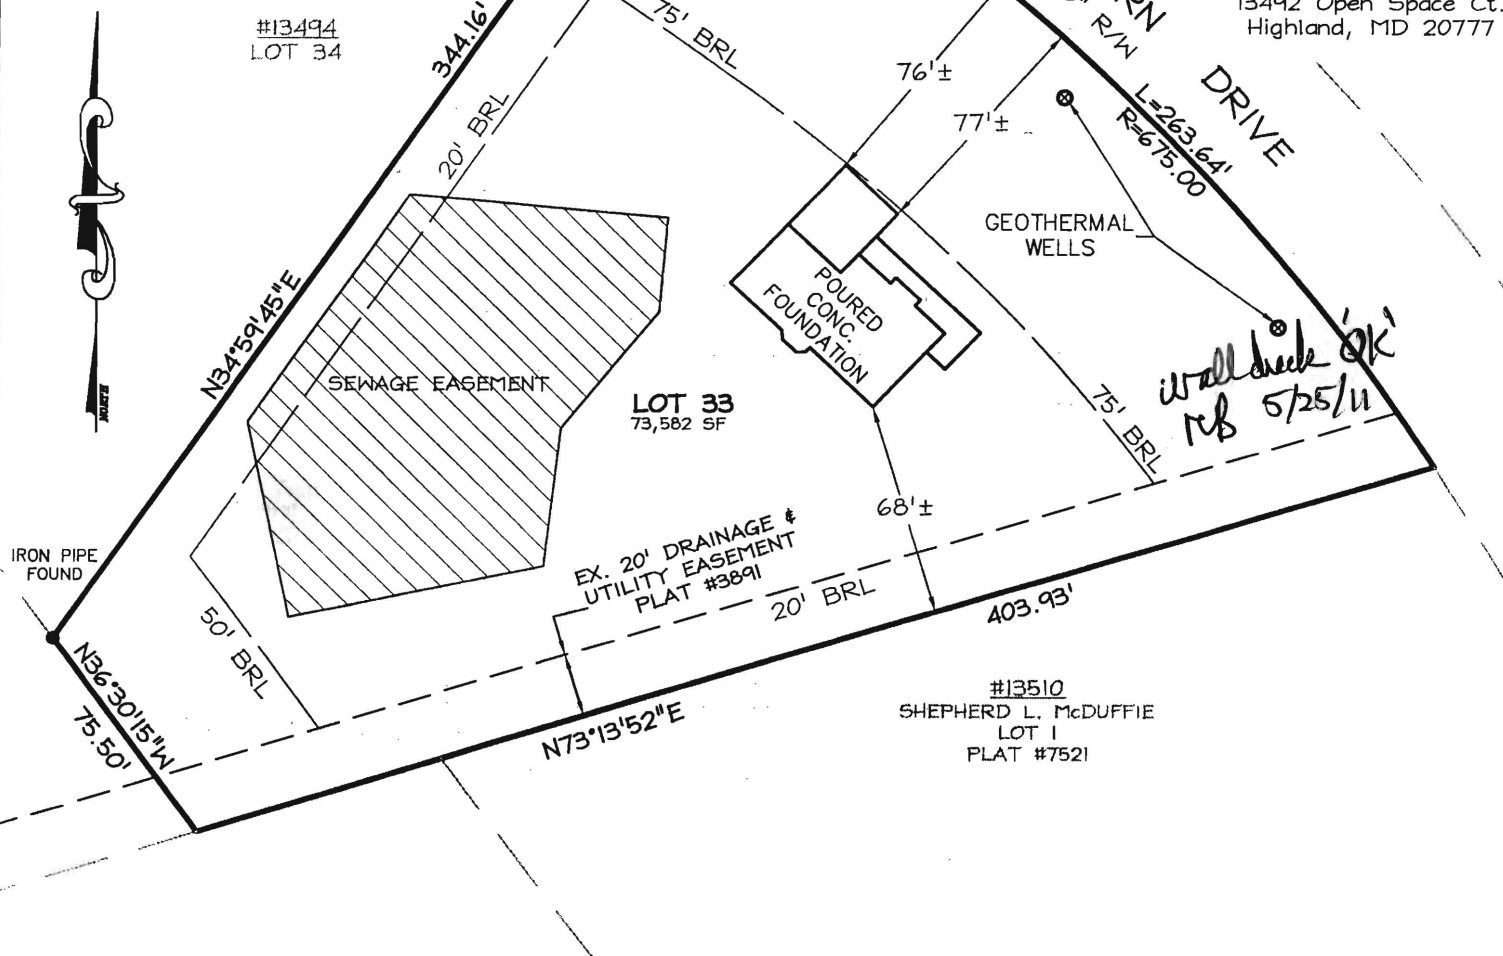

FOUNDATION LOCATION
 TOP WALL ELEV. 463.8'±

THIS PLAT CAN NOT BE USED TO ESTABLISH
 PROPERTY LINES OR CORNERS.

CERTIFICATION	SEAL	SCALE: 1"=60'	DATE: 2/2011
<p>This is to certify that I have surveyed the property known as: <u>LOT 33</u></p> <p>The information shown has been established by current acceptable survey procedures and from available record information. This drawing is to used for Title Transfer Financing, or Refinancing Only and IS NOT to be used for the Establishment of Property Lines, Location for Fences, Garages, Buildings, or other Existing or Future Improvements.</p>		<p>LDE Inc. Engineers, Surveyors, Planners</p> <p>9250 Rumsey Road, Suite 106 Columbia, Maryland - 21045 (410)715-1070 - (410)715-9540 Fax</p>	
DRAWING: MDL		JOB# 09-008.2	

F:\09-008-2\dwg\09-008-2\WALLCHECK.dwg, Layout1, 2/18/2011 9:56:53 AM