

PUB. SEWER STATUS VERIFIED BY \_\_\_\_\_

ISSUE DATE: 8/05/09

P ~~531866~~ 531866

APPROVAL DATE: 8/21/09

# PERMIT

A REPAIR

Tax ID # 6-442714

**ON-SITE SEWAGE DISPOSAL SYSTEM  
HOWARD COUNTY HEALTH DEPARTMENT  
BUREAU OF ENVIRONMENTAL HEALTH**

*In Pat Trac*

Hatfields IS PERMITTED TO  INSTALL  ALTER

ADDRESS: \_\_\_\_\_ PHONE NUMBER: \_\_\_\_\_

SUBDIVISION: \_\_\_\_\_ LOT NUMBER: \_\_\_\_\_

ADDRESS: 10624 Gorman Road PROPERTY OWNER: Szymon Poplawski

SEPTIC TANK CAPACITY (GALLONS): 1500

PUMP CHAMBER CAPACITY (GALLONS): \_\_\_\_\_

NUMBER OF BEDROOMS: 4

SQUARE FEET PER BEDROOM: \_\_\_\_\_

LINEAR FEET OF TRENCH REQUIRED: 68' ~~68'~~ 68' PUBLIC WATER


TRENCHES:	One <del>20</del> foot trench. Inlet 4 foot. Bottom 10 foot. Trench 2 feet wide. Replace collapsed metal tank.
LOCATION:	As per layout.
ADDITIONAL NOTES:	

PLANS APPROVED: B. Baker DATE: 8/05/09

- NOTE: PERMIT VOID AFTER 2 YEARS
- NOTE: CONTRACTOR RESPONSIBLE FOR SCHEDULING A PRE-CONSTRUCTION INSPECTION FOR ALL INSTALLATIONS
- NOTE: WATERTIGHT SEPTIC TANKS REQUIRED
- NOTE: ALL PARTS OF SEPTIC SYSTEM SHALL BE 100 FEET FROM ANY WATER WELL
- NOTE: MANHOLE RISERS REQUIRED ON ALL SEPTIC TANKS AND PUMP CHAMBERS

**NEITHER THE HOWARD COUNTY COUNCIL OR THE HEALTH DEPARTMENT IS RESPONSIBLE FOR THE SUCCESSFUL OPERATION OF ANY SYSTEM PERMITTEE RESPONSIBLE FOR OBTAINING FINAL APPROVAL ON THIS PERMIT CALL 410-313-1771 FOR INSPECTION OF SEPTIC SYSTEM**

NOT TO SCALE

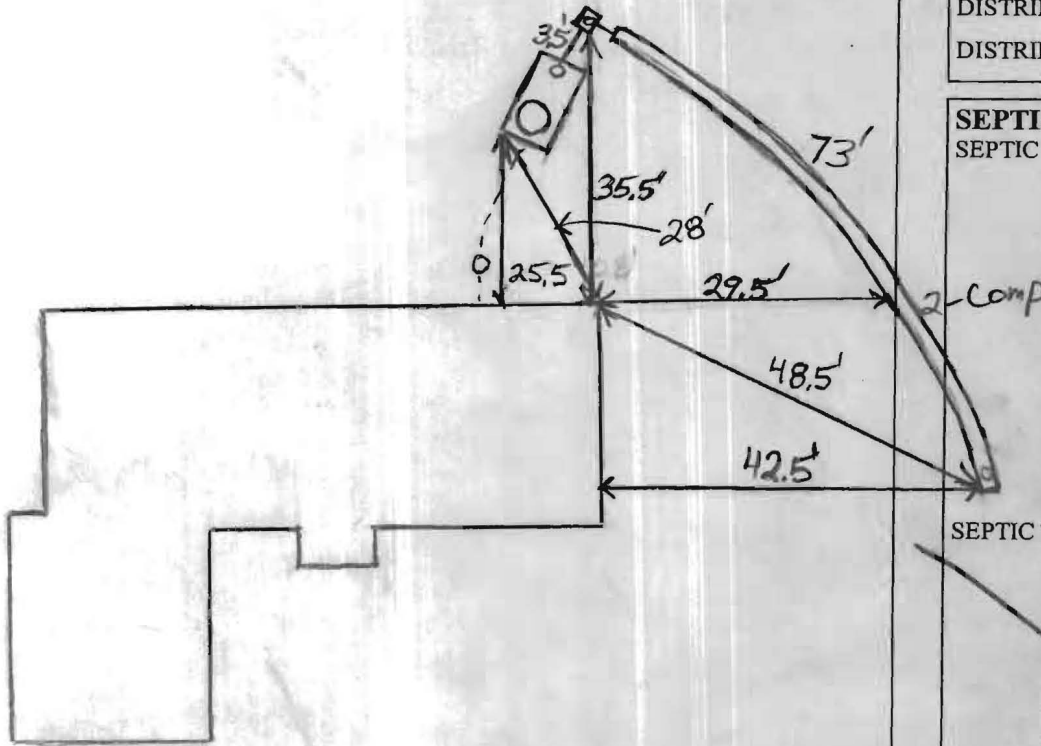

TRENCH/DRAINFIELD DATA		
WIDTH	INLET	BOTTOM
2'	4'	10'
NUMBER OF TRENCHES		1
TOTAL LENGTH		73'
ABSORPTION AREA		438+
DISTRIBUTION BOX LEVEL		Yes
DISTRIBUTION BOX BAFFLE		Yes
DISTRIBUTION BOX PORT		Yes

SEPTIC TANK DATA	
SEPTIC TANK 1 LEVEL	Yes
CAPACITY	1500 GAL
SEAM LOC	Top
TANK LID DEPTH	1.5'-3.5'
BAFFLES	Yes
BAFFLE FILTER	No
MANHOLE LOC	Front
6" PORT LOC	Rear
WATERTIGHT TEST	No
SEPTIC TANK 2 LEVEL	N/A
CAPACITY	_____ GAL
SEAM LOC	_____
TANK LID DEPTH	_____
BAFFLES	_____
BAFFLE FILTER	_____
MANHOLE LOC	_____
6" PORT LOC	_____
WATERTIGHT TEST	_____

Gorman ROAD

PRE-CONSTRUCTION 8/20/09 Install new 1500 gallon two compartment tank and trench on contour directly  
 INSTALLATION after tank. (BB) 8/21/09 Tank and trench installed. O.K. to backfill. (BB)

FINAL INSPECTOR B. Baker DATE OF APPROVAL 8/21/09

**INFORMATION FORM - SEPTIC SYSTEM REPAIR / UPGRADE / EVALUATION**

For internal office use only

**Reason for Request:**

- Failing System (includes surface discharge or inadequate treatment zone)
- Has the contractor verified through excavation/pumping evaluation, that there are no pipe blockages?**
- System relocation for proposed addition for setback compliance \*
- Verification of adequate system per COMAR 26.04.02.02D (4)\*
- To replace collapsed septic tank  metal tank ?
- To replace collapsed drywell

Septic Contractor: Hutchclds Equipment  
Contractor's Address: PO Box 519  
Annapolis Junction MD 20701  
Contractor's Phone #: 301-854-6172 410-984-0047  
Property Address: 10624 Gorman Road  
Property (Subdivision) & Lot # \_\_\_\_\_  
County file number if known: \_\_\_\_\_  
Owner's Name and Phone number: Szymon Poplawski: 301-404-1565  
Is public sewer available/nearby: N/A  
**If public sewer may be close, mention further research will be performed to verify availability**  
Names of Any Previous Owners: \_\_\_\_\_  
Year House Built: 1955  
# of Existing Bedrooms: \_\_\_\_\_  
# of Bedrooms after completion of addition: \_\_\_\_\_  
Has this request been discussed previously with another Sanitarian: No Name: \_\_\_\_\_

**A Sanitarian will be in contact within three business days depending upon the urgency of the situation to coordinate the scheduling/review of the repair, upgrade or evaluation.**

Print out copy of Real Property Data via Dept. of Taxation website \_\_\_\_\_ Indexed file found \_\_\_\_\_

**\*Prior to scheduling inspections, scaled plans should be submitted to clarify the nature of the addition.**

If public sewer may be nearby, verify whether the sewer is technically "available" (defined as abutting or within the property), through the Bureau of Engineering (Diane Nason x 3372 or Jean Reed x 3362).  
If sewer is available, verify whether the property is within the Metropolitan District (Finance x 2061).  
If sewer is available, and property is within the Metropolitan District, connection to sewer is required. If owner believes reasons for exemptions exist, owner should justify request in writing.  
If soil/site conditions are limiting and sewer and/or Metro District status not conducive to connection, Sanitarian may recommend pursuit of Emergency Sewer Extension or Emergency Metro District Inclusion.  
Owner should contact Charlotte Dryden at x 4419 for further detail.

Environmental Sanitarian tentatively assigned per rotating index card box: \_\_\_\_\_  
Date of request: \_\_\_\_\_ (Clerical staff to update scheduling card with date of request/property address)

**Septic permit to be typed by clerical staff after instruction from scheduling Sanitarian.**  
**No permit is to be issued nor inspection to be scheduled without prior fee collection at office unless an emergency situation exists. Contractor to notify office of the emergency situation as soon as possible.**