

APPLICATION

FOR PERCOLATION TESTING AND SITE EVALUATION

TEST DATE(S) _____ TEST TIME _____ AP 5 21624
 AGENCY REVIEW: _____ DATE 12/15/2007

DO NOT WRITE ABOVE THIS LINE

I HEREBY APPLY FOR THE NECESSARY TESTING/EVALUATION PRIOR TO ISSUANCE OF SEWAGE DISPOSAL SYSTEM PERMIT(S) TO:

CHECK AS NEEDED:

- CONSTRUCT NEW SEPTIC SYSTEM(S)
- REPAIR/ADD TO AN EXISTING SEPTIC SYSTEM
- REPLACE AN EXISTING SEPTIC SYSTEM

CHECK AS NEEDED:

- NEW STRUCTURE(S)
- ADDITION TO AN EXISTING STRUCTURE
- REPLACE AN EXISTING STRUCTURE

CHECK ONE:

- CREATE NEW LOT(S)
- BUILD ON AN EXISTING LOT IN A SUBDIVISION
- BUILD ON AN EXISTING PARCEL OF RECORD

IS THE PROPERTY WITHIN 2500' OF ANY RESERVOIR?

- YES
- NO

THE TYPE OF STRUCTURE IS:

- RESIDENTIAL WITH 4-5 PROPOSED BEDROOMS IN THE COMPLETED STRUCTURE (NOTE **UNKNOWN** IF APPROPRIATE)
- COMMERCIAL (PROVIDE DETAIL OF NUMBERS AND TYPES OF EMPLOYEES/ CUSTOMERS ON ACCOMPANYING PLAN)
- INSTITUTIONAL/GOVERNMENT (PROVIDE DETAIL OF NUMBERS AND TYPES OF EMPLOYEES/USERS ON ACCOMPANYING PLAN)

PROPERTY OWNER(S) Clyde H. Brown + Dorothy Mary Brown Trust

DAYTIME PHONE _____ CELL _____ FAX _____

MAILING ADDRESS _____ STREET _____ CITY/TOWN _____ STATE _____ ZIP _____

APPLICANT Greg + Ronda Carpenter

DAYTIME PHONE 443.324.4663 CELL 443.324.2430 FAX 410.988.9016

MAILING ADDRESS 4110 Ten Oaks Road Dayton MD 21036
STREET CITY/TOWN STATE ZIP

APPLICANT'S ROLE: DEVELOPER BUILDER BUYER RELATIVE/FRIEND REALTOR CONSULTANT

PROPERTY LOCATION SUBDIVISION/PROPERTY NAME Howard Road, Dayton new LOT NO. 1

PROPERTY ADDRESS 13835 Howard Road Dayton
STREET TOWN/POST OFFICE

TAX MAP PAGE(S) 28 GRID 7 PARCEL(S) 13 PROPOSED LOT SIZE 40,000 SF

AS APPLICANT, I UNDERSTAND THE FOLLOWING: THE SYSTEM INSTALLED SUBSEQUENT TO THIS APPLICATION IS ACCEPTABLE ONLY UNTIL PUBLIC SEWERAGE IS AVAILABLE. THIS APPLICATION IS COMPLETE WHEN ALL APPLICABLE FEES AND A SUITABLE SITE PLAN HAVE BEEN RECEIVED. I ACCEPT THE RESPONSIBILITY FOR COMPLIANCE WITH ALL M.O.S.H.A. AND "MISS UTILITY" REQUIREMENTS. APPROVAL IS BASED UPON SATISFACTORY REVIEW OF A PERC CERTIFICATION PLAN.


TEST RESULTS WILL BE MAILED TO APPLICANT. Ronda Carpenter SIGNATURE OF APPLICANT

HOWARD COUNTY HEALTH DEPARTMENT, BUREAU OF ENVIRONMENTAL HEALTH, WELL AND SEPTIC PROGRAM
 3525-H ELLICOTT MILLS DRIVE, ELLICOTT CITY, MARYLAND 21043-4544 (410) 313-1771 FAX (410) 313-2648
 TDD (410) 313-2323 TOLL FREE 1-877-4MD-DHMH

AP
6
2 roots
brown
light brown
sil
micaceous
brown
micaceous
1
light brown
red
sil
light yellow
red
brown
sil w/ 10-15% grass
15

7
3 roots
brown
brown
sil
orange
brown
sil
red brown
sil
red yellow
brown
sil w/ 10-15% grass
10
10

0
2 roots
brown
brown
sil
red brown
sil
micaceous
red brown
sil w/ 5% grass
light
red brown
sil w/ 10% charcoal
grass
& saprolite

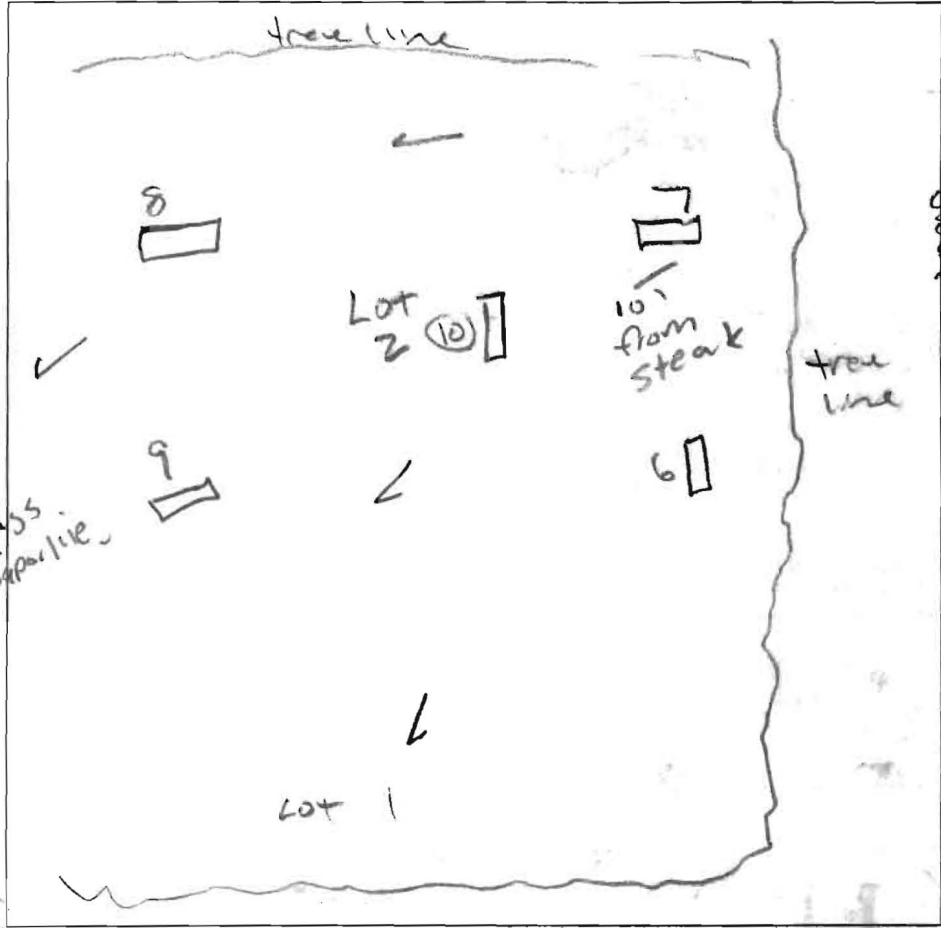


9
1 brown
5 brown
1-2 sil
4 red brown
micaceous
sil
5 1 sil
6 11
10-15% saprolite

11 light
brown
sil
15

10
1 brown
brown
sil
3 yellow
brown
dark
brown
sil
(micaceous)
12 red brown
sil w/ 10-15% saprolite
14

DATE	TEST #	DEPTH	START	BREAK 1" DROP	STOP 2" DROP	TIME OF 2nd INCH	P/F/H
12/20/04	6	4/15	11:06	Pulled	so slow		
	7	4 1/2 / 16	11:10	11:14	11:18	4	P
	8	6 / 14	11:46	11:50	11:58	8	P
	9	5 / 14	9:34	9:41	9:53	12	P
	10	4 / 14	9:35	9:39	9:45	6	P
	6	repair 6 / 15	11:36	11:38	11:40	2	P

REMARKS Freeing Perc holes / Dug to STEAK
 SANITARIAN PAY BACKHOE TRUCK OTHERS OWNERS
 TEST HOLES USED IN SDA _____ AVG. PERC TIME _____ SQ. FT/BR _____
 TRENCH WIDTH _____ INLET DEPTH _____ MAX. BOT DEPTH _____ EFFECTIVE SW _____

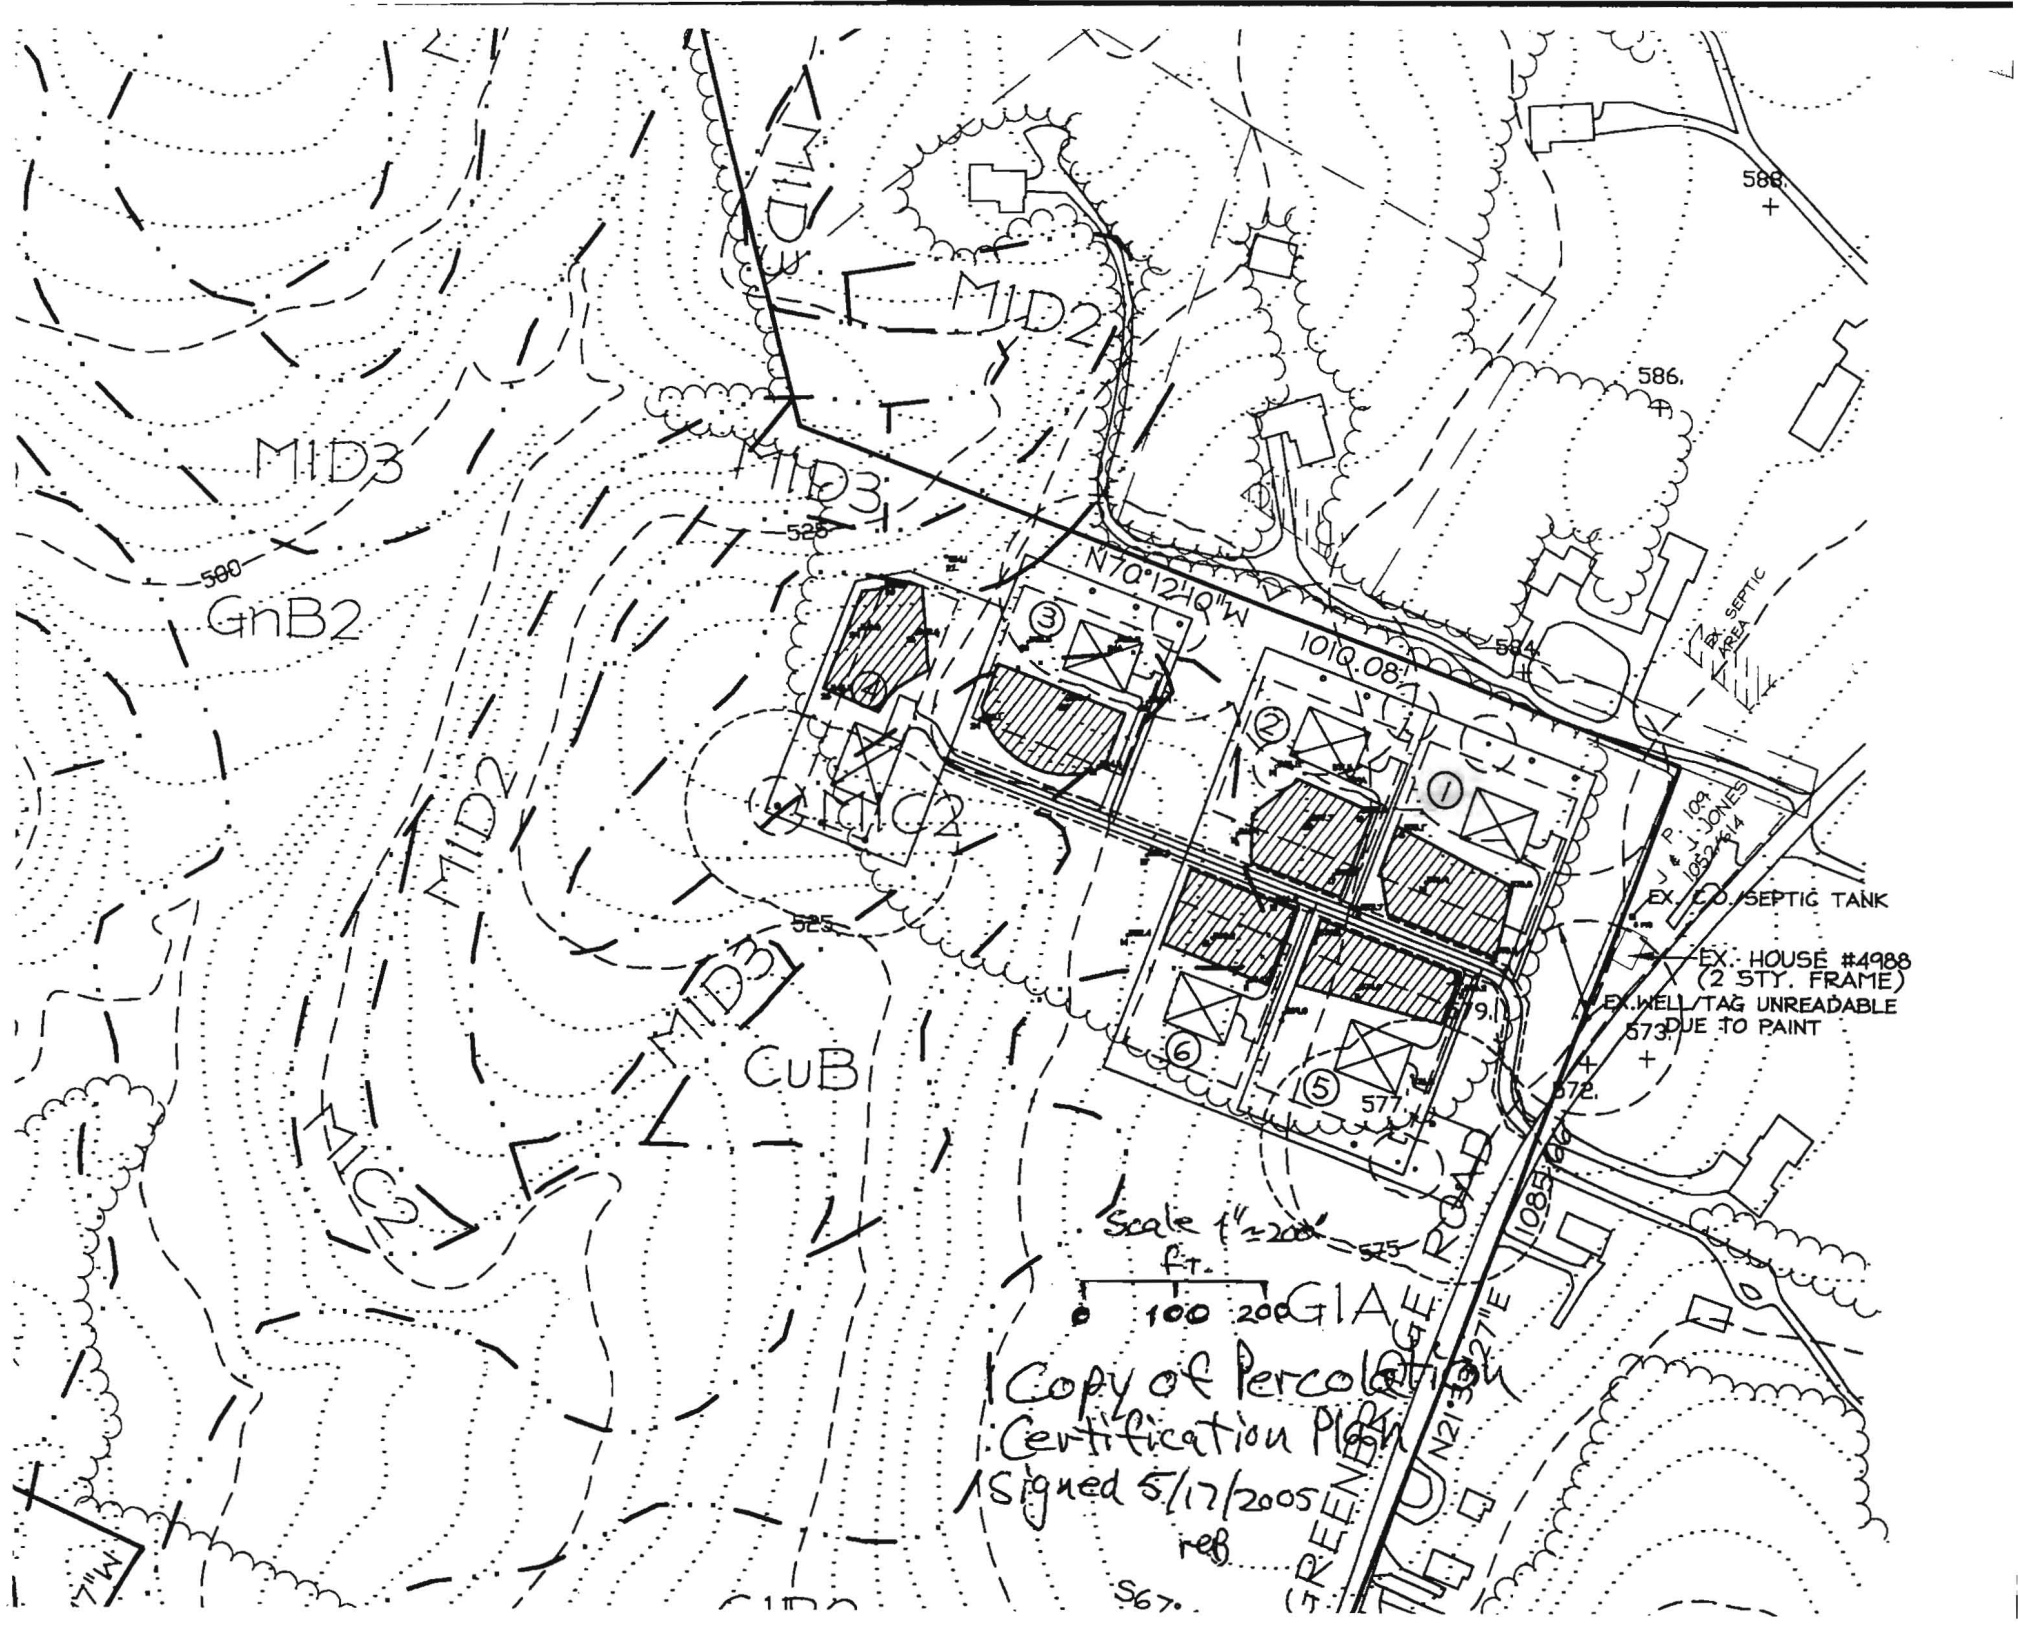

MID3

580

GnB2

MID2

MID3

CuB

Scale 1" = 200'
Ft.

100 200

Copy of Percolation
Certification Plan
Signed 5/17/2005
reb

S67.

586

586.

525

N70°12'40"W

1012.08'

584

EX. SEPTIC AREA

MID2

525

J. P. Jones
1082
1074

EX. CO. SEPTIC TANK

EX. HOUSE #4988
(2 STY. FRAME)

EX. WELL TAG UNREADABLE
573 DUE TO PAINT

GREENIDGE ROAD
N21°30'27"E
1083.66'

572

525

575

577

579

581

583

585

587

589