

# APPLICATION

A 3544P

## SEWAGE DISPOSAL TESTING

STATE OF MARYLAND - DEPARTMENT OF HEALTH AND MENTAL HYGIENE

P \_\_\_\_\_

HOWARD COUNTY HEALTH DEPARTMENT  
ENVIRONMENTAL HEALTH SERVICES

P. O. BOX 476 ELLICOTT CITY, MARYLAND 21043  
TELEPHONE: 992-2330

DISTRICT \_\_\_\_\_

DATE 9/18/85

TO: THE COUNTY HEALTH OFFICER  
ELLICOTT CITY, MARYLAND

I, HEREBY, APPLY FOR THE NECESSARY TEST IN ORDER TO CONSTRUCT (OR RECONSTRUCT) A SEWAGE DISPOSAL SYSTEM.

PROPERTY OWNER CARMAN ASSOCIATES

ADDRESS Box 122, ELLICOTT CITY MD PHONE 301 854-0498

PROPERTY LOCATION:

SUBDIVISION DAYTON MEADOWS LOT NO. 15

ROAD AND DESCRIPTION DAYTON MEADOWS COURT, DAYTON, MD

SIZE OF LOT 3 AC. + TYPE BLDG. THREE  
(NUMBER OF BEDROOMS)

THE SYSTEM INSTALLED UNDER THIS APPLICATION IS ACCEPTABLE ONLY UNTIL PUBLIC FACILITIES BECOME AVAILABLE. I FULLY UNDERSTAND THE FEE CONNECTED WITH THE FILING OF THIS PERC TEST APPLICATION IS NON-REFUNDABLE UNDER ANY CIRCUMSTANCES. I ALSO AGREE TO COMPLY WITH ALL M.O.S.H.A. REQUIREMENTS IN TESTING THIS LOT.

Philip Mergitz  
(SIGNATURE OF APPLICANT)

APPROVED BY \_\_\_\_\_ FOR \_\_\_\_\_ DATE \_\_\_\_\_

REJECTED BY \_\_\_\_\_ FOR \_\_\_\_\_ DATE \_\_\_\_\_

HOLD PENDING FURTHER TESTS \_\_\_\_\_ DATE \_\_\_\_\_

REASONS FOR REJECTION OR HOLDING 7-15-85 PERC RESULTS SATISFACTORY, HOLD FOR CERTIFIED SUBDIVISION PLAT. SAME


# THIS IS NOT A PERMIT

SOIL PROFILE

0"  
4" A1-3  
Yellow BR  
Silt loam  
min. clay  
2.5'  
Yellow BR  
micaceous  
Silt loam  
20%  
SAPROHITE

12"  
0"  
4" A1-3  
Yellow Red  
Silt loam  
210%  
SAPROHITE  
3'  
Yellow BR,  
micaceous  
Silt loam  
20%  
SAPROHITE

12"  
0"  
4" A1-3  
Yellow Red  
CLAY loam  
210% SAPROHITE  
4"  
Yellow BR,  
micaceous  
Silt loam  
210%  
SAPROHITE  
13"

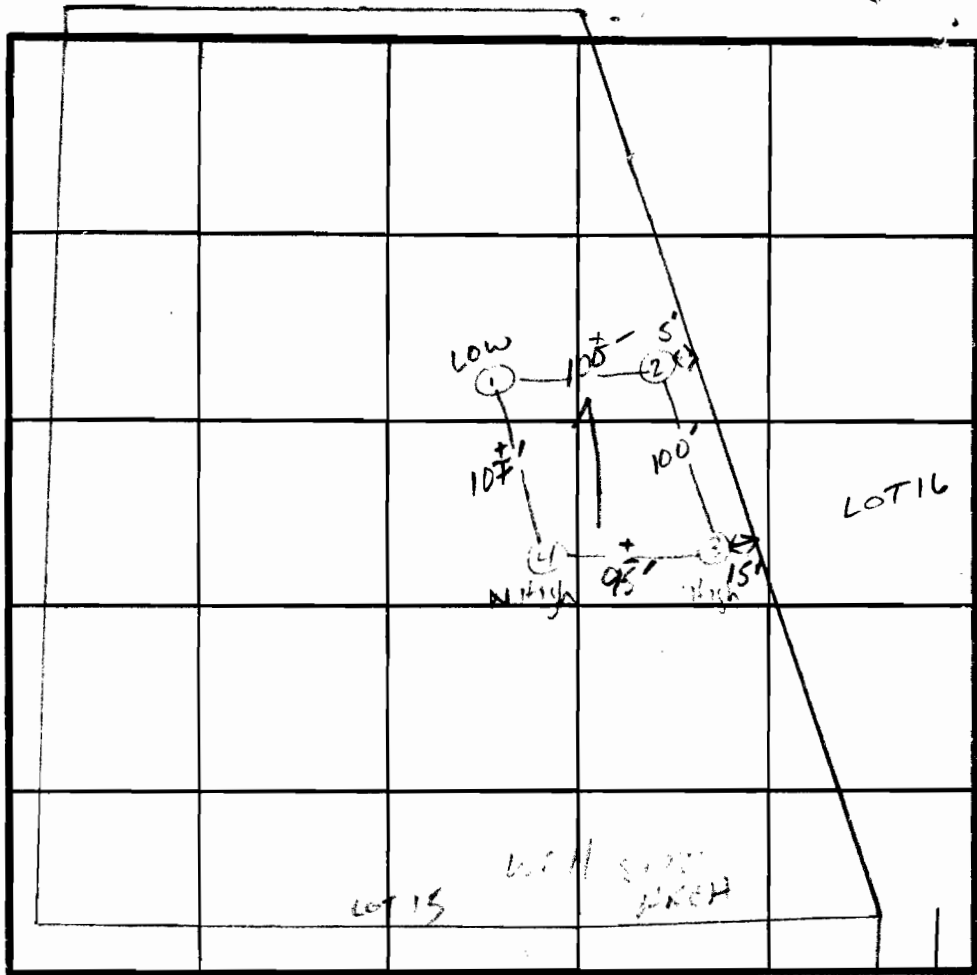

X PERC. TIME  
6min  
INLET 3.5 FT  
BOTTOM MAX 9 FT

DATE	TEST NO.	DEPTH	PRE-WET		TEST - 1" DROP		TIME
			START	STOP	START	STOP	
7/15/85	1 S V	4" 12"	12:52 good silt loam	12:53 from 2.5 ft	12:53	12:54	1min
	2 S V	4" 17"	12:59	1:00	1:00	1:04	4min
	3 S V	4.5" 15"	1:05	1:13	1:13	1:27	14min
	4 S V	4" 15"	1:17	1:18	1:18	1:20	2min

REMARKS: Hole hole cliff THAN PLAT 100 X 100

TYPE OF SOIL: (Clayey) MANOK loam

TESTED BY: S. Abel

ALSO PRESENT: [unclear] [unclear]

EH-12-1079