

LAYOUT 6/16/08 INSP 4 _____
INSP 2 6/17/08 INSP 5 _____
INSP 3 6/18/08 INSP 6 _____
ISSUE DATE: 6/13/08

APPROVAL DATE: 6/19/08

PERMIT *(logged in)*

P 528993
A 515042

TAX ID # 05448395

ON-SITE SEWAGE DISPOSAL SYSTEM HOWARD COUNTY HEALTH DEPARTMENT BUREAU OF ENVIRONMENTAL HEALTH

Fogles Septic Clean, Inc IS PERMITTED TO INSTALL ALTER

ADDRESS: 580 Obrecht Road PHONE NUMBER: 410-795-5670

SUBDIVISION: The Preserve at Clarksville LOT NUMBER: 25

ADDRESS: 6239 Heather Glen Way PROPERTY OWNER: Dayton Oaks LLC

SEPTIC TANK CAPACITY (GALLONS): 2000 OUTLET BAFFLE FILTER REQUIRED

PUMP CHAMBER CAPACITY (GALLONS): _____ COMPARTMENTED TANK REQUIRED

NUMBER OF BEDROOMS: 5

SQUARE FEET PER BEDROOM: _____

LINEAR FEET OF TRENCH REQUIRED: 194

TRENCHES:	Trench to be 3.0 feet wide. Inlet 3.0 feet below original grade. Bottom maximum depth 7.0 feet below original grade. Effective area begins at 5.0 feet below original grade. 3.0 feet of stone below distribution pipe.
LOCATION:	
NOTES:	Install as noted unless otherwise directed by HCHD. Layout inspection required prior to installation.

PLANS APPROVED: Heidi Scott DATE: 12/5/07

- NOTE: PERMIT VOID AFTER 2 YEARS
- NOTE: CONTRACTOR RESPONSIBLE FOR SCHEDULING A PRE-CONSTRUCTION INSPECTION FOR ALL INSTALLATIONS
- NOTE: WATERTIGHT SEPTIC TANKS REQUIRED
- NOTE: ALL PARTS OF SEPTIC SYSTEM SHALL BE 100 FEET FROM ANY WATER WELL
- NOTE: MANHOLE RISERS REQUIRED ON ALL SEPTIC TANKS AND PUMP CHAMBERS UNLESS SPECIFICALLY AUTHORIZED

NEITHER THE HOWARD COUNTY COUNCIL NOR THE HEALTH DEPARTMENT IS RESPONSIBLE FOR THE SUCCESSFUL OPERATION OF ANY SYSTEM PERMITTEE RESPONSIBLE FOR OBTAINING FINAL APPROVAL ON THIS PERMIT CALL 410-313-1771 FOR INSPECTION OF SEPTIC SYSTEM

NOT TO SCALE

★ See Seperate Sheet for As-Built

TRENCH/DRAINFIELD DATA

WIDTH	INLET	BOTTOM
3'	4'	7'
NUMBER OF TRENCHES		4
TOTAL LENGTH		200'
ABSORPTION AREA		600'± SW
DISTRIBUTION BOX LEVEL		Level 2
DISTRIBUTION BOX BAFFLE		Yes
DISTRIBUTION BOX PORT		Yes

SEPTIC TANK DATA

SEPTIC TANK 1 LEVEL	Yes
CAPACITY	2000 GAL
SEAM LOC	Top
TANK LID DEPTH	2.5'
BAFFLES	Yes
BAFFLE FILTER	No
MANHOLE LOC	Front/Rear
6" PORT LOC	None
WATERTIGHT TEST	_____
Babylon slotted	
SEPTIC TANK 2 LEVEL	_____
CAPACITY	_____ GAL
SEAM LOC	_____
TANK LID DEPTH	_____
BAFFLES	_____
BAFFLE FILTER	_____
MANHOLE LOC	_____
6" PORT LOC	_____
WATERTIGHT TEST	_____

PRE-CONSTRUCTION

6/16/08 Set Tank per BP plan. Set D box ~60' down from top highest corner of SDA. Run 2 trenches towards house (40' and 45').

and 2 trenches away from house (45' and 65'). May need to fill some swale near top part of SDA. Area lost due to swale. (Kw)

INSTALLATION: 6/19/08 Tank set as planned. All plumbing installed to D box. OK to cover what has been installed. No trenches dug. (Kw)

6/18/08 Trenches dug accordingly to layout design. D Box level OK to backfill. (Kw)

ROAD

FINAL INSPECTOR

[Signature]

DATE OF APPROVAL

6/18/08

H0-95-0237

45' 40'

6239 Heather Glenn Way

Prop. Drive

25

NOT TO SCALE

~300'

126'

81.5'

51'

105'

27'

8.5' ETC

46'

6'

4'

20'

66'

27'

27'

42'

46'

16'

46'

6'

5'

2'

13'

20'

10'

6'

11'

10'

10'


10'

10'


10'

10'

HEATHER GLEN WAY

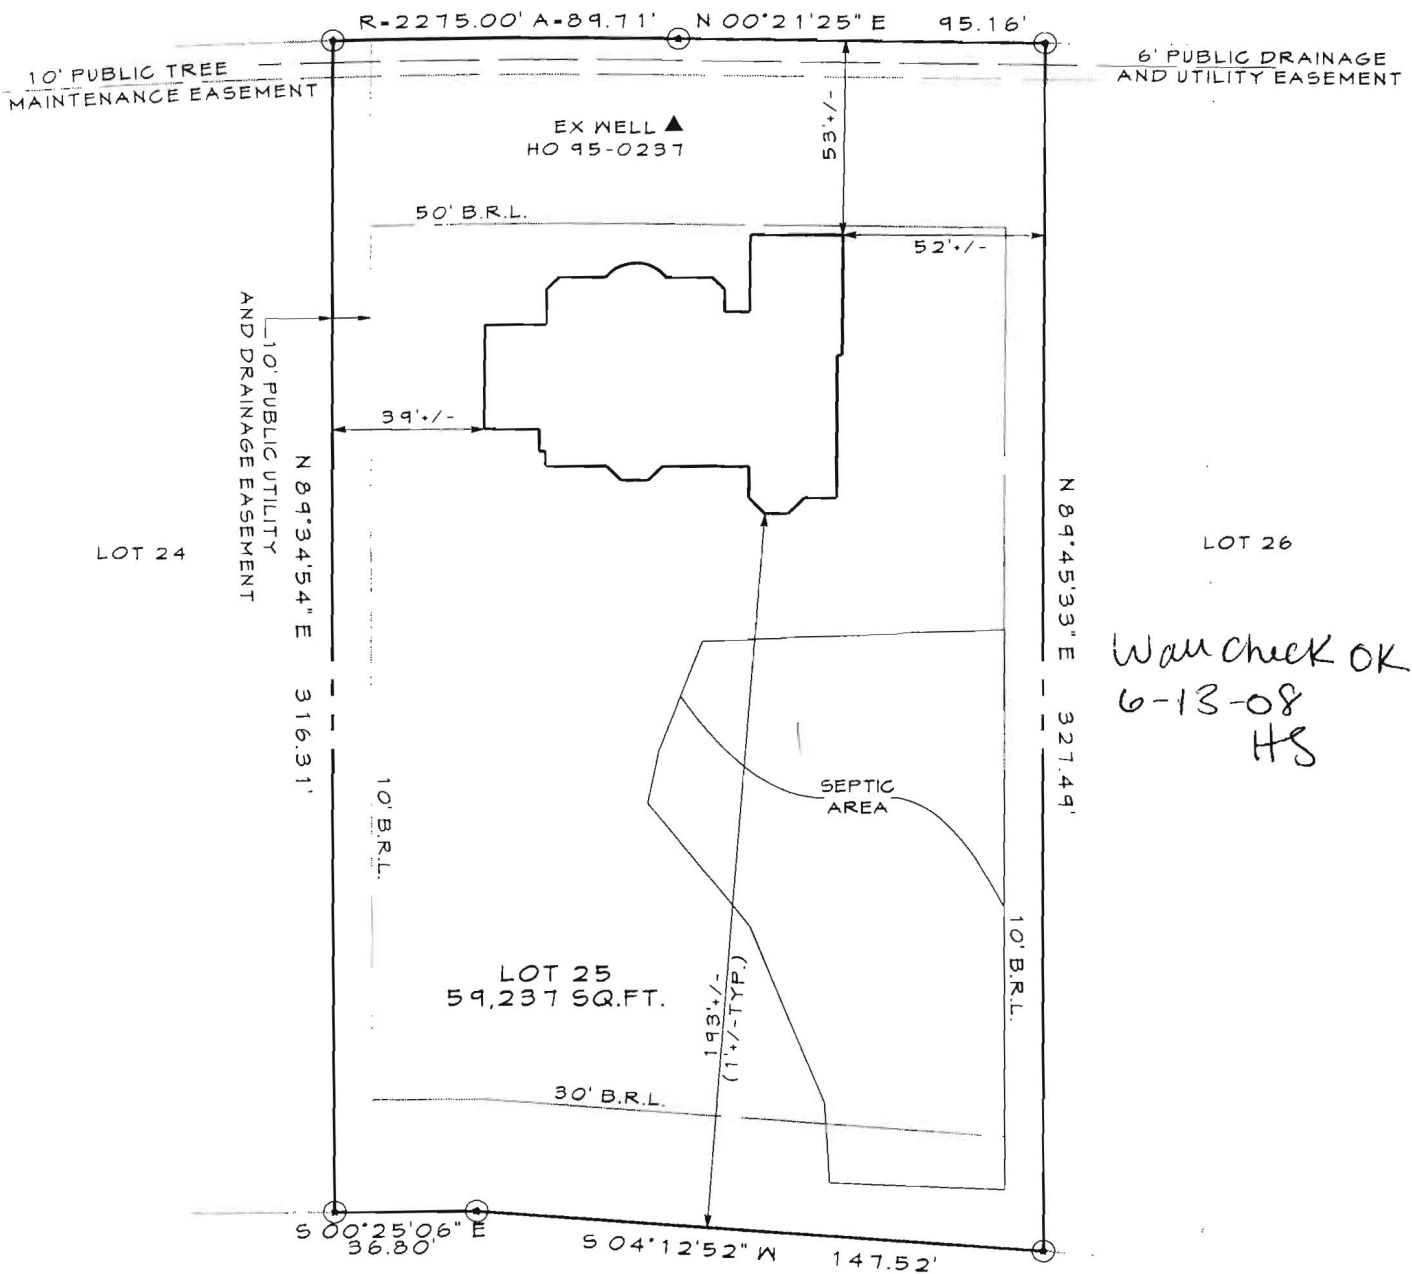

Was check OK
6-13-08
HS

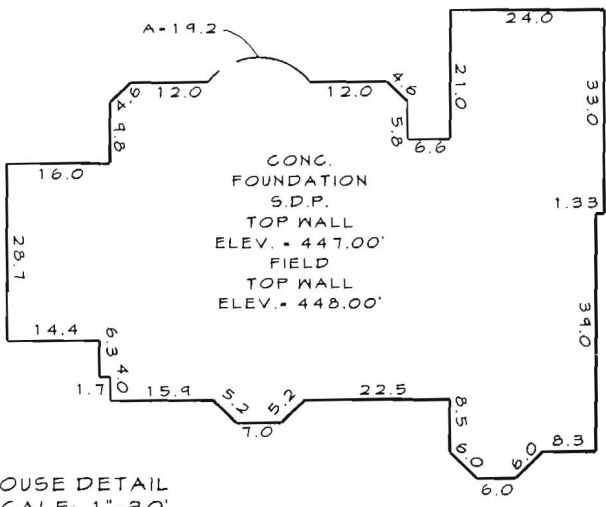

FOUNDATION CERTIFICATION
LOT 25
#6239 HEATHER GLEN WAY
THE PRESERVE
AT CLARKSVILLE
 5th ELECTION DISTRICT HOWARD COUNTY, MD.
 PLATBOOK: 19216

A licensed Maryland Surveyor either personally prepared this Foundation Certification, or was in responsible charge over its preparation and the surveying work reflected in it, in compliance with the Maryland Minimum Standards of Practice for Land Surveyors.

I hereby certify that I have surveyed the property shown hereon for the sole purpose of locating the improvements. This plan is a benefit to the consumer only in so far as it is required by a lender or a title insurance company or its agent in connection with contemplated transfer, financing or refinancing. It is not to be relied upon for the establishment of boundary, easement or right-of-way lines for any reason, such as the location of fences, garages, buildings, or other existing or future improvements.

By Dennis E. Meckley Date 6/12/08
 Dennis E. Meckley Property Line Surveyor No. 10844

	DRAWN BY: CDD
	DESIGN BY:
	REVIEW BY: DEM
	DATE: 1/28/08
	SCALE: 1"=50'
	JOB NO: 2007035
WESTMINSTER OFFICE: 439 East Main Street Westminster, MD 21157-5539 (410) 848-1790 FAX (410) 848-1791	SHEET: 1 OF 1