

C1 0285

SEQUENCE NO. (MDE USE ONLY)

STATE OF MARYLAND WELL COMPLETION REPORT

THIS REPORT MUST BE SUBMITTED WITHIN 45 DAYS AFTER WELL IS COMPLETED.

1 2 3 6 (THIS NUMBER IS TO BE PUNCHED IN COLS. 3-6 ON ALL CARDS)

COUNTY NUMBER 13 A35198

ST/CO USE ONLY DATE RECEIVED

DATE WELL COMPLETED

Depth of Well

PERMIT NO. FROM "PERMIT TO DRILL WELL" 40-95-0397

OWNER C Cunningham Thomas STREET OR RFD 1140 Homewood Road TOWN Ellicott City SUBDIVISION Point of Homewood SECTION LOT 13

WELL LOG

GROUTING RECORD

C 3

Not required for driven wells

WELL HAS BEEN GROUTED (Circle Appropriate Box)

yes no Y N 44 44

STATE THE KIND OF FORMATIONS PENETRATED, THEIR COLOR, DEPTH, THICKNESS AND IF WATER BEARING

TYPE OF GROUTING MATERIAL (Circle one)

CEMENT CM BENTONITE CLAY BCI

NO. OF BAGS 24 NO. OF POUNDS 1300

GALLONS OF WATER 480

DEPTH OF GROUT SEAL (to nearest foot) from 0 ft. to 400 ft.

PUMPING TEST

HOURS PUMPED (nearest hour) 8

PUMPING RATE (gal. per min.) 11 15

METHOD USED TO MEASURE PUMPING RATE

WATER LEVEL (distance from land surface)

BEFORE PUMPING 17 20 ft.

WHEN PUMPING 22 25 ft.

TYPE OF PUMP USED (for test)

A air P piston T turbine C centrifugal R rotary O other J jet S submersible

Table with columns: DESCRIPTION, FEET (FROM, TO), check if water bearing. Includes entries for dirt, soft brown, hard gray rock, etc.

CASING RECORD ST CO PL OT STEEL CONCRETE PLASTIC OTHER

MAIN CASING TYPE Nominal diameter top (main) casing Total depth of main casing

OTHER CASING (if used) diameter depth (feet)

SCREEN RECORD ST BR HO PL OT STEEL BRASS BRONZE PLASTIC OPEN HOLE OTHER

C 2 DEPTH (nearest ft.)

Table with columns: E A C H S C R E E S L O T S I Z E 1 2 3

DIAMETER OF SCREEN (NEAREST INCH) from 58 to 60

GRAVEL PACK IF WELL DRILLED WAS FLOWING WELL INSERT F IN BOX 68

MDE USE ONLY (NOT TO BE FILLED IN BY DRILLER) T (E.R.O.S.) W Q

70 72 74 75 76 TELESCOPE CASING LOG INDICATOR OTHER DATA

PUMP INSTALLED DRILLER INSTALLED PUMP (CIRCLE) (YES or NO)

IF DRILLER INSTALLS PUMP, THIS SECTION MUST BE COMPLETED FOR ALL WELLS.

TYPE OF PUMP INSTALLED PLACE (A,C,J,R,R,S,T,O) IN BOX 29

CAPACITY: GALLONS PER MINUTE (to nearest gallon) 31 35

PUMP HORSE POWER 37 41

PUMP COLUMN LENGTH (nearest ft.) 43 47

CASING HEIGHT (circle appropriate box and enter casing height) LAND SURFACE (nearest foot)

LOCATION OF WELL ON LOT SHOW PERMANENT STRUCTURE SUCH AS BUILDING, SEPTIC TANKS, AND /OR LANDMARKS AND INDICATE NOT LESS THAN TWO DISTANCES (MEASUREMENTS TO WELL)

NUMBER OF UNSUCCESSFUL WELLS: 0

WELL HYDROFRACTURED Y N

CIRCLE APPROPRIATE LETTER A WELL WAS ABANDONED AND SEALED WHEN THIS WELL WAS COMPLETED

I HEREBY CERTIFY THAT THIS WELL HAS BEEN CONSTRUCTED IN ACCORDANCE WITH COMAR 26.04.04 "WELL CONSTRUCTION"

DRILLERS LIC. NO. MW D 304 David Kelly

LIC. NO. MW D 564

SITE SUPERVISOR (sign. of driller or journeyman responsible for sitework if different from permittee)



C1 3048

SEQUENCE NO. (MDE USE ONLY)

STATE OF MARYLAND WELL COMPLETION REPORT

THIS REPORT MUST BE SUBMITTED WITHIN 45 DAYS AFTER WELL IS COMPLETED.

(THIS NUMBER IS TO BE PUNCHED IN COLS. 3-6 ON ALL CARDS)

COUNTY NUMBER

ST/CO USE ONLY DATE RECEIVED

DATE WELL COMPLETED

Depth of Well

PERMIT NO. FROM "PERMIT TO DRILL WELL"

OWNER, STREET OR RFD, TOWN, SUBDIVISION, SECTION, LOT

WELL LOG Not required for driven wells

STATE THE KIND OF FORMATIONS PENETRATED, THEIR COLOR, DEPTH, THICKNESS AND IF WATER BEARING

Table with columns: DESCRIPTION, FEET (FROM, TO), check if water bearing. Includes handwritten entries like 'dirt', 'soft brown w/ gravel', 'hard gray rock'.

GRROUTING RECORD

WELL HAS BEEN GROUTED (Y/N), TYPE OF GROUTING MATERIAL (CEMENT/BENTONITE CLAY), NO. OF BAGS, NO. OF POUNDS, GALLONS OF WATER, DEPTH OF GROUT SEAL

CASING RECORD (ST/CO/PL/OT), MAIN CASING TYPE, Nominal diameter, Total depth

OTHER CASING (if used) diameter, depth

SCREEN RECORD (ST/BR/PL/HO/OT), screen type or open hole

DEPTH (nearest ft.) table with columns 1-21 and rows E, A, C, H, S, R, E, E, N

PUMPING TEST

HOURS PUMPED, PUMPING RATE, METHOD USED TO MEASURE PUMPING RATE, WATER LEVEL, BEFORE PUMPING, WHEN PUMPING, TYPE OF PUMP USED

PUMP INSTALLED

DRILLER INSTALLED PUMP (YES/NO), TYPE OF PUMP INSTALLED, CAPACITY: GALLONS PER MINUTE, PUMP HORSE POWER, PUMP COLUMN LENGTH, CASING HEIGHT

LOCATION OF WELL ON LOT SHOW PERMANENT STRUCTURE SUCH AS BUILDING, SEPTIC TANKS, AND/OR LANDMARKS



NUMBER OF UNSUCCESSFUL WELLS: 0

WELL HYDROFRACTURED (Y/N)

CIRCLE APPROPRIATE LETTER A, E, P

I HEREBY CERTIFY THAT THIS WELL HAS BEEN CONSTRUCTED IN ACCORDANCE WITH COMAR 26.04.04

DRILLERS LIC. NO. 1 MWD 304, DRILLERS SIGNATURE, LIC. NO. 1 MWD 564

SITE SUPERVISOR (sign. of driller or journeyman responsible for sitework)

DEPTH (nearest ft.)

DEPTH (nearest ft.) table with columns 1-21 and rows E, A, C, H, S, R, E, E, N

DIAMETER OF SCREEN (NEAREST INCH) from to

GRAVEL PACK IF WELL DRILLED WAS FLOWING WELL INSERT F IN BOX 68

MDE USE ONLY (NOT TO BE FILLED IN BY DRILLER)

TELESCOPE CASING, LOG INDICATOR, OTHER DATA

C1 3049

SEQUENCE NO. (MDE USE ONLY)

STATE OF MARYLAND WELL COMPLETION REPORT

THIS REPORT MUST BE SUBMITTED WITHIN 45 DAYS AFTER WELL IS COMPLETED.

(THIS NUMBER IS TO BE PUNCHED IN COLS. 3-6 ON ALL CARDS)

COUNTY NUMBER

DATE RECEIVED MM DD YY

DATE WELL COMPLETED MM DD YY

DEPTH OF WELL (TO NEAREST FOOT)

PERMIT NO. FROM "PERMIT TO DRILL WELL"

OWNER, STREET OR RFD, TOWN, SUBDIVISION, SECTION, LOT

WELL LOG table with columns: DESCRIPTION, FEET (FROM, TO), check if water bearing

GROUTING RECORD: WELL HAS BEEN GROUTED, TYPE OF GROUTING MATERIAL, CEMENT, BENTONITE CLAY, NO. OF BAGS, NO. OF POUNDS, GALLONS OF WATER, DEPTH OF GROUT SEAL

CASING RECORD: MAIN CASING TYPE, Nominal diameter top (main) casing, Total depth of main casing

OTHER CASING (if used) diameter, depth (feet)

SCREEN RECORD: screen type or open hole, insert appropriate code below

NUMBER OF UNSUCCESSFUL WELLS

WELL HYDROFRACTURED

CIRCLE APPROPRIATE LETTER: A, E, P

I HEREBY CERTIFY THAT THIS WELL HAS BEEN CONSTRUCTED IN ACCORDANCE WITH COMAR 26.04.04

DRILLERS LIC. NO., DRILLERS SIGNATURE, LIC. NO.

SITE SUPERVISOR (sign. of driller or journeyman responsible for sitework if different from permittee)

DEPTH (nearest ft.) table with columns: 1, 2, 3, 79, 80


GRAVEL PACK IF WELL DRILLED WAS FLOWING WELL INSERT F IN BOX 68

MDE USE ONLY (NOT TO BE FILLED IN BY DRILLER)

TELESCOPE CASING, LOG INDICATOR, OTHER DATA

PUMPING TEST: HOURS PUMPED, PUMPING RATE, METHOD USED TO MEASURE PUMPING RATE, WATER LEVEL, BEFORE PUMPING, WHEN PUMPING, TYPE OF PUMP USED

PUMP INSTALLED: DRILLER INSTALLED PUMP, TYPE OF PUMP INSTALLED, CAPACITY: GALLONS PER MINUTE, PUMP HORSE POWER, PUMP COLUMN LENGTH, CASING HEIGHT, LAND SURFACE

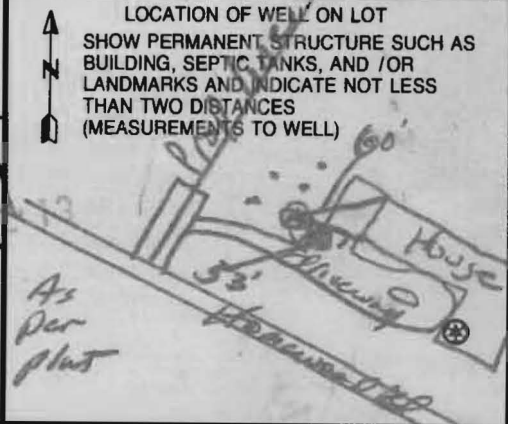

C 1 3050

SEQUENCE NO. (MDE USE ONLY)

STATE OF MARYLAND WELL COMPLETION REPORT FILL IN THIS FORM COMPLETELY PLEASE TYPE

THIS REPORT MUST BE SUBMITTED WITHIN 45 DAYS AFTER WELL IS COMPLETED.

COUNTY NUMBER

(THIS NUMBER IS TO BE PUNCHED IN COLS. 3-6 ON ALL CARDS)

ST/CO USE ONLY DATE RECEIVED MM DD YY

DATE WELL COMPLETED MM DD YY

Depth of Well

PERMIT NO. FROM "PERMIT TO DRILL WELL"

OWNER, STREET OR RFD, TOWN, SUBDIVISION, SECTION, LOT

WELL LOG Not required for driven wells

STATE THE KIND OF FORMATIONS PENETRATED, THEIR COLOR, DEPTH, THICKNESS AND IF WATER BEARING

Table with columns: DESCRIPTION, FEET (FROM, TO), check if water bearing. Includes handwritten entries like 'dirt', 'soft brown w/ gravel', 'hard gray rock', etc.

GROUTING RECORD

WELL HAS BEEN GROUTED (Y/N), TYPE OF GROUTING MATERIAL (CEMENT/BENTONITE CLAY), NO. OF BAGS, NO. OF POUNDS, GALLONS OF WATER, DEPTH OF GROUT SEAL

CASING RECORD

MAIN CASING TYPE (ST/PL), Nominal diameter top (main) casing, Total depth of main casing

OTHER CASING (if used) diameter, depth

SCREEN RECORD

screen type or open hole (ST/BR/PL, HO/OT), DEPTH (nearest ft.)

PUMPING TEST

HOURS PUMPED, PUMPING RATE, METHOD USED TO MEASURE PUMPING RATE, WATER LEVEL, TYPE OF PUMP USED

PUMP INSTALLED

DRILLER INSTALLED PUMP (YES/NO), TYPE OF PUMP INSTALLED PLACE, CAPACITY: GALLONS PER MINUTE, PUMP HORSE POWER, PUMP COLUMN LENGTH, CASING HEIGHT

NUMBER OF UNSUCCESSFUL WELLS

WELL HYDROFRACTURED (Y/N)

CIRCLE APPROPRIATE LETTER: A (abandoned), E (electric log), P (production well)

I HEREBY CERTIFY THAT THIS WELL HAS BEEN CONSTRUCTED IN ACCORDANCE WITH COMAR 26.04.04 "WELL CONSTRUCTION"

DRILLERS LIC. NO. 1 MWD 304

DRILLERS SIGNATURE (Matt Wolfitt), LIC. NO. 1 MWD 564


SITE SUPERVISOR (sign. of driller or journeyman responsible for sitework if different from permittee)

GRAVEL PACK IF WELL DRILLED WAS FLOWING WELL INSERT F IN BOX 68

MDE USE ONLY (NOT TO BE FILLED IN BY DRILLER) T (E.R.O.S.) W Q

TELESCOPE CASING, LOG INDICATOR, OTHER DATA

LOCATION OF WELL ON LOT SHOW PERMANENT STRUCTURE SUCH AS BUILDING, SEPTIC TANKS, AND /OR LANDMARKS AND INDICATE NOT LESS THAN TWO DISTANCES (MEASUREMENTS TO WELL)

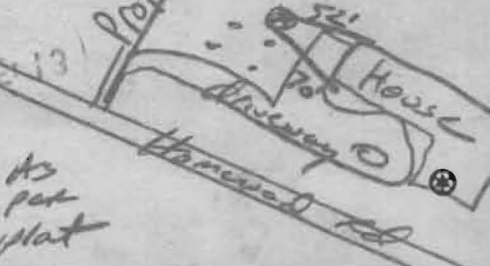

C1 3051

SEQUENCE NO. (MDE USE ONLY)

STATE OF MARYLAND WELL COMPLETION REPORT

THIS REPORT MUST BE SUBMITTED WITHIN 45 DAYS AFTER WELL IS COMPLETED.

(THIS NUMBER IS TO BE PUNCHED IN COLS. 3-6 ON ALL CARDS)

COUNTY NUMBER

ST/CO USE ONLY DATE RECEIVED

DATE WELL COMPLETED

Depth of Well

PERMIT NO. FROM "PERMIT TO DRILL WELL"

OWNER, STREET OR RFD, TOWN, SUBDIVISION, SECTION, LOT

WELL LOG

Not required for driven wells

STATE THE KIND OF FORMATIONS PENETRATED, THEIR COLOR, DEPTH, THICKNESS AND IF WATER BEARING

Table with columns: DESCRIPTION, FEET (FROM, TO), check if water bearing. Includes entries like dirt, silt, gravel, hard gray rock, soft fractured brown rock, etc.

GROUTING RECORD

WELL HAS BEEN GROUTED (Circle Appropriate Box), TYPE OF GROUTING MATERIAL (Circle one), CEMENT, BENTONITE CLAY, NO. OF BAGS, NO. OF POUNDS, GALLONS OF WATER, DEPTH OF GROUT SEAL

CASING RECORD

MAIN CASING TYPE, Nominal diameter top (main) casing, Total depth of main casing

OTHER CASING (if used) diameter, depth

SCREEN RECORD

DEPTH (nearest ft.)

Table with columns: Casing type (A, C, S, R, E, N), Slot size, Diameter of screen

GRAVEL PACK IF WELL DRILLED WAS FLOWING WELL, MDE USE ONLY (NOT TO BE FILLED IN BY DRILLER)


TELESCOPE CASING, LOG INDICATOR, OTHER DATA

PUMPING TEST

HOURS PUMPED, PUMPING RATE, METHOD USED TO MEASURE PUMPING RATE, WATER LEVEL (distance from land surface) BEFORE PUMPING, WHEN PUMPING, TYPE OF PUMP USED

PUMP INSTALLED

DRILLER INSTALLED PUMP (CIRCLE) YES or NO, IF DRILLER INSTALLS PUMP, THIS SECTION MUST BE COMPLETED FOR ALL WELLS, TYPE OF PUMP INSTALLED PLACE (A,C,J,P,R,S,T,O) IN BOX 29, CAPACITY: GALLONS PER MINUTE, PUMP HORSE POWER, PUMP COLUMN LENGTH, CASING HEIGHT, LAND SURFACE

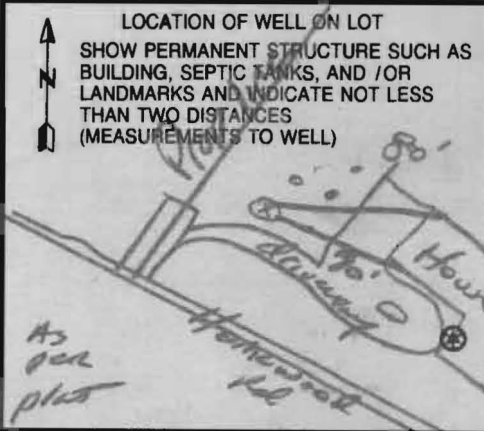

NUMBER OF UNSUCCESSFUL WELLS:

WELL HYDROFRACTURED

CIRCLE APPROPRIATE LETTER A WELL WAS ABANDONED AND SEALED WHEN THIS WELL WAS COMPLETED

I HEREBY CERTIFY THAT THIS WELL HAS BEEN CONSTRUCTED IN ACCORDANCE WITH COMAR 26.04.04 "WELL CONSTRUCTION" AND IN CONFORMANCE WITH ALL CONDITIONS STATED IN THE ABOVE CAPTIONED PERMIT, AND THAT THE INFORMATION PRESENTED HEREIN IS ACCURATE AND COMPLETE TO THE BEST OF MY KNOWLEDGE.

DRILLERS LIC. NO. 1 MWD 304, DRILLERS SIGNATURE

LIC. NO. 1 MWD 564

SITE SUPERVISOR (sign. of driller or journeyman responsible for sitework if different from permittee)

B 1 1715

SEQUENCE NO. (MDE USE ONLY)


STATE OF MARYLAND APPLICATION FOR PERMIT TO DRILL WELL 524469 please type

STATE PERMIT NUMBER Ho-95-0397 fill in this form completely

OWNER INFORMATION Date Received (APA) 8 MM DD YY 13 Cunningham Tom 15 Last Name Owner First Name 34 11140 Homewood Rd. 36 Street or RFD 55 37 Ellicott City MD 21042 57 Town 70 State 72 Zip 76

LOCATION OF WELL B 3 Howard 8 COUNTY 21 Point of Homewood 23 SUBDIVISION 42 SECTION 44 46 LOT 13 48 50 Clarksville 52 NEAREST TOWN 71 MILES FROM TOWN (enter 0 if in town) 3 M I 73 76 77 78

DRILLER INFORMATION DAVID KELLY 410-921-6981 MW D 304 76 License No. 81 Jones Well Drilling Inc. 3700 Kush Rd. Jarrettsville, MD 21084 37 Address David Kelly 5/12/06 38 Signature Date

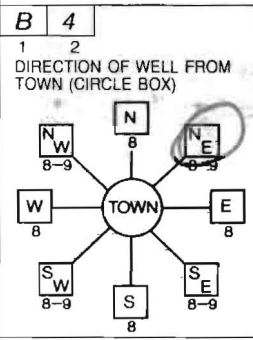

11140 Homewood Rd. 11 NEAR WHAT ROAD 30 ON WHICH SIDE OF ROAD (CIRCLE APPROPRIATE BOX) 34 150 37 DISTANCE FROM ROAD FT 38 39 ENTER FT OR MI TAX MAP: 29 BLK: 10 PARCEL 279

WELL INFORMATION B 2 APPROX. PUMPING RATE (GAL. PER MIN.) 8 0 12 AVERAGE DAILY QUANTITY NEEDED (GAL. PER DAY) 14 0 20

USE FOR WATER (CIRCLE APPROPRIATE BOX) D DOMESTIC POTABLE SUPPLY & RESIDENTIAL IRRIGATION F FARMING (LIVESTOCK WATERING & AGRICULTURAL IRRIGATION) I INDUSTRIAL, COMMERCIAL, DEWATERING P PUBLIC WATER SUPPLY WELL T TEST, OBSERVATION, MONITORING G GEO-THERMAL 4 holes closed loop


NOT TO BE FILLED IN BY DRILLER HEALTH DEPARTMENT APPROVAL Howard (13) A35198 COUNTY NAME COUNTY NO. STATE SIGNATURE INSERT S DATE ISSUED 5/31/06 Brian Baker 5/31/2007 43 MM DD YY 48 CO SIGNATURE EXP. DATE NORTH GRID 511 000 EAST GRID 828 000 50 55 57 63

APPROXIMATE DEPTH OF WELL 400 24 28 FEET APPROXIMATE DIAMETER OF WELL 6 28 INCH NEAREST INCH

SHOW MAJOR FEATURES OF BOX & LOCATE WELL WITH AN X SOURCES OF DRILLING WATER 1. 2. 3. WRITE THE BOX NUMBER FROM THE MAP HERE E 828 N 511 000 000

METHOD OF DRILLING (circle one) BORED (or Augered) JETTED Jetted & DRIVEN AIR-ROTary AIR-PERCussion ROTARY (Hydraulic Rotary) 30 CABLE REVERSE-ROTary DRIVE-POINT 37 other


REPLACEMENT OR DEEPEMED WELLS (CIRCLE APPROPRIATE BOX) N THIS WELL WILL NOT REPLACE AN EXISTING WELL Y THIS WELL WILL REPLACE A WELL THAT WILL BE ABANDONED AND SEALED S THIS WELL WILL REPLACE A WELL THAT WILL BE USED AS A STANDBY-CONTACT LOCAL APPROVING AUTHORITY FOR POLICY ON STANDBY WELLS D THIS WELL WILL DEEPEEN AN EXISTING WELL PERMIT NUMBER OF WELL TO BE REPLACED OR DEEPEMED (IF AVAILABLE) 41 52

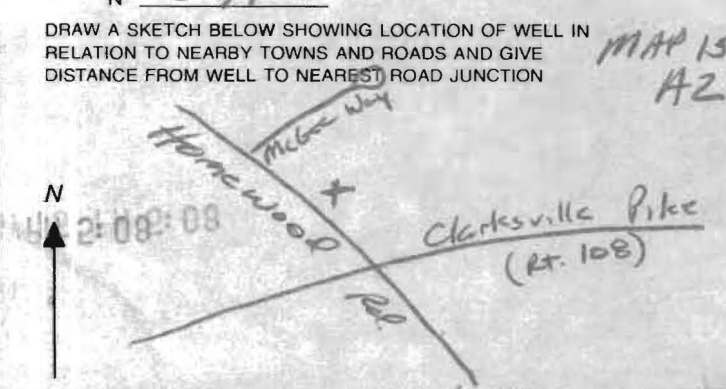

Not to be filled in by driller (MDE OR COUNTY USE ONLY) APPROP. PERMIT NUMBER G PERMIT No. Ho-95-0397 70 71 72 73 74 75 76 77 78 79

SPECIAL CONDITIONS Submit Well Completion Report For Each well 5/16/06

Scale 1" = 60'

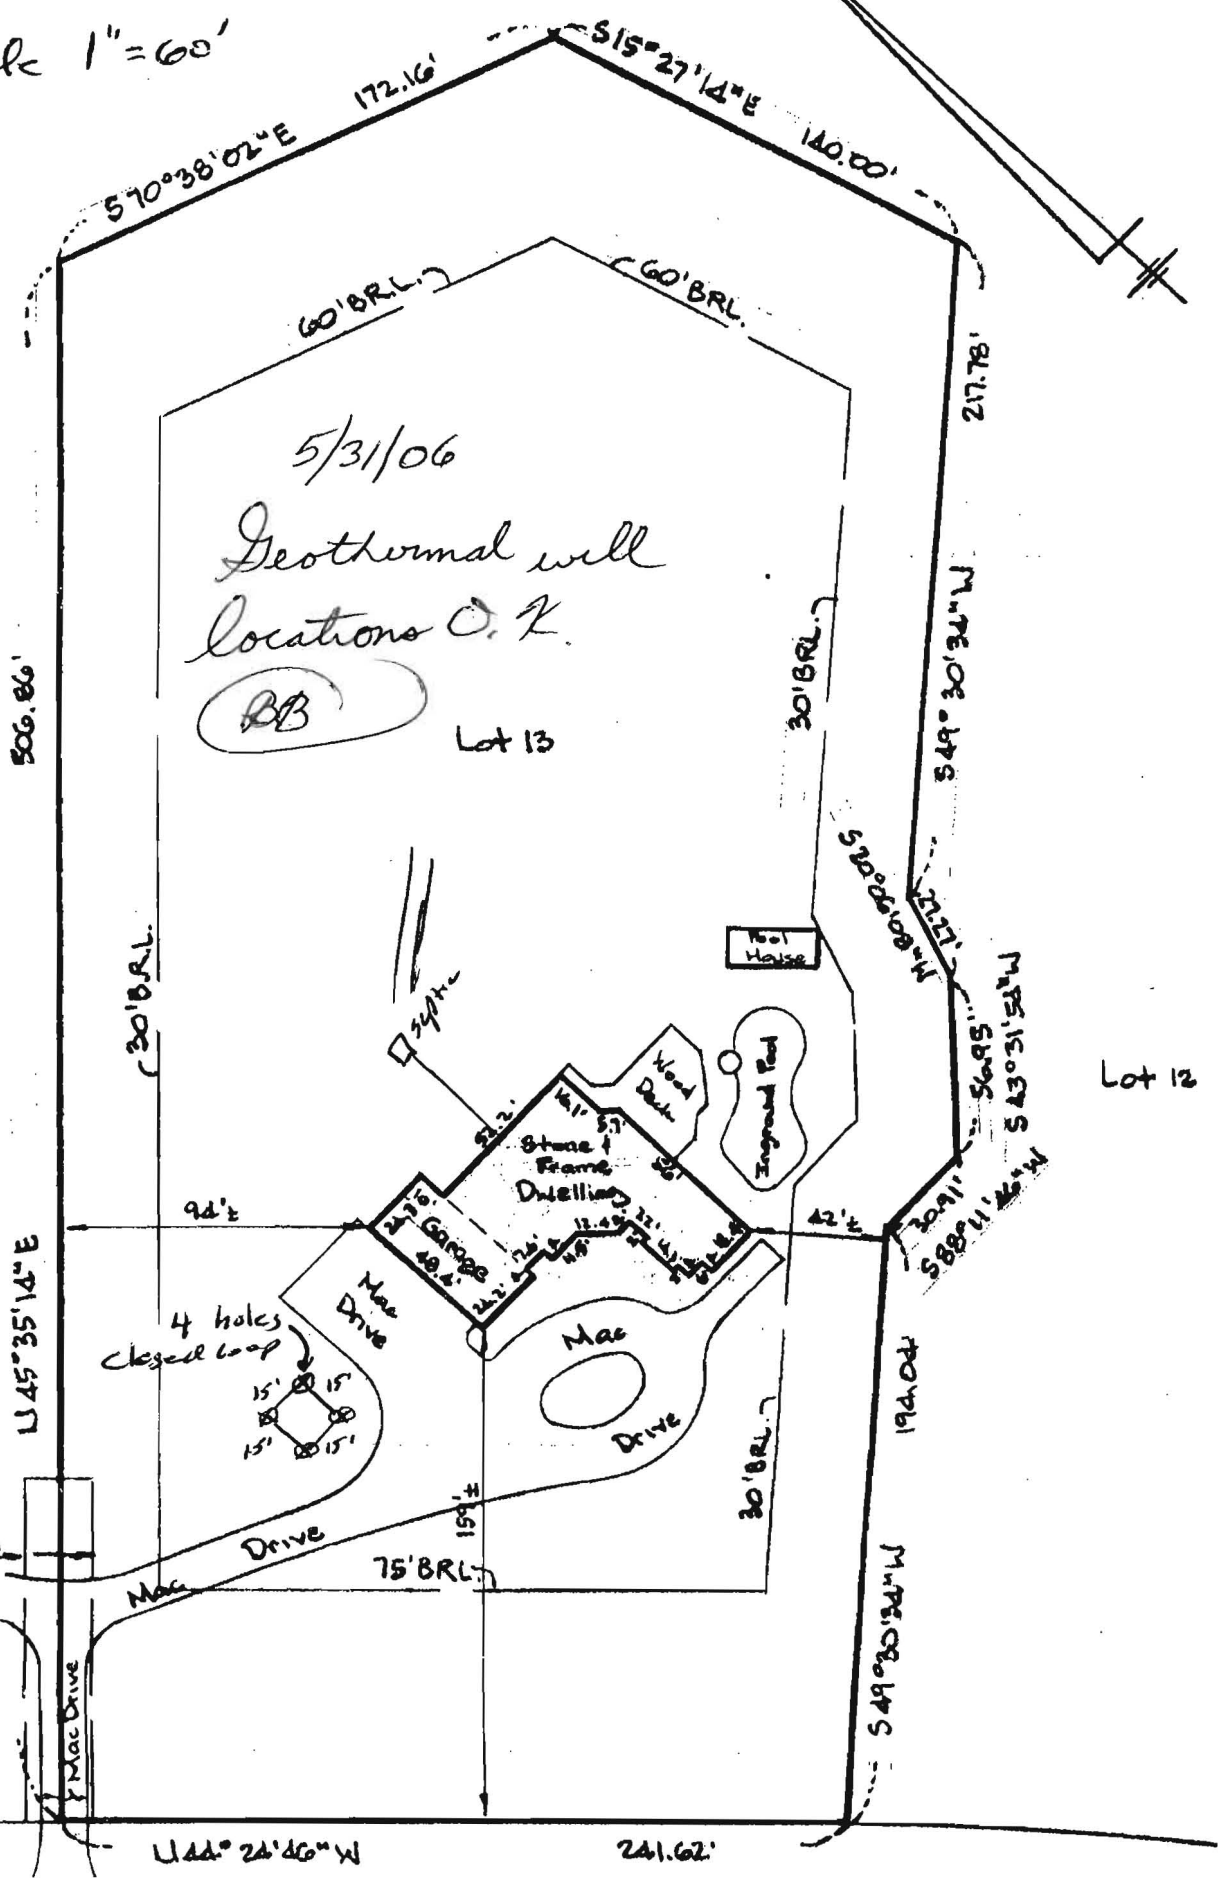

5/31/06
 Geothermal well
 locations O.K.


BB

Lot 13

Lot 7



Lot 12

20' Private Common
 Ingress & Egress
 Easement For
 Lots 7 & 13.

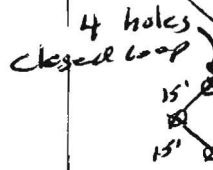

U44°24'46"W 241.62'

SCALE: 1"=30'

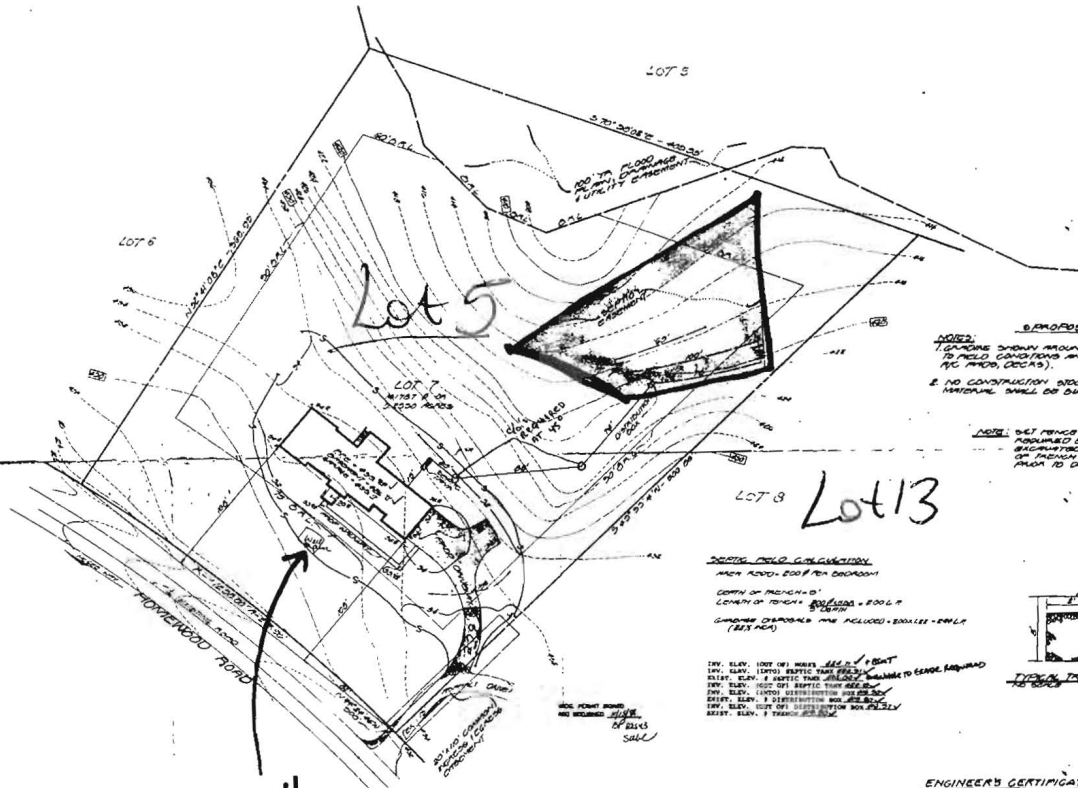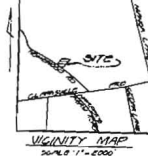


NOTES:
1. ELEVATIONS SHOWN AROUND HOUSE MAY VARY DUE TO FIELD CONDITIONS AND HOUSE "ADD-ONS" (PORCHES, ETC., PORCH, DECK, ETC.).
2. NO CONSTRUCTION DISCARPINE AROUND AN EXCESS MATERIAL SHALL BE SHOWN AT SETBACK ENCROACHMENT.

NOTE: SET BACKS ON SPRAWN CURBS SHALL BE ASSUMED BY THE SUBSCRIBER. THIS IS NOT TO BE TAKEN AS AN ENDORSEMENT OR GUARANTEE OF THE ACCURACY OF THE INFORMATION PROVIDED HEREON.

SETBACK FIELD CALCULATION
MIN. ADD. 200' PER DECK/POOR
CORNER OF TRENCH = 0'
CORNER OF TRENCH = 200' ±
CORNER OF TRENCH = 200' ±
(SEE PLAN)

INV. ELEV. 1007' (W) MARK SET 1" ± SENT
INV. ELEV. 1000' (S) MARK SET 1" ± SENT
ELEV. ELEV. 1000' (S) MARK SET 1" ± SENT
ELEV. ELEV. 1000' (S) MARK SET 1" ± SENT
ELEV. ELEV. 1000' (S) MARK SET 1" ± SENT
ELEV. ELEV. 1000' (S) MARK SET 1" ± SENT

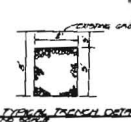

ENGINEER'S CERTIFICATE
I HEREBY CERTIFY THAT THE INFORMATION
HEREON IS TRUE AND CORRECT TO THE BEST
OF MY KNOWLEDGE.



PRINTED
OCT 9 2008

GLW GUTSCHICK LITTLE & WEBER, P.A.
ENGINEERS, PLANNERS, SURVEYORS
1000 NATIONAL DRIVE SUITE 600 BARTHOLOMEW OFFICE PARK BARTHOLOMEW, MD 20828
TELEPHONE (301) 421-4024 FAX (301) 421-4020

NO.	DATE	REVISION	BY	APP'D

DRAWN BY:
HELEN QUINN
CHECKED BY:
DAVID QUINN
DATE: 10/1/08
PHONE: (301) 421-4024


SITE PLAN
POINT OF HOMEWOOD
LOT NO. 7
3RD ELECTION DISTRICT
HOWARD COUNTY, MARYLAND

SCALE	DATE	SHEET
T-30	OCT. 08	1 OF 2

THIS LOCATION DRAWING IS OF BENEFIT TO A CONSUMER ONLY INsofar AS IT IS REQUIRED BY A LENDER OR TITLE INSURANCE COMPANY, OR ITS AGENTS, IN CONNECTION WITH FINANCING THE PROPERTY SHOWN HEREON. THIS DRAWING IS NOT TO BE RELIED UPON FOR THE ESTABLISHMENT OF PROPERTY LINES OR THE CONSTRUCTION OF IMPROVEMENTS SUCH AS FENCES, GARAGES, OR BUILDING ADDITIONS. THIS DRAWING SHOWS THE LOT CONFIGURATION AS CURRENTLY RECORDED, BEING SUFFICIENT FOR SETTLEMENT PURPOSES, BUT BEING INSUFFICIENT FOR THE SETTING OF PROPERTY CORNER PINS ON THE GROUND.

5/28/96
 Proposed pool location
 will have no impact
 to existing well
 and septic.

Ray McMill

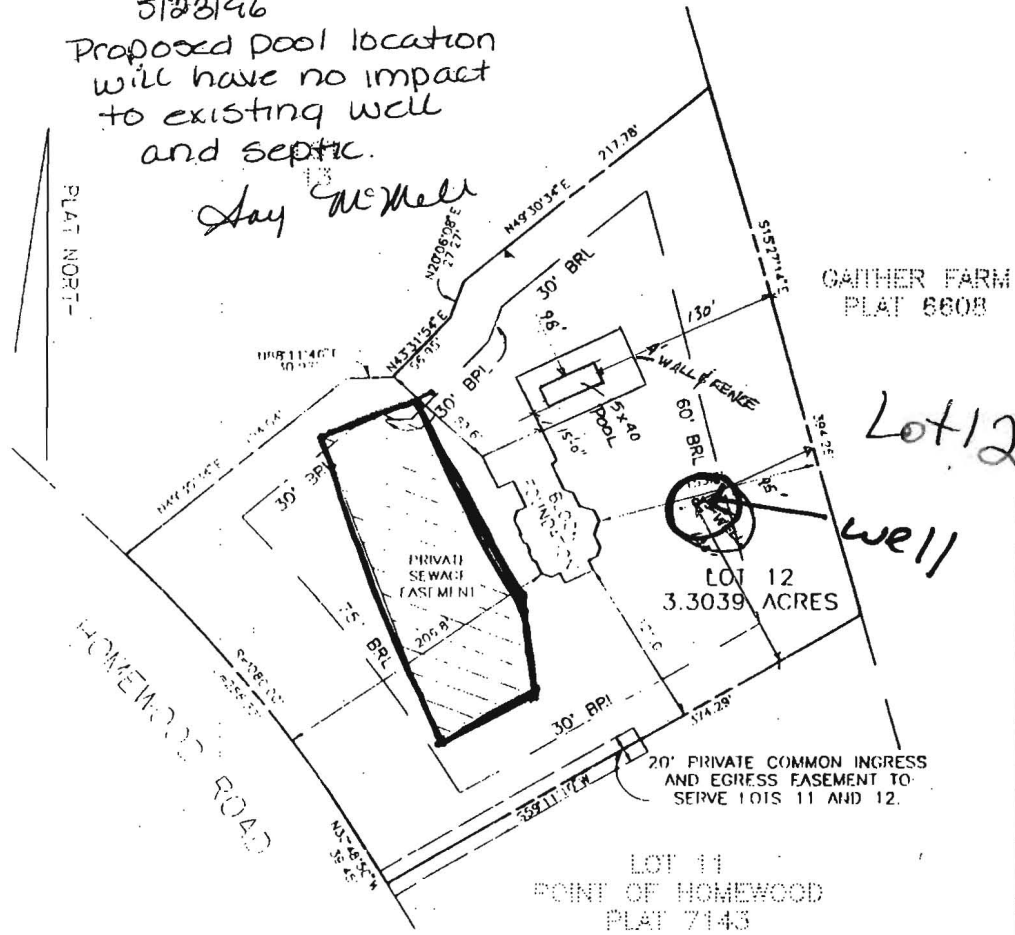

GATHER FARM
 PLAT 6608

Lot 12

Well

LOT 11
 POINT OF HOMEWOOD
 PLAT 7143

SEPTIC AREA REVEALED PER
 HOWARD COUNTY ENVIRONMENTAL
 HEALTH DEPARTMENT

TYPE OF FOUNDATION
 WALL TYPE

SURVEYOR'S CERTIFICATE


I HEREBY CERTIFY THAT THE LOCATION DRAWING
 SHOWN HEREON IS CORRECT TO THE BEST OF
 MY KNOWLEDGE AND BELIEF; THAT THE
 IMPROVEMENTS HAVE BEEN LOCATED AS THE
 PROPERTY OF A FEED SUBJECT; AND THAT THERE ARE
 NO VISIBLE ENCROACHMENTS UNLESS SHOWN. THE
 PROPERTY DOES NOT LIE WITHIN FLOOD HAZARD
 AREA ON THE FEMA (FIRM) IDENTIFIED BELOW.
 AT THE WRITTEN REQUEST OF THE PURCHASER, OR
 HERETOFOR, OTHER MODELS HAVE BEEN SET.

Ray McMill
 PETER J. DARE
 M.D. PROPERTY LINE SURVEYOR

RECORD PLAT No. B004
 FEMA FIRM No. 240644 0027 B
 DATED DEC 4, 1986

TSA GROUP, INC.

planning • architecture • engineering • surveying
 1480 BALTIMORE NATIONAL FIRE 30101 418
 ELLEBETH CITY, MARYLAND 21043
 (410) 465-6105

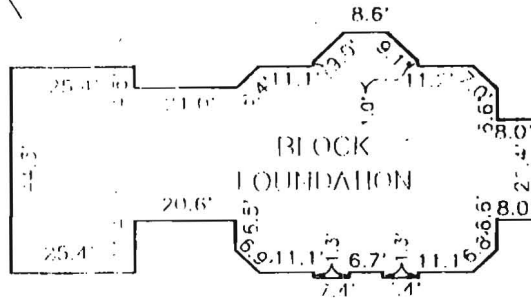

HOUSE DETAIL
 1" = 30'

LOCATION DRAWING
 RESUBDIVISION PLAT
 POINT OF HOMEWOOD
 LOTS 12 & 13
 LOT 12
 11130 HOMEWOOD ROAD

3rd ELECTION DISTRICT
 HOWARD COUNTY, MARYLAND
 SCALE: 1" = 100' DATE: 07/25/1995