

LAYOUT _____ INSP 4 _____
INSP 2 _____ INSP 5 _____
INSP 3 _____ INSP 6 _____

ISSUE DATE: 6/14/06

P 525111

APPROVAL DATE: 7/19/06

A 541569

PERMIT

INDEXED

TAX ID #05-412587

ON-SITE SEWAGE DISPOSAL SYSTEM HOWARD COUNTY HEALTH DEPARTMENT BUREAU OF ENVIRONMENTAL HEALTH

South Carroll Backhoe IS PERMITTED TO INSTALL ALTER

ADDRESS: 4410 Salem Bottom Rd, Westminster PHONE NUMBER: 410-875-4197

SUBDIVISION: K&D Stables / The Warfields LOT NUMBER: 2

ADDRESS: 14343 Howard Road PROPERTY OWNER: NVR Inc.

SEPTIC TANK CAPACITY (GALLONS): 1250 OUTLET BAFFLE FILTER REQUIRED

PUMP CHAMBER CAPACITY (GALLONS): n/a COMPARTMENTED TANK REQUIRED

NUMBER OF BEDROOMS: 4

34' x 5' trenches = 170'

SQUARE FEET PER BEDROOM: 200

LINEAR FEET OF TRENCH REQUIRED: 168 HOUSE SERVED BY PUBLIC WATER

TRENCHES:	Trench to be 2.0 feet wide. Inlet 3.0 feet below original grade. Bottom maximum depth 7.0 feet below original grade. Effective area begins at 3.0 feet below original grade. 4.0 feet of stone below distribution pipe.
LOCATION:	Install the septic system as shown on the approved building permit plan.
NOTES:	

PLANS APPROVED: KJB/Sara Fegel DATE: 4/17/06

NOTES: PERMIT VOID AFTER 2 YEARS
CONTRACTOR IS RESPONSIBLE FOR SCHEDULING A PRE-CONSTRUCTION INSPECTION FOR ALL INSTALLATIONS
WATERTIGHT SEPTIC TANKS REQUIRED
ALL PARTS OF SEPTIC SYSTEM SHALL BE 100 FEET FROM ANY WATER WELL UNLESS SPECIFICALLY AUTHORIZED
MANHOLE RISERS REQUIRED ON ALL SEPTIC TANKS AND PUMP CHAMBERS UNLESS SPECIFICALLY AUTHORIZED
CONTRACTOR RESPONSIBLE FOR COMPLIANCE WITH APPLICABLE REGULATIONS, GUIDELINES AND THE TERMS OF THIS PERMIT


**NEITHER THE HOWARD COUNTY COUNCIL NOR THE HEALTH DEPARTMENT IS
RESPONSIBLE FOR THE SUCCESSFUL OPERATION OF ANY SYSTEM
PERMITTEE RESPONSIBLE FOR OBTAINING FINAL APPROVAL ON THIS PERMIT
CALL 410-313-1771 FOR INSPECTION OF SEPTIC SYSTEM**

AS41569

NOT TO SCALE

HO-95-0151
97'

102'

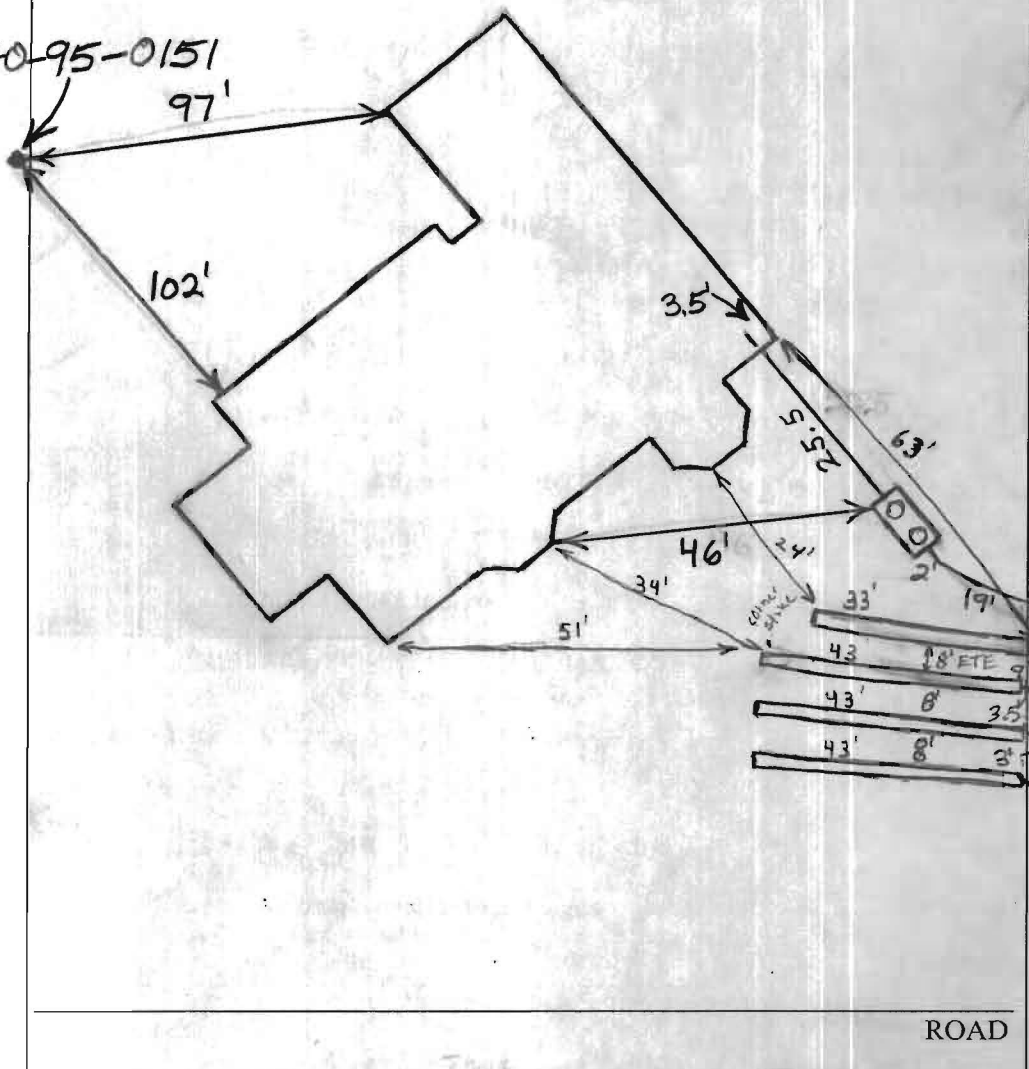

TRENCH/DRAINFIELD DATA		
WIDTH	INLET	BOTTOM
2	3	7
NUMBER OF TRENCHES		4
TOTAL LENGTH		162
ABSORPTION AREA		
DISTRIBUTION BOX LEVEL		Levelers
DISTRIBUTION BOX BAFFLE		Yes
DISTRIBUTION BOX PORT		No

SEPTIC TANK DATA	
SEPTIC TANK 1 LEVEL	Yes
CAPACITY	1500 GAL
SEAM LOC	Top
TANK LID DEPTH	1'-2'
BAFFLES	Yes
BAFFLE FILTER	No
MANHOLE LOC	Both
6" PORT LOC	Front & Rear
WATERTIGHT TEST	No
SEPTIC TANK 2 LEVEL	N/A
CAPACITY	
SEAM LOC	
TANK LID DEPTH	
BAFFLES	
BAFFLE FILTER	
MANHOLE LOC	
6" PORT LOC	
WATERTIGHT TEST	

2-Comp. Babylon


PRE-CONSTRUCTION 7/14/06 Tank set. (BB) 7/17/06 South Carroll to install 5 short trenches in small upper section of septic easement
 INSTALLATION just downhill of septic tank. See drawing on building permit plan. (BB) 7/18/06 - Follow up - Installer put 4 short trenches (slightly out of area on far side. Only 6' short of design specs. OK. Need to install D-Box & line from tank to trenches. (CAC)
 7/19/06 System finished. O.K. to backfill. (BB)

FINAL INSPECTOR B. Baker DATE OF APPROVAL 7/19/06


GENERAL NOTES:

- 1) THIS LOCATION DRAWING IS PREPARED FOR THE BENEFIT OF THE CLIENT SIGNING THE HOUSE LOCATION SURVEY APPROVAL FORM INsofar AS IT IS REQUIRED BY A LENDER OR TITLE INSURANCE COMPANY OR ITS AGENTS IN CONNECTION WITH THE CONTEMPLATED TRANSFER, FINANCING OR REFINANCING OF THE PROPERTY SHOWN HEREON. UNLESS INDICATED AS BEING A BOUNDARY SURVEY, THIS LOCATION DRAWING IS NOT INTENDED FOR USE IN THE ESTABLISHMENT OF PROPERTY LINES AND IS NOT TO BE RELIED UPON FOR THE ESTABLISHMENT OR LOCATIONS OF FENCES, GARAGES, BUILDINGS OR OTHER EXISTING OR FUTURE IMPROVEMENTS. AS A RESULT, THIS LOCATION DRAWING DOES NOT PROVIDE FOR ACCURATE IDENTIFICATION OF PROPERTY LINES, BUT SUCH IDENTIFICATION MAY NOT BE REQUIRED FOR THE TRANSFER OF TITLE OR SECURING FINANCING FOR RE-FINANCING.
- 2) SUBJECT PROPERTY IS SHOWN IN ZONE C ON THE NATIONAL FLOOD INSURANCE PROGRAM FLOOD INSURANCE RATE MAP OF HOWARD COUNTY, MARYLAND, COMMUNITY PANEL No. 2400440020B EFFECTIVE DEC. 4, 1986.
- 3) THE OFFSETS FROM BUILDING LINE TO PROPERTY LINE AS SHOWN ON THE PLAT HEREON ARE TO AN ACCURACY OF PLUS OR MINUS 1.0' (+)
- 4) NO TITLE REPORT FURNISHED. SUBJECT TO ALL EASEMENTS, RIGHTS OF WAY AND CONDITIONS OF RECORD.
- 5) THE EXISTING WELL(S) SHOWN ON THIS PLAN (IDENTIFIED WITH THE ATTACHED WELL TAG NUMBER HO- 95-0151) HAS BEEN FIELD LOCATED BY FISHER, COLLINS AND CARTER, INC. PROFESSIONAL LAND SURVEYORS AND IS ACCURATELY SHOWN.

3/11/06 O.K.
M. Davis

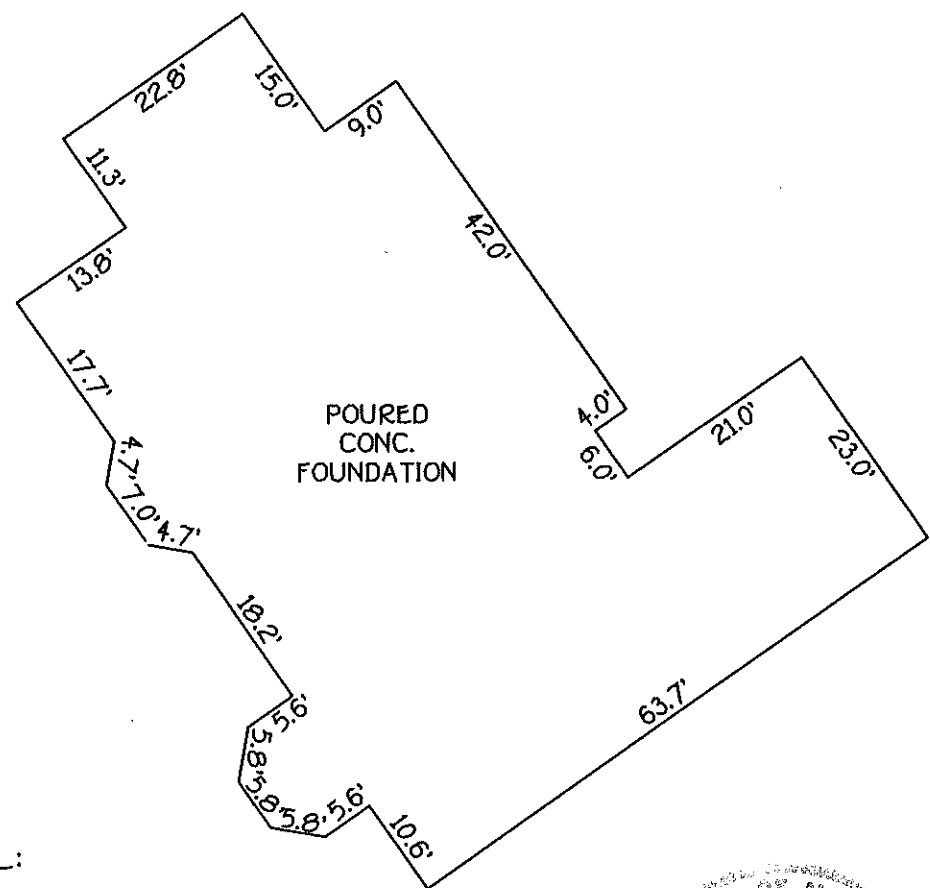


DETAIL:
1"=20'

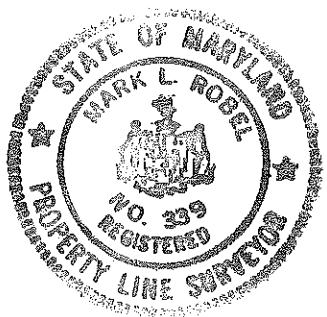

Mark L. Robel 5/31/06
PROFESSIONAL LAND SURVEYOR DATE
REG. # 339



Use-In-Common Access Easement
Across Lots 2, 3 & 4 of Warfield
Brothers For The Use And
Benefit Of Warfield Brothers
Lots 2 & 3 And K&D Stables,
Lots 1-4. Maintenance Agreement
recorded Among The Land
Records Of Howard
County, Maryland.

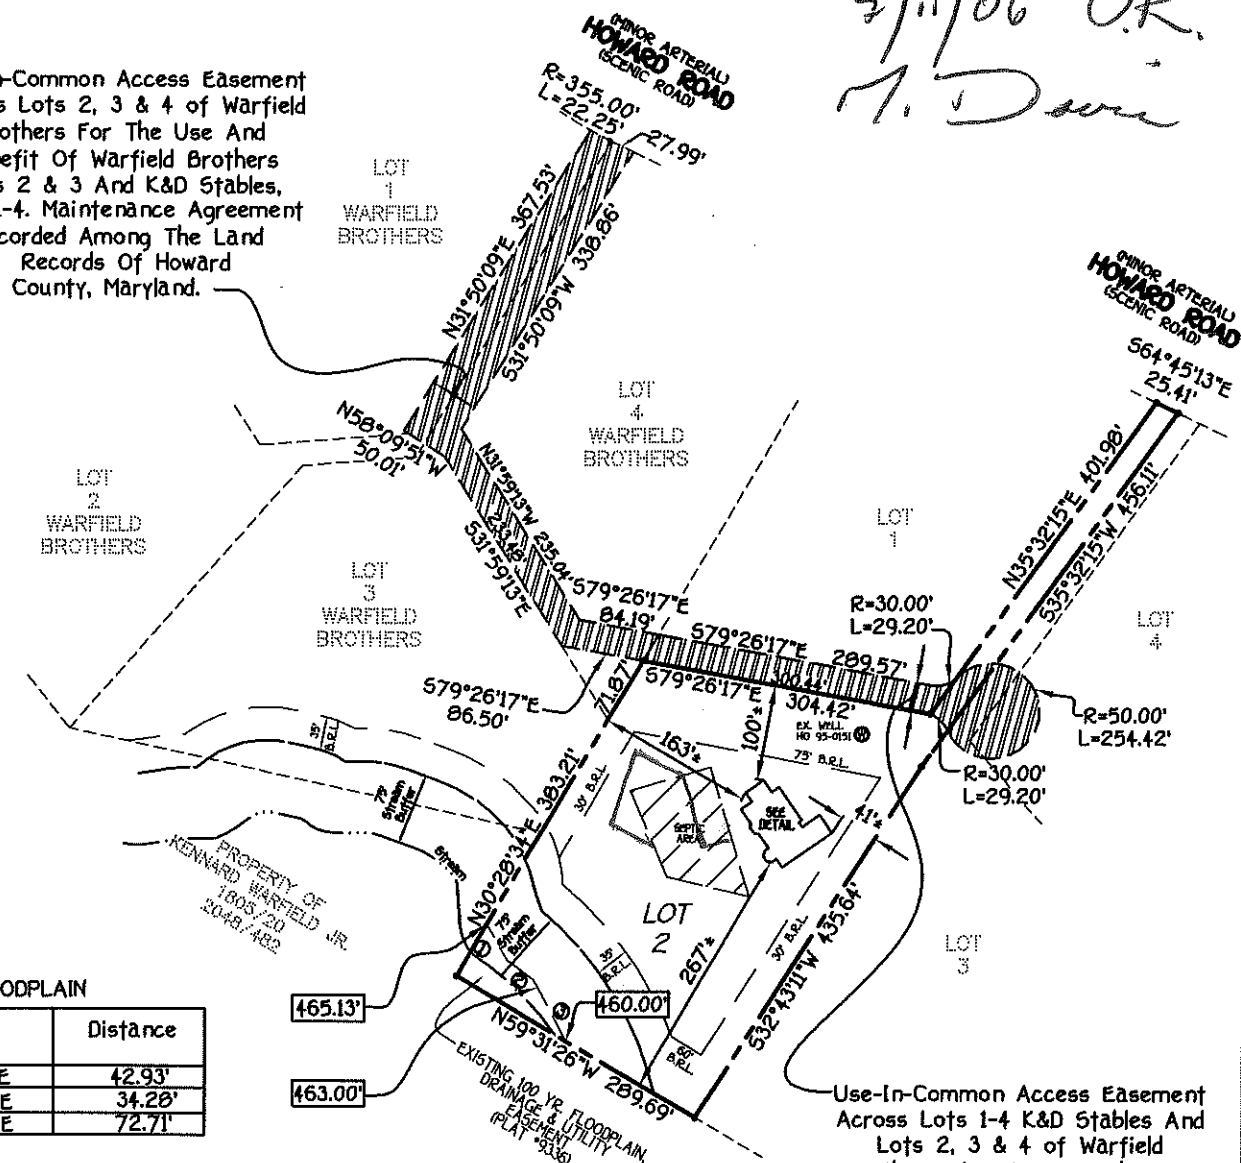

100 YEAR FLOODPLAIN

No.	Bearing	Distance
1	S29°33'07"E	42.93'
2	S54°02'28"E	34.28'
3	S28°27'54"E	72.71'

Use-In-Common Access Easement
Across Lots 1-4 K&D Stables And
Lots 2, 3 & 4 of Warfield
Brothers Plat No. For The Use
And Benefit Of K&D Stables Lots
1-4 And Warfield Brothers
Lots 2 & 3 Plat No. .
Maintenance Agreement Recorded
Among The Land Records Of
Howard County, Maryland.

LOT 2
REVISION PLAT
K & D STABLES
LOTS 1 THRU 4
(A REVISION PLAT OF K & D
STABLES, LOTS 1 THRU 4,
PLAT *9336)
FIFTH ELECTION DISTRICT
HOWARD COUNTY, MARYLAND
PLAT *

**HOUSE LOCATION
DRAWING**

FOUNDATION LOCATION: 5/11/06
FINAL LOCATION: _____
BOUNDARY SURVEY: _____

SCALE: 1"=200'
DATE: 05/31/06
DRAWN BY: VLJ
CHECKED BY: MLR
PROJECT No.: 05064-1002

XX.XX DENOTES 100 YR. FLOODPLAIN ELEV.
• HOWARD ROAD
B.R.L.= BUILDING RESTRICTION LINE
TOP OF FOUNDATION ELEV.= 526.2'+