

LAYOUT _____ INSP 4 _____
INSP 2 _____ INSP 5 _____
INSP 3 _____ INSP 6 _____

ISSUE DATE: 4/6/2006

APPROVAL DATE: 6/27/06

PERMIT
INDEXED
TAX ID #05-411505

P 524392

A 541576

ON-SITE SEWAGE DISPOSAL SYSTEM
HOWARD COUNTY HEALTH DEPARTMENT
BUREAU OF ENVIRONMENTAL HEALTH

South Carroll Backhoe IS PERMITTED TO INSTALL ALTER

ADDRESS: 4410 Salem Bottom Road PHONE NUMBER: 410-875-4197

SUBDIVISION: Warfield Brothers LOT NUMBER: 1

ADDRESS: 14373 Howard Road PROPERTY OWNER: NVR Inc.

SEPTIC TANK CAPACITY (GALLONS): 1500 OUTLET BAFFLE FILTER REQUIRED

PUMP CHAMBER CAPACITY (GALLONS) n/a COMPARTMENTED TANK REQUIRED

NUMBER OF BEDROOMS: 5

SQUARE FEET PER BEDROOM: 180

LINEAR FEET OF TRENCH REQUIRED: 186 HOUSE SERVED BY PUBLIC WATER


TRENCHES:	Trench to be 3.0 feet wide. Inlet 3.0 feet below original grade. Bottom maximum depth 7.0 feet below original grade. Effective area begins at 5.0 feet below original grade. 4.0 feet of stone below distribution pipe.
LOCATION:	Place the distribution box as shown on the approved building permit plan. Run 3 65' length trenches on contour in both directions at the top of the approved SDA. 12' center to center. No new construction to be permitted without evidence of proper abandonment.
NOTES:	

PLANS APPROVED: Sara Fegel Reviewed by: _____ DATE: 2/9/06

NOTES: PERMIT VOID AFTER 2 YEARS
CONTRACTOR IS RESPONSIBLE FOR SCHEDULING A PRE-CONSTRUCTION INSPECTION FOR ALL INSTALLATIONS
WATERTIGHT SEPTIC TANKS REQUIRED
ALL PARTS OF SEPTIC SYSTEM SHALL BE 100 FEET FROM ANY WATER WELL UNLESS SPECIFICALLY AUTHORIZED
MANHOLE RISERS REQUIRED ON ALL SEPTIC TANKS AND PUMP CHAMBERS UNLESS SPECIFICALLY AUTHORIZED
CONTRACTOR RESPONSIBLE FOR COMPLIANCE WITH APPLICABLE REGULATIONS, GUIDELINES AND THE TERMS OF THIS PERMIT

NEITHER THE HOWARD COUNTY COUNCIL NOR THE HEALTH DEPARTMENT IS RESPONSIBLE FOR THE SUCCESSFUL OPERATION OF ANY SYSTEM PERMITTEE RESPONSIBLE FOR OBTAINING FINAL APPROVAL ON THIS PERMIT ALL 410-313-1771 FOR INSPECTION OF SEPTIC SYSTEM

A 541576

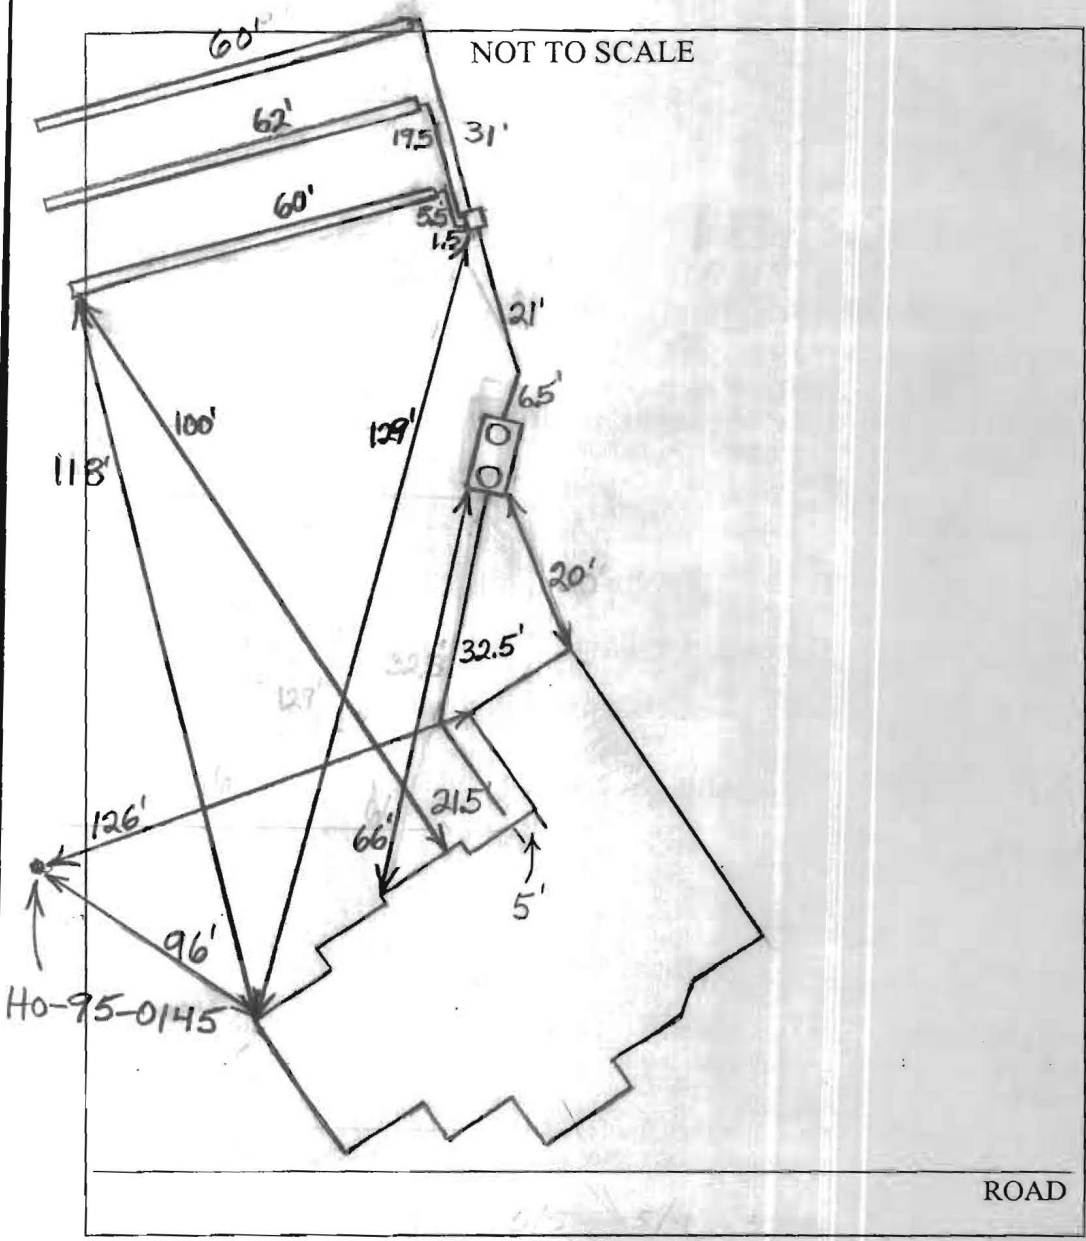

TRENCH/DRAINFIELD DATA		
WIDTH	INLET	BOTTOM
3'	3'	7'
NUMBER OF TRENCHES	3	
TOTAL LENGTH	182'	
ABSORPTION AREA	546 + Sidewalk	
DISTRIBUTION BOX LEVEL	Levelers	
DISTRIBUTION BOX BAFFLE	Yes	
DISTRIBUTION BOX PORT	No	

SEPTIC TANK DATA	
SEPTIC TANK 1 LEVEL	Yes
CAPACITY	1500 GAL
SEAM LOC	Top
TANK LID DEPTH	1'-2'
BAFFLES	Yes
BAFFLE FILTER	None
MANHOLE LOC	Front + Rear
6" PORT LOC	None
WATERTIGHT TEST	No
SEPTIC TANK 2 LEVEL	N/A
CAPACITY	_____ GAL
SEAM LOC	_____
TANK LID DEPTH	_____
BAFFLES	_____
BAFFLE FILTER	_____
MANHOLE LOC	_____
6" PORT LOC	_____
WATERTIGHT TEST	_____

PRE-CONSTRUCTION 5/5/2006 The builder requested that the driveway be moved so that it crosses the septic easement. O.K.



INSTALLATION as long as easement is reconfigured. Perc. testing (if required) and a revised perc. cert. First system to end about 20' outside of remaining easement area. (BB)

5/9/06 Tank set. Need house connection. (BB) 5/10/06 Top 2 trenches done. Need rear tank baffle. (BB) 5/11/06 Everything finished except for final part of house connection. End of top trench staked so that it can be located. (BB) 6/27/06 House connection made. (BB)


FINAL INSPECTOR B. Baber DATE OF APPROVAL 6/27/06

GENERAL NOTES:

- 1) THIS LOCATION DRAWING IS PREPARED FOR THE BENEFIT OF THE CLIENT SIGNING THE HOUSE LOCATION SURVEY APPROVAL FORM INsofar AS IT IS REQUIRED BY A LENDER OR TITLE INSURANCE COMPANY OR ITS AGENTS IN CONNECTION WITH THE CONTEMPLATED TRANSFER, FINANCING OR REFINANCING OF THE PROPERTY SHOWN HEREON. UNLESS INDICATED AS BEING A BOUNDARY SURVEY, THIS LOCATION DRAWING IS NOT INTENDED FOR USE IN THE ESTABLISHMENT OF PROPERTY LINES AND IS NOT TO BE RELIED UPON FOR THE ESTABLISHMENT OR LOCATIONS OF FENCES, GARAGES, BUILDINGS OR OTHER EXISTING OR FUTURE IMPROVEMENTS, AS A RESULT, THIS LOCATION DRAWING DOES NOT PROVIDE FOR ACCURATE IDENTIFICATION OF PROPERTY LINES, BUT SUCH IDENTIFICATION MAY NOT BE REQUIRED FOR THE TRANSFER OF TITLE OR SECURING FINANCING FOR RE-FINANCING. SUBJECT PROPERTY IS SHOWN IN ZONE C ON THE NATIONAL FLOOD INSURANCE PROGRAM FLOOD INSURANCE RATE MAP OF HOWARD COUNTY, MARYLAND, COMMUNITY PANEL No. 2400440208 EFFECTIVE DEC. 4, 1986.
- 2) THE OFFSETS FROM BUILDING LINE TO PROPERTY LINE AS SHOWN ON THE PLAT HEREON ARE TO AN ACCURACY OF PLUS OR MINUS 1' (±)
- 3) NO TITLE REPORT FURNISHED. SUBJECT TO ALL EASEMENTS, RIGHTS OF WAY AND CONDITIONS OF RECORD.
- 4) THE EXISTING WELL(S) SHOWN ON THIS PLAN IDENTIFIED WITH THE ATTACHED WELL TAG NUMBER HO-95-0145) HAS BEEN FIELD LOCATED BY FISHER, COLLINS AND CARTER, INC. PROFESSIONAL LAND SURVEYORS AND IS ACCURATELY SHOWN.

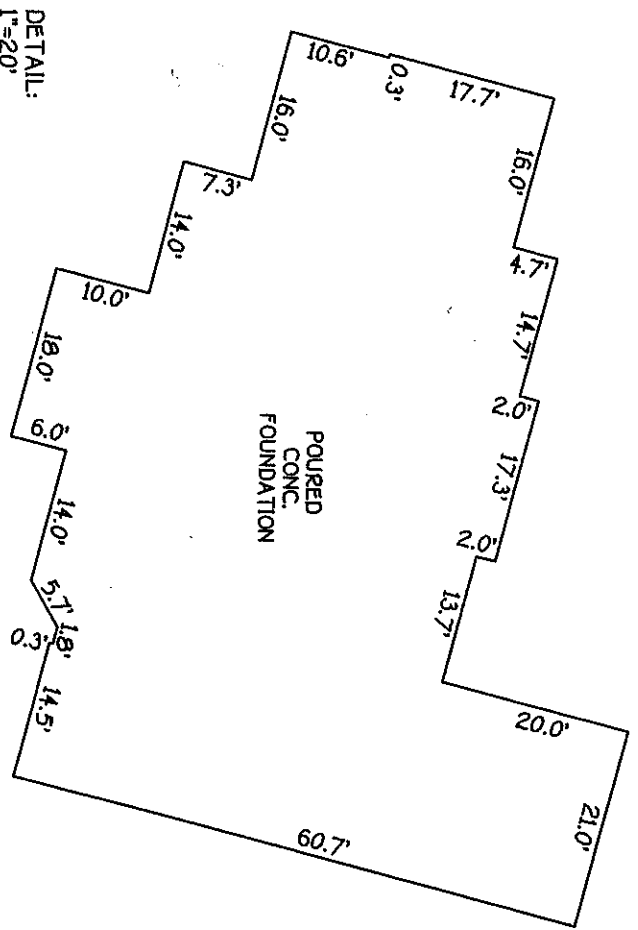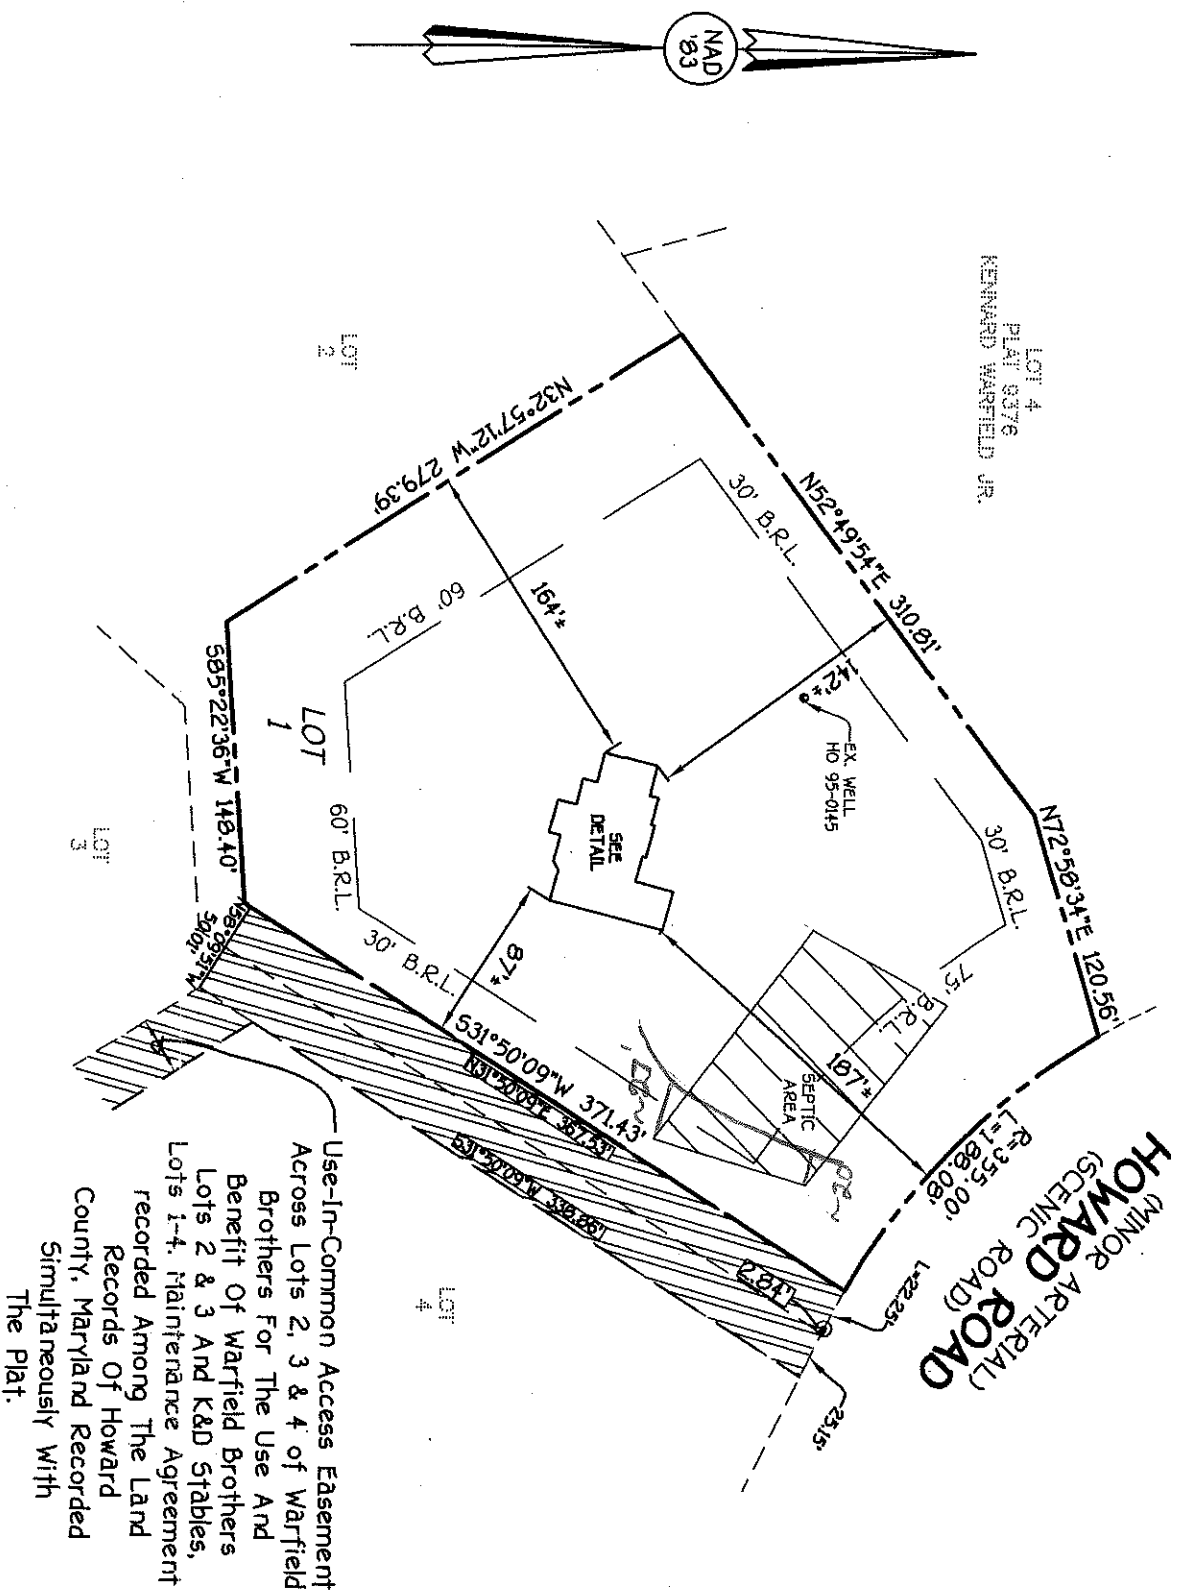

Use-In-Common Access Easement
 Across Lots 2, 3 & 4 of Warfield
 Brothers For The Use And
 Benefit Of Warfield Brothers
 Lots 2 & 3 And K&D Stables,
 Lots 1-4. Maintenance Agreement
 recorded Among The Land
 Records Of Howard
 County, Maryland Recorded
 Simultaneously With
 The Plat.

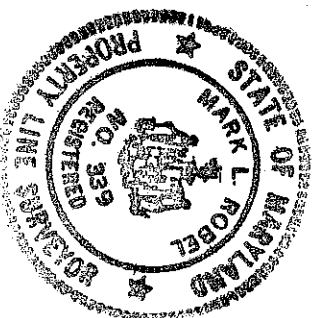

FISHER COLLINS & CARTER, INC.
 CIVIL ENGINEERING CONSULTANTS & LAND SURVEYORS
 11500 WOODBURN ROAD - SUITE 200
 ELLETTT CITY, MARYLAND 20624
 (410) 481-2625

Mark L. Robel
 PROFESSIONAL LAND SURVEYOR
 REG. NO. 939 DATE 3/16/06

LOT 1
 REVISION PLAT
 WARFIELD BROTHERS
 LOTS 1-4
 (A REVISION PLAT OF WARFIELD
 BROTHERS, LOTS 1-4, PLAT NO. 8841)
 FIFTH ELECTION DISTRICT
 HOWARD COUNTY, MARYLAND
 PLAT
 HOWARD ROAD
 BUILDING RESTRICTION LINE
 TOP OF FOUNDATION ELEV. = 521.4'

**HOUSE LOCATION
 DRAWING**
 FOUNDATION LOCATION: 24027208
 FINAL LOCATION:
 BOUNDARY SURVEY:
 SCALE: 1"=100'
 DATE: 03/16/06
 DRAWN BY: WLT
 CHECKED BY: JMG
 PROJECT No.: 08084-1002