

# APPLICATION

SEWAGE DISPOSAL TESTING

STATE OF MARYLAND - DEPARTMENT OF HEALTH AND MENTAL HYGIENE

A 41728

P \_\_\_\_\_

HOWARD COUNTY HEALTH DEPARTMENT  
ENVIRONMENTAL HEALTH SERVICES

P. O. BOX 473 ELLICOTT CITY, MARYLAND 21043  
TELEPHONE: 992-2330

DISTRICT 3RD.

DATE FEB 16, 1988

TO: THE COUNTY HEALTH OFFICER  
ELLICOTT CITY, MARYLAND

I, HEREBY, APPLY FOR THE NECESSARY TEST IN ORDER TO CONSTRUCT (OR RECONSTRUCT) A SEWAGE DISPOSAL SYSTEM.

PROPERTY OWNER ALBEE FARMS

ADDRESS 12150 ROUTE 99 MARIOTTVILLE MD. 21104 PHONE \_\_\_\_\_

PROPERTY LOCATION: N/3 MD. ROUTE 99 WEST OF HENRYTON ROAD

SUBDIVISION ~~ALBEE FARM~~ Spring Valley Chase LOT NO. ~~200~~ 32

ROAD AND DESCRIPTION ~~ROAD A~~ Woodford Drive

SIZE OF LOT 11.38 AC± TYPE BLDG. SFD  
(NUMBER OF BEDROOMS)

THE SYSTEM INSTALLED UNDER THIS APPLICATION IS ACCEPTABLE ONLY UNTIL PUBLIC FACILITIES BECOME AVAILABLE. I FULLY UNDERSTAND THE FEE CONNECTED WITH THE FILING OF THIS PERC TEST APPLICATION IS NON-REFUNDABLE UNDER ANY CIRCUMSTANCES. I ALSO AGREE TO COMPLY WITH ALL M.O.S.H.A. REQUIREMENTS IN TESTING THIS LOT.

Ivan D. Bell  
(SIGNATURE OF APPLICANT)

APPROVED BY \_\_\_\_\_ FOR \_\_\_\_\_ DATE \_\_\_\_\_

REJECTED BY \_\_\_\_\_ FOR \_\_\_\_\_ DATE \_\_\_\_\_


HOLD PENDING FURTHER TESTS \_\_\_\_\_ DATE \_\_\_\_\_

REASONS FOR REJECTION (OR HOLDING) 7-15-88 Pmt Satisfactory, Hold for Subcl. Plan SOB

# THIS IS NOT A PERMIT

SOIL PROFILE

0	A1-3
4"	yellow to silt clay loam 10-15% frag
3'	yellow BA silt loam micaceous 15-20% frag
13'	

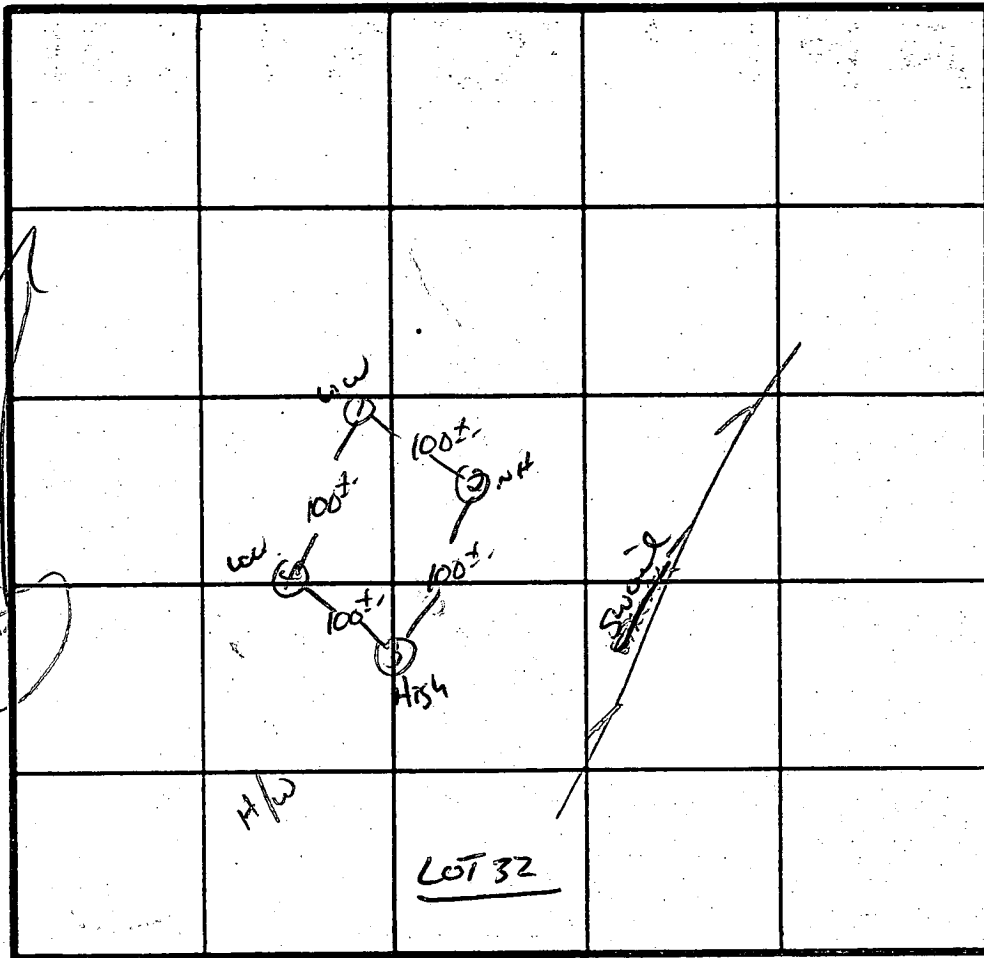

X Perc 3 min

160 Φ BR

INLET - 3  
BOTTOM - 8

INDICATE NORTH - NAME ADJOINING ROADWAY AS BASE LINE.

R499

DATE	TEST NO.	DEPTH	PRE-WET		TEST - 1" DROP		TIME
			START	STOP	START	STOP	
7/15/88	1V	3.5 13'	10:42 UNIFORM	10:44 Soil below 3.0'	10:44	10:47	3 min
	2V	13'	UNIFORM	Soil below 3.0'			
	3S	3.5	10:33	10:34	10:34	10:36	2 min
	3M	7.5	10:33	10:35	10:35	10:39	4 min
	3V	12.5'	UNIFORM	Soil below 3.0'			
	4S	3.5'	10:48	10:49	10:49	10:51	2 min
	4V	12'	UNIFORM	Soil below 3.0'			

REMARKS

Holes APPROX TO PLAT

TYPE OF SOIL

MANOR LOAM / Chert loam

TESTED BY

S. Abel

ALSO PRESENT

SKIP, JOHN  
MS. BAKER