

May 31, 1988
9:30
Preliminary

APPLICATION

PERCOLATION TESTING

RECEIVED
10 AM 4/7/88

41580
~~41568~~
A _____
P _____
DISTRICT 5
DATE 4/6/88

HOWARD COUNTY HEALTH DEPARTMENT
BUREAU OF ENVIRONMENTAL HEALTH
P.O. BOX 476 ELLICOTT CITY, MARYLAND 21043
TELEPHONE: 461-9933

TO: THE COUNTY HEALTH OFFICER
ELLICOTT CITY, MARYLAND

I, HEREBY, APPLY FOR THE NECESSARY TEST IN ORDER TO CONSTRUCT (OR RECONSTRUCT) A SEWAGE DISPOSAL SYSTEM.

PROPERTY OWNER K+D Stables c/o Howard Co Land Services

ADDRESS 8307 Main St PHONE 465-5855

PROSPECTIVE BUYER N/A

ADDRESS _____ PHONE _____

PROPERTY LOCATION: KENNARD WARFIELD JR F90-78 LOT 3 PARCEL C
SUBDIVISION _____ LOT NO. 1 Parcel C

ROAD AND DESCRIPTION Howard Rd south of Triadelphia Rd

TAX MAP 21 PARCEL # 68

SIZE OF LOT 3 acres TYPE BLDG. SFD
(SINGLE FAMILY DWELLING OR COMMERCIAL)

THE SYSTEM INSTALLED UNDER THIS APPLICATION IS ACCEPTABLE ONLY UNTIL PUBLIC FACILITIES BECOME AVAILABLE. I FULLY UNDERSTAND THE FEE CONNECTED WITH THE FILING OF THIS PERC TEST APPLICATION IS NON-REFUNDABLE UNDER ANY CIRCUMSTANCES. I ALSO AGREE TO COMPLY WITH ALL M.O.S.H.A. REQUIREMENTS IN TESTING THIS LOT.

M. J. R. [Signature]
(SIGNATURE OF APPLICANT)

APPROVED BY C. Wilton FOR TRENCHES DATE 3/23/90

REJECTED BY _____ FOR _____ DATE _____

HOLD PENDING FURTHER TESTS _____ DATE _____

REASONS FOR REJECTION OR HOLDING 5-31-88 For perc hole locations and subdivision plot approval. Swale runs along one side of field. Only 125± ft from stream. Does 500 ft restriction apply here? DEN


THIS IS NOT A PERMIT

High D
A
E
C
Low 1

A41580 1-C

SOIL PROFILE

0-5 Br silclm
little,
broken
rock
415%
3 Br-white
sa silm,
trc mottled
11 Bottom
Water
at 12.0 ft

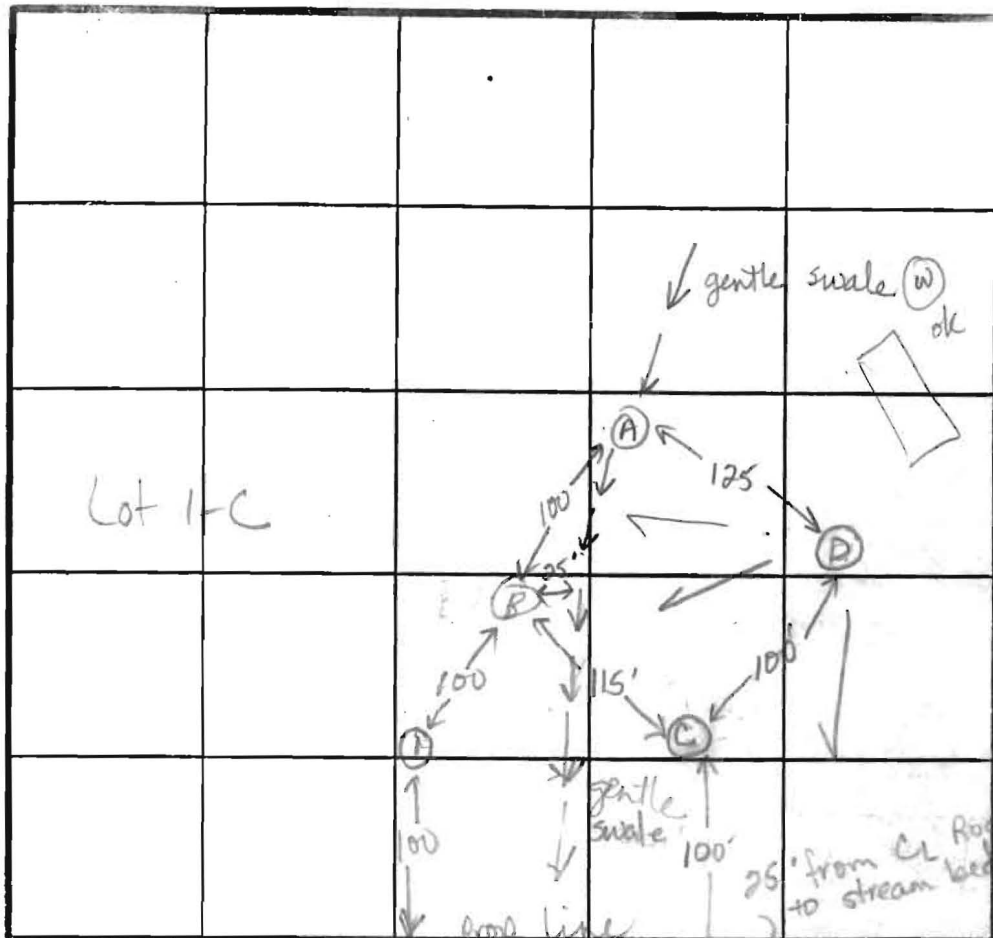

(D)
0-4.0 Br silcl
loam
4.0-11.0 Br sa silm
1m, 410%
broken
rock frags
11.0 Bottom

(A)
0-4.0 Br silclm
4.0-12.0 Br sa silm
<10%
broken rx
frags
12.0 Bottom

(B)
-4.0 Br sa
sil
-13.0 Br sa
sil
little
broken
rock frags
<21%
20 Bottom

(C)
0-3 Br silclm
3-12 Br sa silm
trc
rock
frag
415%
12 Bottom

INDICATE NORTH - NAME ADJOINING ROADWAY AS BASE LINE

Howard - centerline

DATE	TEST NO.	DEPTH	PRE-WET		TEST - 1" DROP		TIME
			START	STOP	START	STOP	
5-31-88		13.0 V	see profile		(water at 12.0)		Failed
	B	5.0 S	2:06	2:08	2:08	12:12	4min
		13.0 D	Bottom				ok
	C	3.0 S	2:07	2:10	2:10	2:14	4min
		12.0 D	Bottom				ok
	D	4.5 S	2:22	2:24	2:24	2:27	3min
		8.0 M	2:23	2:25	2:25	2:28	3min
		11.0 D	Bottom				ok
	A	12.0 V	(see profile)				ok

REMARKS

Holes not as shown on plat. Swale runs through part of field

TYPE OF SOIL

0-4 Br silclm, 4-12 Br sa silm, <20% rx frags

TESTED BY

JF Nozeman

ALSO PRESENT

Ornk, Rp
Mark Reich

EH-12-10790


5
17
24
188
94
110
39
2

1	200.00'	178.75'	95.84'	172.86'	S21°48'22"E	51'12'24"
2	1500.00'	410.02'	206.30'	408.74'	S18°19'54"E	15°39'42"

MINIMUM LOT SIZE TABULATION

LOT	GROSS AREA	15-25% STEEP SLOPE	NET AREA
1	3.3082	-0-	3.3082
2	3.0328	.3843	2.6485
3	3.0229	.2704	2.7525
4	3.0094	.1566	2.8528

MINIMUM
PROP. 25' R/W DEDIC

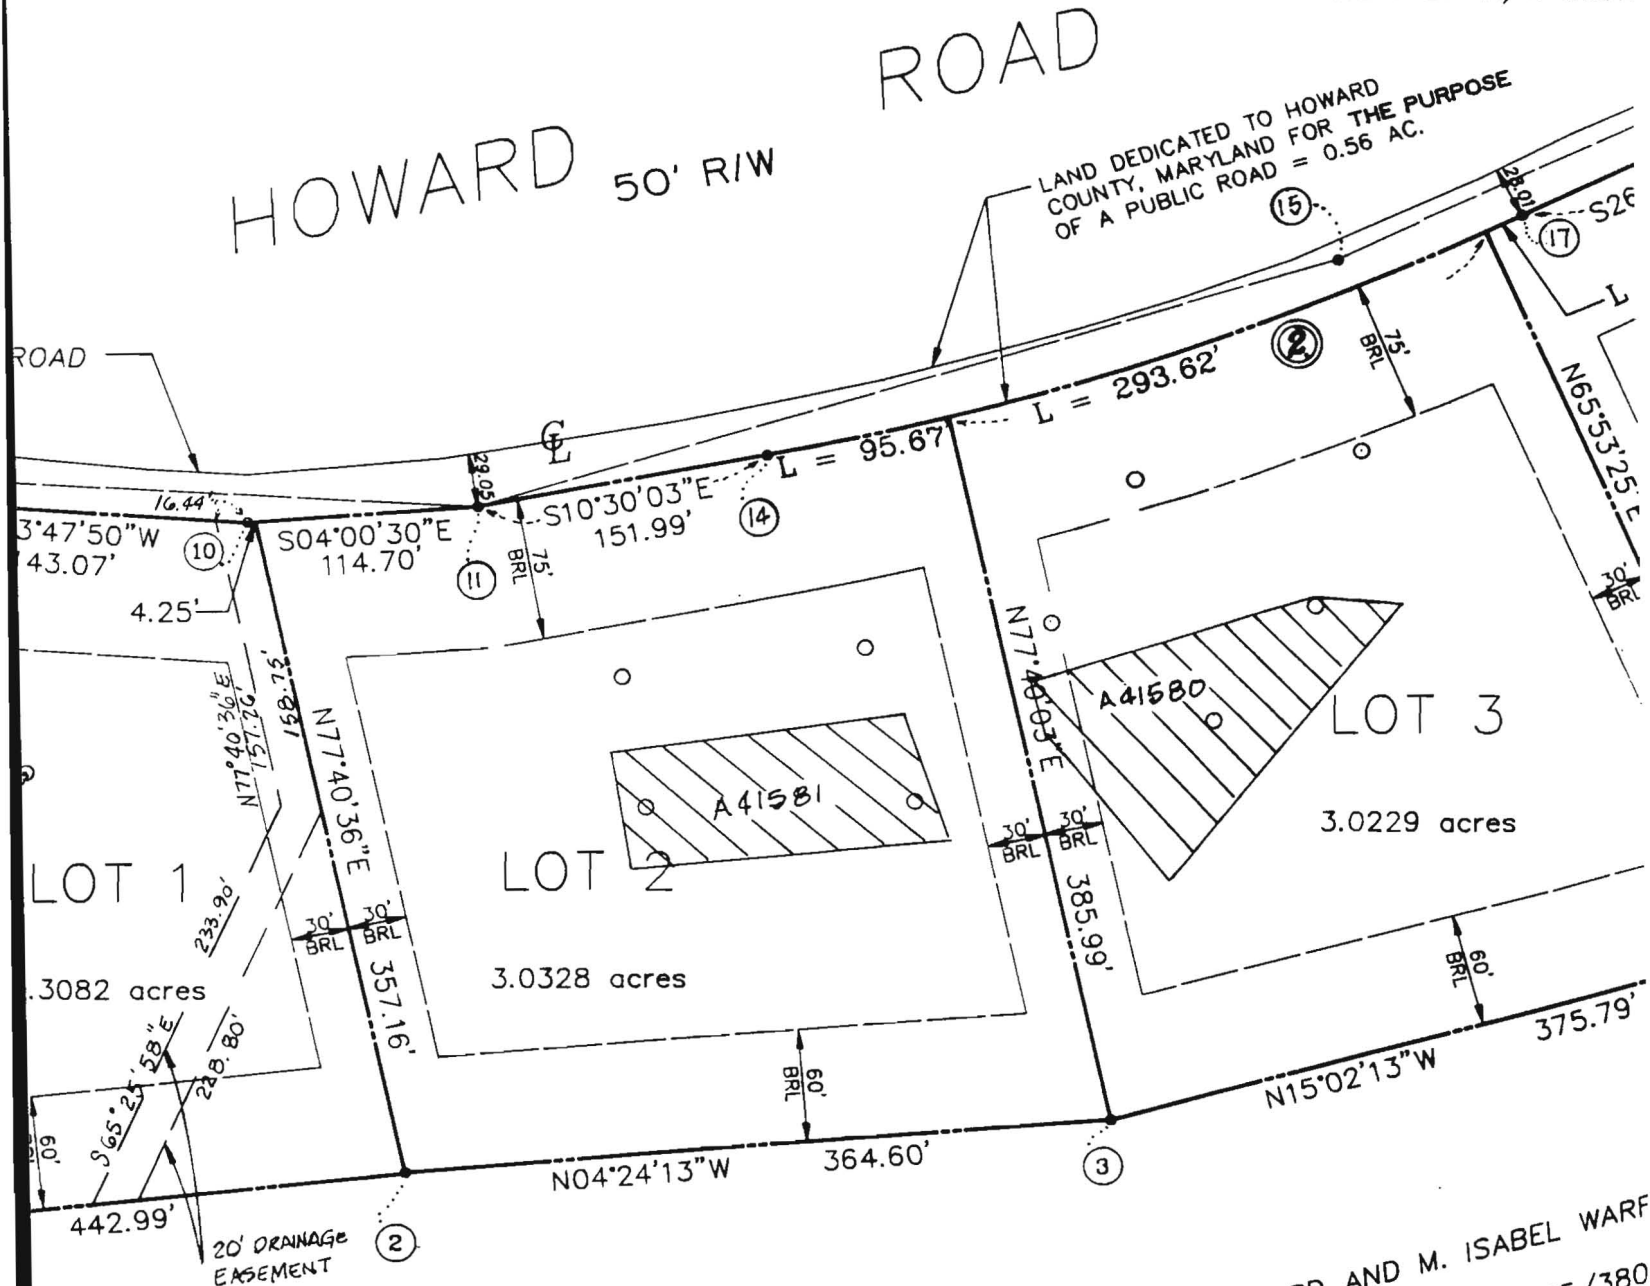

KENNARD AND M. ISABEL WARF
939/207 165/380
1805/20
PARCEL 114

* APPROXIMATE TIES
DEPARTMENT FILE
LOCATED.

OWNER
KENNARD WARFIELD Jr.
CONTRACT PURCHASER
c/o LAND DESIGN AND

517500